


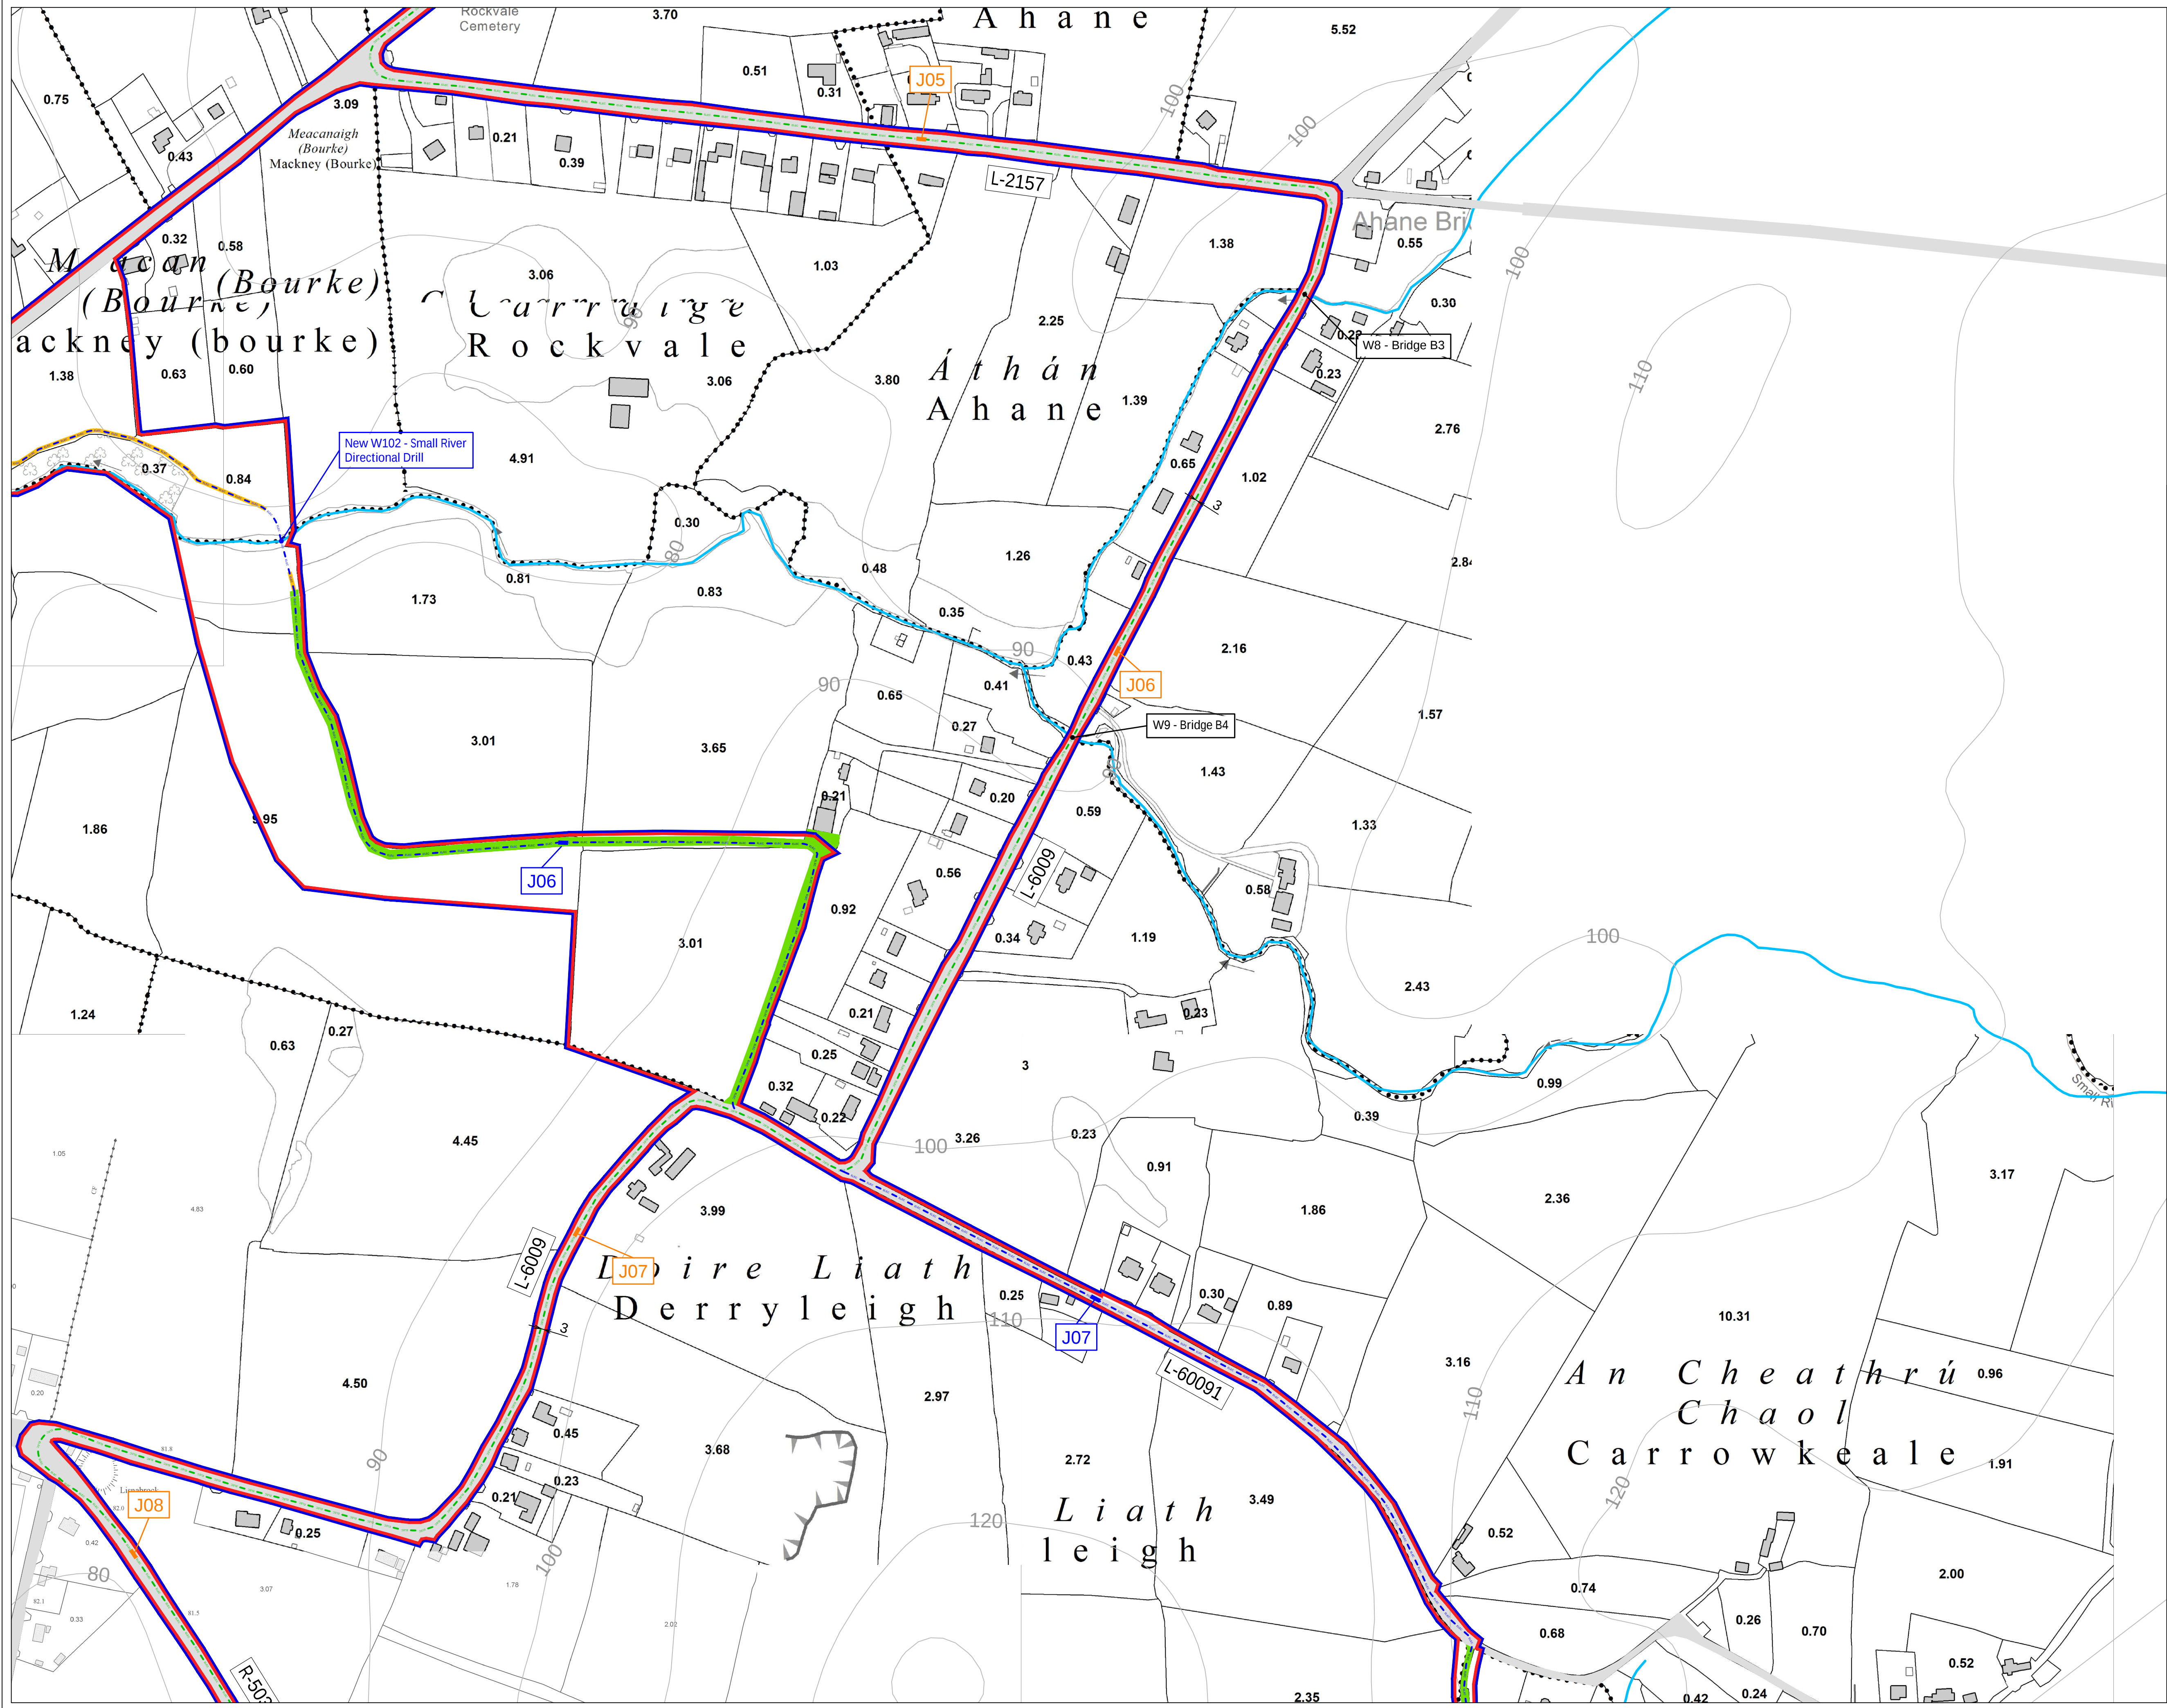

LEGEND

- Blue Line Boundary
- Red Line Boundary
- Height contours showing elevations in meters above sea level
- Distance to Boundaries in meters
- Watercourse
- Public Road
- Public Road Identification Number
- Existing Farm Track

AUTHORISED

- 110kV underground cable route (UGC)
- Joint Bay Locations
- Watercourse Crossings

ALTERATION

- Alteration to 110kV underground cable route (UGC)
- New Joint Bay
- New Watercourse Crossing
- New 3m wide ESB access track

Drawing Notes:

- All dimensions in meters
- Maps Printed under Ordnance Survey Ireland Licence No. CYAL50188738 Copyright Ordnance Survey Ireland Government of Ireland
- Joint Bay locations shown are indicative and will be subject to detailed electrical design

OSI Sheet(s): 4626, 4567, 4626-A, 4626-B, 4626-C, 4626-D

Project


UWF Grid Connection ABP Ref. 306204.19

Drawing Title

Revised Site Layout Map 3 of 17

Drawing Number: Revised UWF GC 13

Sheet Size:	ISO A1 (landscape)	Scale:	1 : 2500
Drawn by:	Conor Brett	Checked by:	Phil Kenealy
Date produced:	05.03.2025		

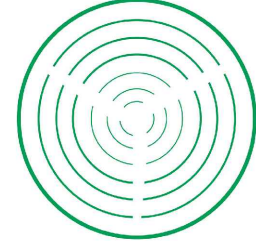

Conor Brett
Ecopower Limited
Zetec House, Purcellstown IDA Business Park
Dublin Road, Kilkenny - R95 WV80
Landline - 056-7750140 (Ext 204)
Mobile - +353 (0)87-6531458

ECOPOWER