


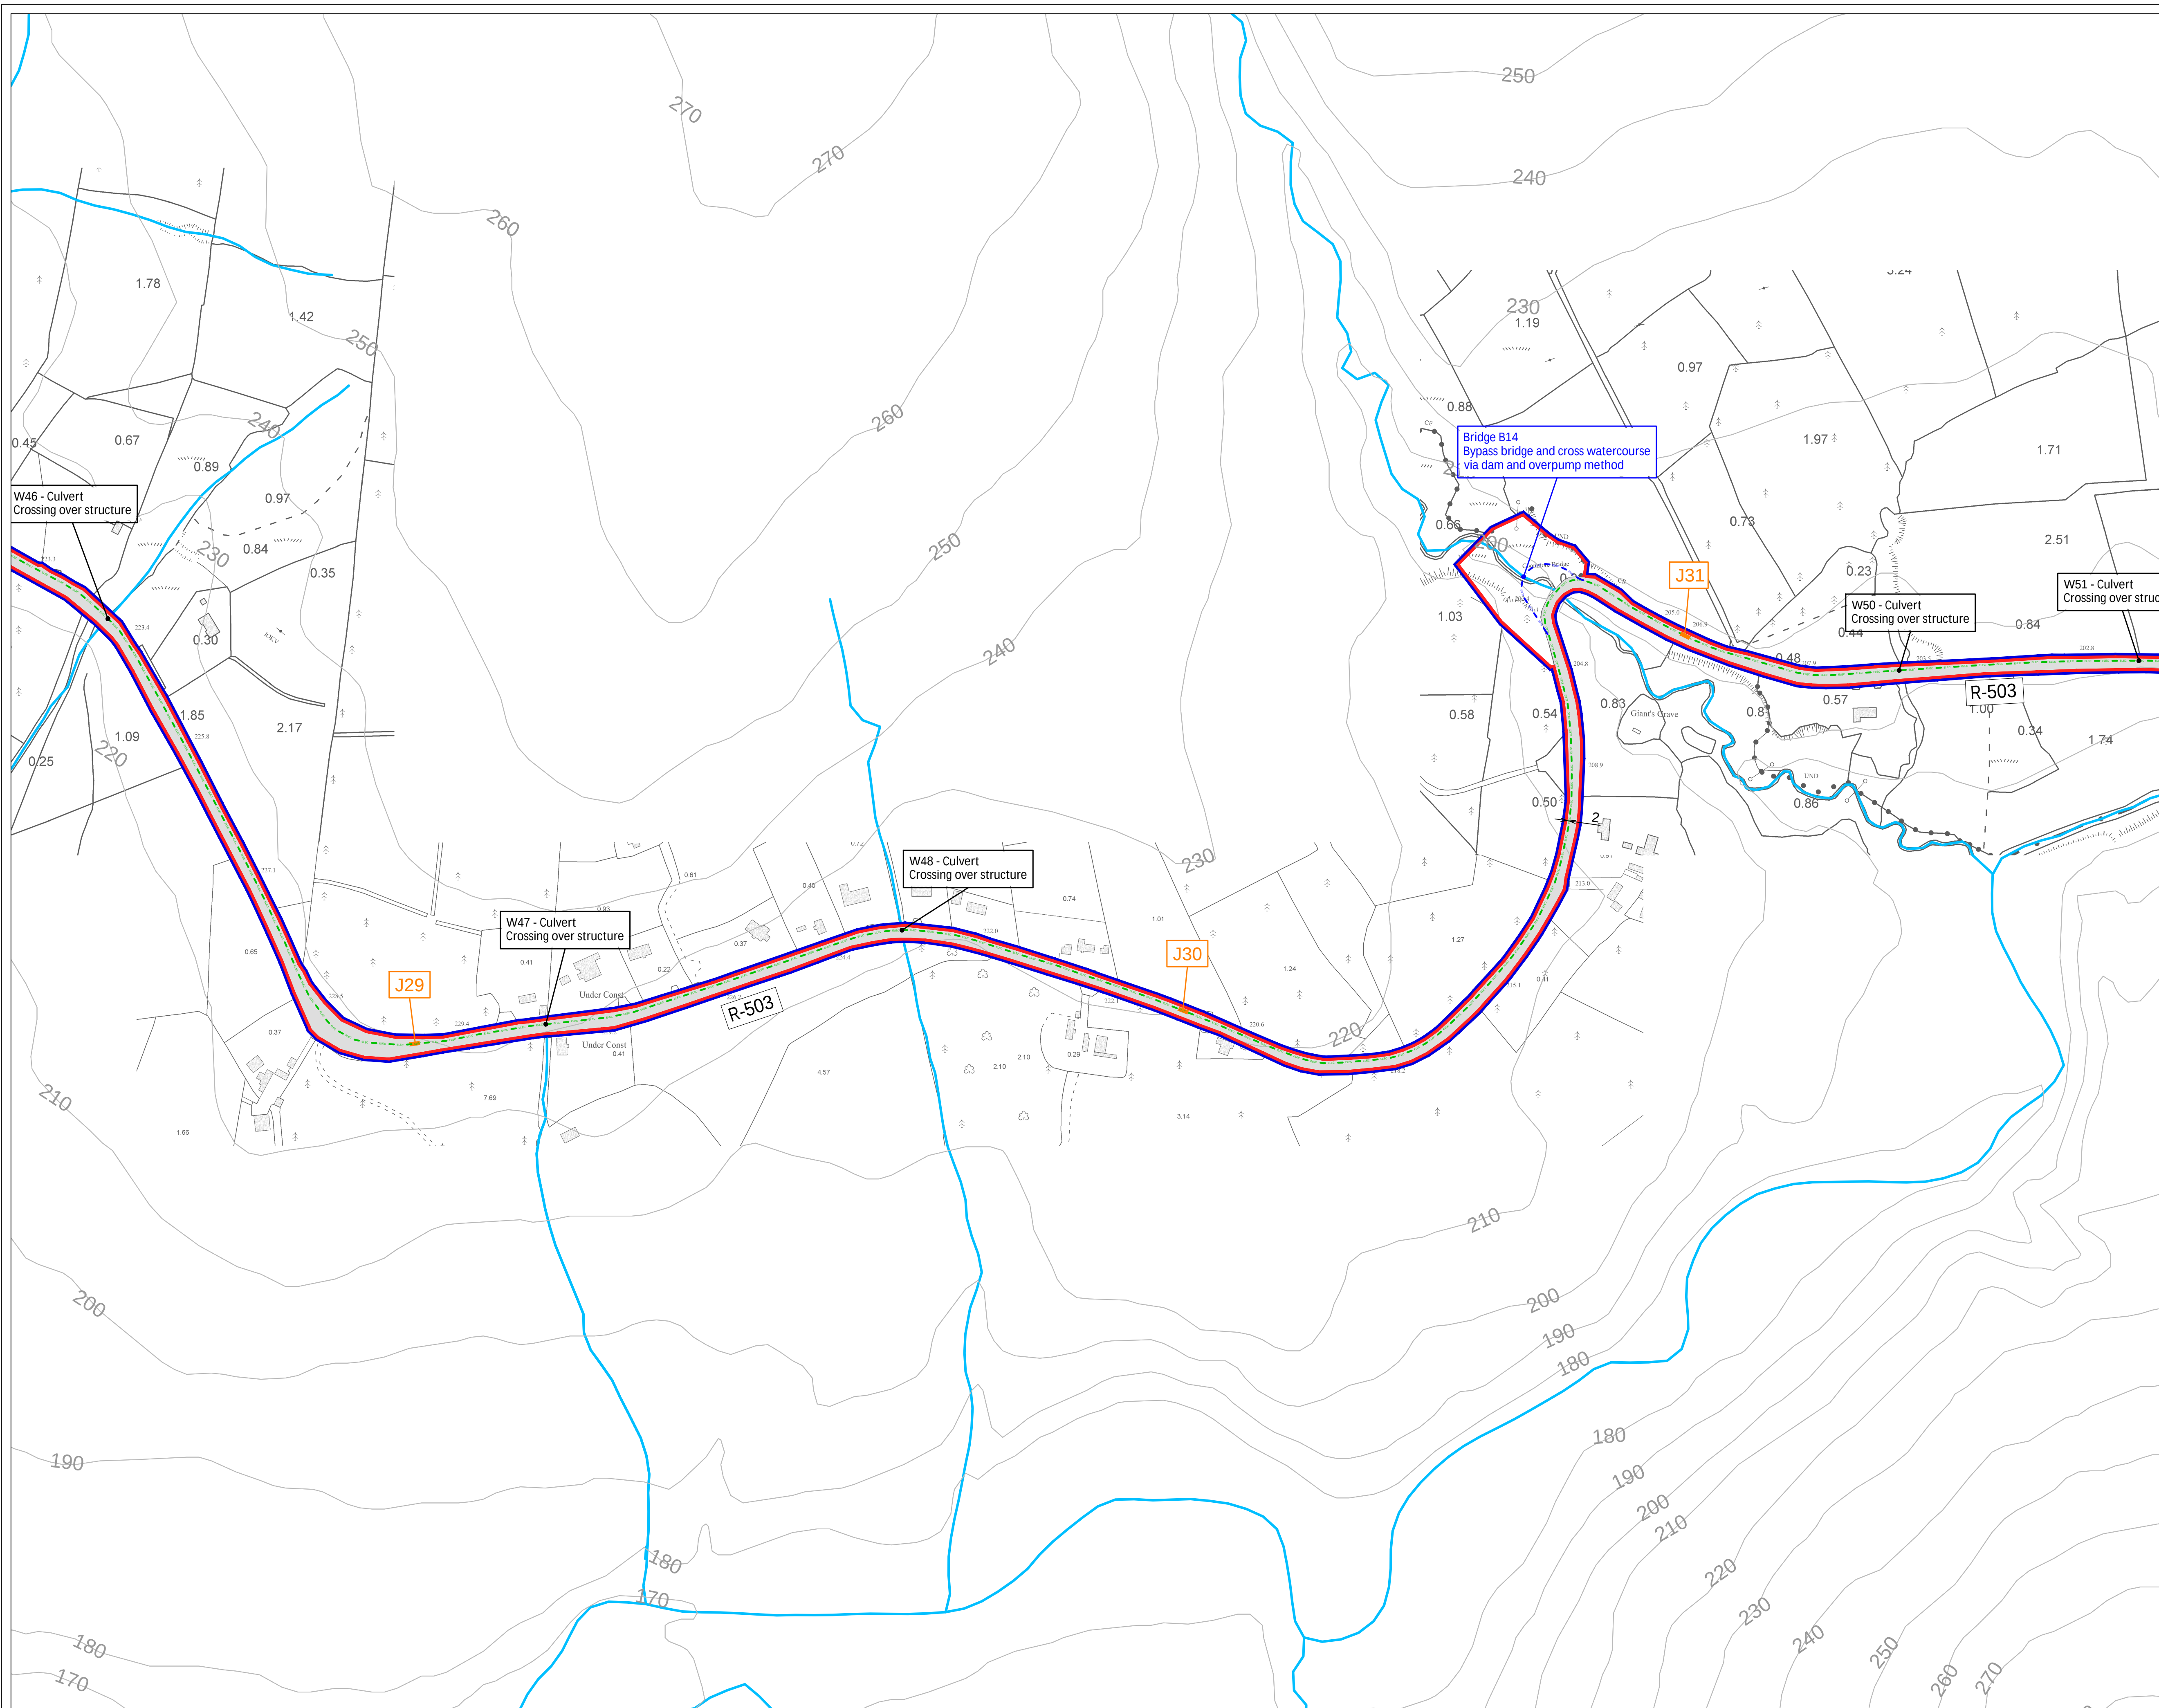

LEGEND


- | | |
|---|--|
|  | Blue Line Boundary |
|  | Red Line Boundary |
|  | Height contours showing elevations in meters above sea level |
|  | Distance to Boundaries in meters |
|  | Watercourse |
|  | Public Road |
|  | Public Road Identification Number |

AUTHORISED

-  110kV underground cable route (UGC)
 Joint Bay Locations
 Watercourse Crossings

ALTERATION

- | | |
|------|---|
| ELEC | Alteration to 110kV underground cable route (UGC) |
| B14 | Alteration to watercourse crossing methodology |

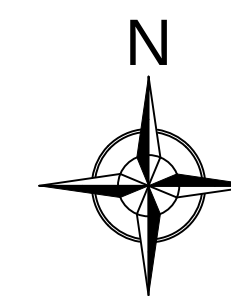

Drawing Notes:


1. All dimensions in meters
2. Maps Printed under Ordnance Survey Ireland Licence No. CYAL50188738 Copyright Ordnance Survey Ireland Government of Ireland
3. Joint Bay locations shown are indicative and will be subject to detailed electrical design

OSI Sheet(s): 4689-A, 4689-B, 4689-D, 4689, 4690-A, 4690-B, 4690-C, 4690

Project UWF Grid Connection ABP Ref. 306204.19

Drawing Title
Revised Site Layout Map 12 of 17
Drawing Number: Revised UWF GC 22

Sheet Size: ISO A1 (landscape)		Scale: 1 : 2500
Drawn by: Conor Brett	Checked by: Phil Kenealy	Date produced: 06.03.2025

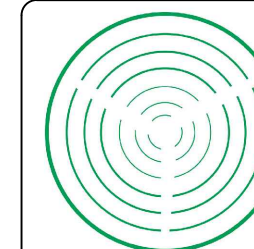

Conor Brett
Ecopower Limited
Zetec House, Purcellsinnch IDA Business Park
Dublin Road, Kilkenny - R95 WV80

Landline - 056-7750140 (Ext 204)
Mobile - +353 (0)87-6531458

ECOPOWER