


ISO A3 297mm x 420mm

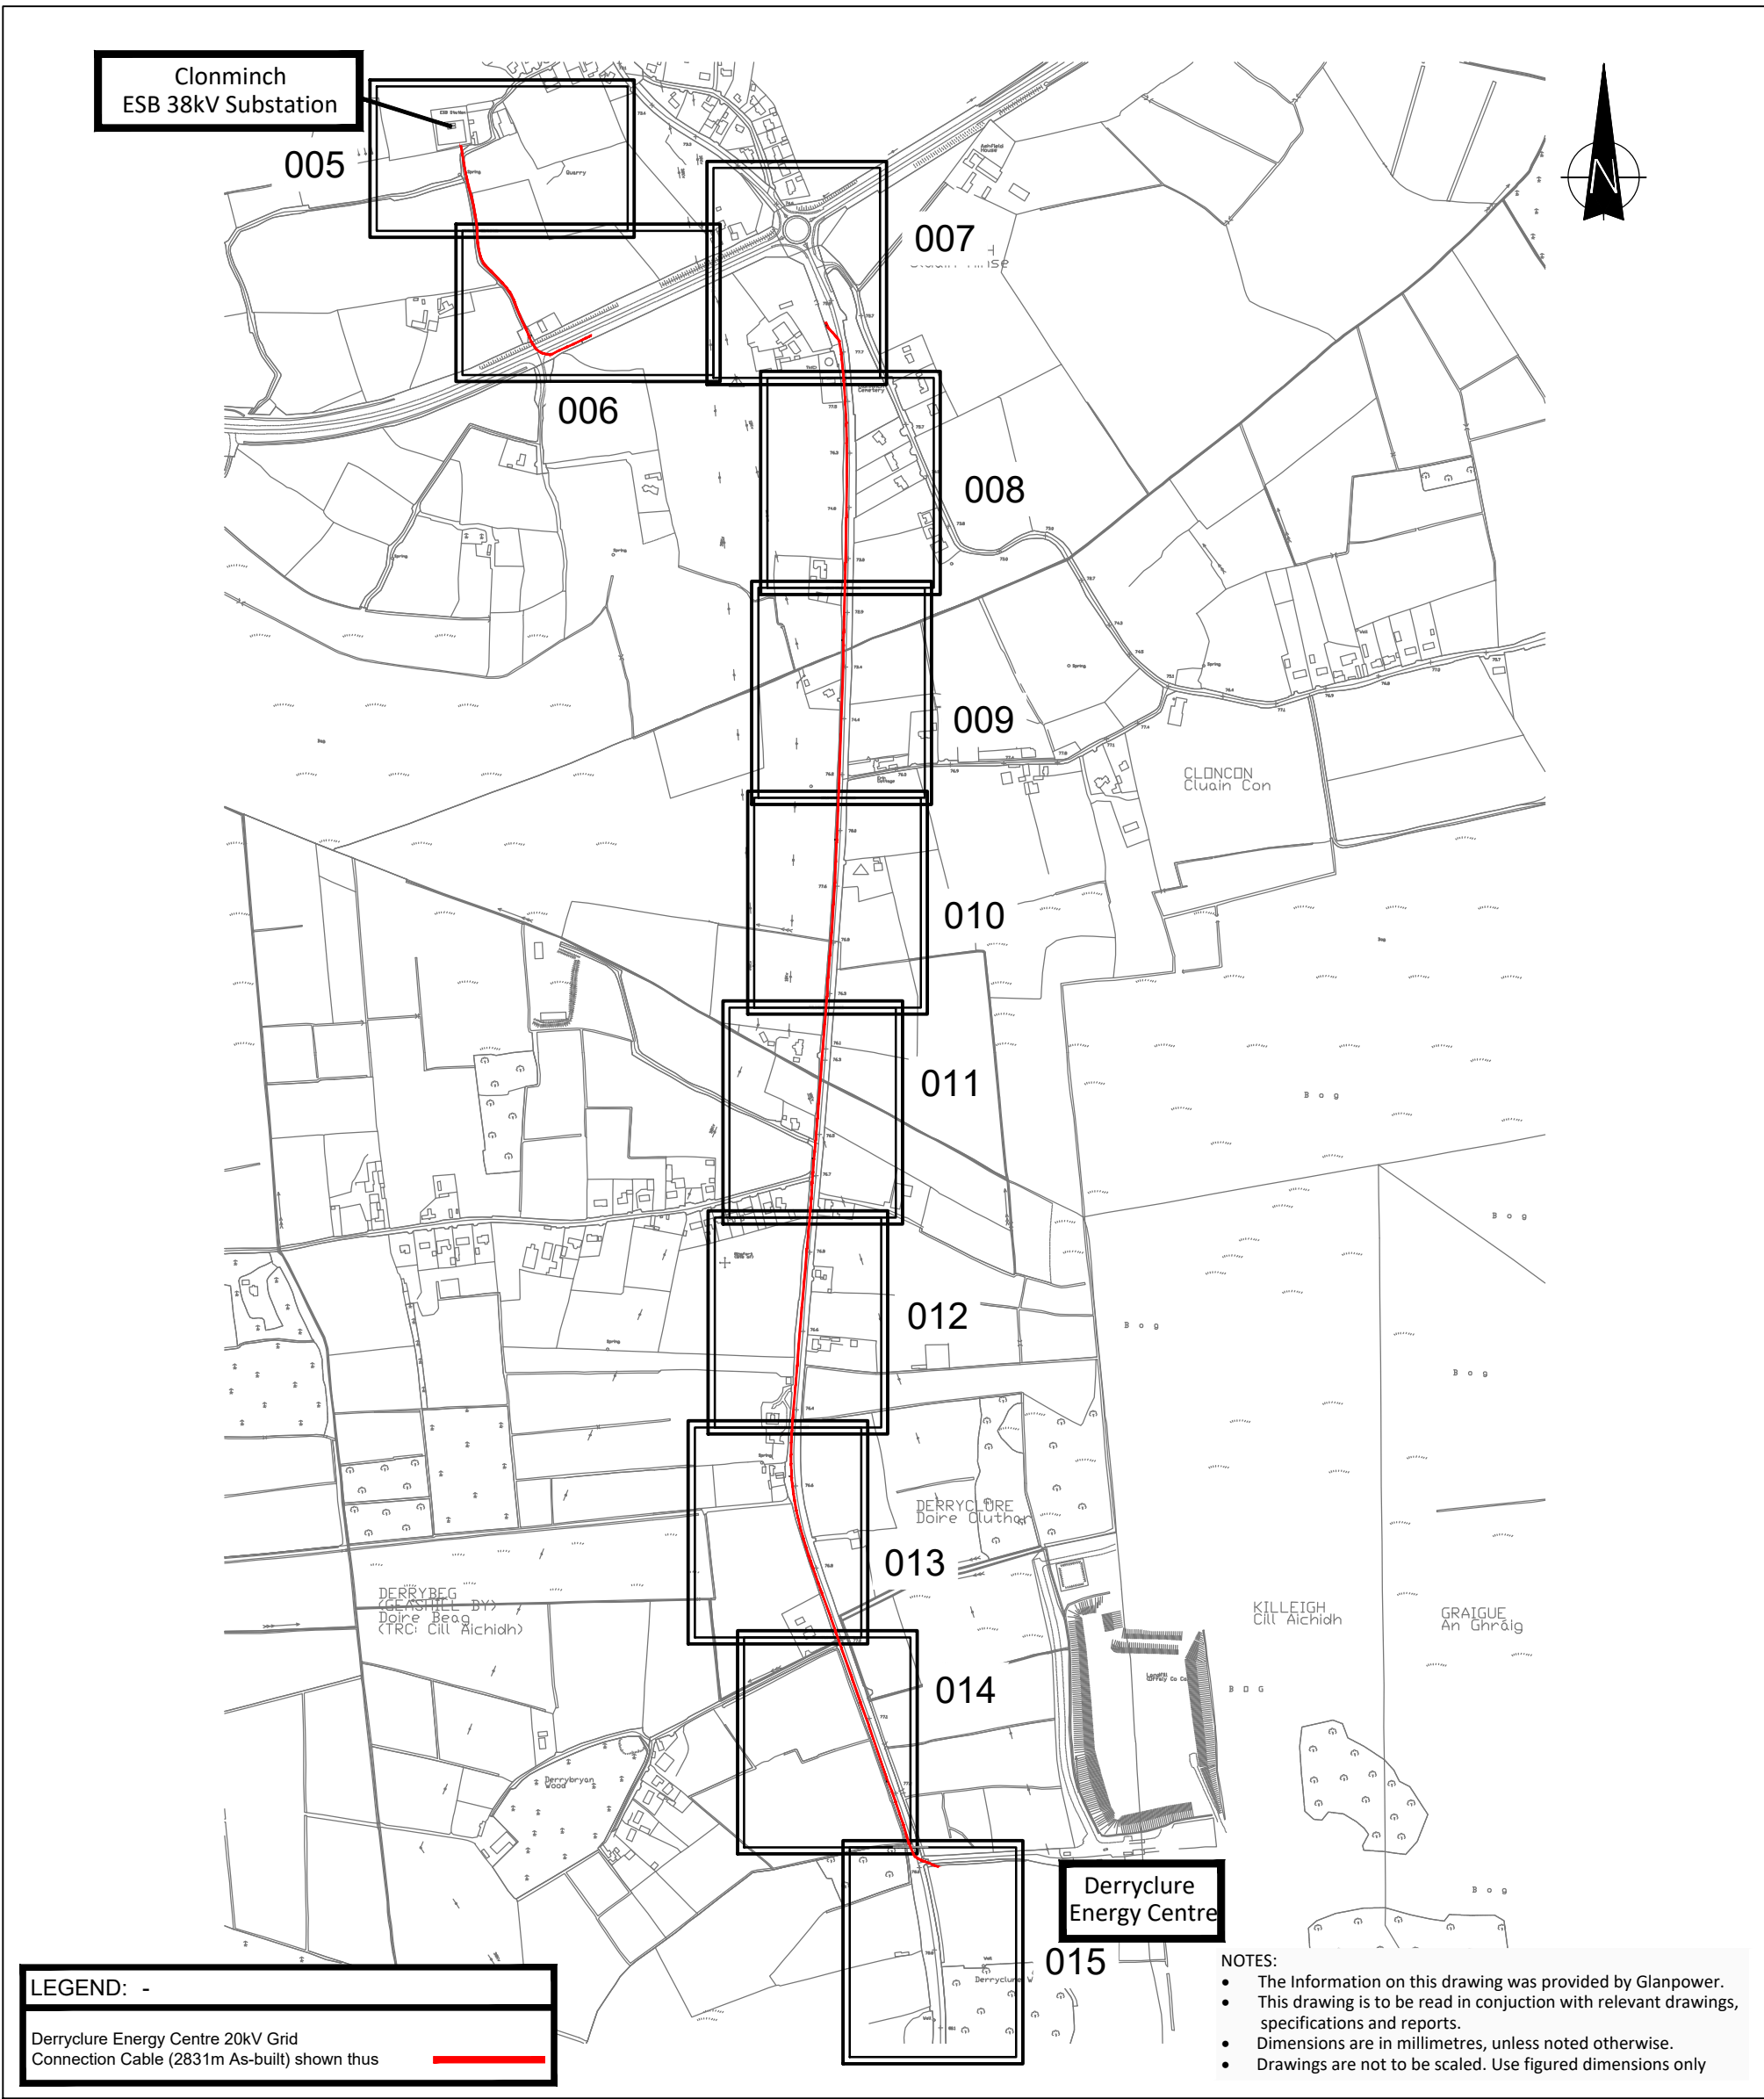

Overall Site Map

05772-004

Scale: 1:10000



Head Office
Beenreigh,
Abbeydorney,
Tralee, Co. Kerry
Ireland
Tel: 00353 66 7135710

CLIENT



SHEET TITLE
Overall Site Map

DRAWING STATUS
As Built

PROJECT NUMBER
05-772

SHEET NUMBER
05772-004

LEGEND/NOTES: -

ISSUE/REVISION		
Z0	23.11.21	As Built
I/R	DATE	DESCRIPTION

PROJECT
Derryclure Energy Centre
20kV Grid Connection