


ISO A1 594mm x 841mm

Project Management Initials: Designer: POS Checked: ER Approved: AC

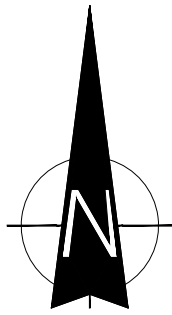


Map Series:  
Prime Data Vector

OSI Sheet Reference Number:  
6471-C

ITM Centre Point Co-ordinate:  
X,Y = 657516.8,653099.53

Tailte Éireann Licence No.  
CYAL50510216

Copyright:  
© Tailte Éireann - Surveying

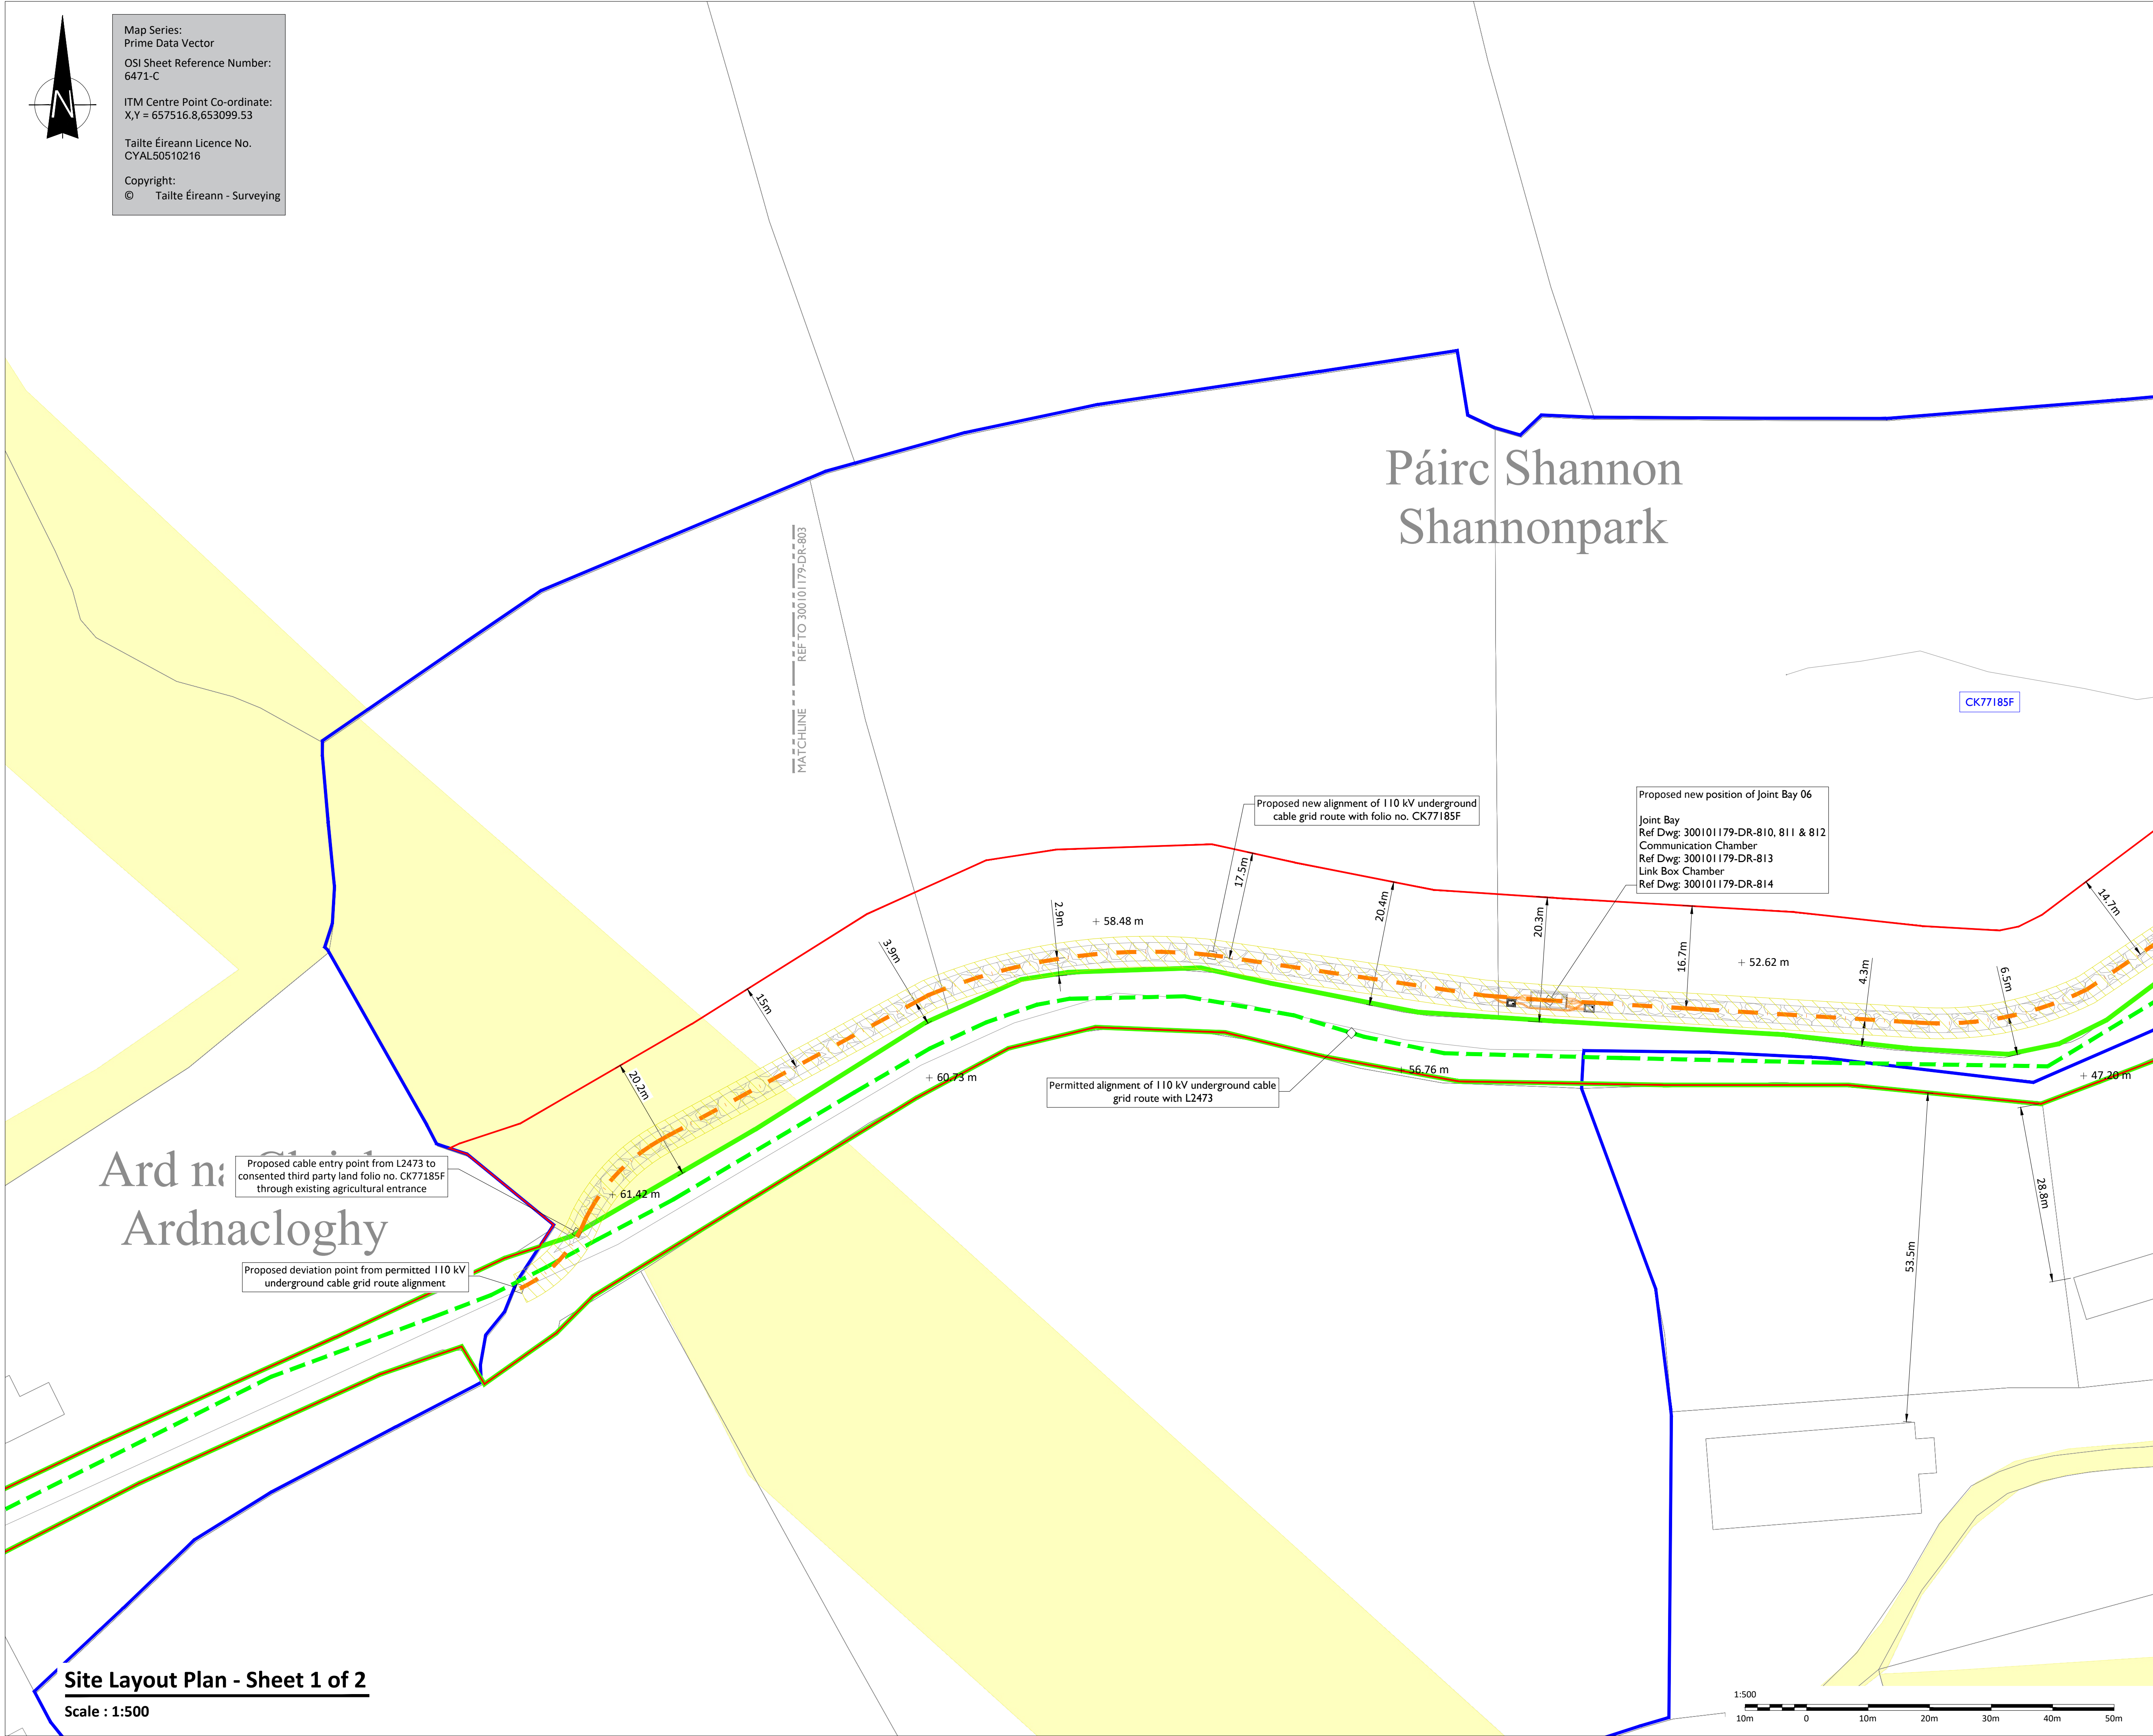

Head Office  
Beenreigh,  
Abbeydorney,  
Tralee, Co. Kerry  
Ireland  
Tel: 00353 66 7135710

Regional Office  
Basepoint Business Centre  
Stroudley Road, Basingstoke,  
Hampshire,  
RG24 8UP, UK  
Tel: 00 44 1256406664

PROJECT

Ballinrea 110kV Grid Route  
S146B Alteration Application

CLIENT



CONSULTANTS

Issued for Planning Amendment  
Not for Construction  
02.03.2026

NOTES: -

- Path of cable route and location of associated Joint Bays, Link Boxes and Comms Chambers may vary depending on site conditions and following detailed design. Deviations will remain within the planning boundary at all times.
- Other services may be encountered along the route.
- Final levels may vary depending on local ground condition.

LEGEND: -

|                                 |           |
|---------------------------------|-----------|
| Proposed Planning Amendment     |           |
| Red Line Boundary               |           |
| Permitted Planning Application  |           |
| Boundary                        |           |
| Consented Third Party Landowner |           |
| Boundary                        |           |
| Permitted 110 kV Underground    |           |
| Cable Grid Route                |           |
| Proposed 110 kV Underground     |           |
| Cable Grid Route Amendment      |           |
| Proposed 3 m Wide Permanent     |           |
| Access Track                    |           |
| Statutory Wayleave in Respect   |           |
| of the 110 kV Cable Route       |           |
| Spot Height                     | + 47.20 m |
| Existing Wayleave               |           |

ISSUE/REVISION

| I/R | DATE     | DESCRIPTION                   |
|-----|----------|-------------------------------|
| P5  | 02.03.26 | Issued for Planning Amendment |
| P4  | 25.02.26 | Issued for Planning Amendment |
| P3  | 09.02.26 | Issued for Planning Amendment |
| P2  | 03.02.26 | Issued for Planning Amendment |
| P1  | 12.12.25 | Issued for Planning Amendment |

PROJECT NUMBER

300-101179

SHEET TITLE

Site Layout Plan  
Sheet 1 of 2

SHEET NUMBER

300101179-DR-802