



ISO A1 594mm x 841mm

Project Management Initials: Designer: POS Checked: ER Approved: AC

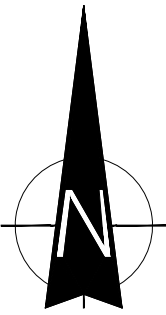

Map Series:
Prime Data Vector
OSI Sheet Reference Number:
6471-C
ITM Centre Point Co-ordinate:
X,Y = 657516.8,653099.53
Tailte Éireann Licence No.
CYAL50510216
Copyright:
© Tailte Éireann - Surveying

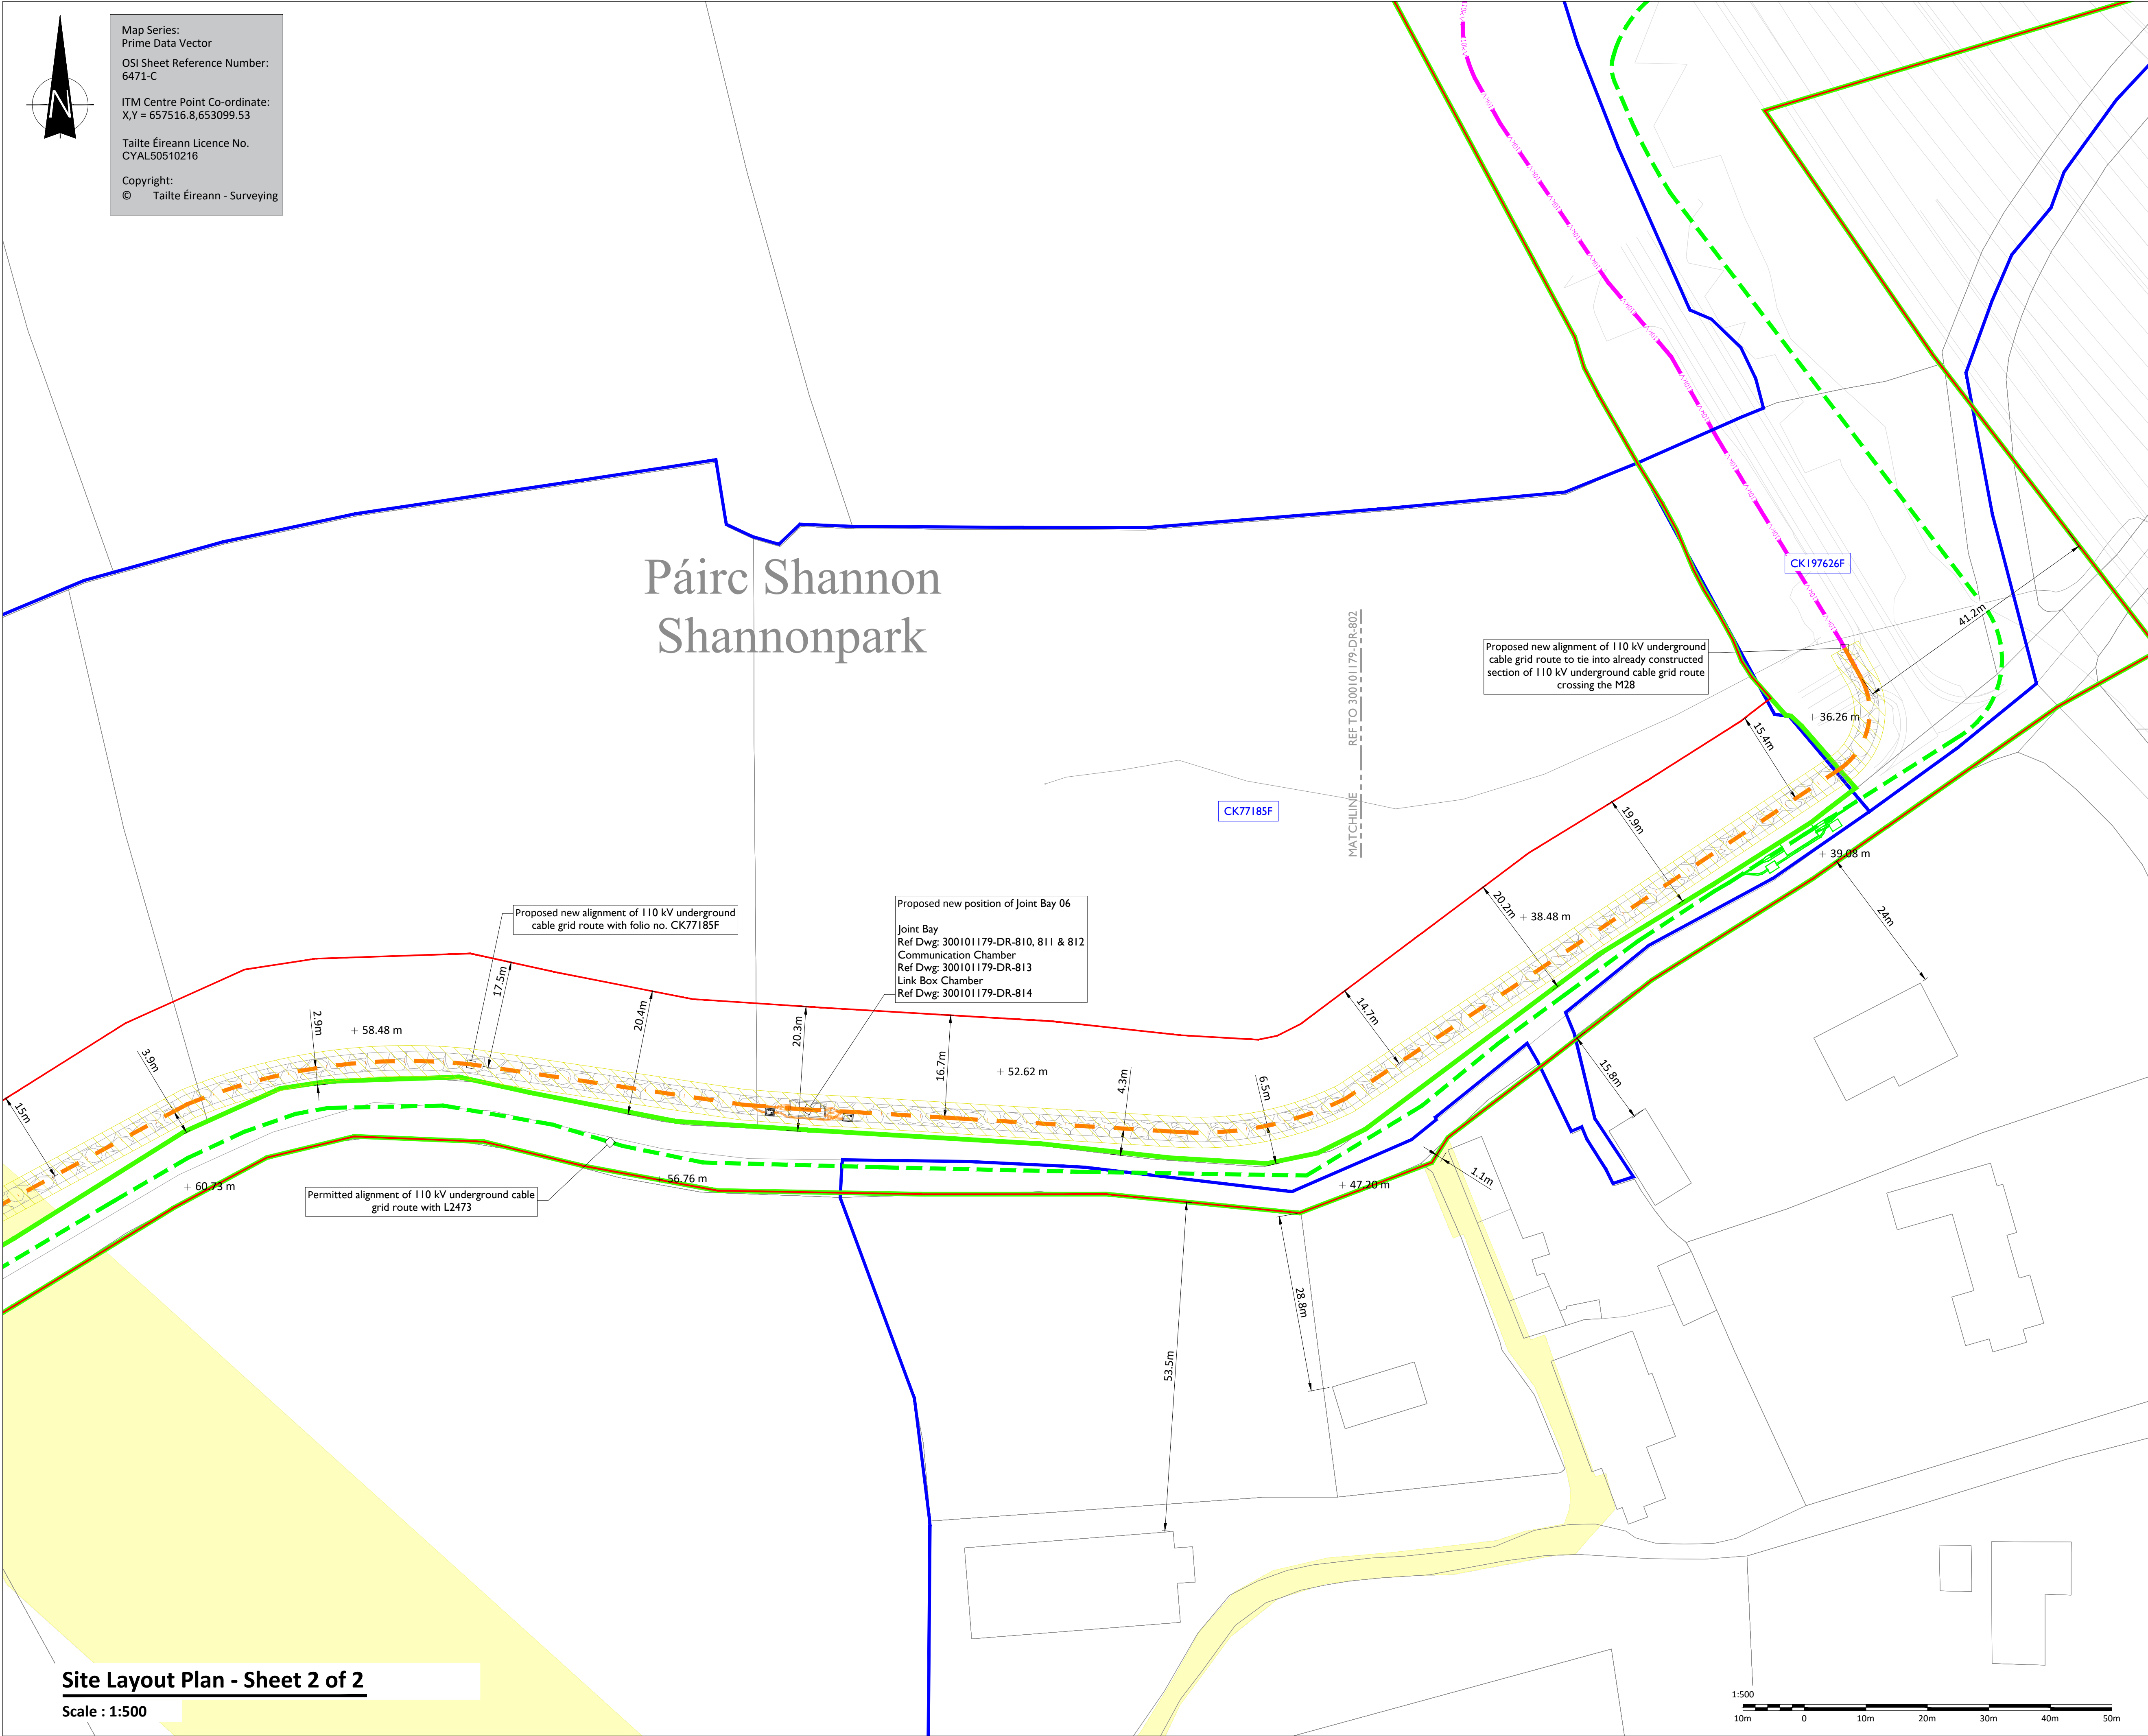

Head Office
Beenreigh,
Abbeydorney,
Tralee, Co. Kerry
Ireland
Tel: 00353 66 7135710

Regional Office
Basepoint Business Centre
Stroudley Road, Basingstoke,
Hampshire,
RG24 8UP, UK
Tel: 00 44 1256406664

PROJECT

Ballinrea 110kV Grid Route
S146B Alteration Application

CLIENT



CONSULTANTS

Issued for Planning Amendment
Not for Construction
02.03.2026

NOTES: -

- Path of cable route and location of associated Joint Bays, Link Boxes and Comms Chambers may vary depending on site conditions and following detailed design. Deviations will remain within the planning boundary at all times.
- Other services may be encountered along the route.
- Final levels may vary depending on local ground condition.

LEGEND: -

- Proposed Planning Amendment
Red Line Boundary
- Permitted Planning Application
Boundary
- Consented Third Party Landowner
Boundary
- Permitted 110 kV Underground
Cable Grid Route
- Proposed 110 kV Underground
Cable Grid Route Amendment
- Built 110 kV Underground
Cable Grid Route
- Proposed 3 m Wide Permanent
Access Track
- Statutory Wayleave in Respect
of the 110 kV Cable Route
Spot Height
+ 47.20 m
- Existing Wayleave

ISSUE/REVISION

I/R	DATE	DESCRIPTION
P5	02.03.26	Issued for Planning Amendment
P4	25.02.26	Issued for Planning Amendment
P3	09.02.26	Issued for Planning Amendment
P2	03.02.26	Issued for Planning Amendment
P1	12.12.25	Issued for Planning Amendment

PROJECT NUMBER

300-101179

SHEET TITLE

Site Layout Plan
Sheet 2 of 2

SHEET NUMBER

300101179-DR-803

Site Layout Plan - Sheet 2 of 2

Scale : 1:500