
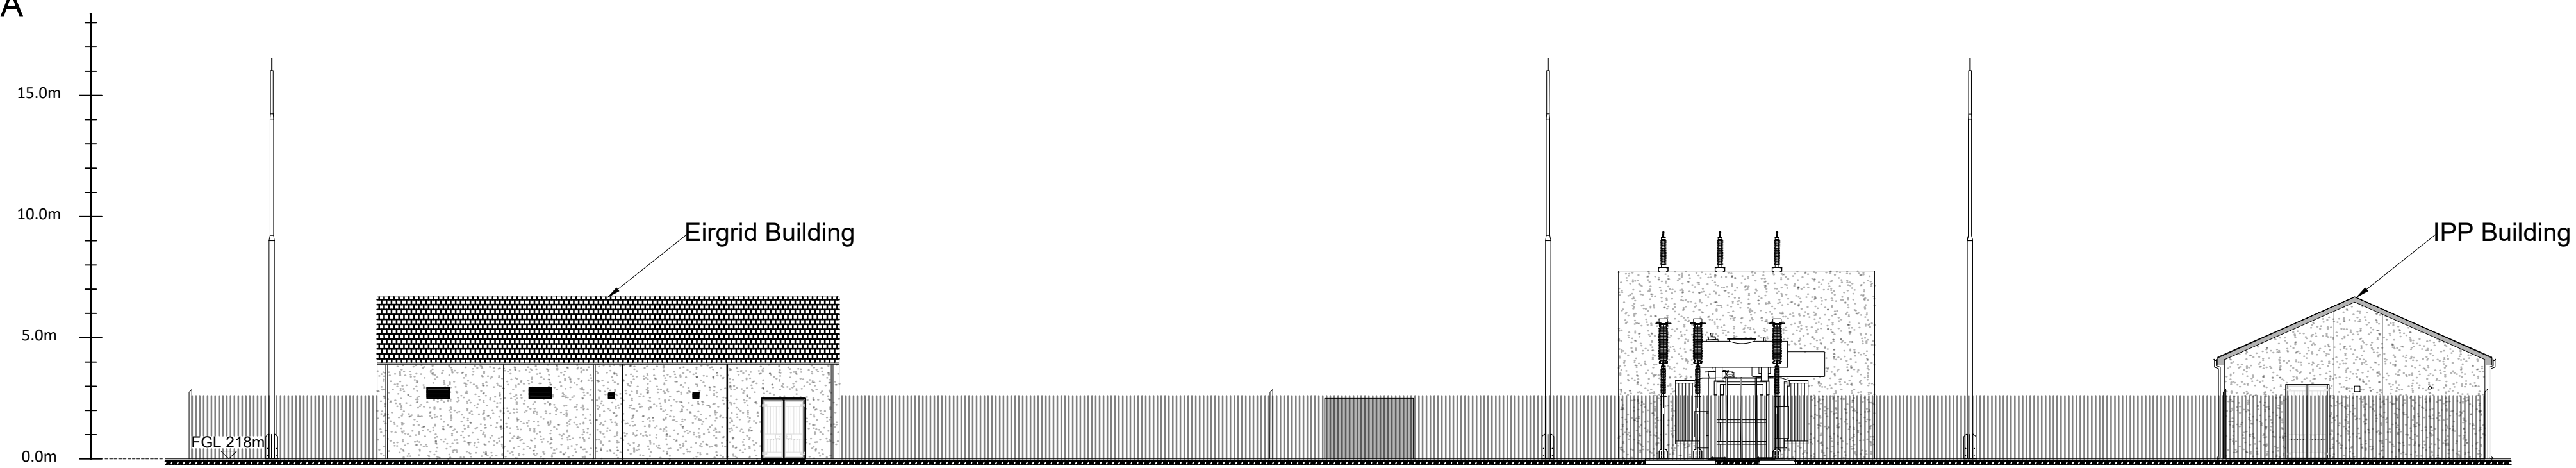
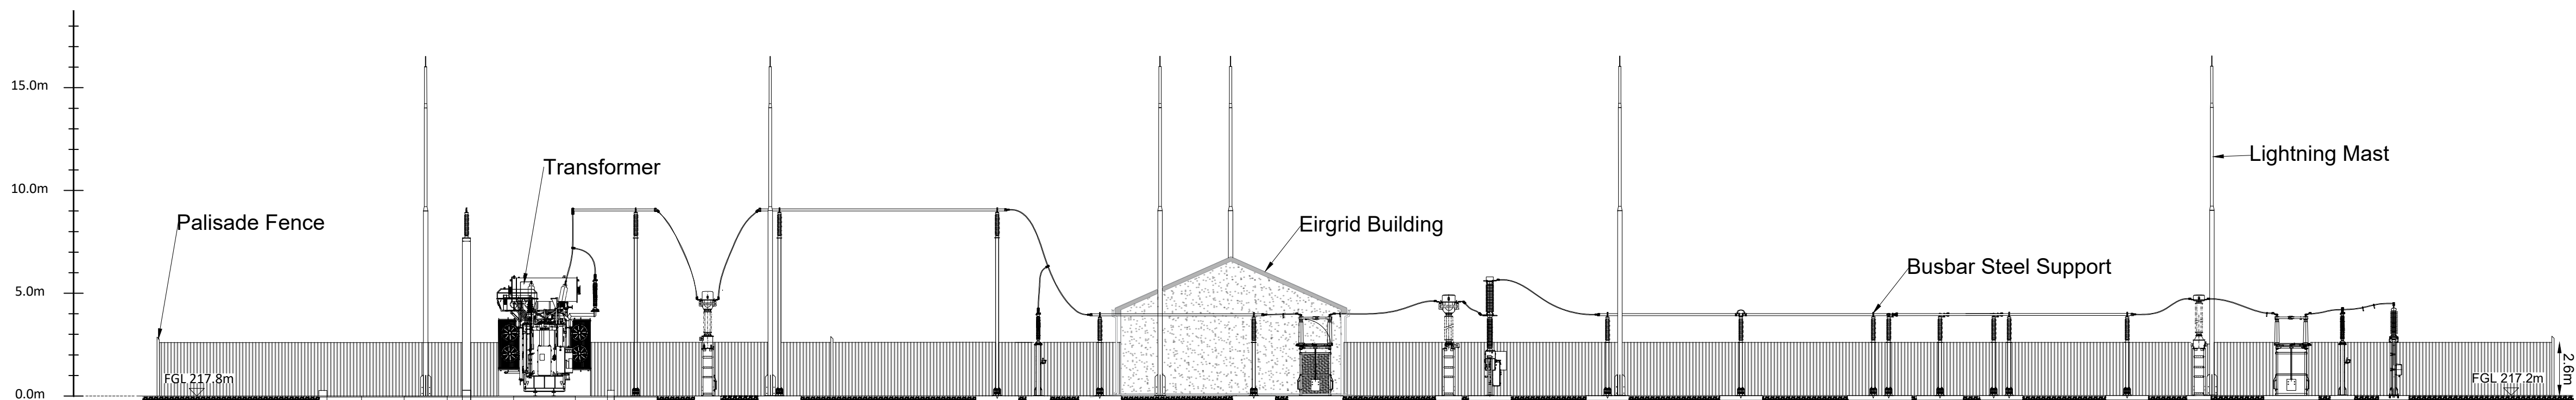


- NOTES
1. ALL DIMENSIONS IN METRES UNLESS OTHERWISE STATED.
 2. DRAWINGS ARE NOT TO BE SCALED.

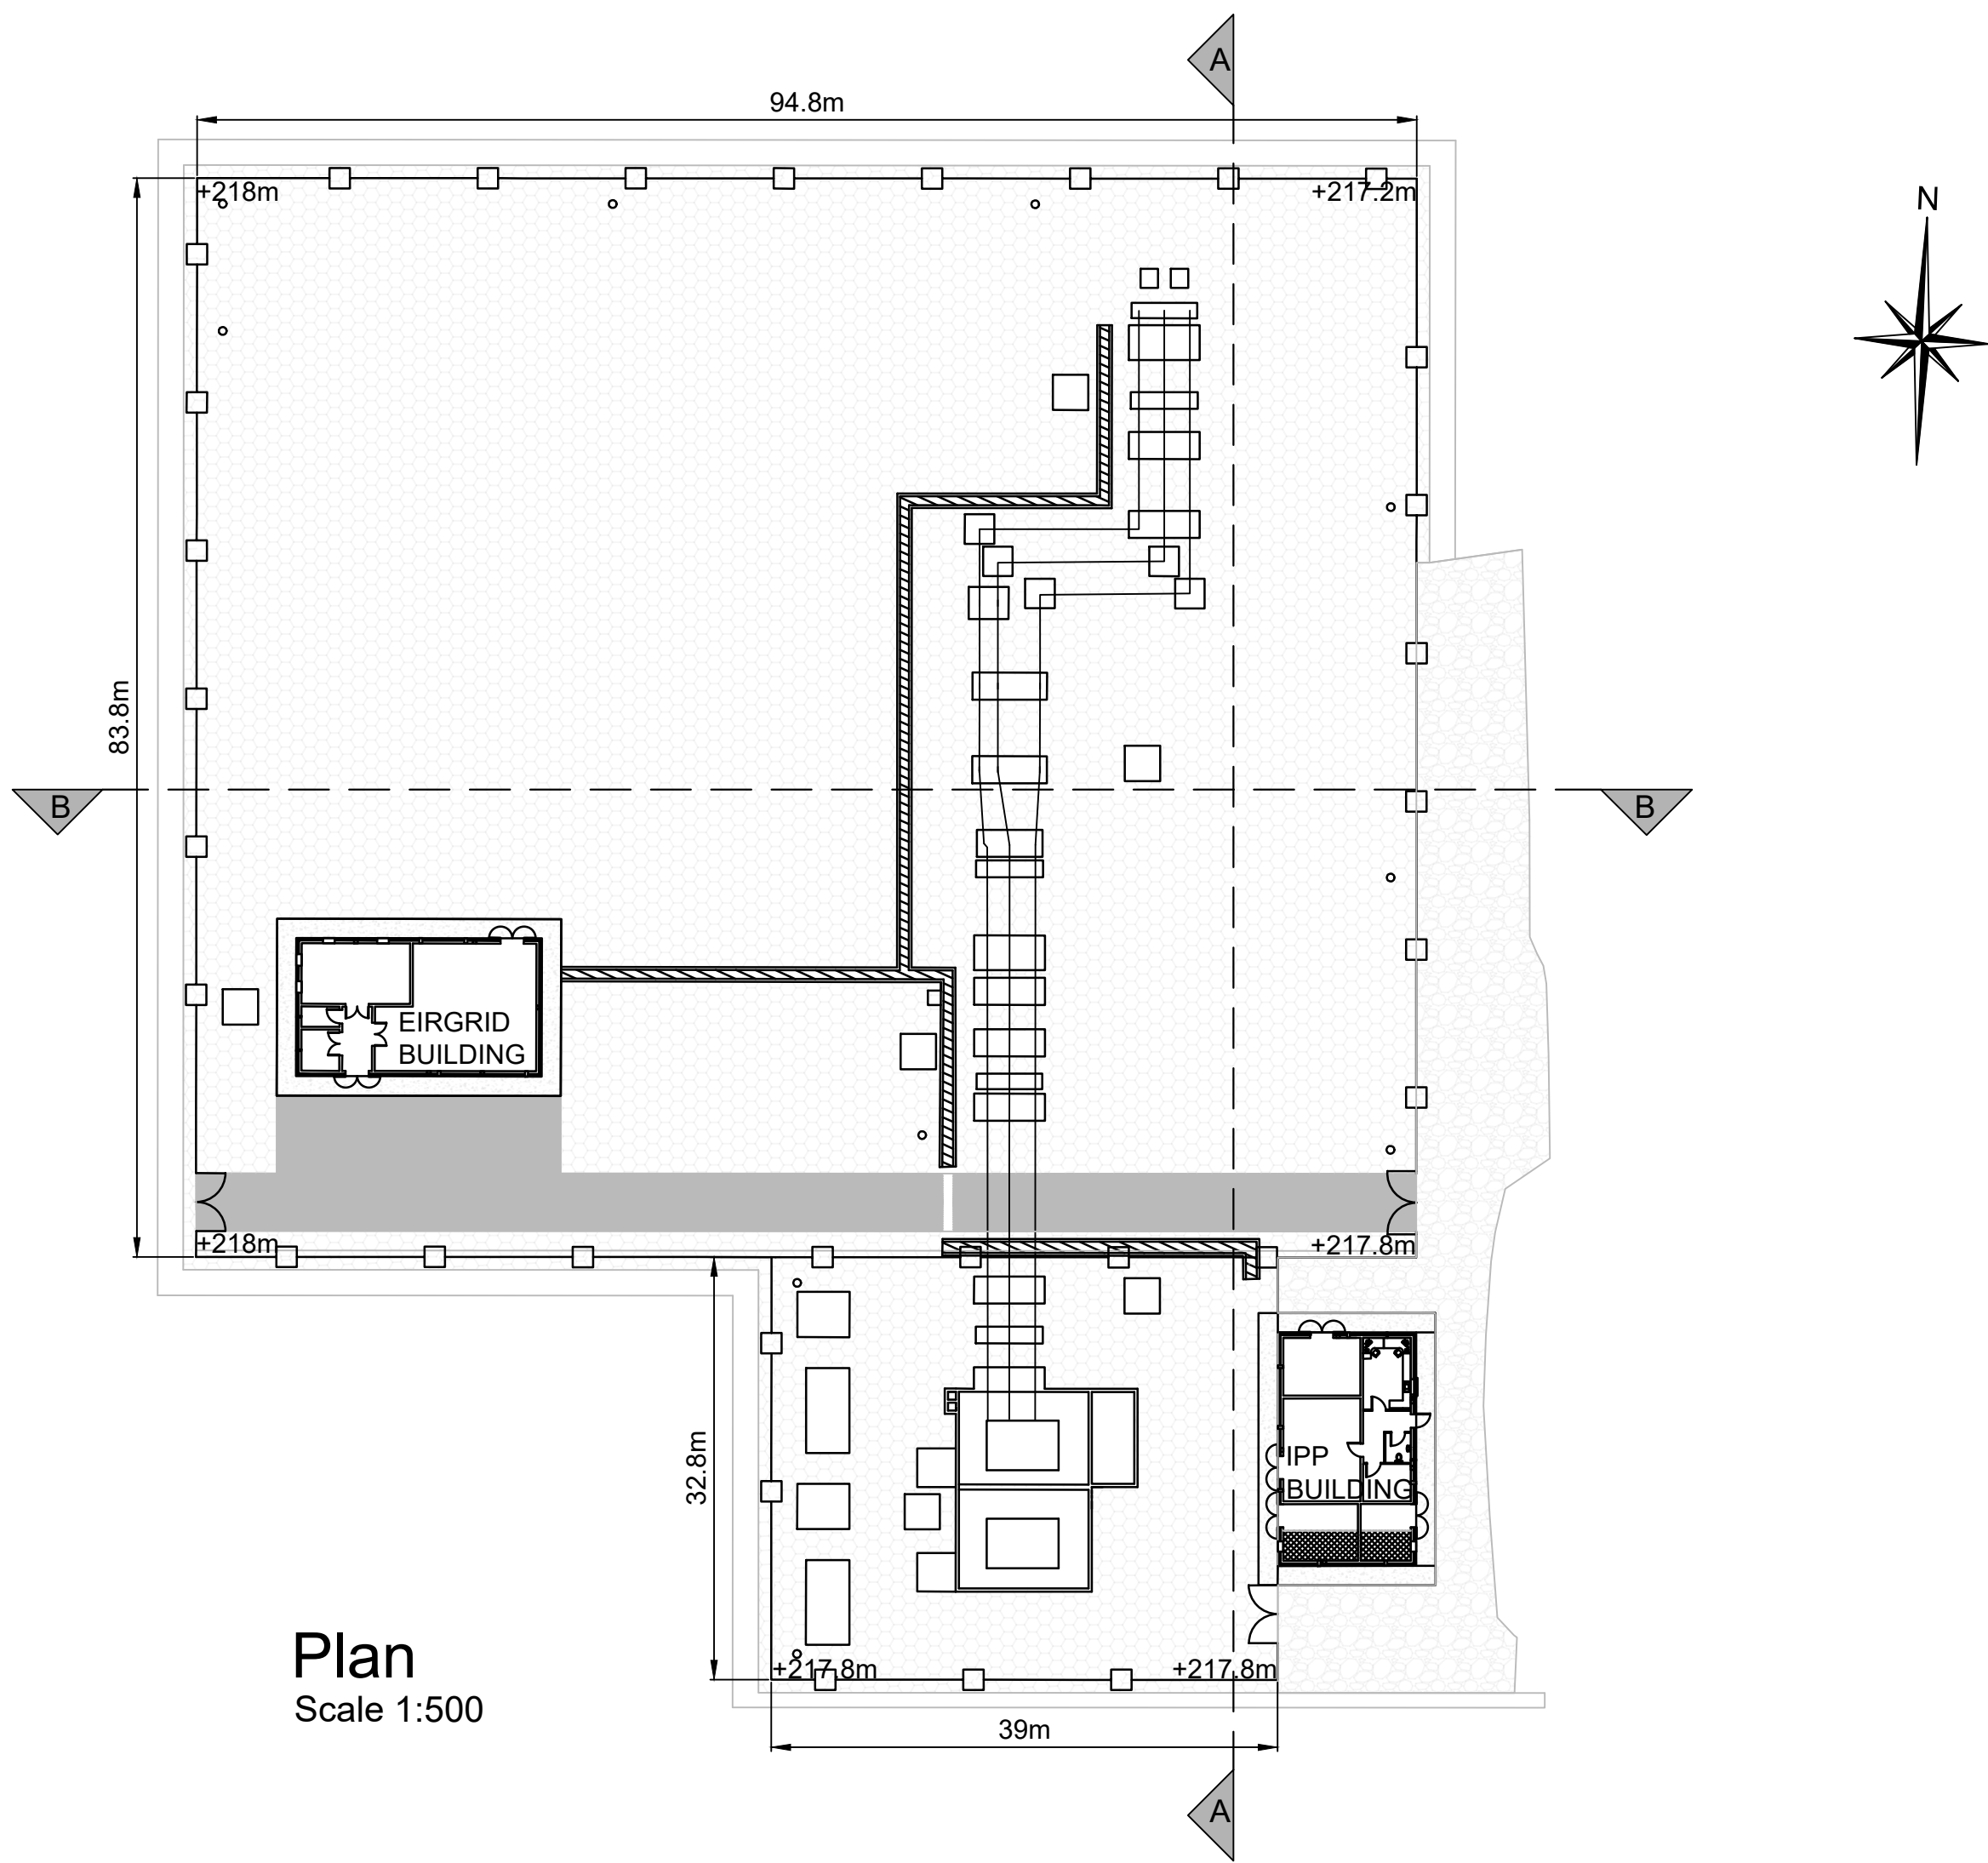

NOTES

REV	DATE	DRAWN BY	CHECKED BY	DETAILS
A	23/06/2026	M.B.	L.P.	FIRST ISSUE

ENGINEER



AFRY Ireland Ltd.
The Hyde Building, The Park,
Carrickmines,
D18VC44
Ireland
Tel: +353 (0) 1 845 5031

CLIENT

PROJECT

MEENBOG WIND FARM

TITLE

ONSITE 110kV SUBSTATION COMPOUND
PLAN AND SECTIONS

REVISION

A

DRAWN BY
M. BROWNE

DATE
23/06/2026

PAPER SIZE
A1

SCALE
AS SHOWN

CHECKED AND APPROVED
L. POWER

DATE
23/06/2026

STATUS
EXISTING

DRAWING NUMBER
MNBG d004.2.1

Plotted: 2026/03/26 14:53:52
X:\3-80\110kV\Substation\Drawings\MNBG\Drawings\MNBG 0004 Substation\MNBG 0004.2 Substation Compound\MNBG 0004.2 Substation Compound_A4-B.pdf