
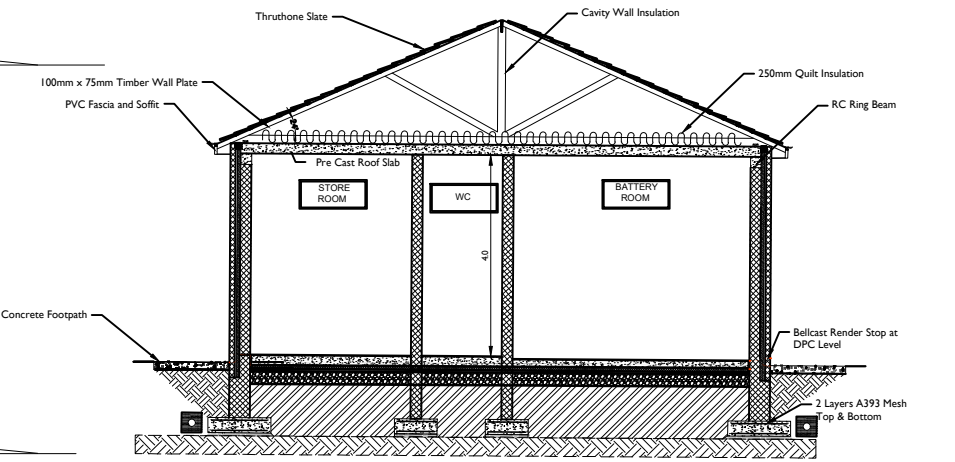
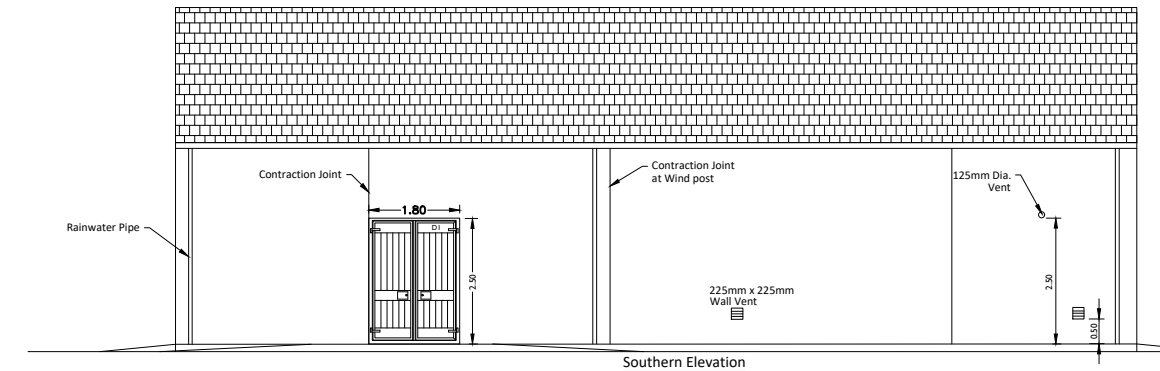
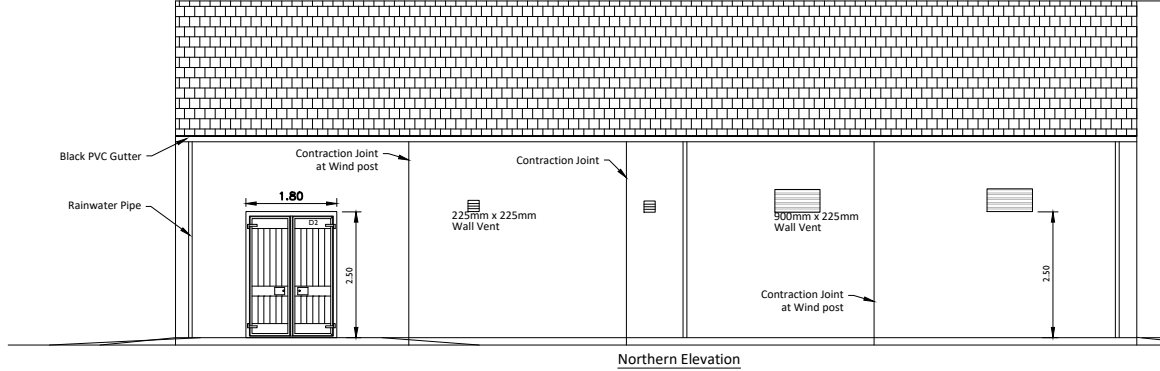
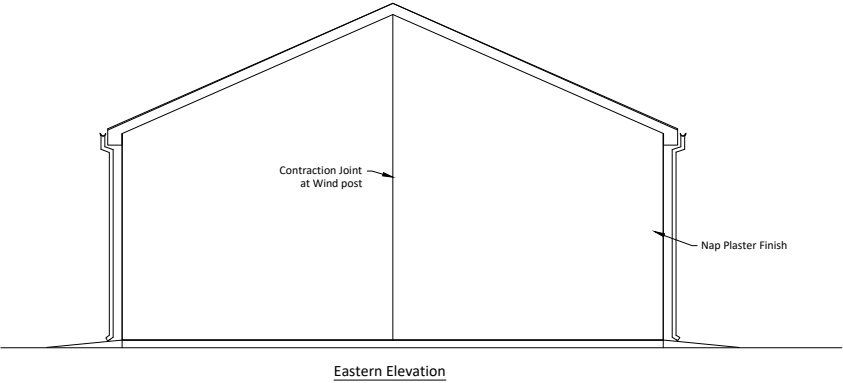
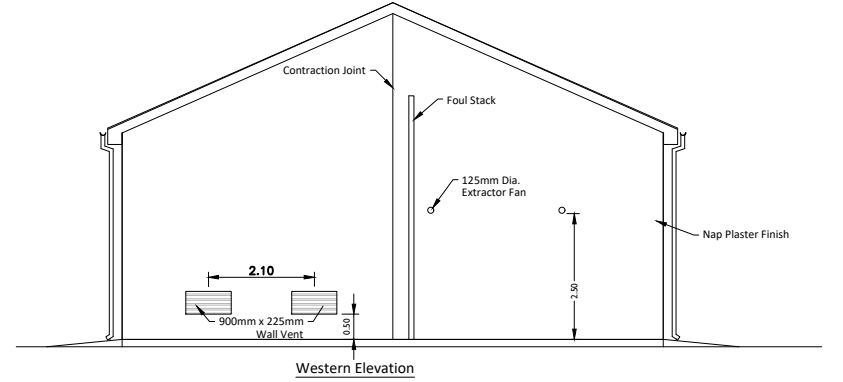


- NOTES:
- DRAWING NOT TO BE SCALED.
 - ALL DIMENSIONS IN METERS UNLESS NOTED OTHERWISE

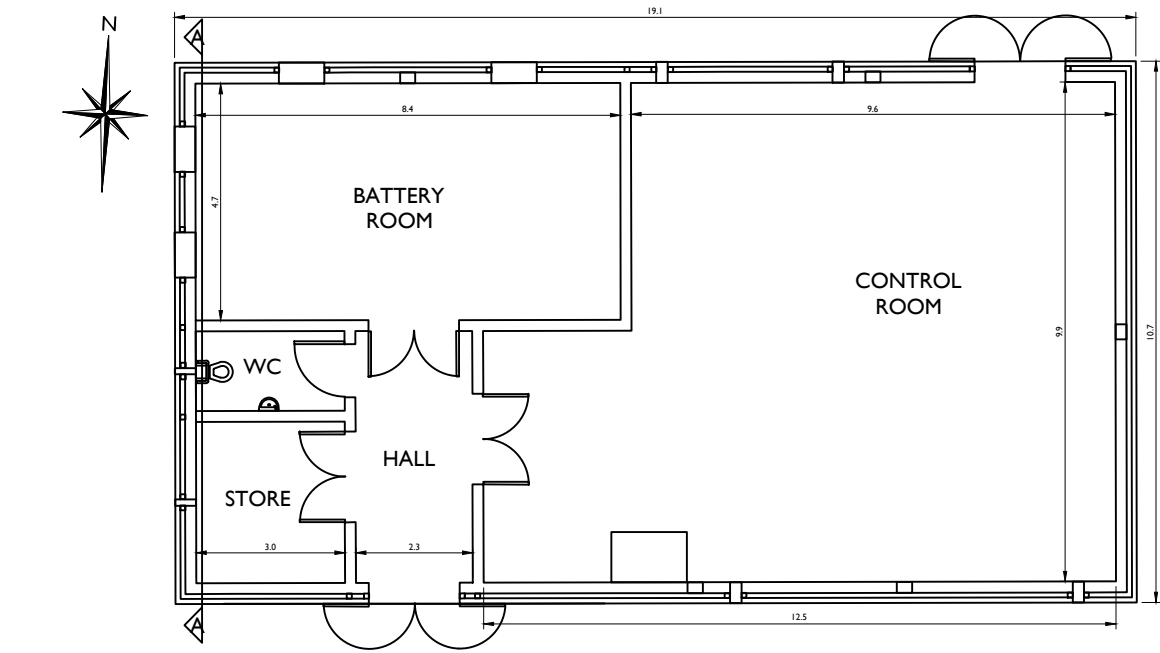

NOTES						ENGINEER		CLIENT		PROJECT	
						 AFRY Ireland Ltd. The Hyde Building, The Park, Carrickmines, D18VC44 Ireland Tel. +353 (0) 1 845 5031				MEENBOG WIND FARM	
DRAWN BY		DATE		PAPER SIZE		SCALE		TITLE		REVISION	
M BROWNE		23/06/2026		A3		1:150					
CHECKED AND APPROVED		DATE		STATUS		DRAWING NUMBER		EIRGRID BUILDING GENERAL ARRANGEMENT		A	
L. POWER		23/06/2026		EXISTING		MNBG.d004.3.1					
REV		DATE		DRAWN BY		CHECKED BY		DETAILS			