
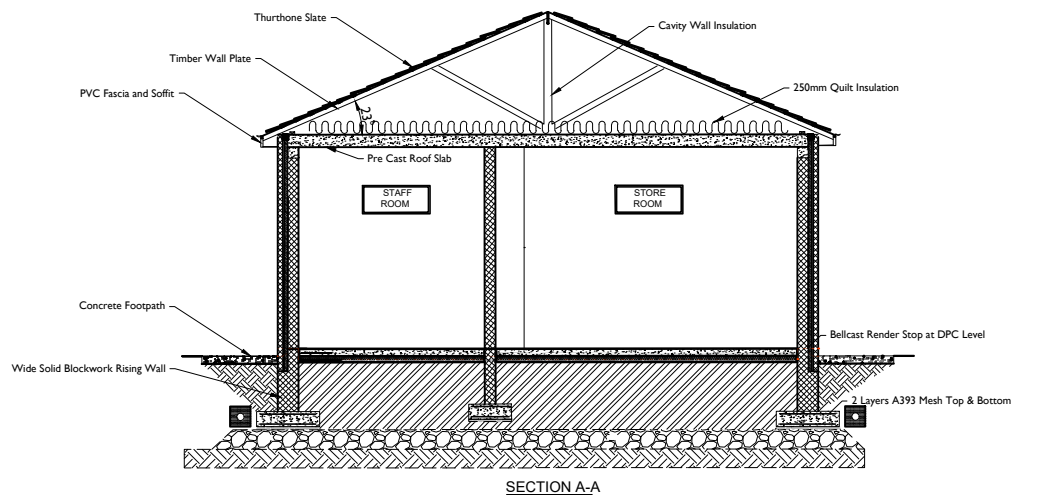
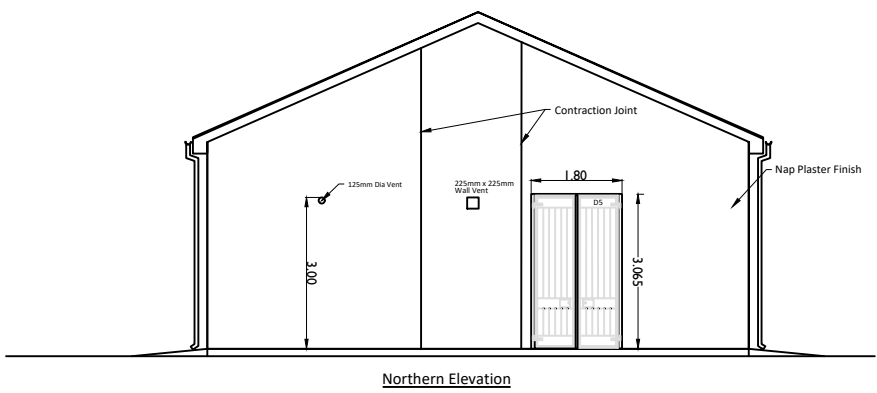
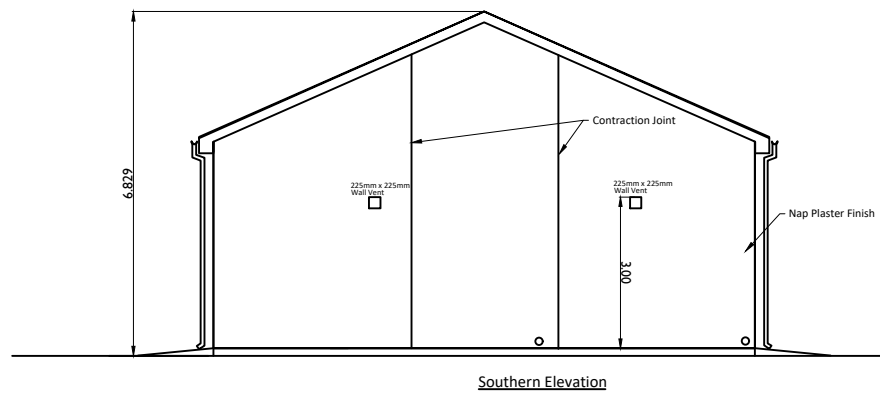
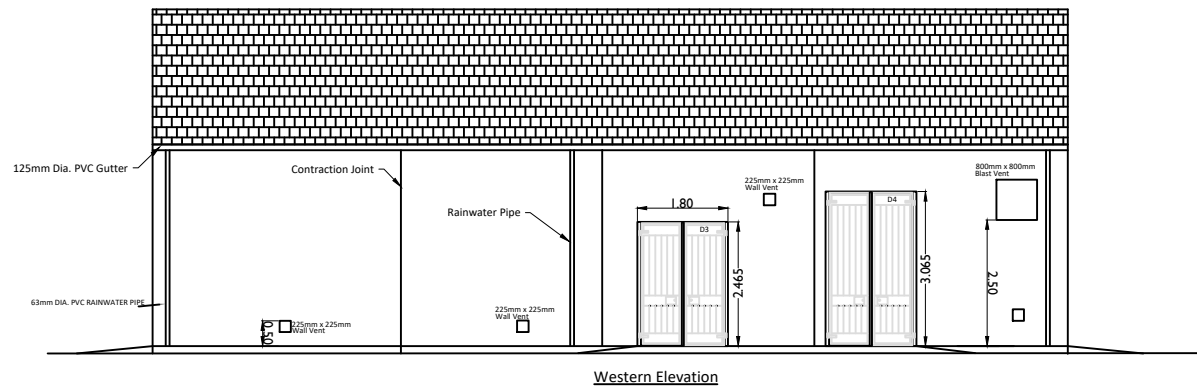
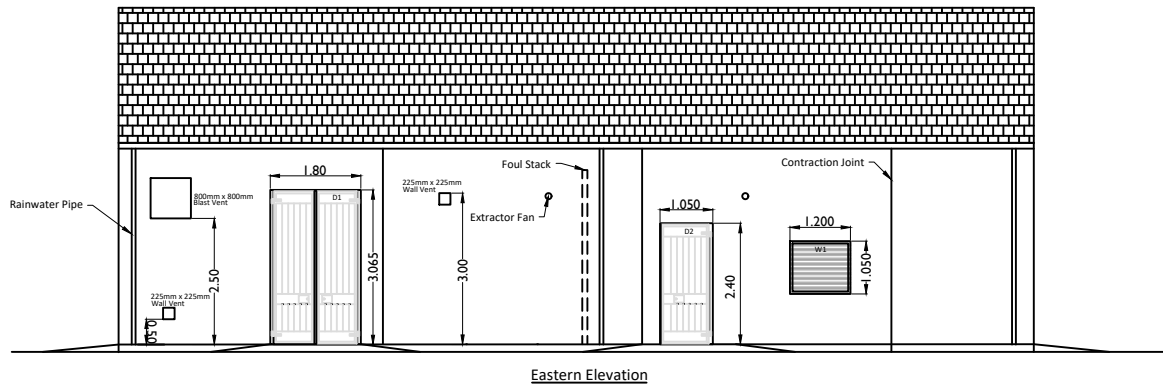


- NOTES:
- DRAWING NOT TO BE SCALED.
 - ALL DIMENSIONS ARE IN METERS UNLESS NOTED OTHERWISE

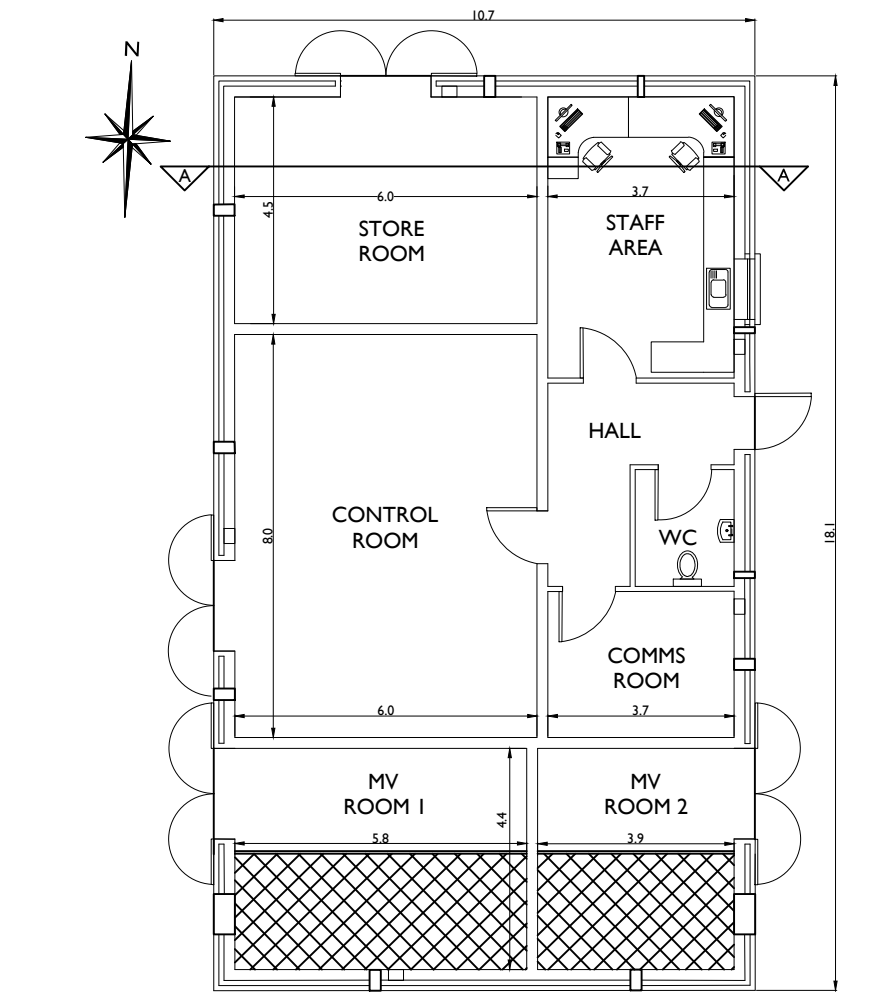

NOTES						ENGINEER		CLIENT		PROJECT	
								AFRY Ireland Ltd. The Hyde Building, The Park, Carrickmines, D18VC44 Ireland Tel. +353 (0) 1 845 5031		MEENBOG WIND FARM	
						DRAWN BY M. BROWNE		DATE 23/06/2026		PAPER SIZE A3	
						CHECKED AND APPROVED L. POWER		DATE 23/06/2026		SCALE 1:100	
								STATUS EXISTING		DRAWING NUMBER MNBG d004.6.1	
										REVISION A	
REV	DATE	DRAWN BY	CHECKED BY	DETAILS							
A	23/06/2026	M.B.	L.P.	FIRST ISSUE							