



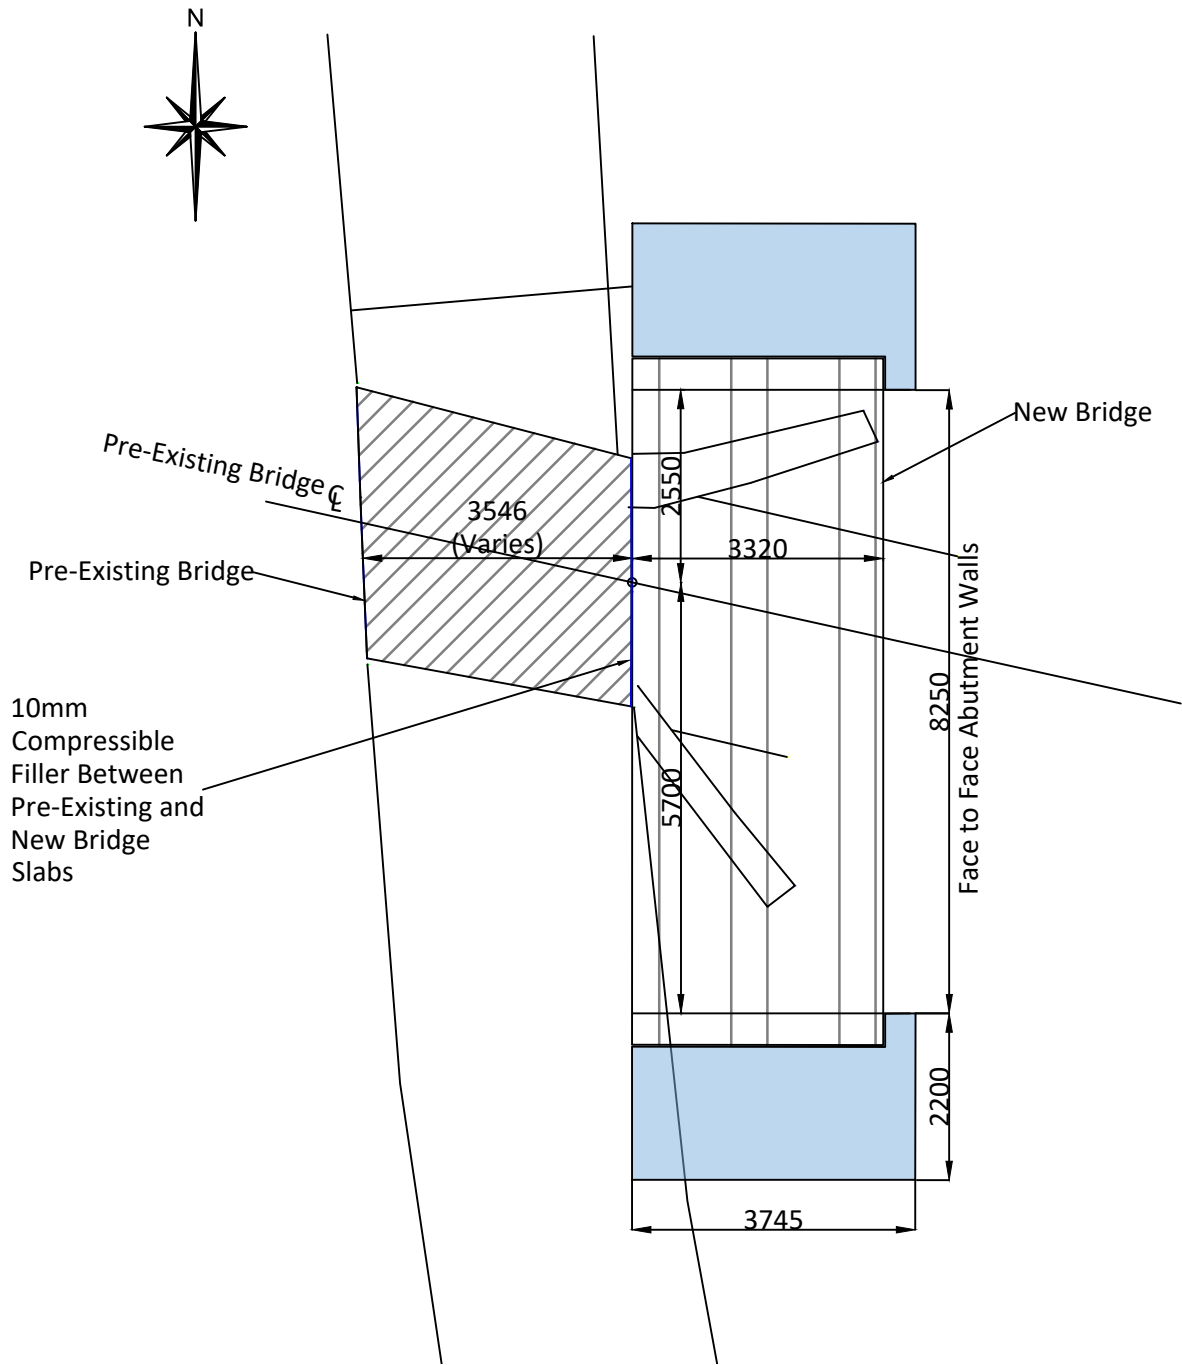

PLAN ON NEW/PRE-EXISTING BRIDGE (EC5)
Scale 1:100

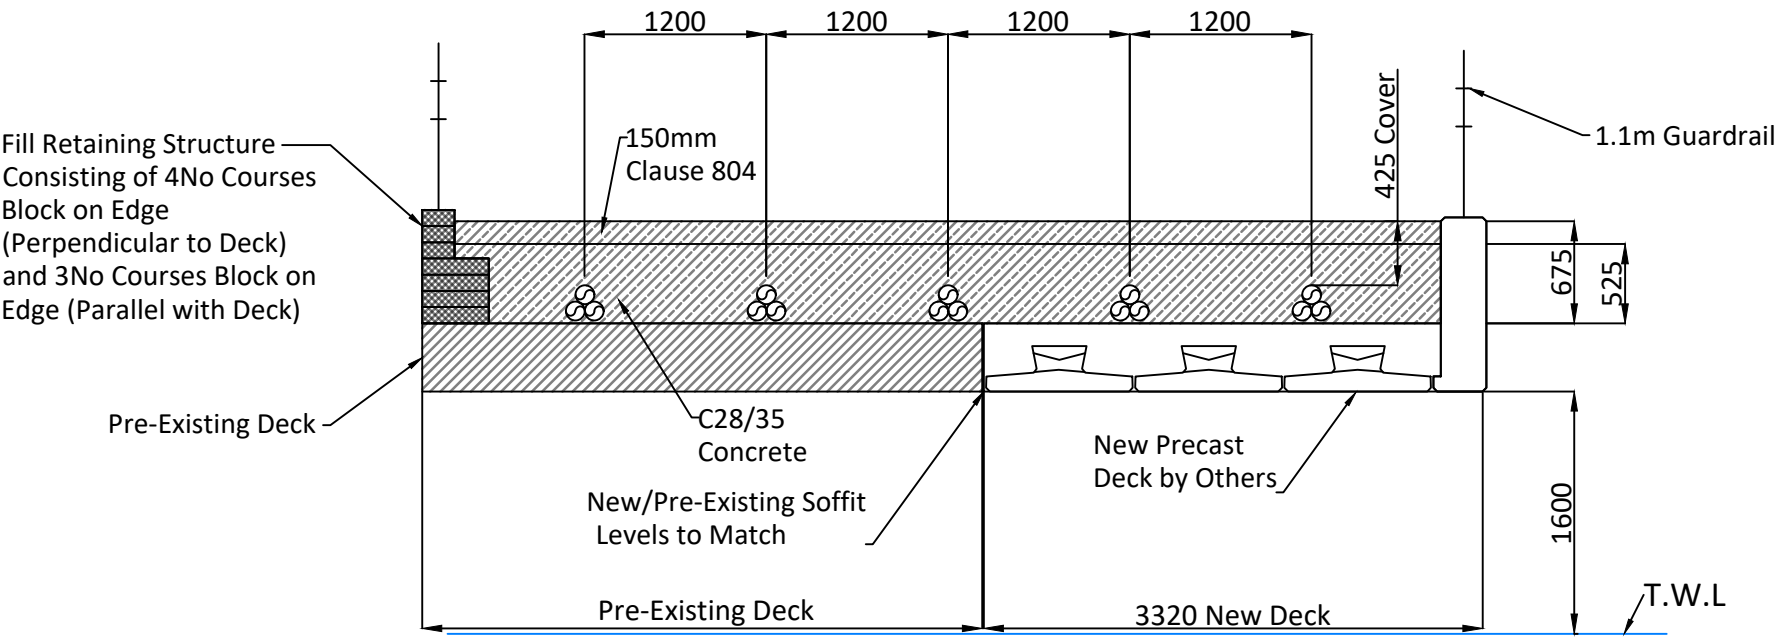

SECTION THROUGH CENTRELINE OF NEW/PRE-EXISTING BRIDGE
(EC5)

- NOTES
1. ALL DIMENSIONS ARE IN MILLIMETERS, UNLESS NOTED OTHERWISE.
 2. FIGURED DIMENSIONS ONLY TO BE USED, DRAWINGS NOT TO BE SCALED.

NOTES						ENGINEER  AFRY AFRY Ireland Ltd. The Hyde Building, The Park, Carrickmines, D18VC44 Ireland Tel. +353 (0) 1 845 5031	CLIENT		PROJECT MEENBOG WIND FARM			
						DRAWN BY M. BROWNE	DATE 23/06/2026	PAPER SIZE A3	SCALE 1:100	TITLE UPGRADED BRIDGE DETAILS EC5	REVISION A	
						CHECKED AND APPROVED L. POWER	DATE 23/06/2026	STATUS EXISTING				DRAWING NUMBER MNBG d008.1.3
	REV	DATE	DRAWN BY	CHECKED BY	DETAILS							
	A	23/06/2026	M.B.	L.P.	FIRST ISSUE							
AFRY Ireland Ltd. Carrickmines, D18VC44 Ireland Tel. +353 (0) 1 845 5031 MEENBOG WIND FARM UPGRADED BRIDGE DETAILS EC5 MNBG d008.1.3 EXISTING REVISION A												