


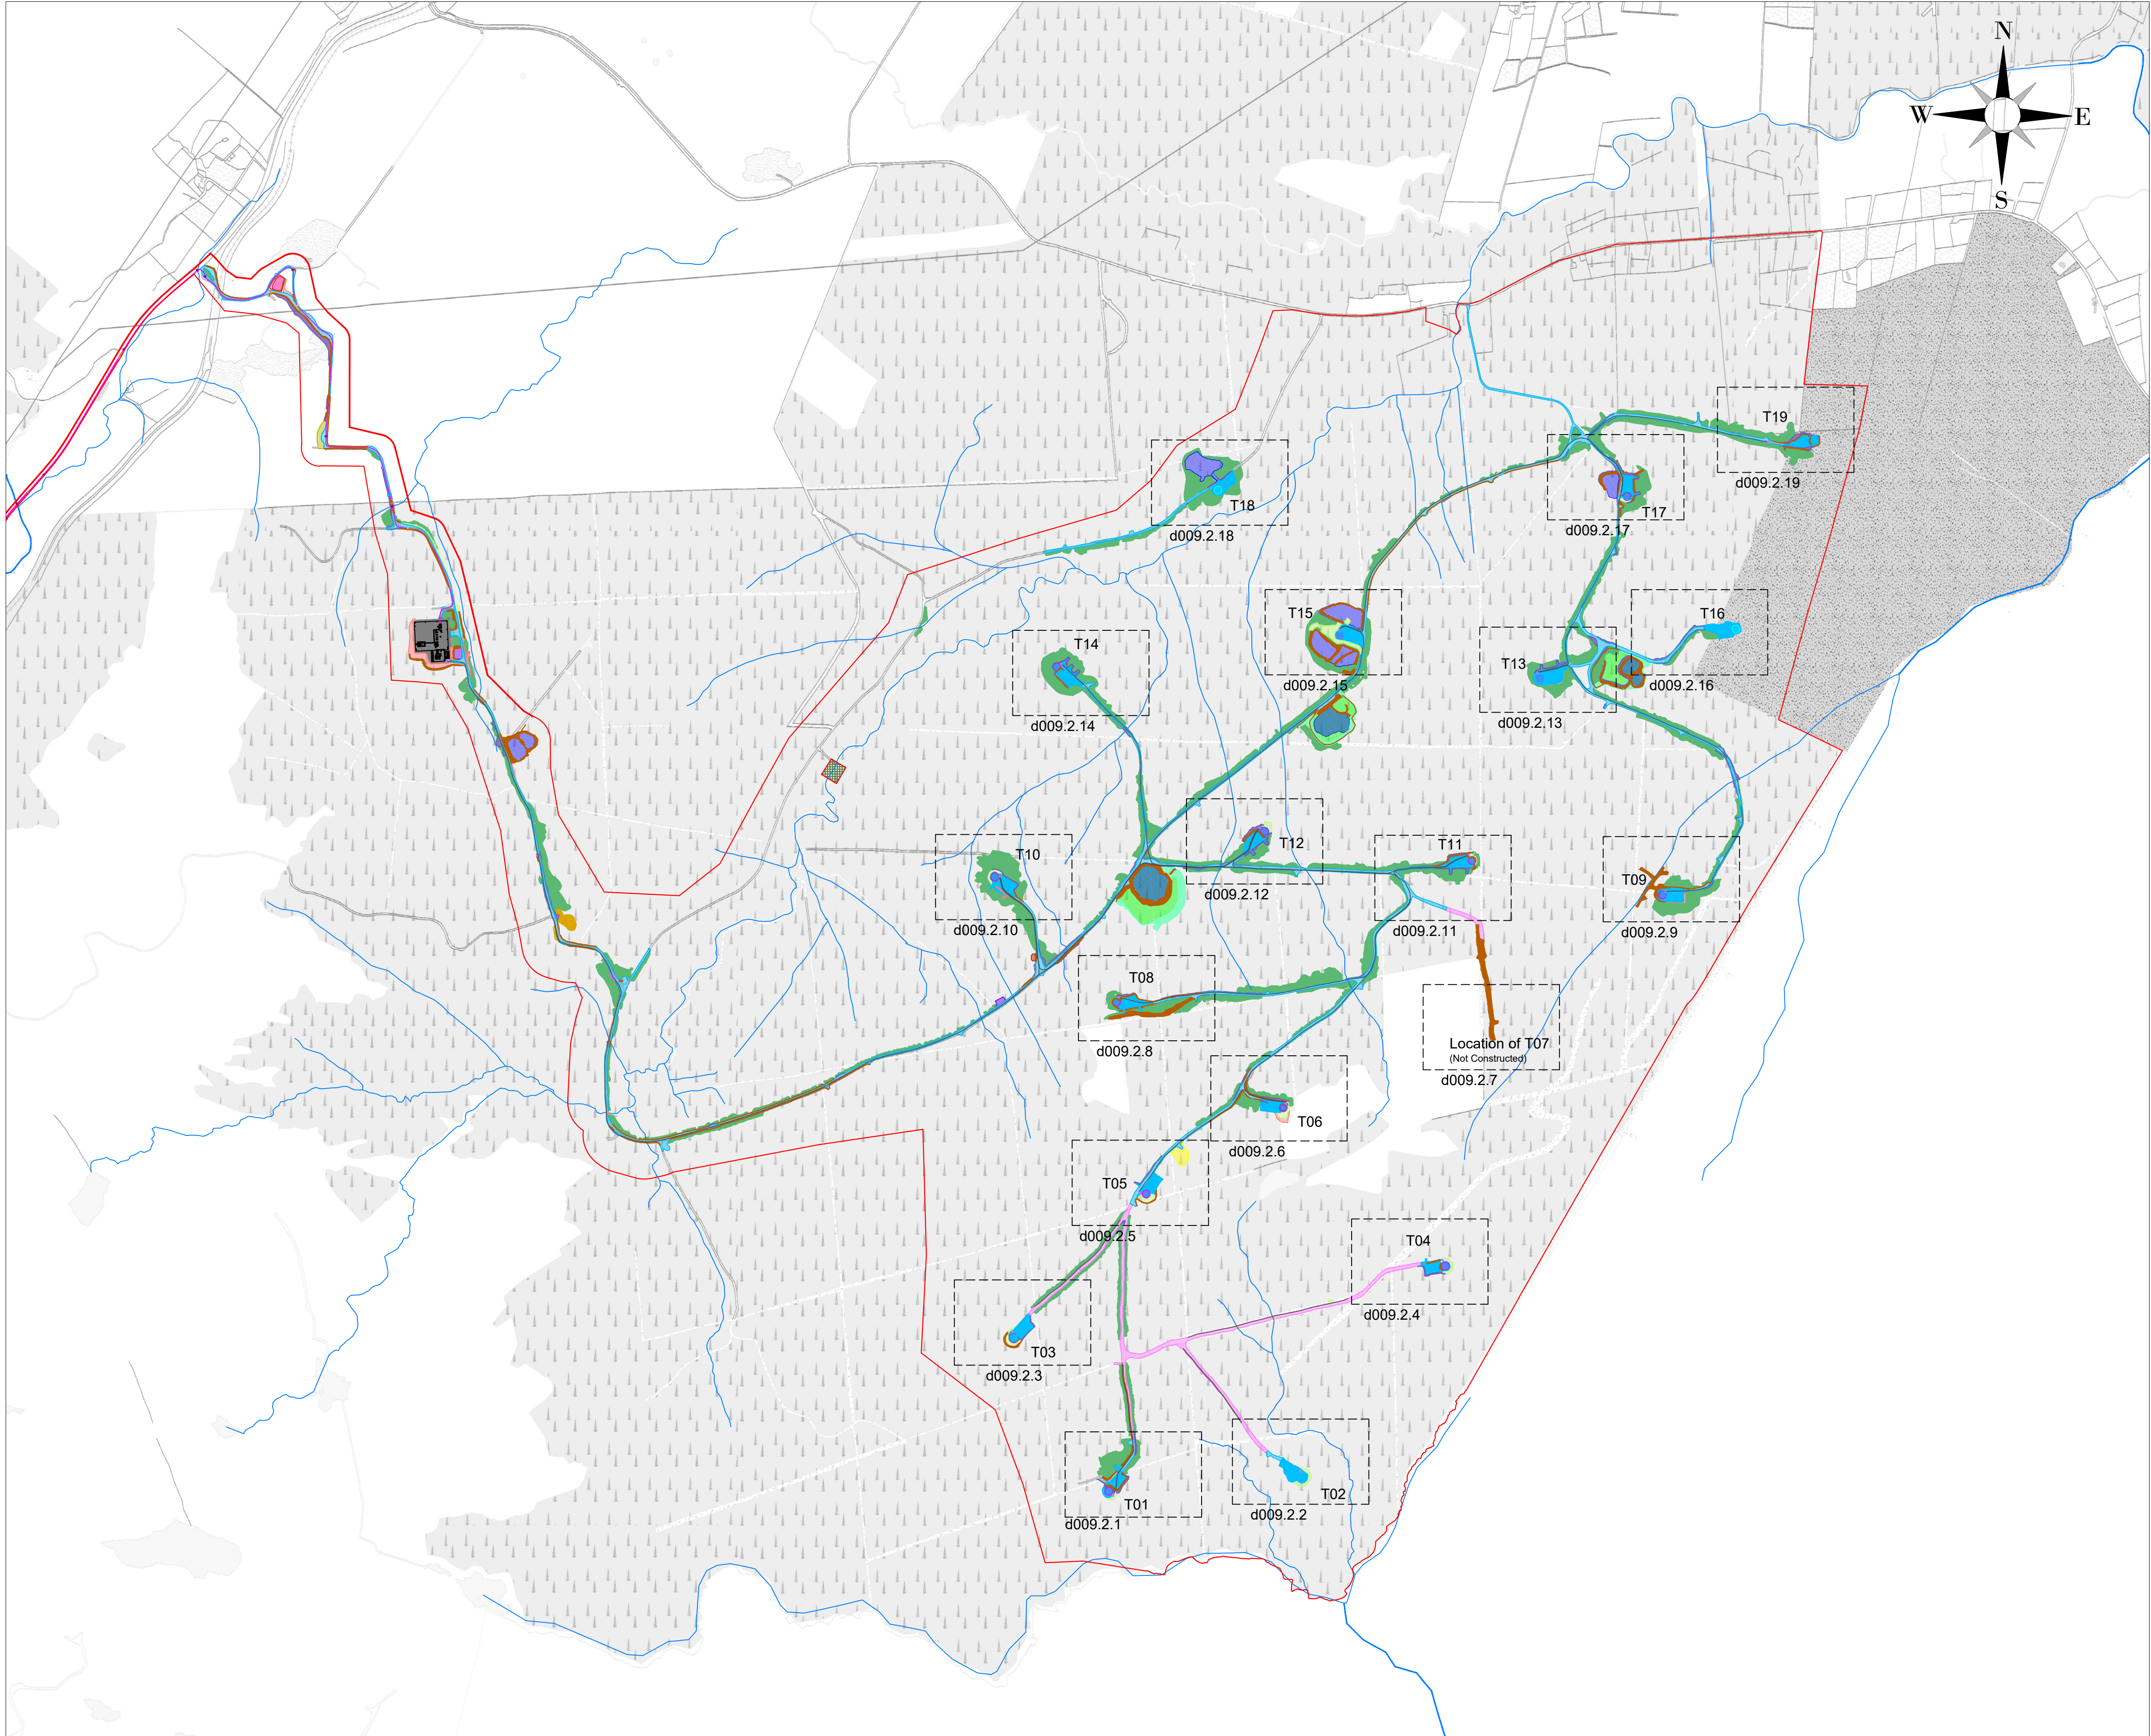

Turbine	ITM COORDINATES		Top of Foundation Elevation (mOD)
	Easting	Northing	
T1	607083	884169	287
* T2	607639	884209	269
T3	606809	884614	316
T4	608056	884820	306
T5	607191	885029	305
T6	607587	885277	293
* T7	608211	885488	258
T8	607105	885583	252
T9	608682	885893	234
T10	606753	885946	214
T11	608133	885993	256
T12	607533	886077	225
T13	608329	886520	222
T14	606933	886553	185
T15	607750	886642	185
* T16	608896	886662	214
T17	608581	887045	183
* T18	697398	887064	169
* T19	609123	887206	196

* Turbine Foundation Not Completed

NOTES

- These drawings have been prepared solely for planning application purposes.
- Copyright © AFRY Ireland. All rights reserved. No part of these drawings may be reproduced, stored, or transmitted in any form without the prior written consent of the copyright holder.
- Do not scale from these drawings. Only figured dimensions shown on the drawings shall be used.
- Existing and proposed levels shown are subject to confirmation and may vary depending on local ground conditions and detailed site investigations.

NOTES

A	04/06/2026	M.B.	L.P.	FIRST ISSUE
REV	DATE	DRAWN BY	CHECKED BY	DETAILS

ENGINEER



AFRY Ireland Ltd.
The Hyde Building, The Park,
Carrickmines,
D18VC44
Ireland
Tel: +353 (0) 1 845 5031

DRAWN BY
M. BROWNE

CHECKED AND APPROVED
L. POWER

DATE
04/06/2026

DATE
04/06/2026

CLIENT

PAPER SIZE
A1

SCALE
1:10000

STATUS
EXISTING

PROJECT

MEENBOG WIND FARM


TITLE
EXISTING DEVELOPMENT TURBINE LAYOUT
KEYPLAN

DRAWING NUMBER
MNBG d009.2.0

REVISION

A

- LEGEND**
- TURBINE BASE (SUBSTANTIALLY COMPLETE)
 - TURBINE BASE (PARTIALLY COMPLETE)
 - SOLID SITE ROADS
 - FLOATING SITE ROADS
 - PRE-EXISTING ROADS
 - ADDITIONAL AREAS
 - HARDSTANDS
 - AREAS OF CUT
 - AREAS OF FILL
 - SIDE CASTING
 - PEAT CELLS
 - STONE BERMS
 - FENCE
 - EXCAVATED BORROW PIT
 - BORROW PIT WORKING STRIP
 - TEMP. CONSTRUCTION AREA
 - PULL PIT LOCATION
 - AS BUILT DUCTING
 - RIVER / STREAM
 - PLANNING APPLICATION BOUNDARY

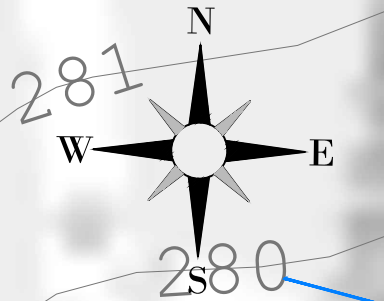

T01

- NOTES**
- These drawings have been prepared solely for planning application purposes. Copyright © AFRY Ireland. All rights reserved. No part of these drawings may be reproduced, stored, or transmitted in any form without the prior written consent of the copyright holder.
 - Do not scale from these drawings. Only figured dimensions shown on the drawings shall be used.
 - Existing and proposed levels shown are subject to confirmation and may vary depending on local ground conditions and detailed site investigations.

NOTES

Ordnance Survey Ireland License No. EN 0051326
© Ordnance Survey Ireland/Government of Ireland
Sheet No's: 0451,0452,0453,0479,0480,0481,0507, 0508

REV	DATE	DRAWN BY	CHECKED BY	DETAILS
A	04/06/2026	M.B.	L.P.	FIRST ISSUE

ENGINEER



AFRY Ireland Ltd.
The Hyde Building, The Park,
Carrickmines,
D18VC44
Ireland
Tel: +353 (0) 1 845 5031

CLIENT

PROJECT

MEENBOG WIND FARM

EXISTING DEVELOPMENT TURBINE LAYOUT
TURBINE 1

REVISION

A

DRAWN BY
M. BROWNE

DATE
04/06/2026

PAPER SIZE
A1

SCALE
1:500

CHECKED AND APPROVED
L. POWER



DATE
04/06/2026

STATUS
EXISTING

DRAWING NUMBER
MNBG d009.2.1

Revised: 2026/03/26 12:41:58
C:\3-ROUTE\Drawings\Proposed\Meenbog\MNBG\Drawings\MNBG_0009_Existing_Turbine Layout.dwg

- LEGEND**
- TURBINE BASE (SUBSTANTIALLY COMPLETE)
 - TURBINE BASE (PARTIALLY COMPLETE)
 - SOLID SITE ROADS
 - FLOATING SITE ROADS
 - PRE-EXISTING ROADS
 - ADDITIONAL AREAS
 - HARDSTANDS
 - AREAS OF CUT
 - AREAS OF FILL
 - SIDE CASTING
 - PEAT CELLS
 - STONE BERMS
 - FENCE
 - EXCAVATED BORROW PIT
 - BORROW PIT WORKING STRIP
 - TEMP. CONSTRUCTION AREA
 - PULL PIT LOCATION
 - AS BUILT DUCTING
 - RIVER / STREAM
 - PLANNING APPLICATION BOUNDARY

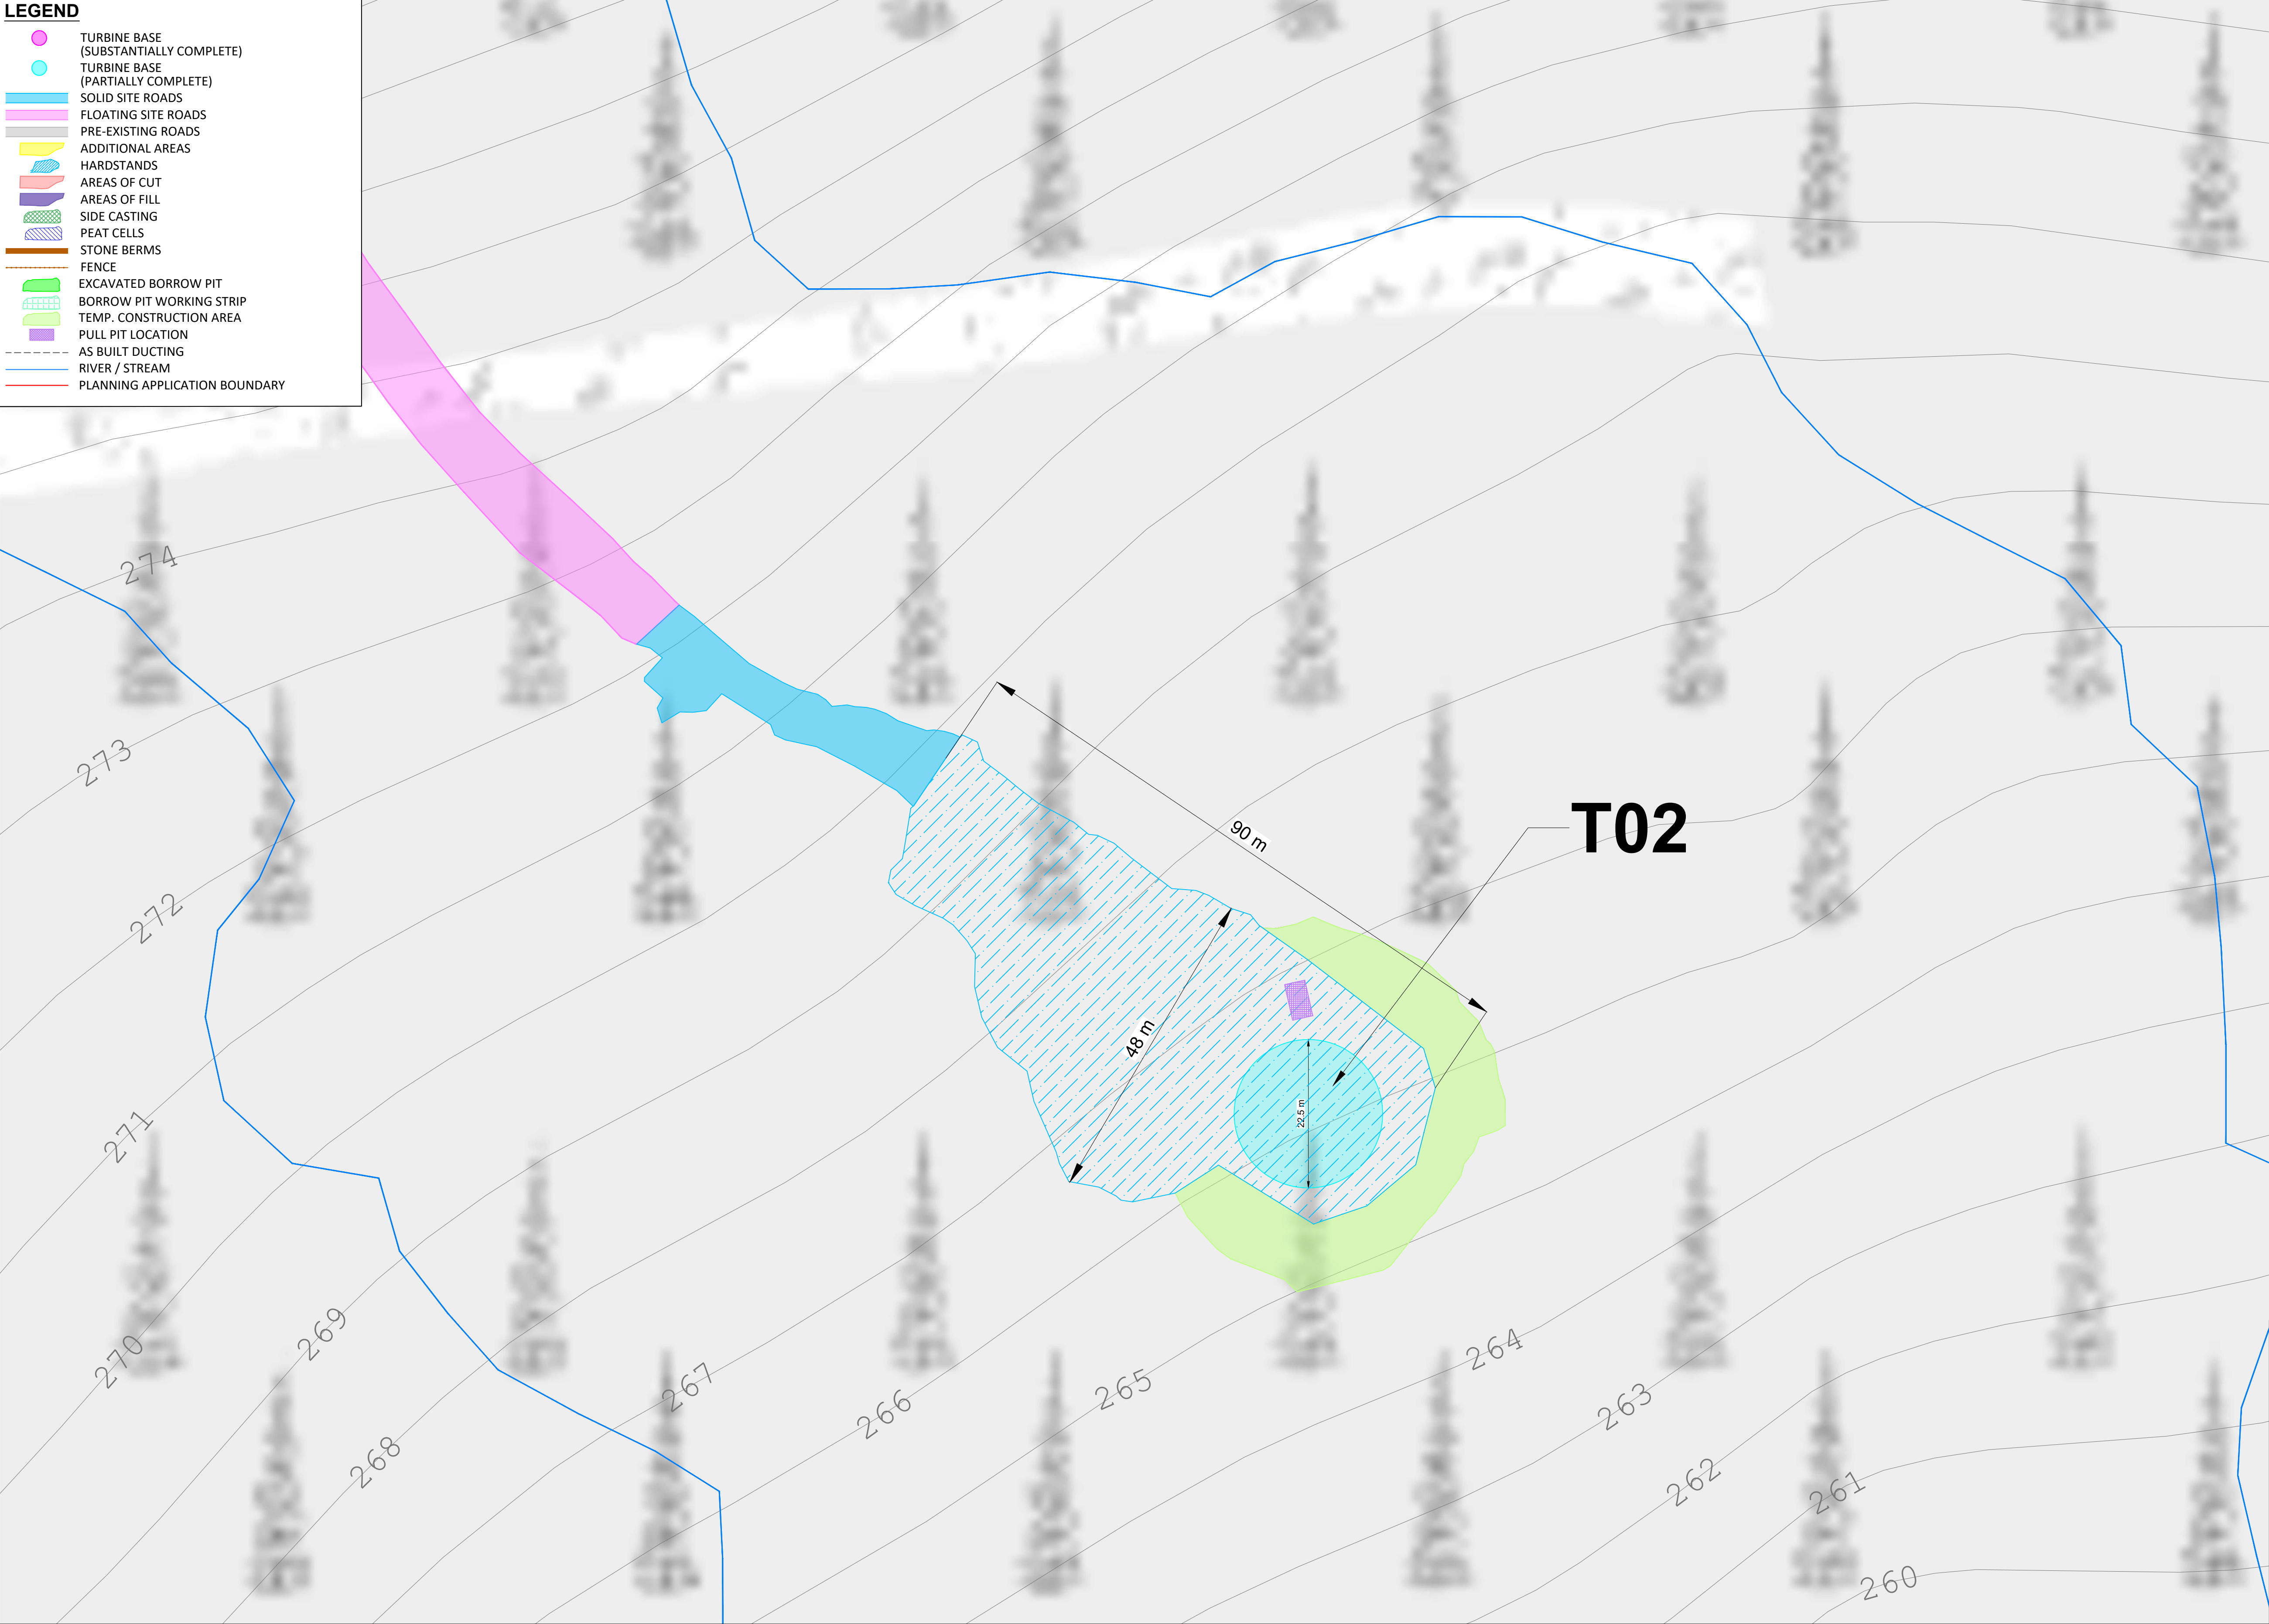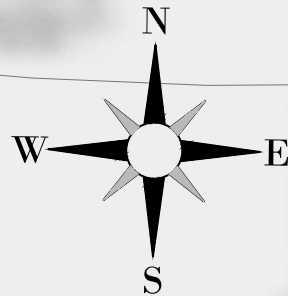

- NOTES**
- These drawings have been prepared solely for planning application purposes.
 - Copyright © AFRY Ireland. All rights reserved. No part of these drawings may be reproduced, stored, or transmitted in any form without the prior written consent of the copyright holder.
 - Do not scale from these drawings. Only figured dimensions shown on the drawings shall be used.
 - Existing and proposed levels shown are subject to confirmation and may vary depending on local ground conditions and detailed site investigations.

NOTES

Ordnance Survey Ireland License No. EN 0051326
© Ordnance Survey Ireland/Government of Ireland
Sheet No's: 0451,0452,0453,0479,0480,0481,0507, 0508

REV	DATE	DRAWN BY	CHECKED BY	DETAILS
A	04/06/2026	M.B.	L.P.	FIRST ISSUE

ENGINEER



AFRY Ireland Ltd.
The Hyde Building, The Park,
Carrickmines,
D18VC44
Ireland
Tel: +353 (0) 1 845 5031

DRAWN BY
M. BROWNE

DATE
04/06/2026

CHECKED AND APPROVED
L. POWER

DATE
04/06/2026

CLIENT

PROJECT

MEENBOG WIND FARM

TITLE

EXISTING DEVELOPMENT TURBINE LAYOUT
TURBINE 2

REVISION



A

DRAWING NUMBER

MNBG d009.2.2

Printed: 2026/06/06 12:01:06
C:\3-ROUTE\Drawings\Proposed\Meenbog\MNBG\Drawings\MNBG_0009_ExistingLayout.dwg (MNBG_0009_2_Turbine Layout.dwg)

- LEGEND**
- TURBINE BASE (SUBSTANTIALLY COMPLETE)
 - TURBINE BASE (PARTIALLY COMPLETE)
 - SOLID SITE ROADS
 - FLOATING SITE ROADS
 - PRE-EXISTING ROADS
 - ADDITIONAL AREAS
 - HARDSTANDS
 - AREAS OF CUT
 - AREAS OF FILL
 - SIDE CASTING
 - PEAT CELLS
 - STONE BERMS
 - FENCE
 - EXCAVATED BORROW PIT
 - BORROW PIT WORKING STRIP
 - TEMP. CONSTRUCTION AREA
 - PULL PIT LOCATION
 - AS BUILT DUCTING
 - RIVER / STREAM
 - PLANNING APPLICATION BOUNDARY

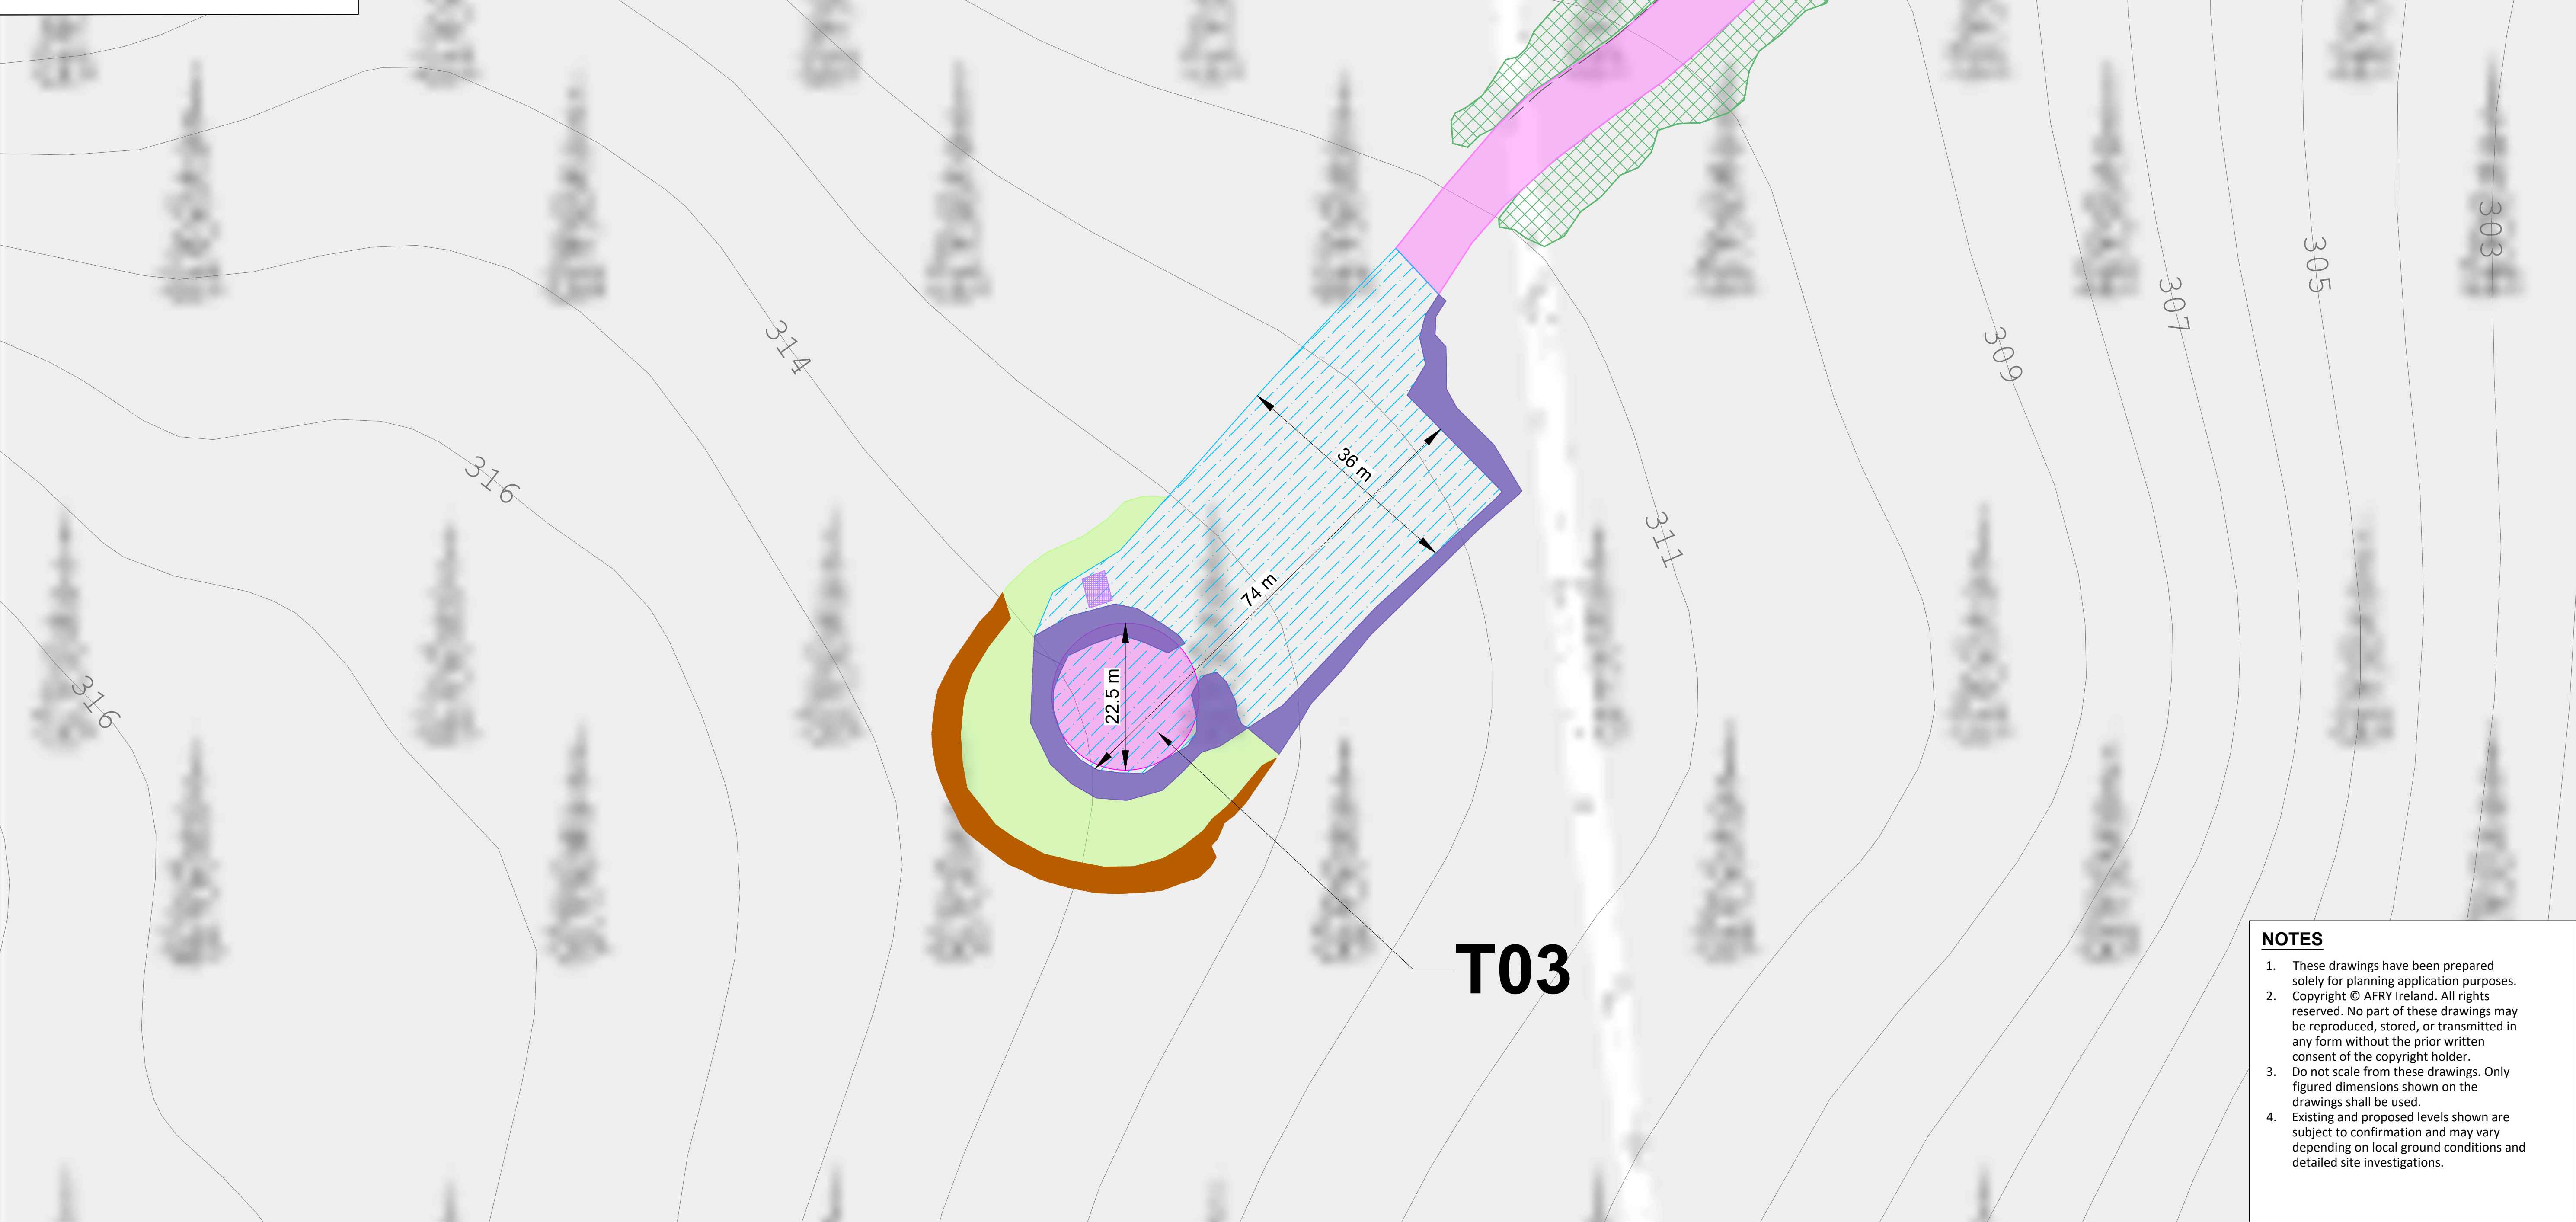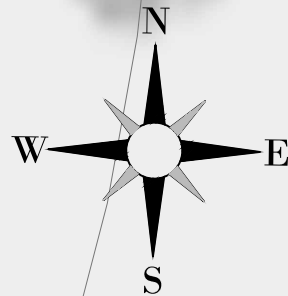

NOTES

- These drawings have been prepared solely for planning application purposes.
- Copyright © AFRY Ireland. All rights reserved. No part of these drawings may be reproduced, stored, or transmitted in any form without the prior written consent of the copyright holder.
- Do not scale from these drawings. Only figured dimensions shown on the drawings shall be used.
- Existing and proposed levels shown are subject to confirmation and may vary depending on local ground conditions and detailed site investigations.

NOTES

Ordnance Survey Ireland License No. EN 0051326
© Ordnance Survey Ireland/Government of Ireland
Sheet No's: 0451,0452,0453,0479,0480,0481,0507, 0508

REV	DATE	DRAWN BY	CHECKED BY	DETAILS
A	04/06/2026	M.B.	L.P.	FIRST ISSUE

ENGINEER



AFRY Ireland Ltd.
The Hyde Building, The Park,
Carrickmines,
D18VC44
Ireland
Tel: +353 (0) 1 845 5031

DRAWN BY
M. BROWNE

DATE
04/06/2026

CHECKED AND APPROVED
L. POWER

DATE
04/06/2026

CLIENT

PAPER SIZE
A1

SCALE
1:500

STATUS
EXISTING

PROJECT

MEENBOG WIND FARM

TITLE
EXISTING DEVELOPMENT TURBINE LAYOUT
TURBINE 3



DRAWING NUMBER
MNBG d009.2.3

REVISION

A

Printed: 2026/06/04 12:01:08
C:\3-ROUTE\Draws\Projects\Meenbog\AFRY\Drawings\MNBG\0009 Existing Layout\MNBG_0002_Turbine Layout.dwg

- LEGEND**
- TURBINE BASE (SUBSTANTIALLY COMPLETE)
 - TURBINE BASE (PARTIALLY COMPLETE)
 - SOLID SITE ROADS
 - FLOATING SITE ROADS
 - PRE-EXISTING ROADS
 - ADDITIONAL AREAS
 - HARDSTANDS
 - AREAS OF CUT
 - AREAS OF FILL
 - SIDE CASTING
 - PEAT CELLS
 - STONE BERMS
 - FENCE
 - EXCAVATED BORROW PIT
 - BORROW PIT WORKING STRIP
 - TEMP. CONSTRUCTION AREA
 - PULL PIT LOCATION
 - AS BUILT DUCTING
 - RIVER / STREAM
 - PLANNING APPLICATION BOUNDARY

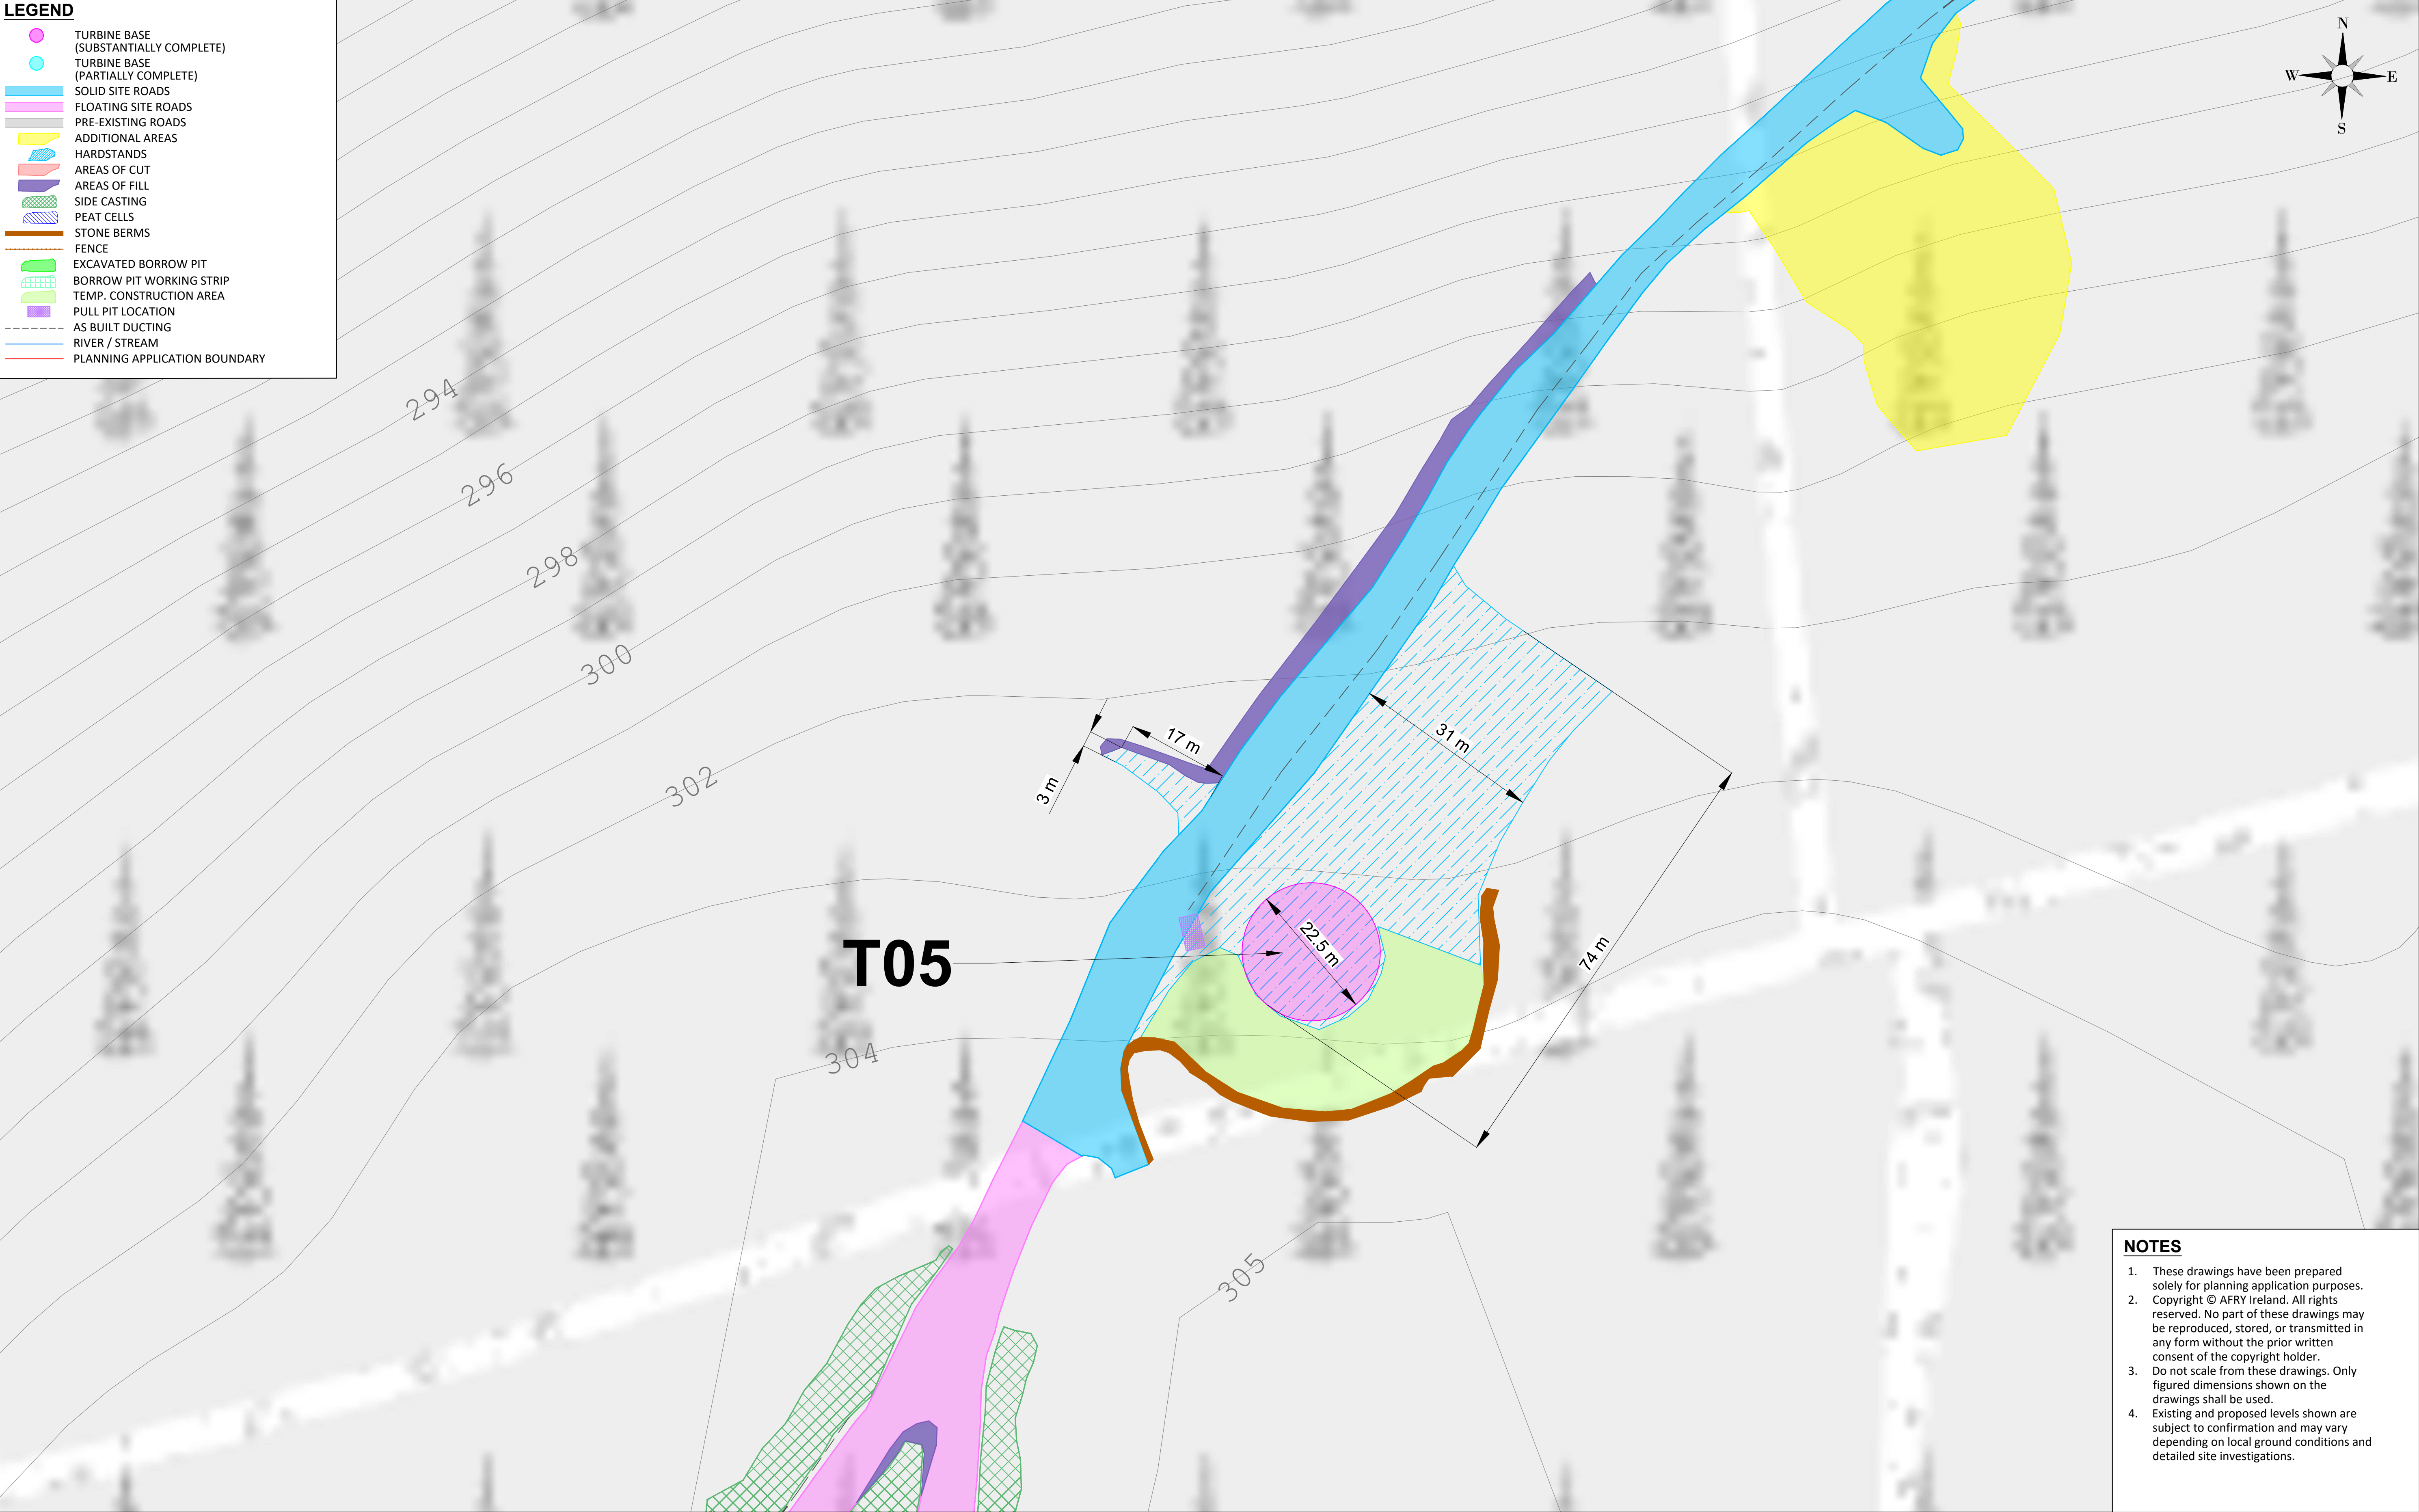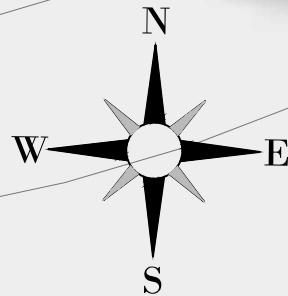

NOTES

Ordnance Survey Ireland License No. EN 0051326
© Ordnance Survey Ireland/Government of Ireland
Sheet No's: 0451,0452,0453,0479,0480,0481,0507, 0508

REV	DATE	DRAWN BY	CHECKED BY	DETAILS
A	04/06/2026	M.B.	L.P.	FIRST ISSUE

ENGINEER



AFRY Ireland Ltd.
The Hyde Building, The Park,
Carrickmines,
D18VC44
Ireland
Tel: +353 (0) 1 845 5031

CLIENT

PROJECT

MEENBOG WIND FARM

**EXISTING DEVELOPMENT TURBINE LAYOUT
TURBINE 5**

REVISION

A

DRAWN BY
M. BROWNE

DATE
04/06/2026

PAPER SIZE
A1

SCALE
1:500

CHECKED AND APPROVED
L. POWER



DATE
04/06/2026

STATUS
EXISTING

DRAWING NUMBER
MNBG d009.2.5

Revised: 2026/03/09 12:48:01
C:\3-ROUTE\Drawings\Proposed\Meenbog\MNBG\Drawings\MNBG_0009_Existing_Turbine Layout.dwg

- LEGEND**
- TURBINE BASE (SUBSTANTIALLY COMPLETE)
 - TURBINE BASE (PARTIALLY COMPLETE)
 - SOLID SITE ROADS
 - FLOATING SITE ROADS
 - PRE-EXISTING ROADS
 - ADDITIONAL AREAS
 - HARDSTANDS
 - AREAS OF CUT
 - AREAS OF FILL
 - SIDE CASTING
 - PEAT CELLS
 - STONE BERMS
 - FENCE
 - EXCAVATED BORROW PIT
 - BORROW PIT WORKING STRIP
 - TEMP. CONSTRUCTION AREA
 - PULL PIT LOCATION
 - AS BUILT DUCTING
 - RIVER / STREAM
 - PLANNING APPLICATION BOUNDARY

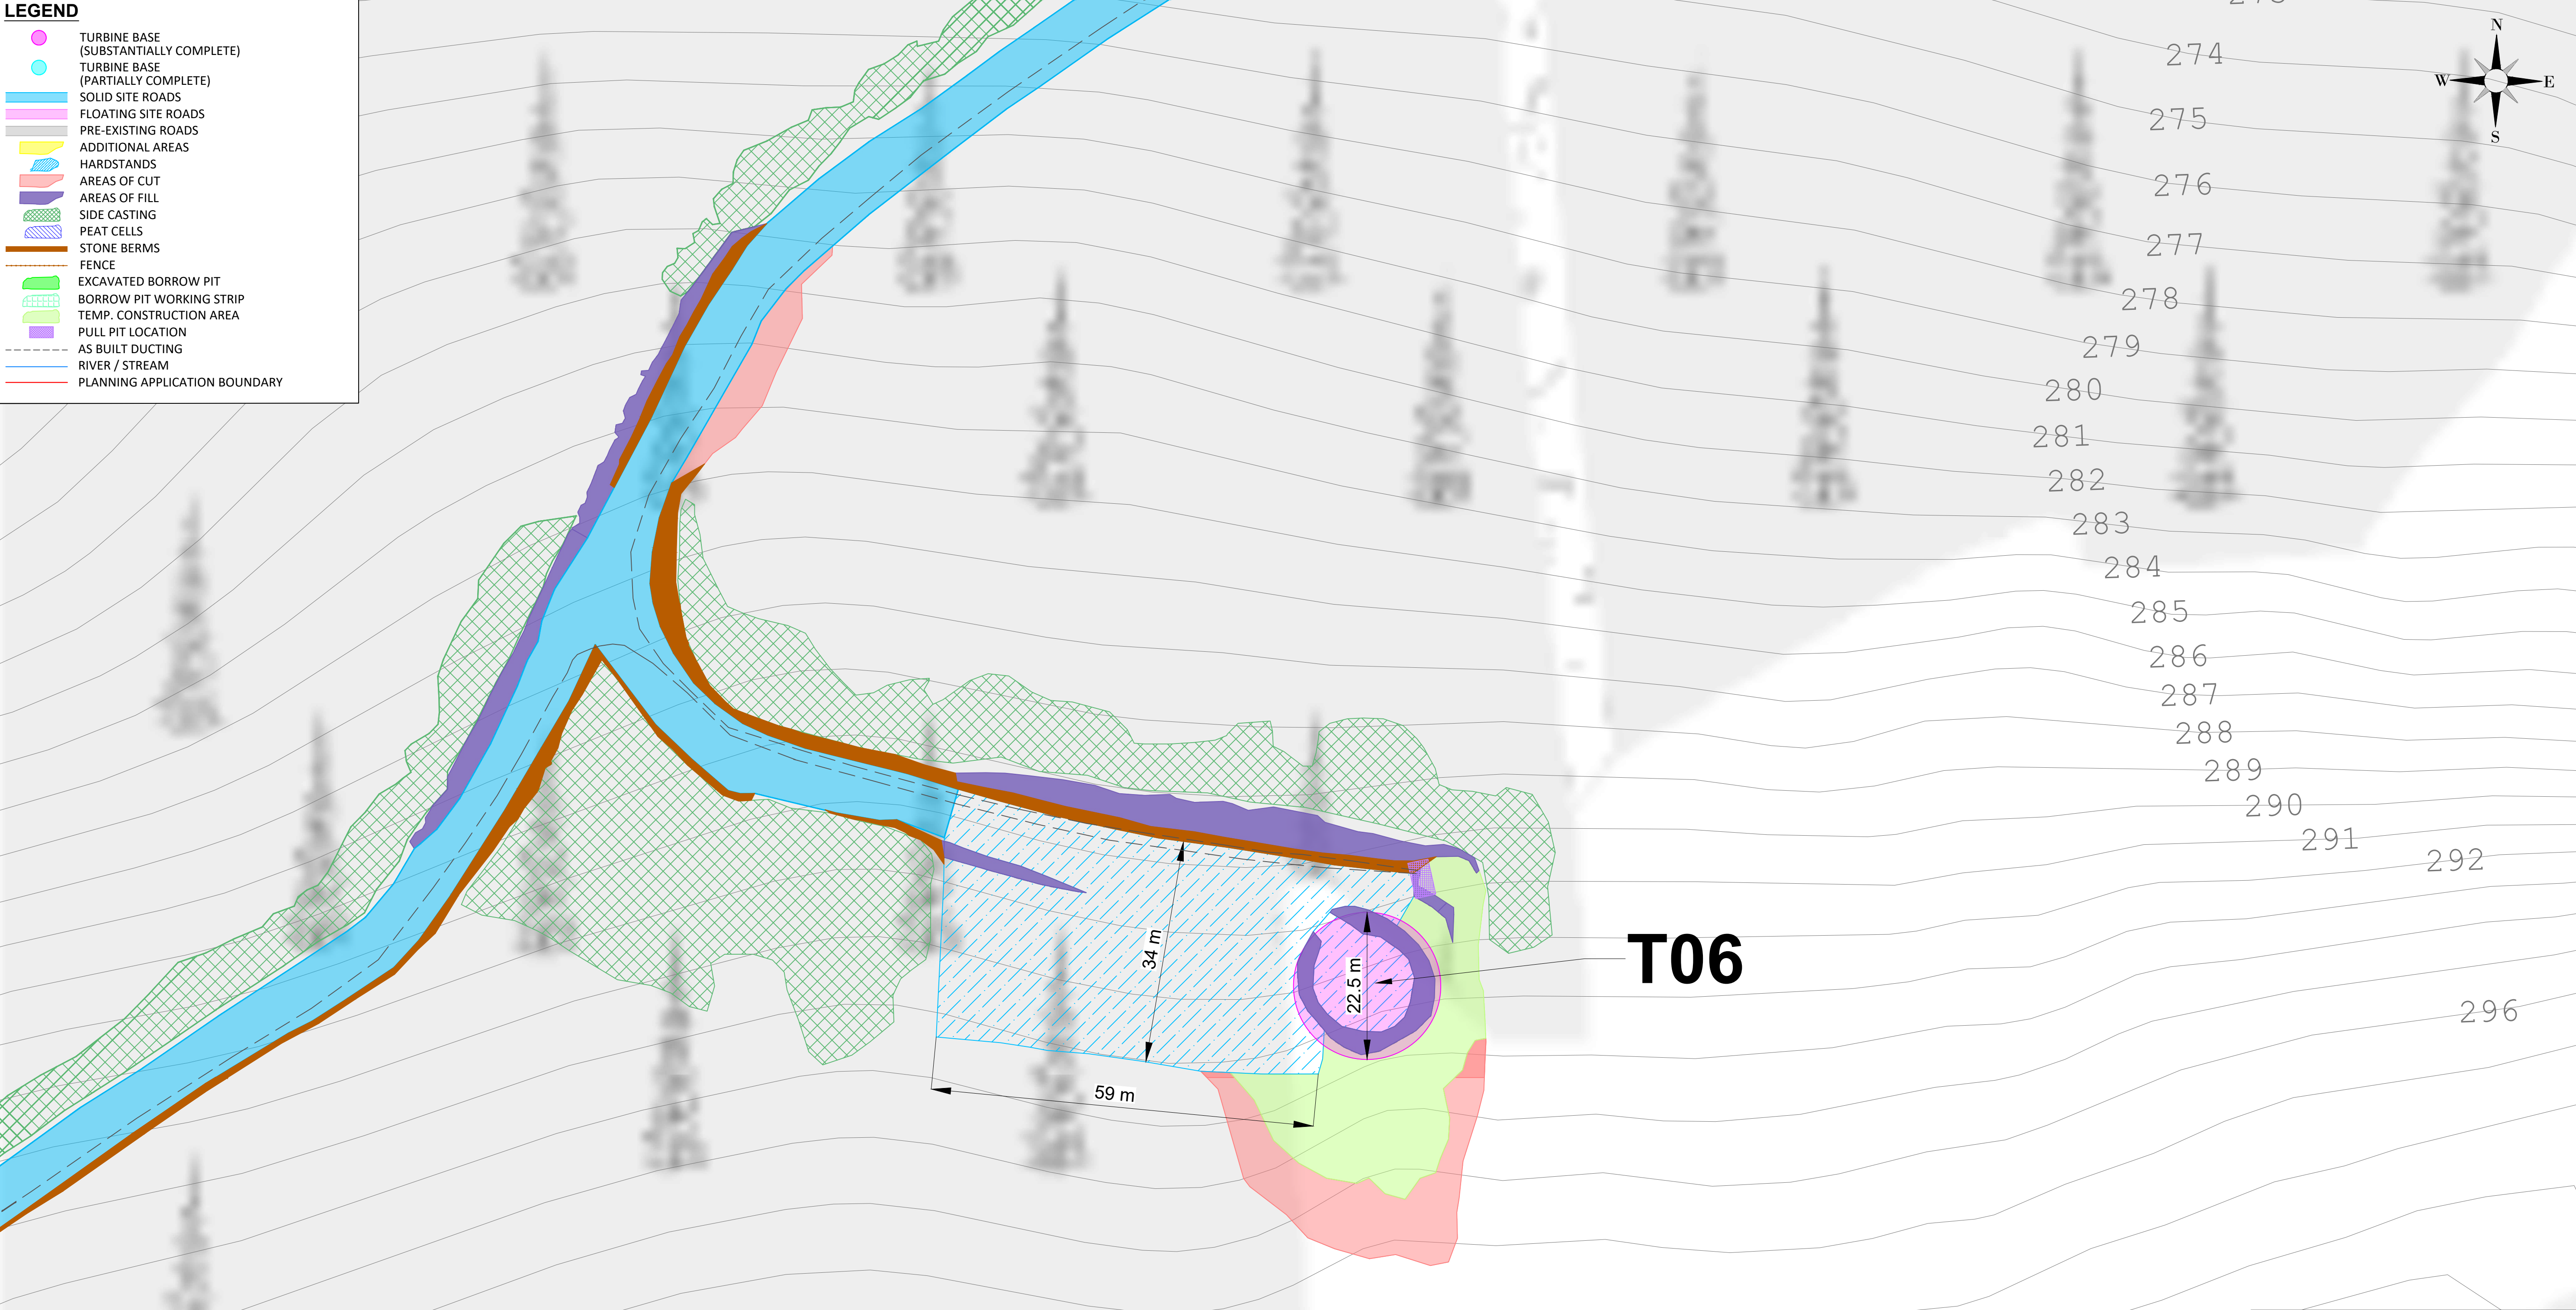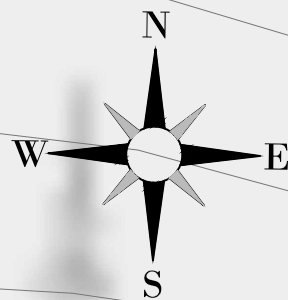

- NOTES**
- These drawings have been prepared solely for planning application purposes. Copyright © AFRY Ireland. All rights reserved. No part of these drawings may be reproduced, stored, or transmitted in any form without the prior written consent of the copyright holder.
 - Do not scale from these drawings. Only figured dimensions shown on the drawings shall be used.
 - Existing and proposed levels shown are subject to confirmation and may vary depending on local ground conditions and detailed site investigations.

NOTES

Ordnance Survey Ireland License No. EN 0051326
© Ordnance Survey Ireland/Government of Ireland
Sheet No's: 0451,0452,0453,0479,0480,0481,0507, 0508

REV	DATE	DRAWN BY	CHECKED BY	DETAILS
A	04/06/2026	M.B.	L.P.	FIRST ISSUE

ENGINEER



AFRY Ireland Ltd.
The Hyde Building, The Park,
Carrickmines,
D18VC44
Ireland
Tel: +353 (0) 1 845 5031

CLIENT

PROJECT

MEENBOG WIND FARM

**EXISTING DEVELOPMENT TURBINE LAYOUT
TURBINE 6**

REVISION

A

DRAWN BY

M. BROWNE

DATE

04/06/2026

PAPER SIZE

A1

SCALE

1:500

CHECKED AND APPROVED

L. POWER

DATE

04/06/2026

STATUS

EXISTING

DRAWING NUMBER

MNBG d009.2.6

Revised: 2026/03/26 12:54:47
C:\3-ROUTE\Draws\Proposed\Draws\Meenbog\MNBG\Drawings\MNBG_0009_Existing_Layou\MNBG_0009_2_Turbine_Layou.dwg

LEGEND

TURBINE BASE
(SUBSTANTIALLY COMPLETE)

TURBINE BASE
(PARTIALLY COMPLETE)

SOLID SITE ROADS

FLOATING SITE ROADS

PRE-EXISTING ROADS

ADDITIONAL AREAS

HARDSTANDS

AREAS OF CUT

AREAS OF FILL

SIDE CASTING

PEAT CELLS

STONE BERMS

FENCE

EXCAVATED BORROW PIT

BORROW PIT WORKING STRIP


TEMP. CONSTRUCTION AREA

PULL PIT LOCATION

AS BUILT DUCTING

RIVER / STREAM

PLANNING APPLICATION BOUNDARY

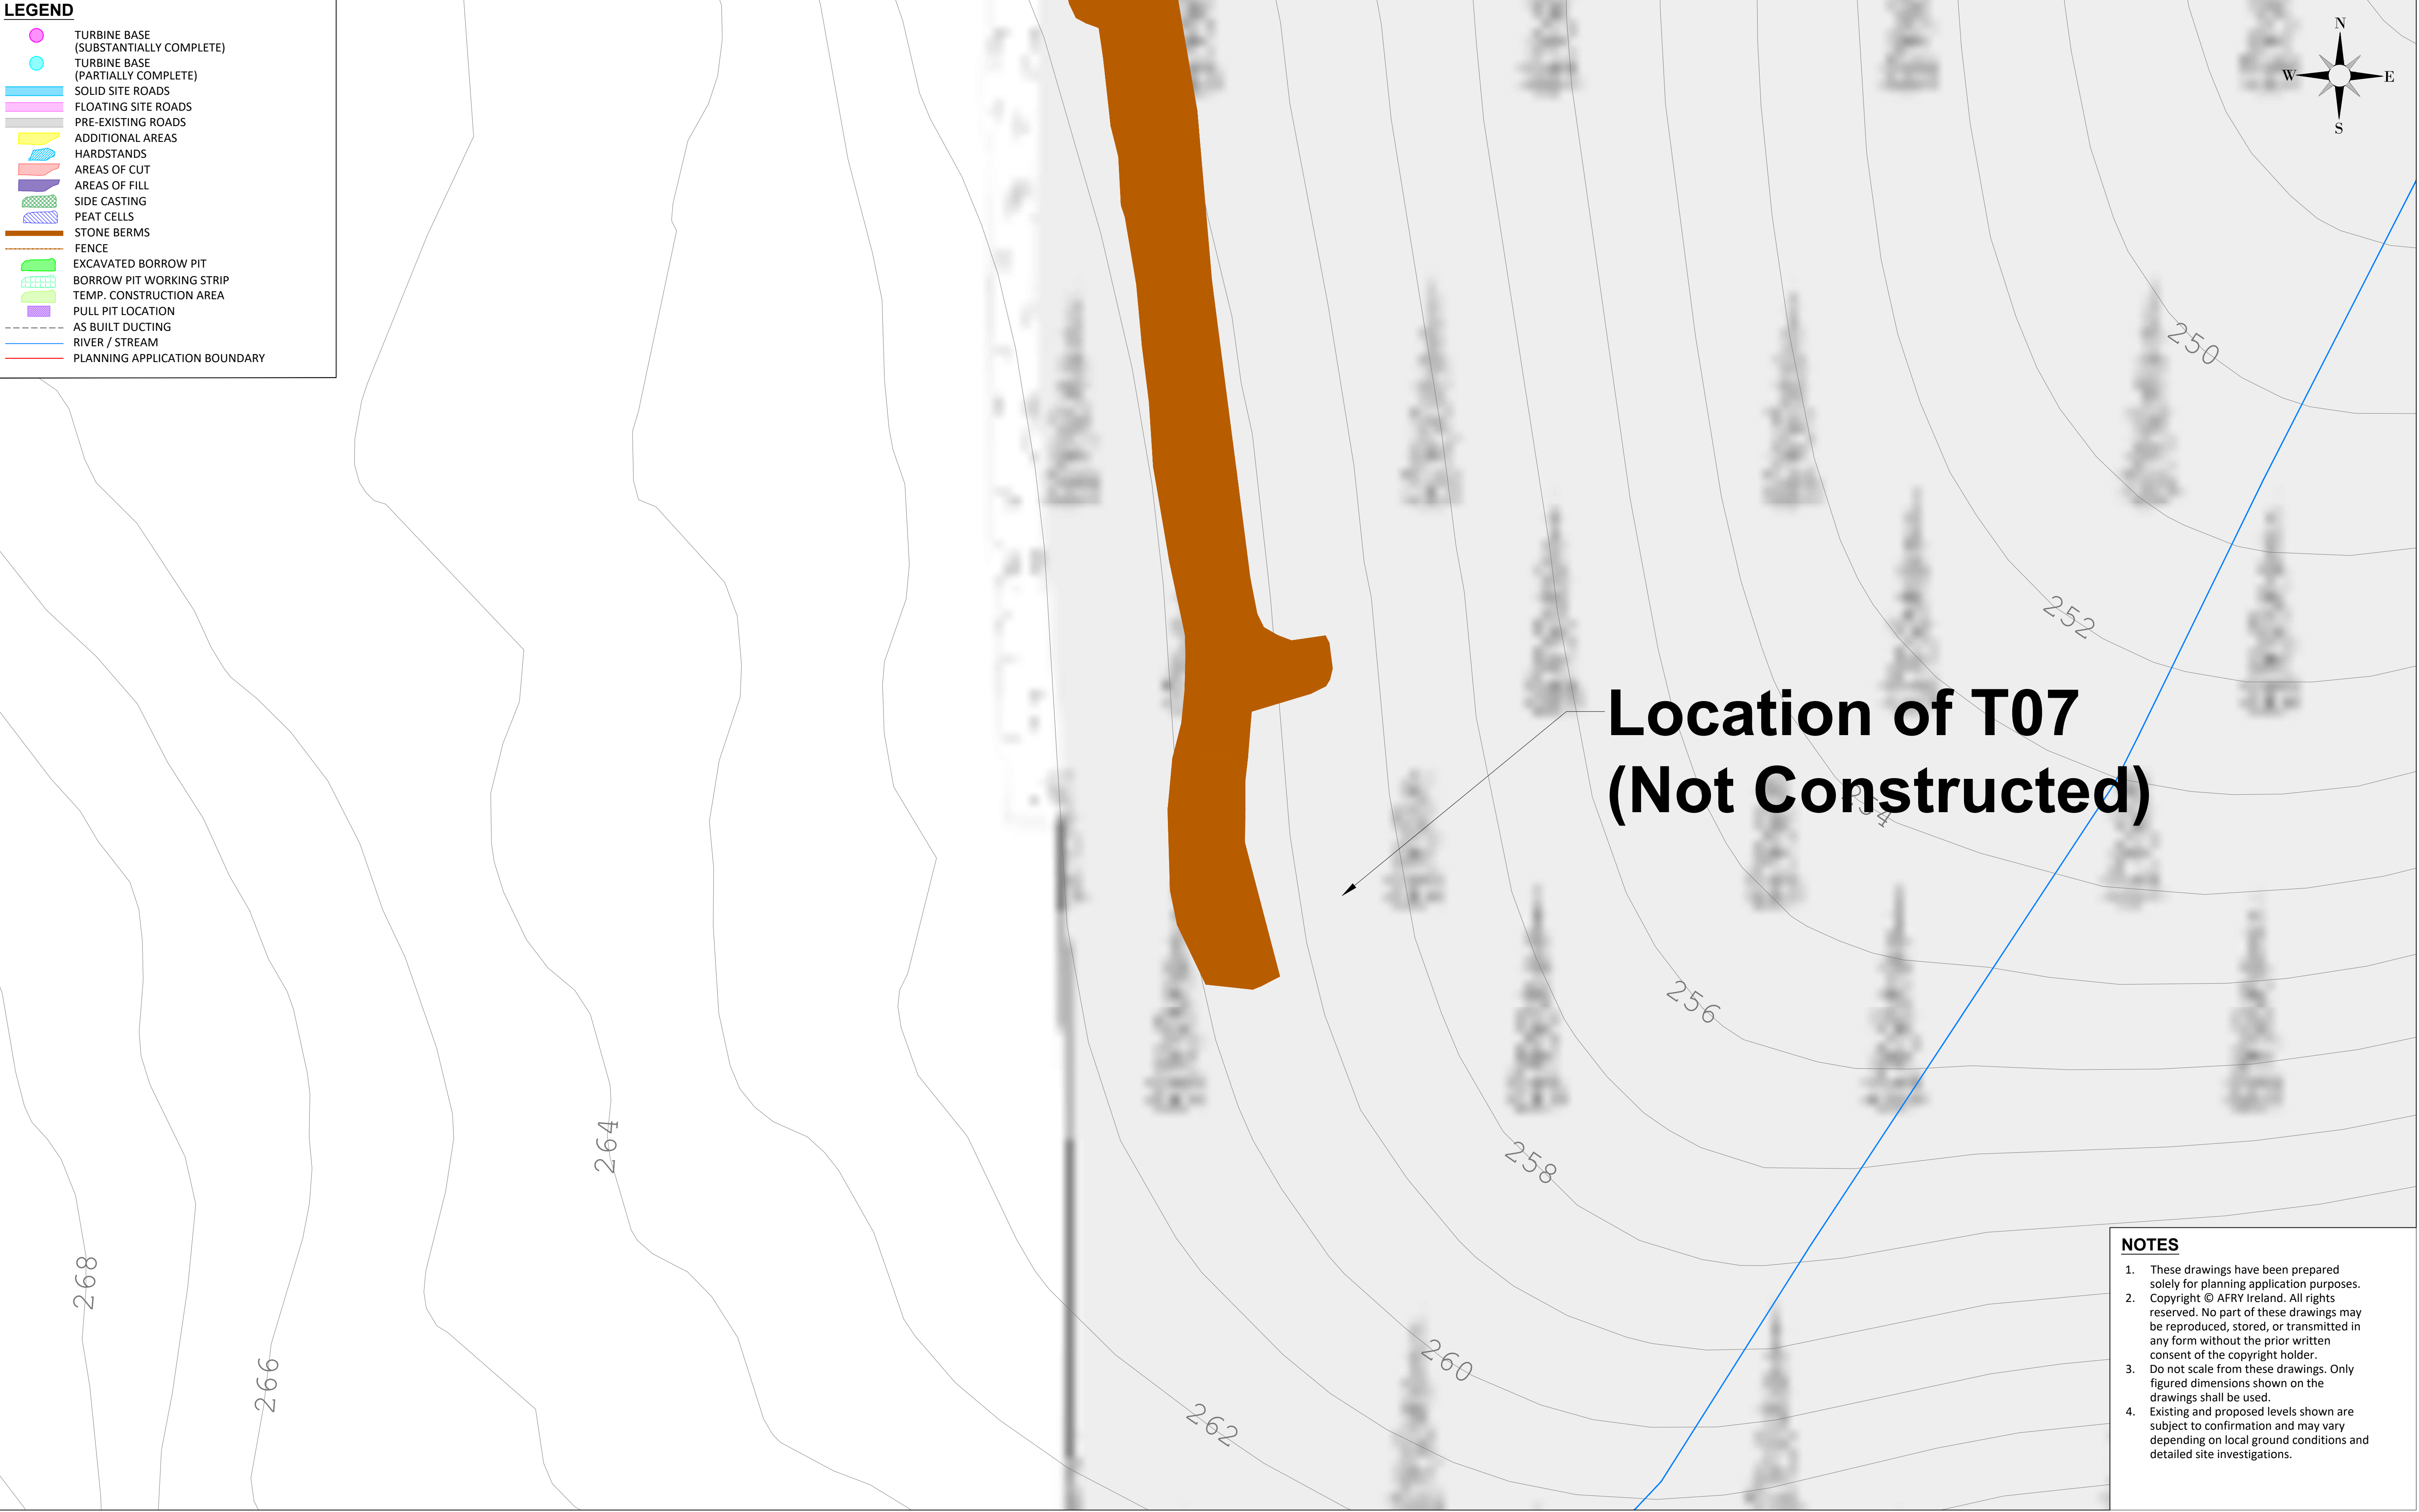

- NOTES
1.

These drawings have been prepared solely for planning application purposes. Copyright © AFRY Ireland. All rights reserved. No part of these drawings may be reproduced, stored, or transmitted in any form without the prior written consent of the copyright holder.
2.


Do not scale from these drawings. Only figured dimensions shown on the drawings shall be used.
3.

Existing and proposed levels shown are subject to confirmation and may vary depending on local ground conditions and detailed site investigations.



Ordnance Survey Ireland License No. EN 0051326 © Ordnance Survey Ireland/Government of Ireland Sheet No.'s: 0451,0452,0453,0479,0480,0481,0507, 0508					ENGINEER		 AFRY AF PÖYRÝ AFRY Ireland Ltd. The Hyde Building, The Park, Carrickmines, D18VC44 Ireland Tel: +353 (0) 1 845 5031		CLIENT		PROJECT MEENBOG WIND FARM		
					DRAWN BY M. BROWNE		DATE 04/06/2026	PAPER SIZE A1	SCALE 1:500	TITLE EXISTING DEVELOPMENT TURBINE LAYOUT TURBINE 7			REVISION A
					CHECKED AND APPROVED L. POWER		DATE 04/06/2026	STATUS EXISTING					
A 04/06/2026					M.B.	L.P.	FIRST ISSUE						
REV	DATE	DRAWN BY	CHECKED BY	DETAILS									

K:\3-BUE\Custom\Projects\external\Meeting\MNBG\Drawing\MNBG 0009 Handdrawing Layout\MNBG 0009 2.7.dwg

Printer: - 2025/06/06 12:31:44

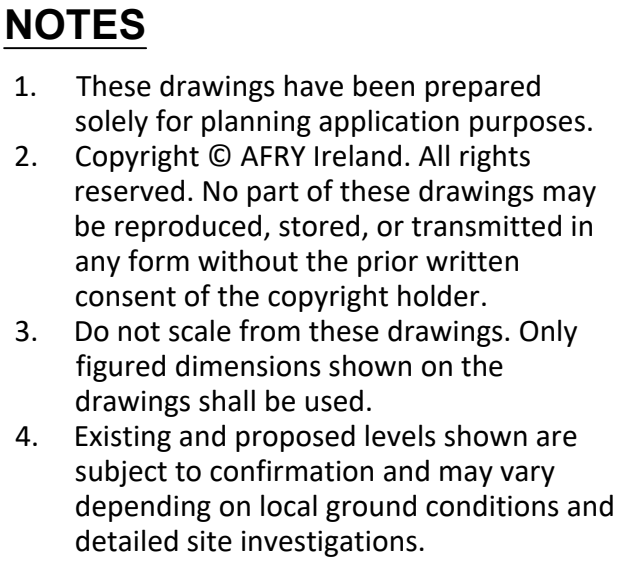

- LEGEND**
- TURBINE BASE (SUBSTANTIALLY COMPLETE)
 - TURBINE BASE (PARTIALLY COMPLETE)
 - SOLID SITE ROADS
 - FLOATING SITE ROADS
 - PRE-EXISTING ROADS
 - ADDITIONAL AREAS
 - HARDSTANDS
 - AREAS OF CUT
 - AREAS OF FILL
 - SIDE CASTING
 - PEAT CELLS
 - STONE BERMS
 - FENCE
 - EXCAVATED BORROW PIT
 - BORROW PIT WORKING STRIP
 - TEMP. CONSTRUCTION AREA
 - PULL PIT LOCATION
 - AS BUILT DUCTING
 - RIVER / STREAM
 - PLANNING APPLICATION BOUNDARY

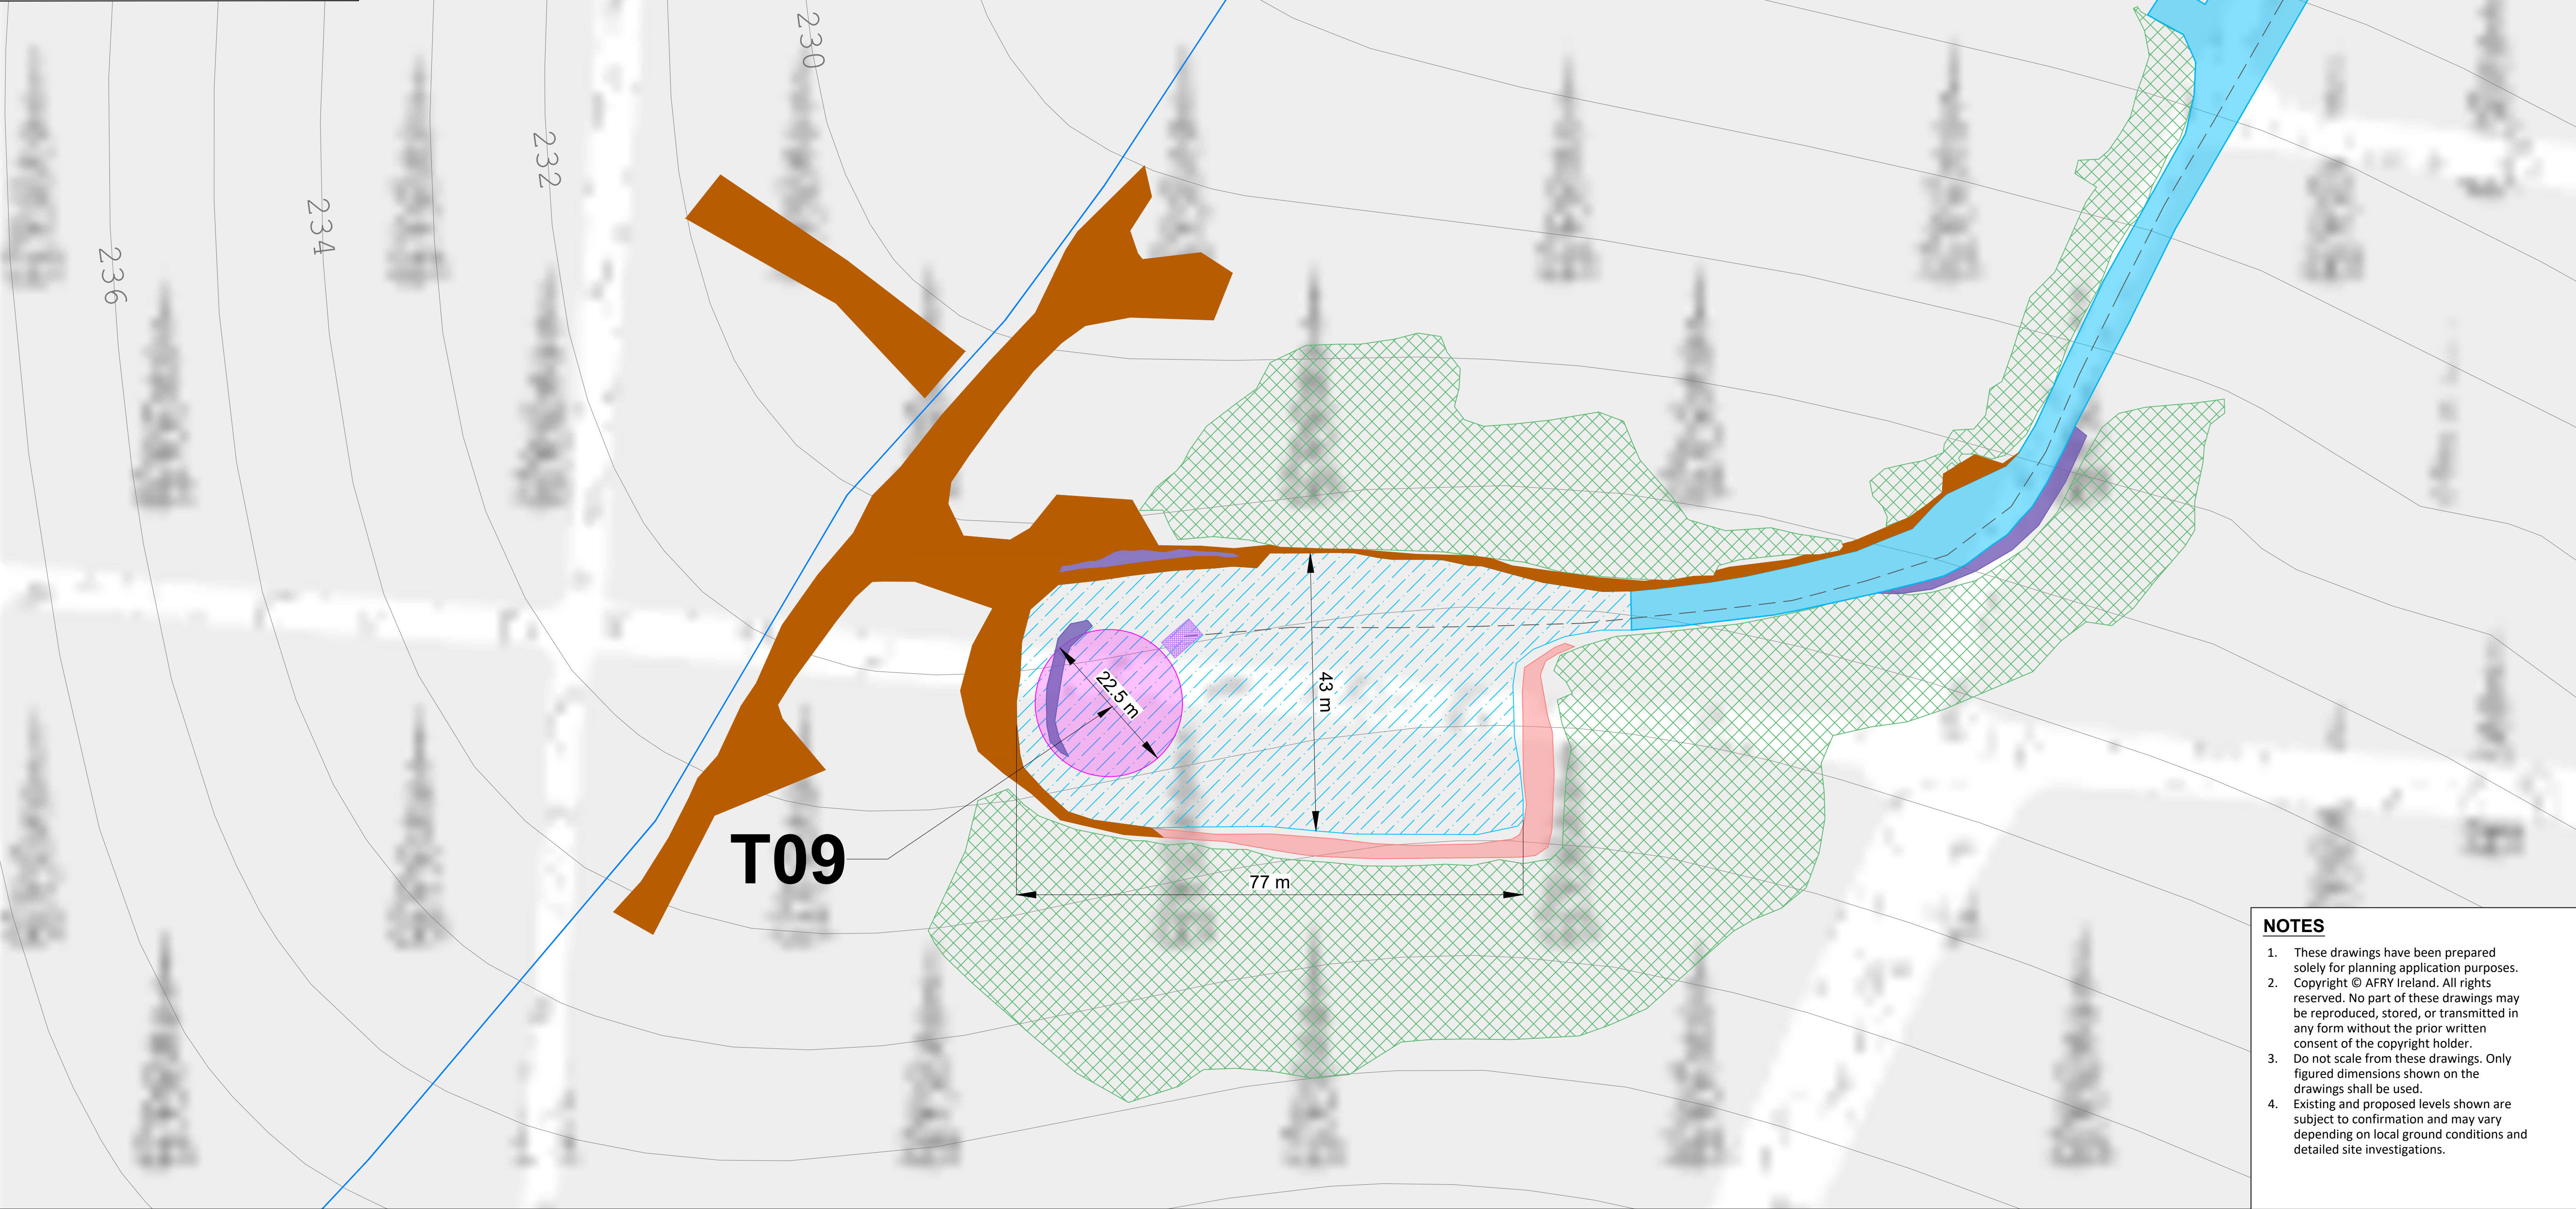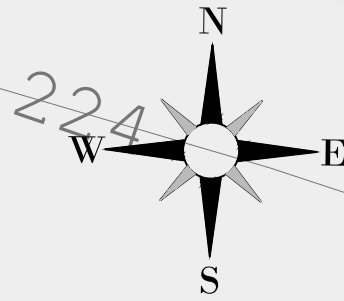

- NOTES**
- These drawings have been prepared solely for planning application purposes. Copyright © AFRY Ireland. All rights reserved. No part of these drawings may be reproduced, stored, or transmitted in any form without the prior written consent of the copyright holder.
 - Do not scale from these drawings. Only figured dimensions shown on the drawings shall be used.
 - Existing and proposed levels shown are subject to confirmation and may vary depending on local ground conditions and detailed site investigations.

NOTES

Ordnance Survey Ireland License No. EN 0051326
© Ordnance Survey Ireland/Government of Ireland
Sheet No's: 0451,0452,0453,0479,0480,0481,0507, 0508

REV	DATE	DRAWN BY	CHECKED BY	DETAILS
A	04/06/2026	M.B.	L.P.	FIRST ISSUE

ENGINEER



AFRY Ireland Ltd.
The Hyde Building, The Park,
Carrickmines,
D18VC44
Ireland
Tel: +353 (0) 1 845 5031

CLIENT

PROJECT

MEENBOG WIND FARM

EXISTING DEVELOPMENT TURBINE LAYOUT
TURBINE 9

A

DRAWN BY
M. BROWNE

DATE
04/06/2026

PAPER SIZE
A1

SCALE
1:500

CHECKED AND APPROVED
L. POWER


DATE
04/06/2026

STATUS
EXISTING

DRAWING NUMBER
MNBG d009.2.9

Revised: 2026/03/26 13:58:14
C:\3-BU-E\Draws\Projects\Meenbog\Meenbog_MNBG\Drawings\MNBG_0009_Existing_Layou\MNBG_0009_2_Turbine_Layou.dwg

- LEGEND**
- TURBINE BASE (SUBSTANTIALLY COMPLETE)
 - TURBINE BASE (PARTIALLY COMPLETE)
 - SOLID SITE ROADS
 - FLOATING SITE ROADS
 - PRE-EXISTING ROADS
 - ADDITIONAL AREAS
 - HARDSTANDS
 - AREAS OF CUT
 - AREAS OF FILL
 - SIDE CASTING
 - PEAT CELLS
 - STONE BERMS
 - FENCE
 - EXCAVATED BORROW PIT
 - BORROW PIT WORKING STRIP
 - TEMP. CONSTRUCTION AREA
 - PULL PIT LOCATION
 - AS BUILT DUCTING
 - RIVER / STREAM
 - PLANNING APPLICATION BOUNDARY

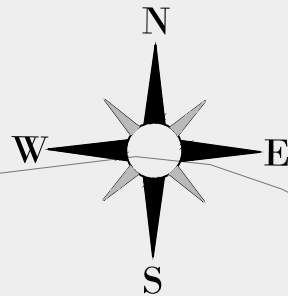

T10

NOTES

- These drawings have been prepared solely for planning application purposes.
- Copyright © AFRY Ireland. All rights reserved. No part of these drawings may be reproduced, stored, or transmitted in any form without the prior written consent of the copyright holder.
- Do not scale from these drawings. Only figured dimensions shown on the drawings shall be used.
- Existing and proposed levels shown are subject to confirmation and may vary depending on local ground conditions and detailed site investigations.

NOTES

Ordnance Survey Ireland License No. EN 0051326
© Ordnance Survey Ireland/Government of Ireland
Sheet No's: 0451,0452,0453,0479,0480,0481,0507, 0508

A	04/06/2026	M.B.	L.P.	FIRST ISSUE
REV	DATE	DRAWN BY	CHECKED BY	DETAILS

ENGINEER



AFRY Ireland Ltd.
The Hyde Building, The Park,
Carrickmines,
D18VC44
Ireland
Tel: +353 (0) 1 845 5031

CLIENT

PROJECT

MEENBOG WIND FARM

TITLE
**EXISTING DEVELOPMENT TURBINE LAYOUT
TURBINE 10**

REVISION

A

DRAWN BY
M. BROWNE

DATE
04/06/2026

PAPER SIZE
A1

SCALE
1:500

CHECKED AND APPROVED
L. POWER



DATE
04/06/2026

STATUS
EXISTING

DRAWING NUMBER
MNBG d009.2.10

Revised: 2026/03/26 12:52:46
C:\3.0\BUE\Draws\Projects\Meenbog\Meenbog MNBG\Drawings\MNBG\0009 Existing Development Layouts\MNBG_0002_Turbine Layouts_A4B.pdf

- LEGEND**
- TURBINE BASE (SUBSTANTIALLY COMPLETE)
 - TURBINE BASE (PARTIALLY COMPLETE)
 - SOLID SITE ROADS
 - FLOATING SITE ROADS
 - PRE-EXISTING ROADS
 - ADDITIONAL AREAS
 - HARDSTANDS
 - AREAS OF CUT
 - AREAS OF FILL
 - SIDE CASTING
 - PEAT CELLS
 - STONE BERMS
 - FENCE
 - EXCAVATED BORROW PIT
 - BORROW PIT WORKING STRIP
 - TEMP. CONSTRUCTION AREA
 - PULL PIT LOCATION
 - AS BUILT DUCTING
 - RIVER / STREAM
 - PLANNING APPLICATION BOUNDARY

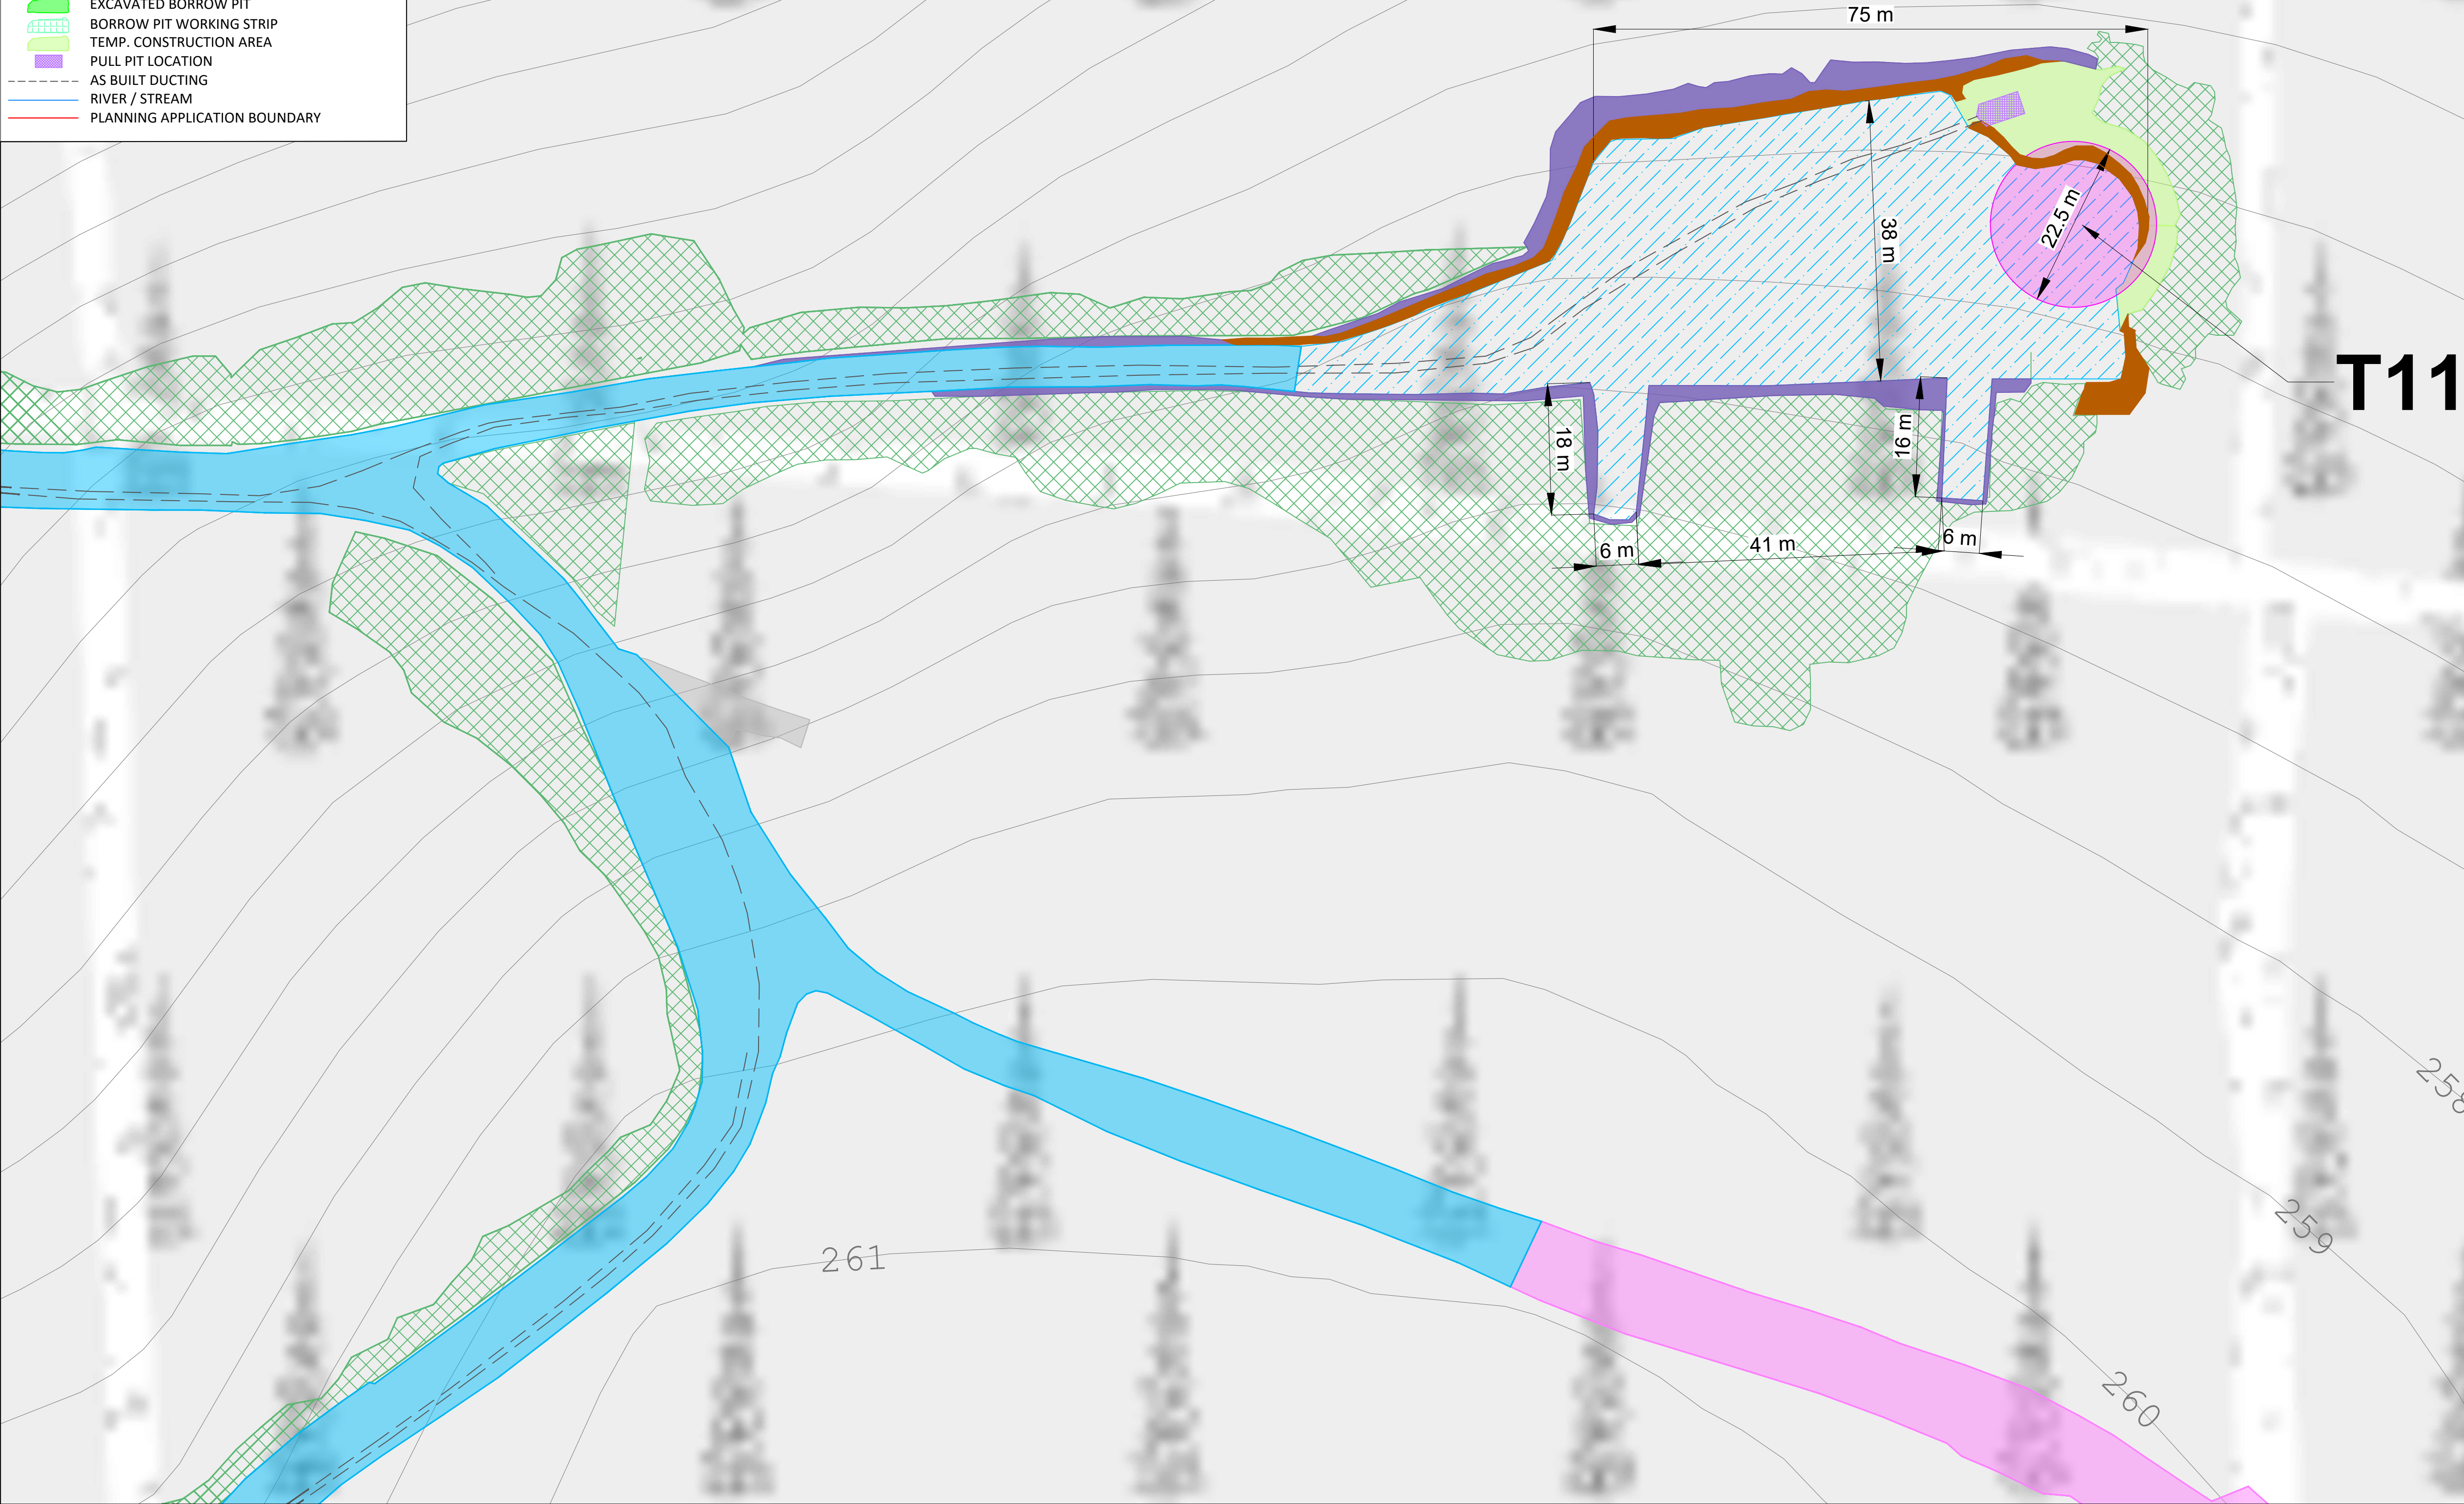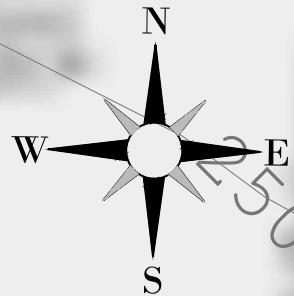

- NOTES**
- These drawings have been prepared solely for planning application purposes. Copyright © AFRY Ireland. All rights reserved. No part of these drawings may be reproduced, stored, or transmitted in any form without the prior written consent of the copyright holder.
 - Do not scale from these drawings. Only figured dimensions shown on the drawings shall be used.
 - Existing and proposed levels shown are subject to confirmation and may vary depending on local ground conditions and detailed site investigations.

NOTES

Ordnance Survey Ireland License No. EN 0051326
© Ordnance Survey Ireland/Government of Ireland
Sheet No's: 0451,0452,0453,0479,0480,0481,0507, 0508

REV	DATE	DRAWN BY	CHECKED BY	DETAILS
A	04/06/2026	M.B.	L.P.	FIRST ISSUE

ENGINEER



AFRY Ireland Ltd.
The Hyde Building, The Park,
Carrickmines,
D18VC44
Ireland
Tel: +353 (0) 1 845 5031

DRAWN BY
M. BROWNE

DATE
04/06/2026

CHECKED AND APPROVED
L. POWER

DATE
04/06/2026

CLIENT

PAPER SIZE
A1

SCALE
1:500

STATUS
EXISTING

PROJECT

MEENBOG WIND FARM

TITLE
EXISTING DEVELOPMENT TURBINE LAYOUT
TURBINE 11



DRAWING NUMBER
MNBG d009.2.11

REVISION

A

Revised: 2026/03/28 12:48:33
C:\3-ROUTE\Drawings\Proposed\Meenbog\MNBG\Drawings\MNBG_0009_Existing Layouts\A4808

- LEGEND**
- TURBINE BASE (SUBSTANTIALLY COMPLETE)
 - TURBINE BASE (PARTIALLY COMPLETE)
 - SOLID SITE ROADS
 - FLOATING SITE ROADS
 - PRE-EXISTING ROADS
 - ADDITIONAL AREAS
 - HARDSTANDS
 - AREAS OF CUT
 - AREAS OF FILL
 - SIDE CASTING
 - PEAT CELLS
 - STONE BERMS
 - FENCE
 - EXCAVATED BORROW PIT
 - BORROW PIT WORKING STRIP
 - TEMP. CONSTRUCTION AREA
 - PULL PIT LOCATION
 - AS BUILT DUCTING
 - RIVER / STREAM
 - PLANNING APPLICATION BOUNDARY

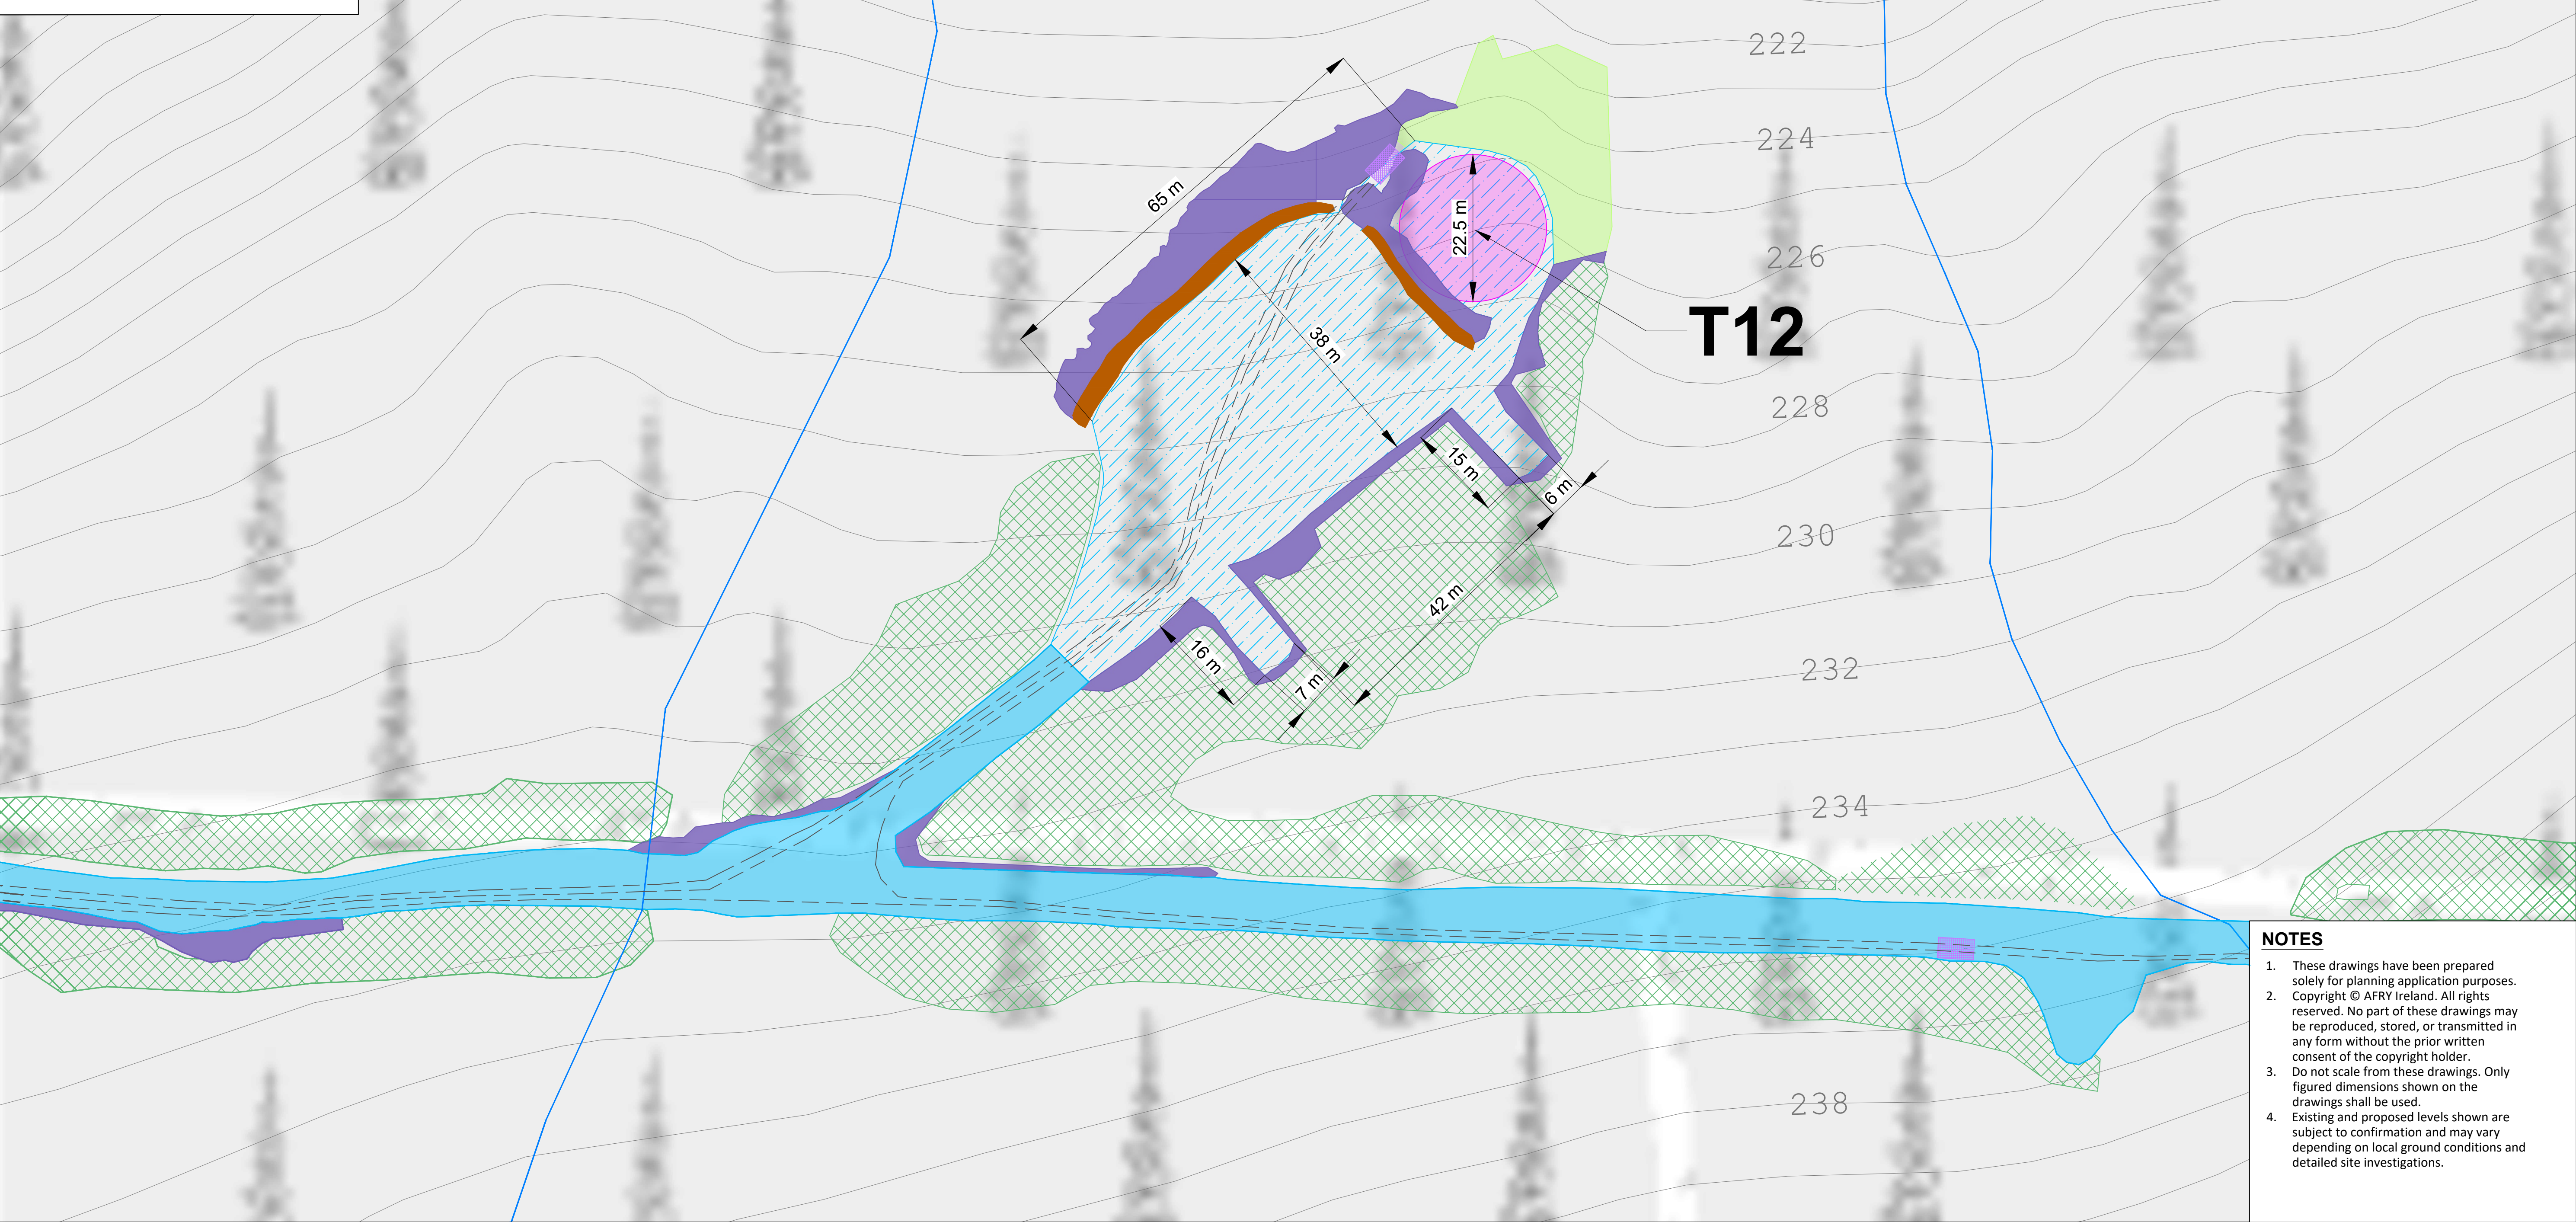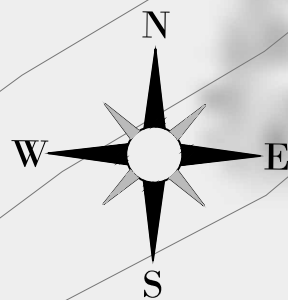

- NOTES**
- These drawings have been prepared solely for planning application purposes. Copyright © AFRY Ireland. All rights reserved. No part of these drawings may be reproduced, stored, or transmitted in any form without the prior written consent of the copyright holder.
 - Do not scale from these drawings. Only figured dimensions shown on the drawings shall be used.
 - Existing and proposed levels shown are subject to confirmation and may vary depending on local ground conditions and detailed site investigations.

NOTES

Ordnance Survey Ireland License No. EN 0051326
© Ordnance Survey Ireland/Government of Ireland
Sheet No's: 0451,0452,0453,0479,0480,0481,0507, 0508

REV	DATE	DRAWN BY	CHECKED BY	DETAILS
A	04/06/2026	M.B.	L.P.	FIRST ISSUE

ENGINEER



AFRY Ireland Ltd.
The Hyde Building, The Park,
Carrickmines,
D18VC44
Ireland
Tel: +353 (0) 1 845 5031

CLIENT

PROJECT

MEENBOG WIND FARM

TITLE
**EXISTING DEVELOPMENT TURBINE LAYOUT
TURBINE 12**

REVISION

A

DRAWN BY
M. BROWNE

DATE
04/06/2026

PAPER SIZE
A1

SCALE
1:500

CHECKED AND APPROVED
L. POWER

DATE
04/06/2026


STATUS
EXISTING

DRAWING NUMBER
MNBG d009.2.12

Revised: 2026/03/26 12:44:46
C:\3-ROUTE\Drawings\Projects\Meenbog\MNBG\Drawings\MNBG_0009_Existing_Layout_A4B.pdf

- LEGEND**
- TURBINE BASE (SUBSTANTIALLY COMPLETE)
 - TURBINE BASE (PARTIALLY COMPLETE)
 - SOLID SITE ROADS
 - FLOATING SITE ROADS
 - PRE-EXISTING ROADS
 - ADDITIONAL AREAS
 - HARDSTANDS
 - AREAS OF CUT
 - AREAS OF FILL
 - SIDE CASTING
 - PEAT CELLS
 - STONE BERMS
 - FENCE
 - EXCAVATED BORROW PIT
 - BORROW PIT WORKING STRIP
 - TEMP. CONSTRUCTION AREA
 - PULL PIT LOCATION
 - AS BUILT DUCTING
 - RIVER / STREAM
 - PLANNING APPLICATION BOUNDARY

- NOTES**
- These drawings have been prepared solely for planning application purposes. Copyright © AFRY Ireland. All rights reserved. No part of these drawings may be reproduced, stored, or transmitted in any form without the prior written consent of the copyright holder.
 - Do not scale from these drawings. Only figured dimensions shown on the drawings shall be used.
 - Existing and proposed levels shown are subject to confirmation and may vary depending on local ground conditions and detailed site investigations.

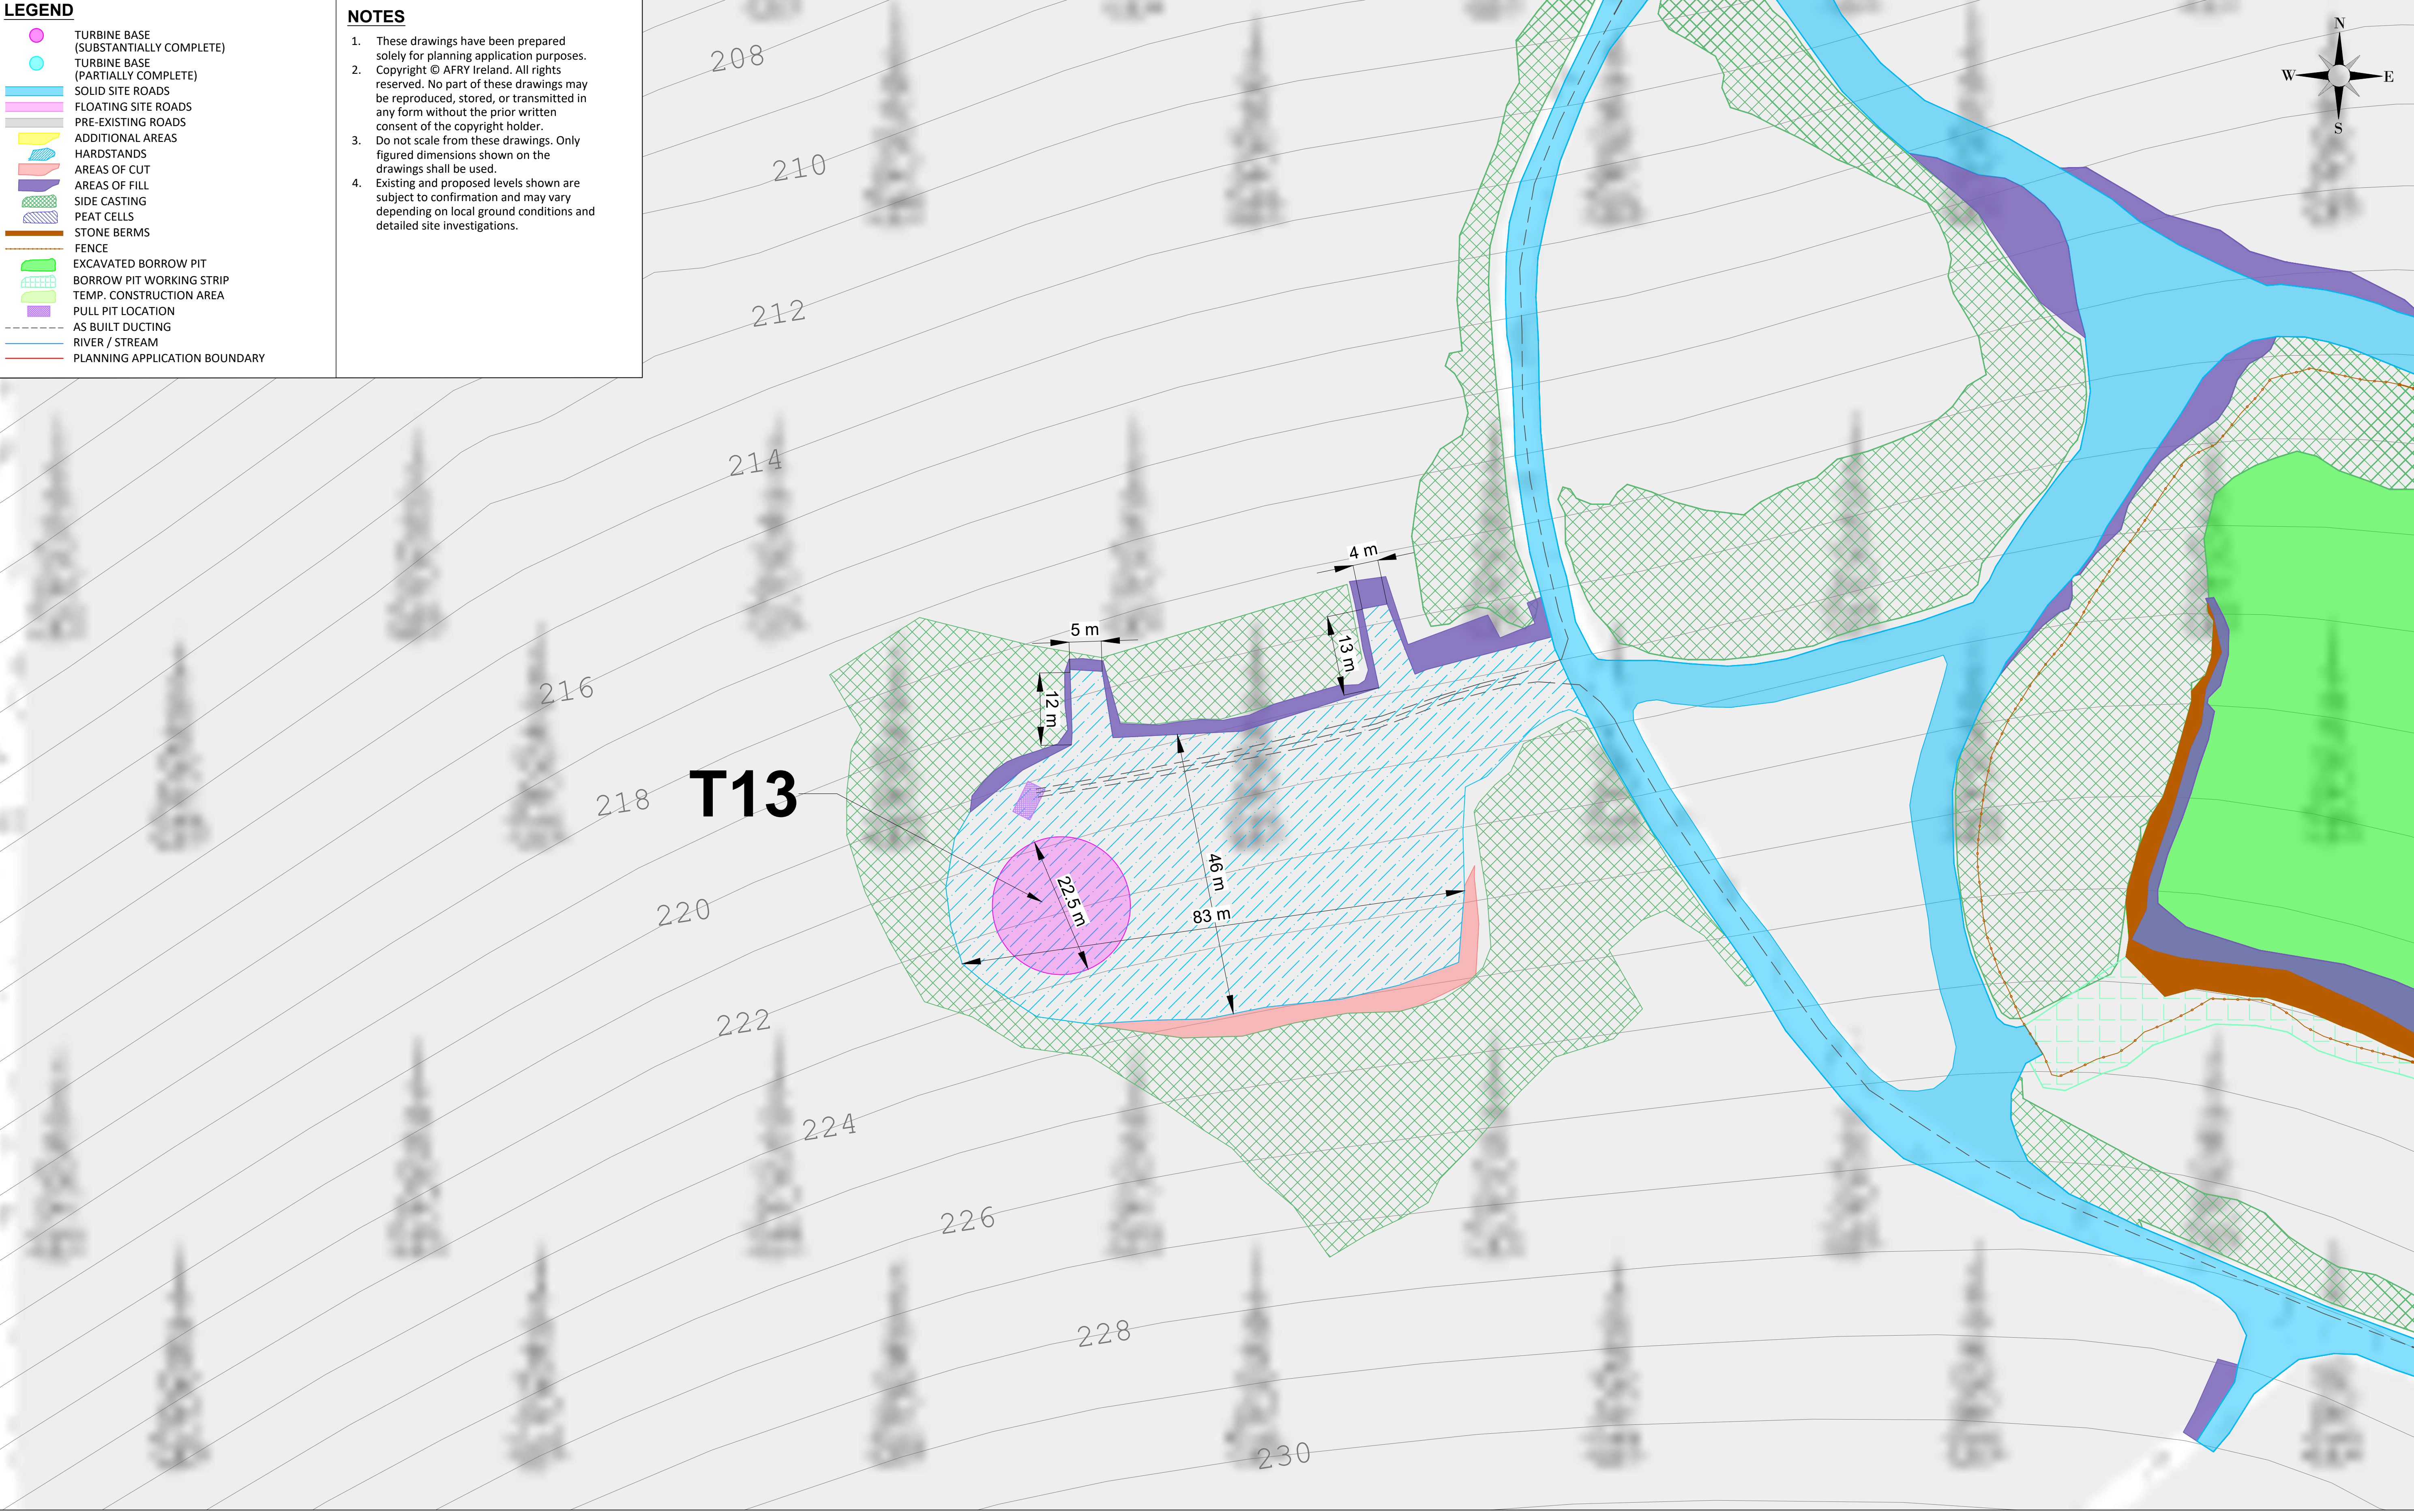

NOTES

A	04/06/2026	M.B.	L.P.	FIRST ISSUE
REV	DATE	DRAWN BY	CHECKED BY	DETAILS

ENGINEER



AFRY Ireland Ltd.
The Hyde Building, The Park,
Carrickmines,
D18VC44
Ireland
Tel: +353 (0) 1 845 5031

CLIENT

PROJECT

MEENBOG WIND FARM

TITLE
**EXISTING DEVELOPMENT TURBINE LAYOUT
TURBINE 13**

REVISION

A

DRAWN BY
M. BROWNE

DATE
04/06/2026

PAPER SIZE
A1

SCALE
1:500


CHECKED AND APPROVED
L. POWER

DATE
04/06/2026

STATUS
EXISTING

DRAWING NUMBER
MNBG d009.2.13

- LEGEND**
- TURBINE BASE (SUBSTANTIALLY COMPLETE)
 - TURBINE BASE (PARTIALLY COMPLETE)
 - SOLID SITE ROADS
 - FLOATING SITE ROADS
 - PRE-EXISTING ROADS
 - ADDITIONAL AREAS
 - HARDSTANDS
 - AREAS OF CUT
 - AREAS OF FILL
 - SIDE CASTING
 - PEAT CELLS
 - STONE BERMS
 - FENCE
 - EXCAVATED BORROW PIT
 - BORROW PIT WORKING STRIP
 - TEMP. CONSTRUCTION AREA
 - PULL PIT LOCATION
 - AS BUILT DUCTING
 - RIVER / STREAM
 - PLANNING APPLICATION BOUNDARY

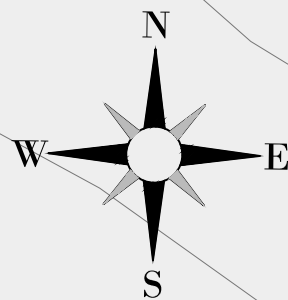

T14

NOTES

- These drawings have been prepared solely for planning application purposes. Copyright © AFRY Ireland. All rights reserved. No part of these drawings may be reproduced, stored, or transmitted in any form without the prior written consent of the copyright holder.
- Do not scale from these drawings. Only figured dimensions shown on the drawings shall be used.
- Existing and proposed levels shown are subject to confirmation and may vary depending on local ground conditions and detailed site investigations.

A	04/06/2026	M.B.	L.P.	FIRST ISSUE
REV	DATE	DRAWN BY	CHECKED BY	DETAILS

ENGINEER



AFRY Ireland Ltd.
The Hyde Building, The Park,
Carrickmines,
D18VC44
Ireland
Tel: +353 (0) 1 845 5031

CLIENT

PROJECT

MEENBOG WIND FARM

EXISTING DEVELOPMENT TURBINE LAYOUT
TURBINE 14

REVISION

A

DRAWN BY
M. BROWNE

DATE
04/06/2026

PAPER SIZE
A1

SCALE
1:500


CHECKED AND APPROVED
L. POWER

DATE
04/06/2026

STATUS
EXISTING

DRAWING NUMBER
MNBG d009.2.14

- LEGEND**
- TURBINE BASE (SUBSTANTIALLY COMPLETE)
 - TURBINE BASE (PARTIALLY COMPLETE)
 - SOLID SITE ROADS
 - FLOATING SITE ROADS
 - PRE-EXISTING ROADS
 - ADDITIONAL AREAS
 - HARDSTANDS
 - AREAS OF CUT
 - AREAS OF FILL
 - SIDE CASTING
 - PEAT CELLS
 - STONE BERMS
 - FENCE
 - EXCAVATED BORROW PIT
 - BORROW PIT WORKING STRIP
 - TEMP. CONSTRUCTION AREA
 - PULL PIT LOCATION
 - AS BUILT DUCTING
 - RIVER / STREAM
 - PLANNING APPLICATION BOUNDARY

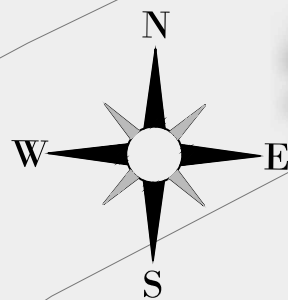

T15

NOTES

- These drawings have been prepared solely for planning application purposes. Copyright © AFRY Ireland. All rights reserved. No part of these drawings may be reproduced, stored, or transmitted in any form without the prior written consent of the copyright holder.
- Do not scale from these drawings. Only figured dimensions shown on the drawings shall be used.
- Existing and proposed levels shown are subject to confirmation and may vary depending on local ground conditions and detailed site investigations.

NOTES

Ordnance Survey Ireland License No. EN 0051326
© Ordnance Survey Ireland/Government of Ireland
Sheet No.'s: 0451,0452,0453,0479,0480,0481,0507, 0508

REV	DATE	DRAWN BY	CHECKED BY	DETAILS
A	04/06/2026	M.B.	L.P.	FIRST ISSUE

ENGINEER



AFRY Ireland Ltd.
The Hyde Building, The Park,
Carrickmines,
D18VC44
Ireland
Tel. +353 (0) 1 845 5031

CLIENT

PROJECT

MEENBOG WIND FARM

TITLE
**EXISTING DEVELOPMENT TURBINE LAYOUT
TURBINE 15**

REVISION

A

DRAWN BY
M. BROWNE

DATE
04/06/2026

PAPER SIZE
A1

SCALE
1:500

CHECKED AND APPROVED
L. POWER


DATE
04/06/2026

STATUS
EXISTING

DRAWING NUMBER
MNBG d009.2.15

Revised: 2019/02/08 12:58:59
C:\3-ROUTE\Draws\Projects\Meenbog\Meenbog MNBG\Drawings\MNBG 0009 Existing Layout.dwg (MNBG 0002 Turbine Layout.dwg)

- LEGEND**
- TURBINE BASE (SUBSTANTIALLY COMPLETE)
 - TURBINE BASE (PARTIALLY COMPLETE)
 - SOLID SITE ROADS
 - FLOATING SITE ROADS
 - PRE-EXISTING ROADS
 - ADDITIONAL AREAS
 - HARDSTANDS
 - AREAS OF CUT
 - AREAS OF FILL
 - SIDE CASTING
 - PEAT CELLS
 - STONE BERMS
 - FENCE
 - EXCAVATED BORROW PIT
 - BORROW PIT WORKING STRIP
 - TEMP. CONSTRUCTION AREA
 - PULL PIT LOCATION
 - AS BUILT DUCTING
 - RIVER / STREAM
 - PLANNING APPLICATION BOUNDARY

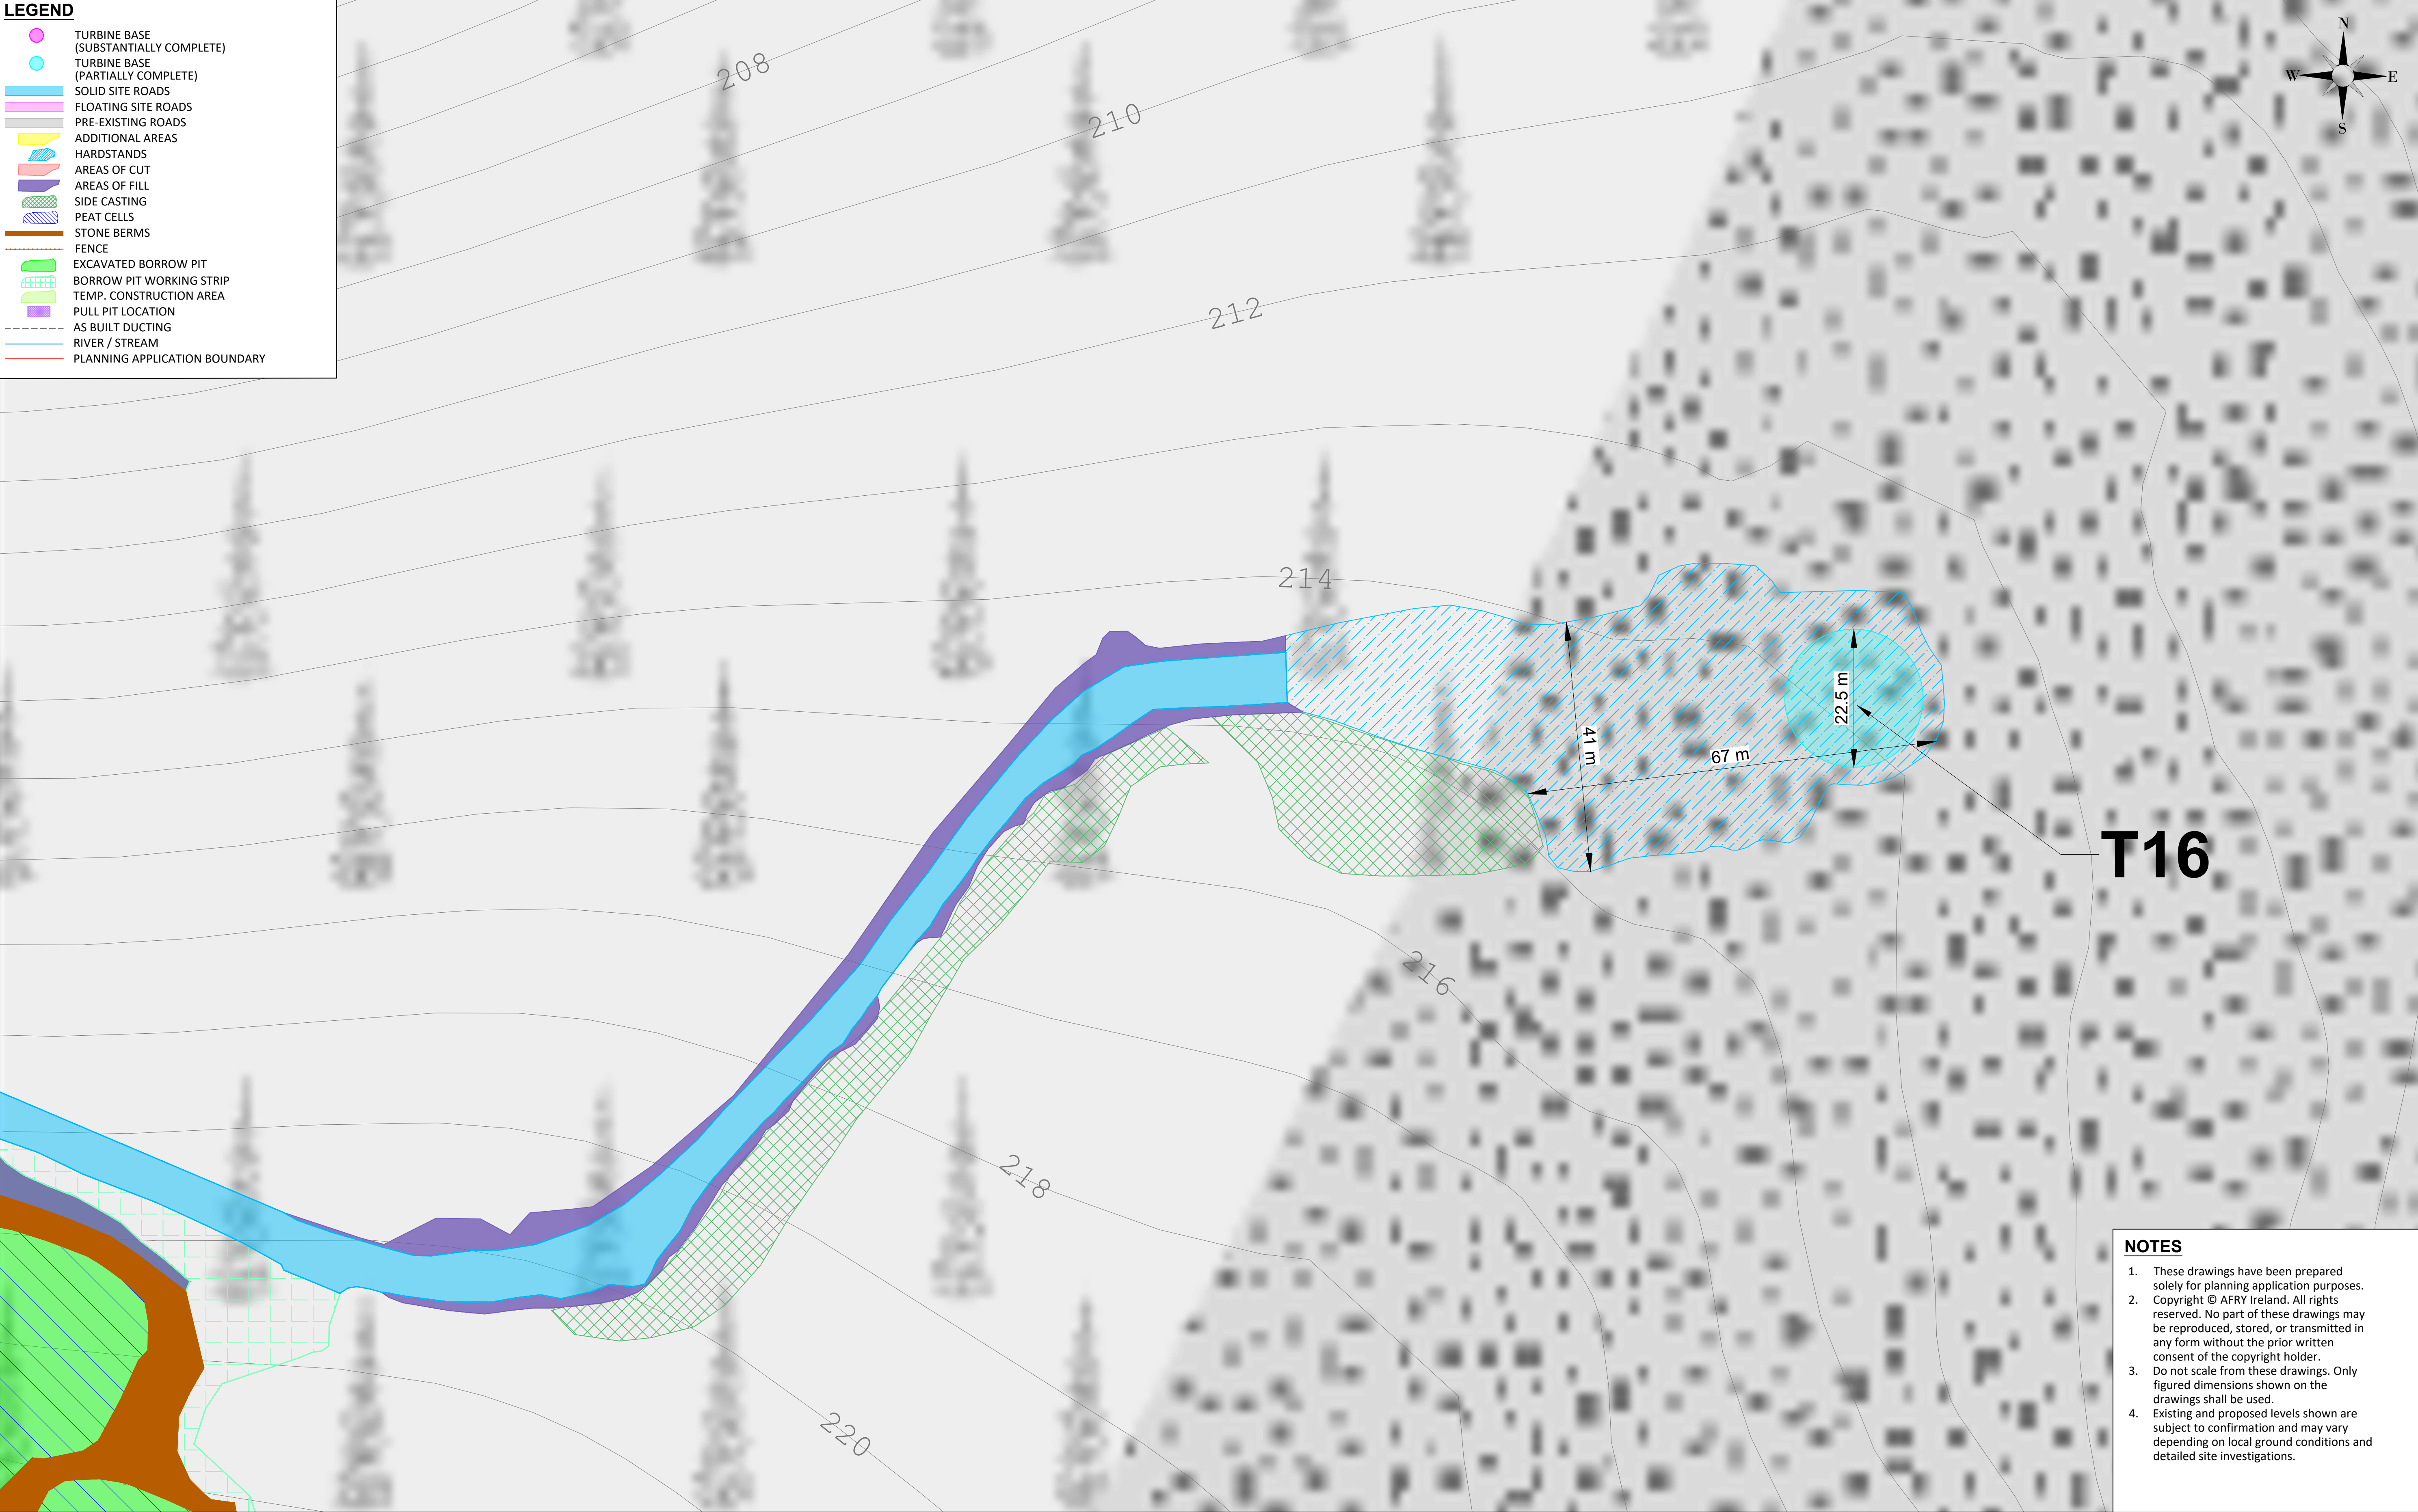

- NOTES**
- These drawings have been prepared solely for planning application purposes. Copyright © AFRY Ireland. All rights reserved. No part of these drawings may be reproduced, stored, or transmitted in any form without the prior written consent of the copyright holder.
 - Do not scale from these drawings. Only figured dimensions shown on the drawings shall be used.
 - Existing and proposed levels shown are subject to confirmation and may vary depending on local ground conditions and detailed site investigations.

NOTES

Ordnance Survey Ireland License No. EN 0051326
© Ordnance Survey Ireland/Government of Ireland
Sheet No's: 0451,0452,0453,0479,0480,0481,0507, 0508

A	04/06/2026	M.B.	L.P.	FIRST ISSUE
REV	DATE	DRAWN BY	CHECKED BY	DETAILS

ENGINEER



AFRY Ireland Ltd.
The Hyde Building, The Park,
Carrickmines,
D18VC44
Ireland
Tel: +353 (0) 1 845 5031

DRAWN BY

M. BROWNE

DATE

04/06/2026

CHECKED AND APPROVED

L. POWER

DATE

04/06/2026

CLIENT

PAPER SIZE

A1

SCALE

1:500

STATUS

EXISTING

PROJECT

MEENBOG WIND FARM

TITLE

EXISTING DEVELOPMENT TURBINE LAYOUT
TURBINE 16

DRAWING NUMBER

MNBG d009.2.16



REVISION

A

Printed: 2026/06/04 13:08:04
C:\3-ROUTE\Draw\Project\Draw\Meenbog\MNBG\Drawings\MNBG_0009_Existing_Layou-A4B.pdf

LEGEND

- TURBINE BASE (SUBSTANTIALLY COMPLETE)
- TURBINE BASE (PARTIALLY COMPLETE)
- SOLID SITE ROADS
- FLOATING SITE ROADS
- PRE-EXISTING ROADS
- ADDITIONAL AREAS
- HARDSTANDS
- AREAS OF CUT
- AREAS OF FILL
- SIDE CASTING
- PEAT CELLS
- STONE BERMS
- FENCE
- EXCAVATED BORROW PIT
- BORROW PIT WORKING STRIP
- TEMP. CONSTRUCTION AREA
- PULL PIT LOCATION
- AS BUILT DUCTING
- RIVER / STREAM
- PLANNING APPLICATION BOUNDARY

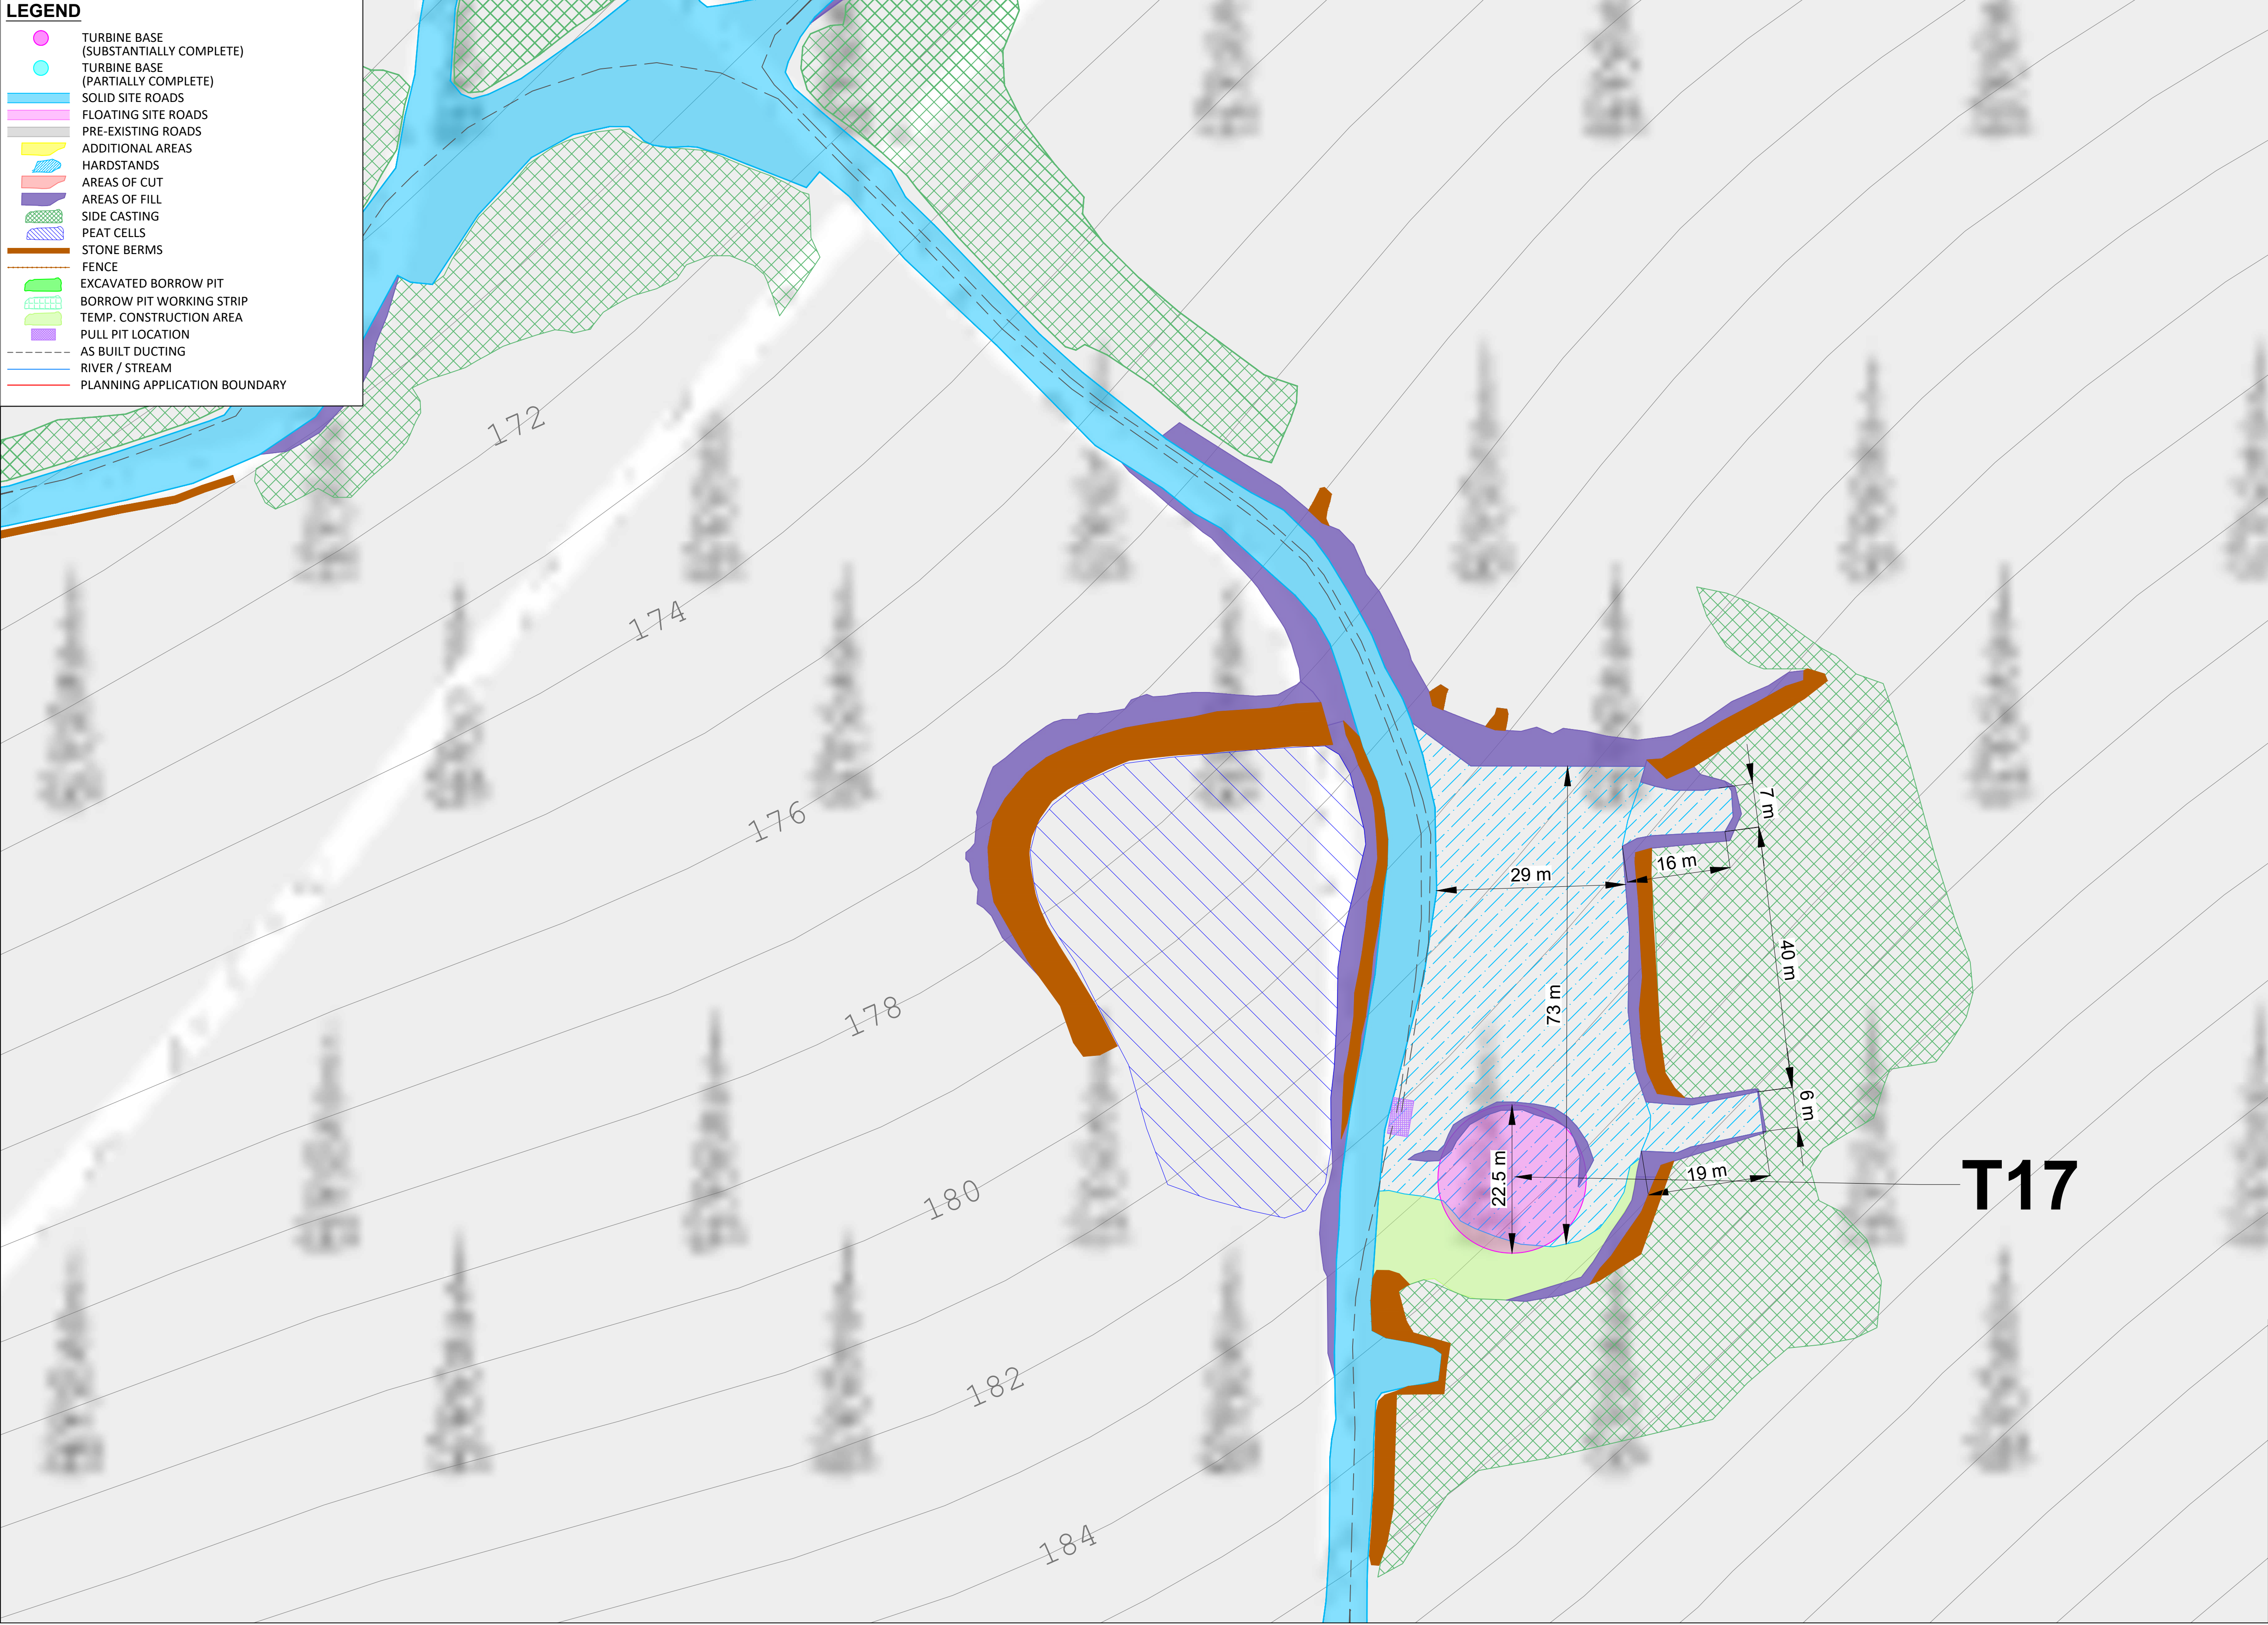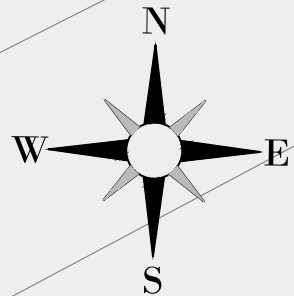

- NOTES**
- These drawings have been prepared solely for planning application purposes. Copyright © AFRY Ireland. All rights reserved. No part of these drawings may be reproduced, stored, or transmitted in any form without the prior written consent of the copyright holder.
 - Do not scale from these drawings. Only figured dimensions shown on the drawings shall be used.
 - Existing and proposed levels shown are subject to confirmation and may vary depending on local ground conditions and detailed site investigations.

NOTES

A	04/06/2026	M.B.	L.P.	FIRST ISSUE
REV	DATE	DRAWN BY	CHECKED BY	DETAILS

ENGINEER



AFRY Ireland Ltd.
The Hyde Building, The Park,
Carrickmines,
D18VC44
Ireland
Tel: +353 (0) 1 845 5031

CLIENT

PROJECT

MEENBOG WIND FARM

TITLE
**EXISTING DEVELOPMENT TURBINE LAYOUT
TURBINE 17**

REVISION

A

DRAWN BY
M. BROWNE

DATE
04/06/2026

PAPER SIZE
A1

SCALE
1:500

CHECKED AND APPROVED
L. POWER

DATE
04/06/2026

STATUS
EXISTING

DRAWING NUMBER
MNBG d009.2.17

LEGEND

TURBINE BASE
(SUBSTANTIALLY COMPLETE)

TURBINE BASE
(PARTIALLY COMPLETE)

SOLID SITE ROADS

FLOATING SITE ROADS

PRE-EXISTING ROADS

ADDITIONAL AREAS

HARDSTANDS

AREAS OF CUT

AREAS OF FILL

SIDE CASTING

PEAT CELLS

STONE BERMS

FENCE

EXCAVATED BORROW PIT

BORROW PIT WORKING STRIP


TEMP. CONSTRUCTION AREA

PULL PIT LOCATION

AS BUILT DUCTING

RIVER / STREAM

PLANNING APPLICATION BOUNDARY

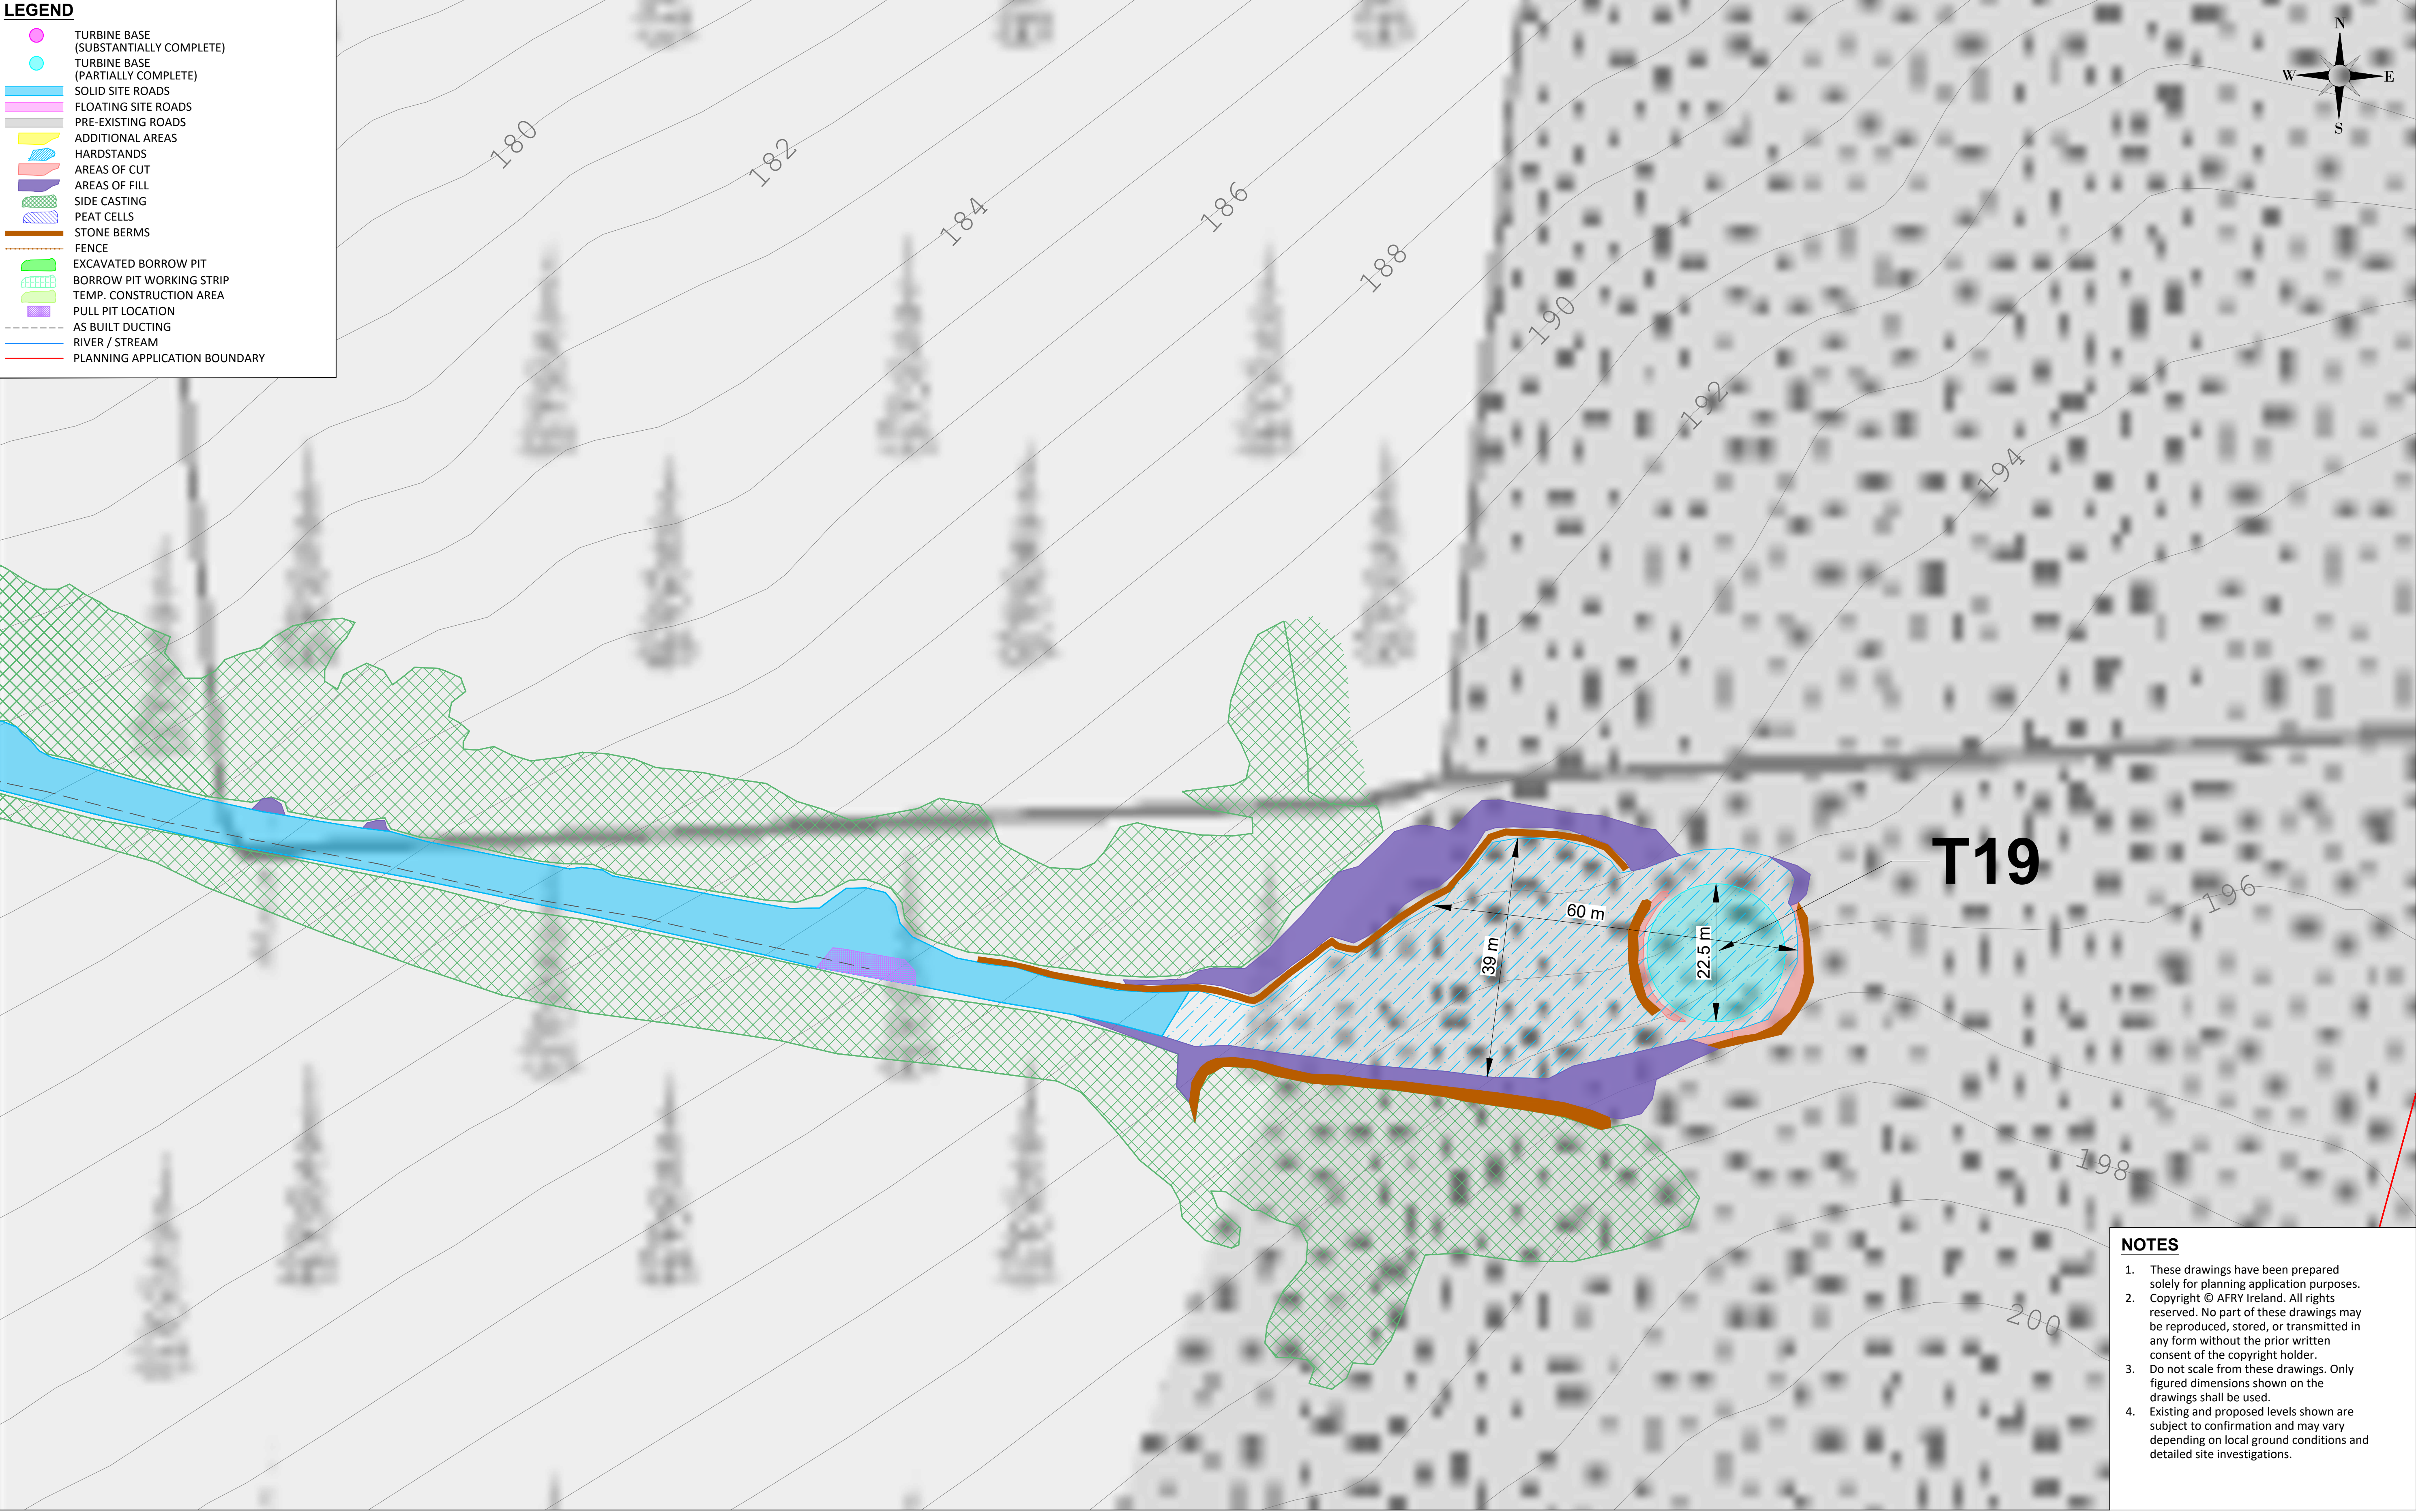

- NOTES
1.

These drawings have been prepared solely for planning application purposes. Copyright © AFRY Ireland. All rights reserved. No part of these drawings may be reproduced, stored, or transmitted in any form without the prior written consent of the copyright holder.
2.

Do not scale from these drawings. Only figured dimensions shown on the drawings shall be used.
3.

Existing and proposed levels shown are subject to confirmation and may vary depending on local ground conditions and detailed site investigations.

NOTES					ENGINEER		CLIENT		PROJECT	
Ordnance Survey Ireland License No. EN 0051326 © Ordnance Survey Ireland/Government of Ireland Sheet No's: 0451,0452,0453,0479,0480,0481,0507, 0508					AFRY AF PÖYRÝ AFRY Ireland Ltd. The Hyde Building, The Park, Carrickmines, D18VC44 Ireland Tel: +353 (0) 1 845 5031				MEENBOG WIND FARM	
									TITLE	
									EXISTING DEVELOPMENT TURBINE LAYOUT TURBINE 19	
REV					DRAWN BY		DATE		PAPER SIZE	
A					M. BROWNE		04/06/2026		A1	
DATE					CHECKED AND APPROVED		DATE		SCALE	
					L. POWER		04/06/2026		1:500	
DRAWN BY					STATUS		EXISTING		DRAWING NUMBER	
M.B.									MNBG d009.2.19	
CHECKED BY					DETAILS				REVISION	
									A	