



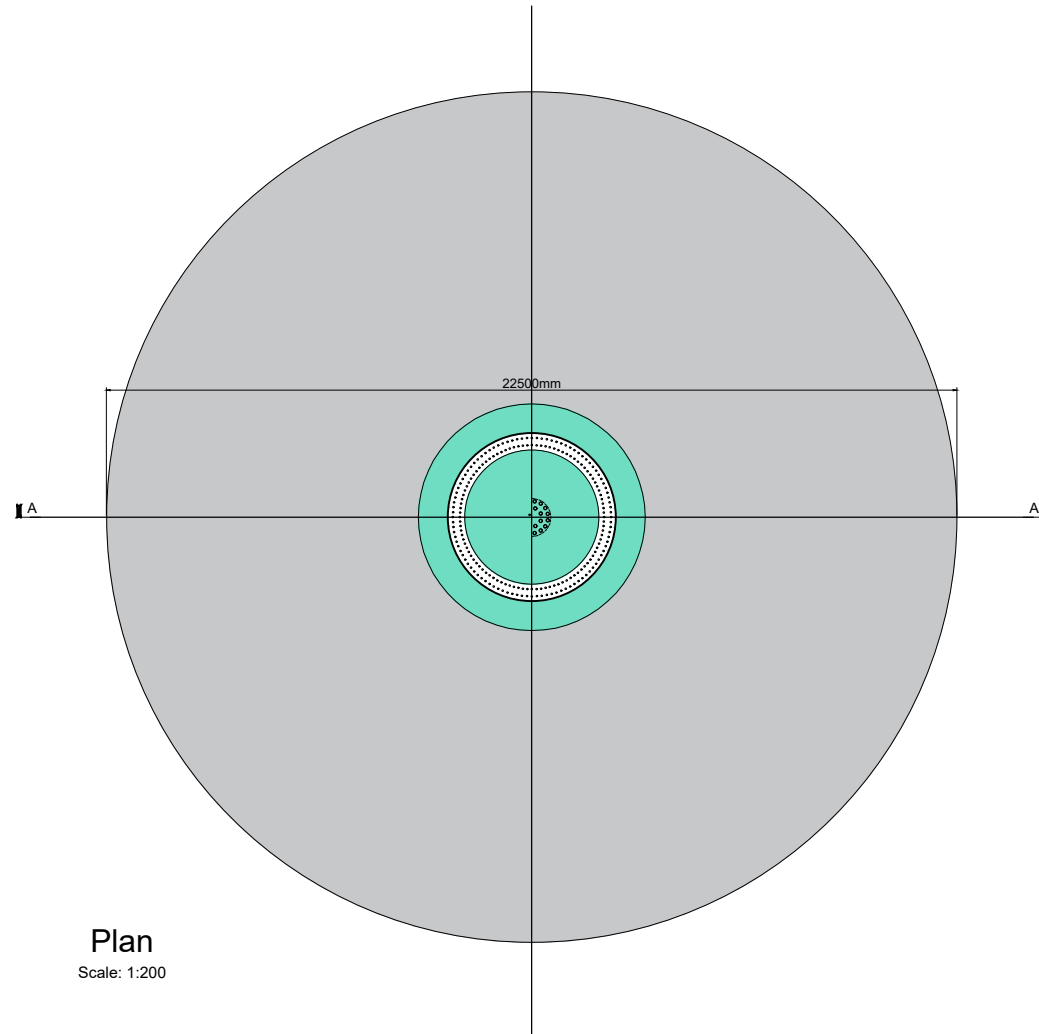

Plan
Scale: 1:200

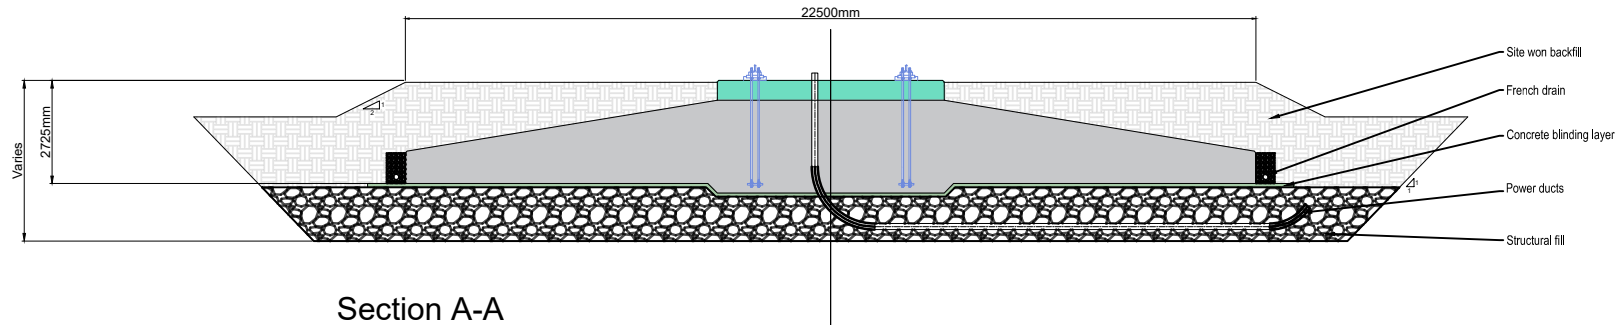

Section A-A
Scale: 1:200

NOTES						ENGINEER		PROJECT		CLIENT		PROJECT			
						AFRY AFRY Ireland Ltd. The Hyde Building, The Park, Carrickmines, D18VC44 Ireland Tel. +353 (0) 1 845 5031						MEENBOG WIND FARM			
						DRAWN BY		DATE		PAPER SIZE	SCALE	TITLE		REVISION	
						M. BROWNE		23/06/2026		A3	1:200				
						CHECKED AND APPROVED		DATE		STATUS		DRAWING NUMBER			
						L. POWER		23/06/2026		EXISTING		MNBG d020.1.1			
	REV	DATE	DRAWN BY	CHECKED BY	DETAILS										
	A	23/06/2026	M.B.	L.P.	FIRST ISSUE										
X:\040_EU\040-Proposals\4000\Drawing\MNBG d020.1.1.dwg Revision: 0206/001 11/02/21 X:\040_EU\040-Proposals\4000\Drawing\MNBG d020.1.1.dwg X:\040_EU\040-Proposals\4000\Drawing\MNBG d020.1.1.dwg															