


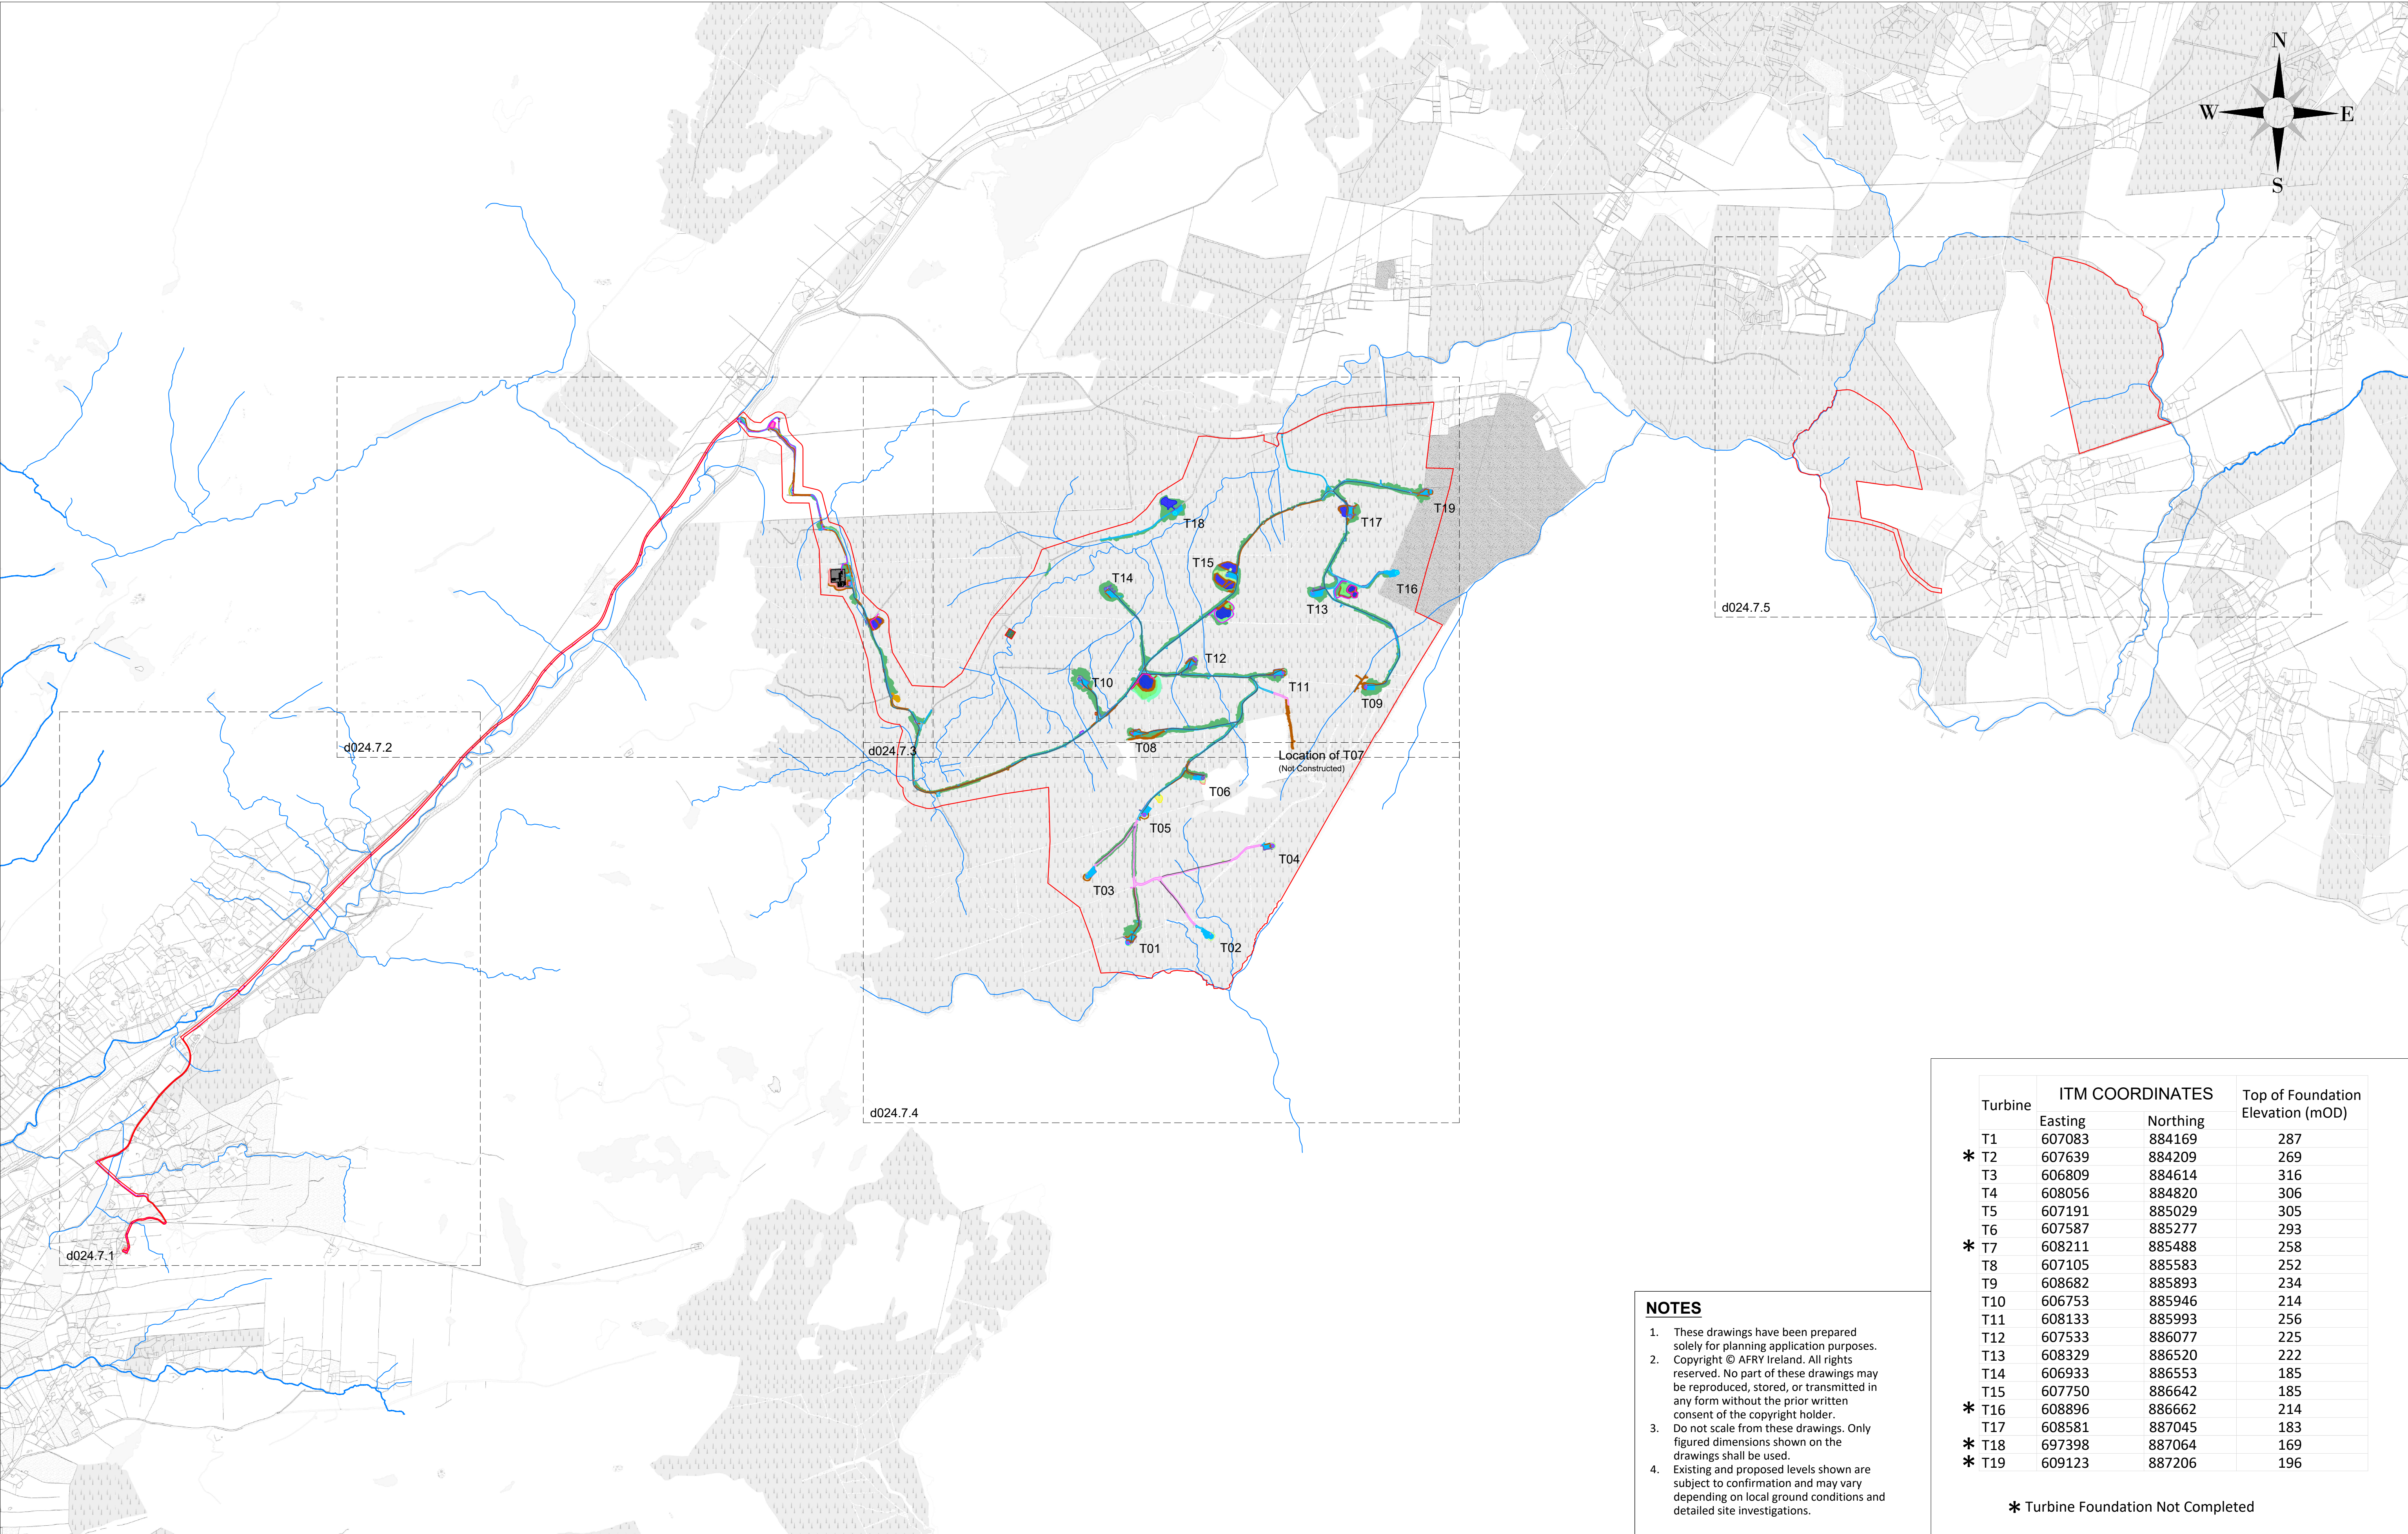

NOTES

- These drawings have been prepared solely for planning application purposes.
- Copyright © AFRY Ireland. All rights reserved. No part of these drawings may be reproduced, stored, or transmitted in any form without the prior written consent of the copyright holder.
- Do not scale from these drawings. Only figured dimensions shown on the drawings shall be used.
- Existing and proposed levels shown are subject to confirmation and may vary depending on local ground conditions and detailed site investigations.

Turbine	ITM COORDINATES		Top of Foundation Elevation (mOD)
	Easting	Northing	
T1	607083	884169	287
* T2	607639	884209	269
T3	606809	884614	316
T4	608056	884820	306
T5	607191	885029	305
T6	607587	885277	293
* T7	608211	885488	258
T8	607105	885583	252
T9	608682	885893	234
T10	606753	885946	214
T11	608133	885993	256
T12	607533	886077	225
T13	608329	886520	222
T14	606933	886553	185
T15	607750	886642	185
* T16	608896	886662	214
T17	608581	887045	183
* T18	697398	887064	169
* T19	609123	887206	196

* Turbine Foundation Not Completed

NOTES

Ordnance Survey Ireland License No. EN 0051326
© Ordnance Survey Ireland/Government of Ireland
Sheet No.'s: 0451,0452,0453,0479,0480,0481,0507, 0508

REV	DATE	DRAWN BY	CHECKED BY	DETAILS
A	23/06/2026	M.B.	L.P.	FIRST ISSUE

ENGINEER



AFRY Ireland Ltd.
The Hyde Building, The Park,
Carrickmines,
D18VC44
Ireland
Tel: +353 (0) 1 845 5031

DRAWN BY
M. BROWNE

DATE
23/06/2026

CHECKED AND APPROVED
L. POWER

DATE
23/06/2026

CLIENT

PAPER SIZE
A1

SCALE
1:20,000

STATUS
EXISTING

PROJECT

MEENBOG WIND FARM

TITLE

EXISTING DEVELOPMENT LAYOUT
1:5000 KEYPLAN

DRAWING NUMBER

MNBG d024.7.0

REVISION


A

LEGEND

- 110kV UNDERGROUND GRID CONNECTION CABLING
- JOINT BAY
- COMMUNICATIONS CHAMBER
- LINK BOX
- TRANSITION CHAMBER
- CULVERT CROSSING
- BRIDGE CROSSING
- RIVER / STREAM
- PLANNING APPLICATION BOUNDARY

NOTES

- These drawings have been prepared solely for planning application purposes. Copyright © AFRY Ireland. All rights reserved. No part of these drawings may be reproduced, stored, or transmitted in any form without the prior written consent of the copyright holder.
- Do not scale from these drawings. Only figured dimensions shown on the drawings shall be used.
- Existing and proposed levels shown are subject to confirmation and may vary depending on local ground conditions and detailed site investigations.

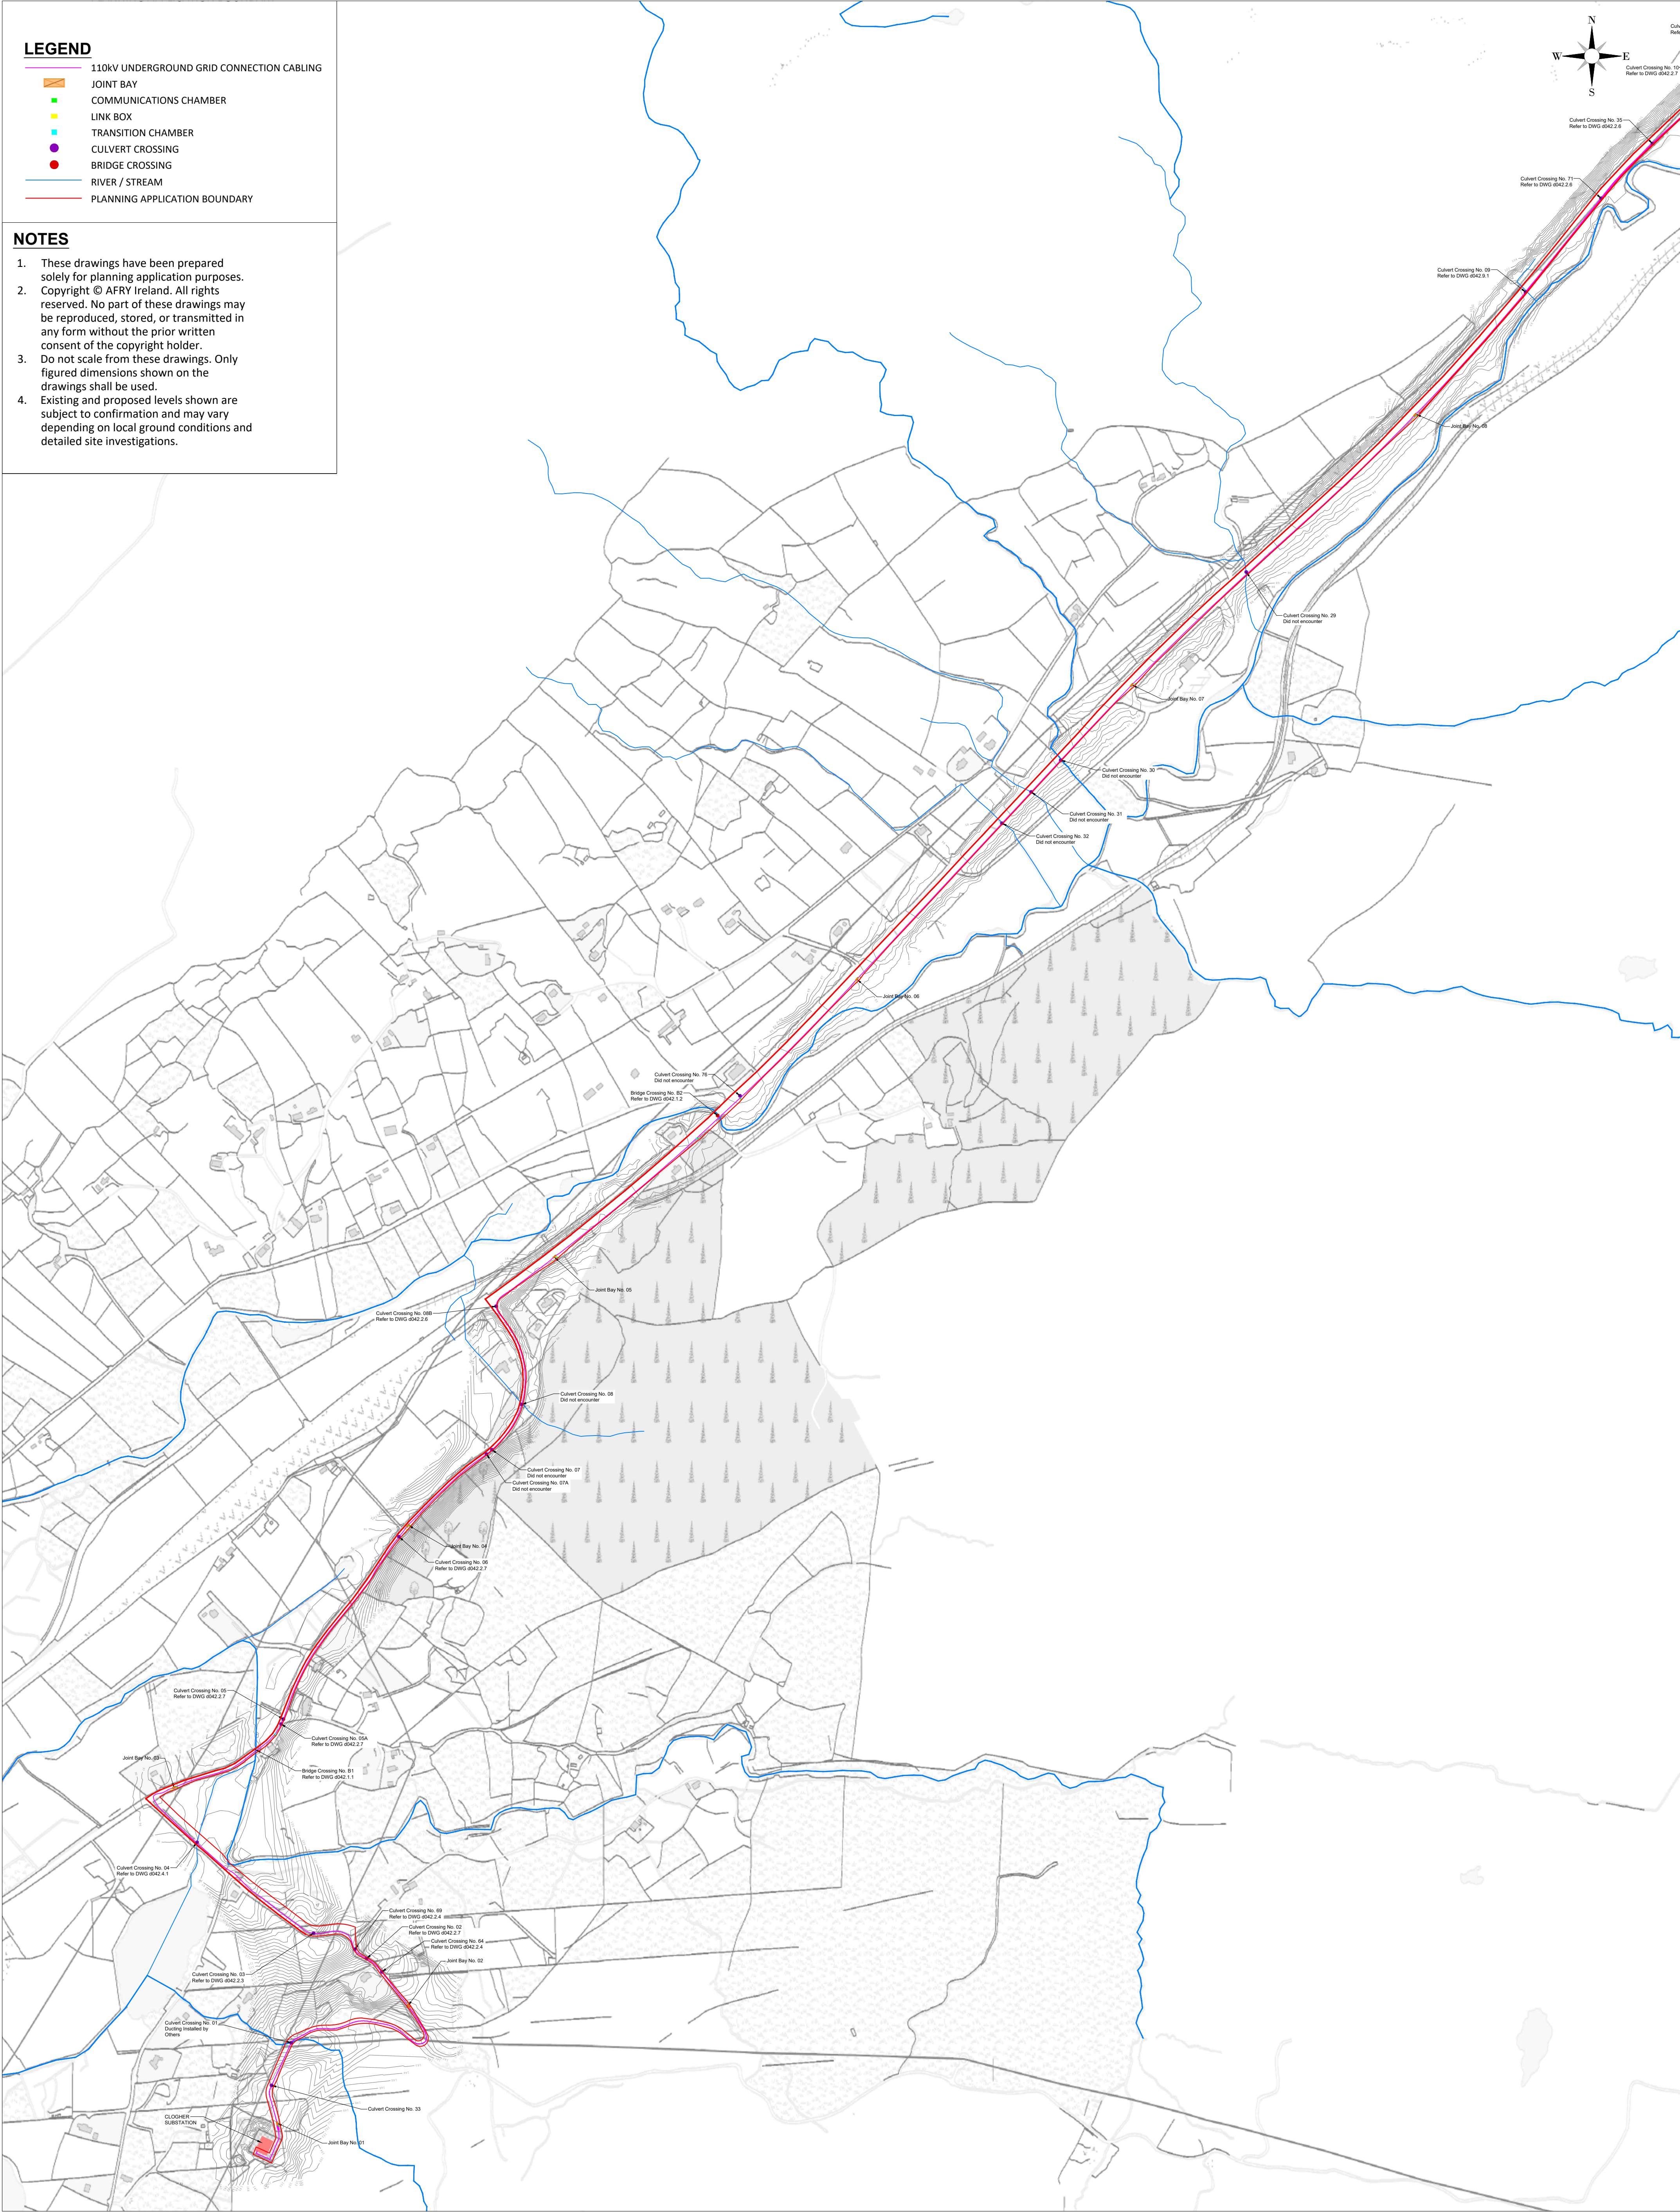

Ordnance Survey Ireland License No. EN 0051326
© Ordnance Survey Ireland/Government of Ireland
Sheet No's: 0451,0452,0453,0479,0480,0481,0507, 0508

REV	DATE	DRAWN BY	CHECKED BY	DETAILS
A	23/06/2026	M.B.	L.P.	FIRST ISSUE

ENGINEER		AFRY AF PÓRY		AFRY Ireland Ltd. The Hyde Building, The Park, Carrickmines, D18VC44 Ireland Tel. +353 (0) 1 845 5031	
DRAWN BY M. BROWNE		DATE 23/06/2026		PAPER SIZE A1	
CHECKED AND APPROVED L. POWER		DATE 23/06/2026		SCALE 1:5000	
				STATUS EXISTING	


CLIENT		PROJECT MEENBOG WIND FARM	
		TITLE EXISTING DEVELOPMENT LAYOUT SHEET 1	
		REVISION A	
		DRAWING NUMBER MNBG d024.7.1	

LEGEND

- TURBINE BASE (SUBSTANTIALLY COMPLETE)
- TURBINE BASE (PARTIALLY COMPLETE)
- SOLID SITE ROADS
- FLOATING SITE ROADS
- PRE-EXISTING ROADS
- ADDITIONAL AREAS
- HARDSTANDS
- AREAS OF CUT
- AREAS OF FILL
- SIDE CASTING
- PEAT CELLS
- STONE BERMS
- FENCE
- AS BUILT GATE
- PRE-EXISTING LANDOWNER GATE
- CONCRETE WASHOUT AREA
- TEMP. CONSTRUCTION COMPOUND
- EXCAVATED BORROW PIT
- BORROW PIT WORKING STRIP
- TEMP. CONSTRUCTION AREA
- PULL PIT LOCATION
- AS BUILT DUCTING
- 110kV UNDERGROUND GRID CONNECTION CABLING
- JOINT BAY
- COMMUNICATIONS CHAMBER
- LINK BOX
- TRANSITION CHAMBER
- CULVERT CROSSING
- BRIDGE CROSSING
- RIVER / STREAM
- PLANNING APPLICATION BOUNDARY

NOTES

- These drawings have been prepared solely for planning application purposes.
- Copyright © AFRY Ireland. All rights reserved. No part of these drawings may be reproduced, stored, or transmitted in any form without the prior written consent of the copyright holder.
- Do not scale from these drawings. Only figured dimensions shown on the drawings shall be used.
- Existing and proposed levels shown are subject to confirmation and may vary depending on local ground conditions and detailed site investigations.

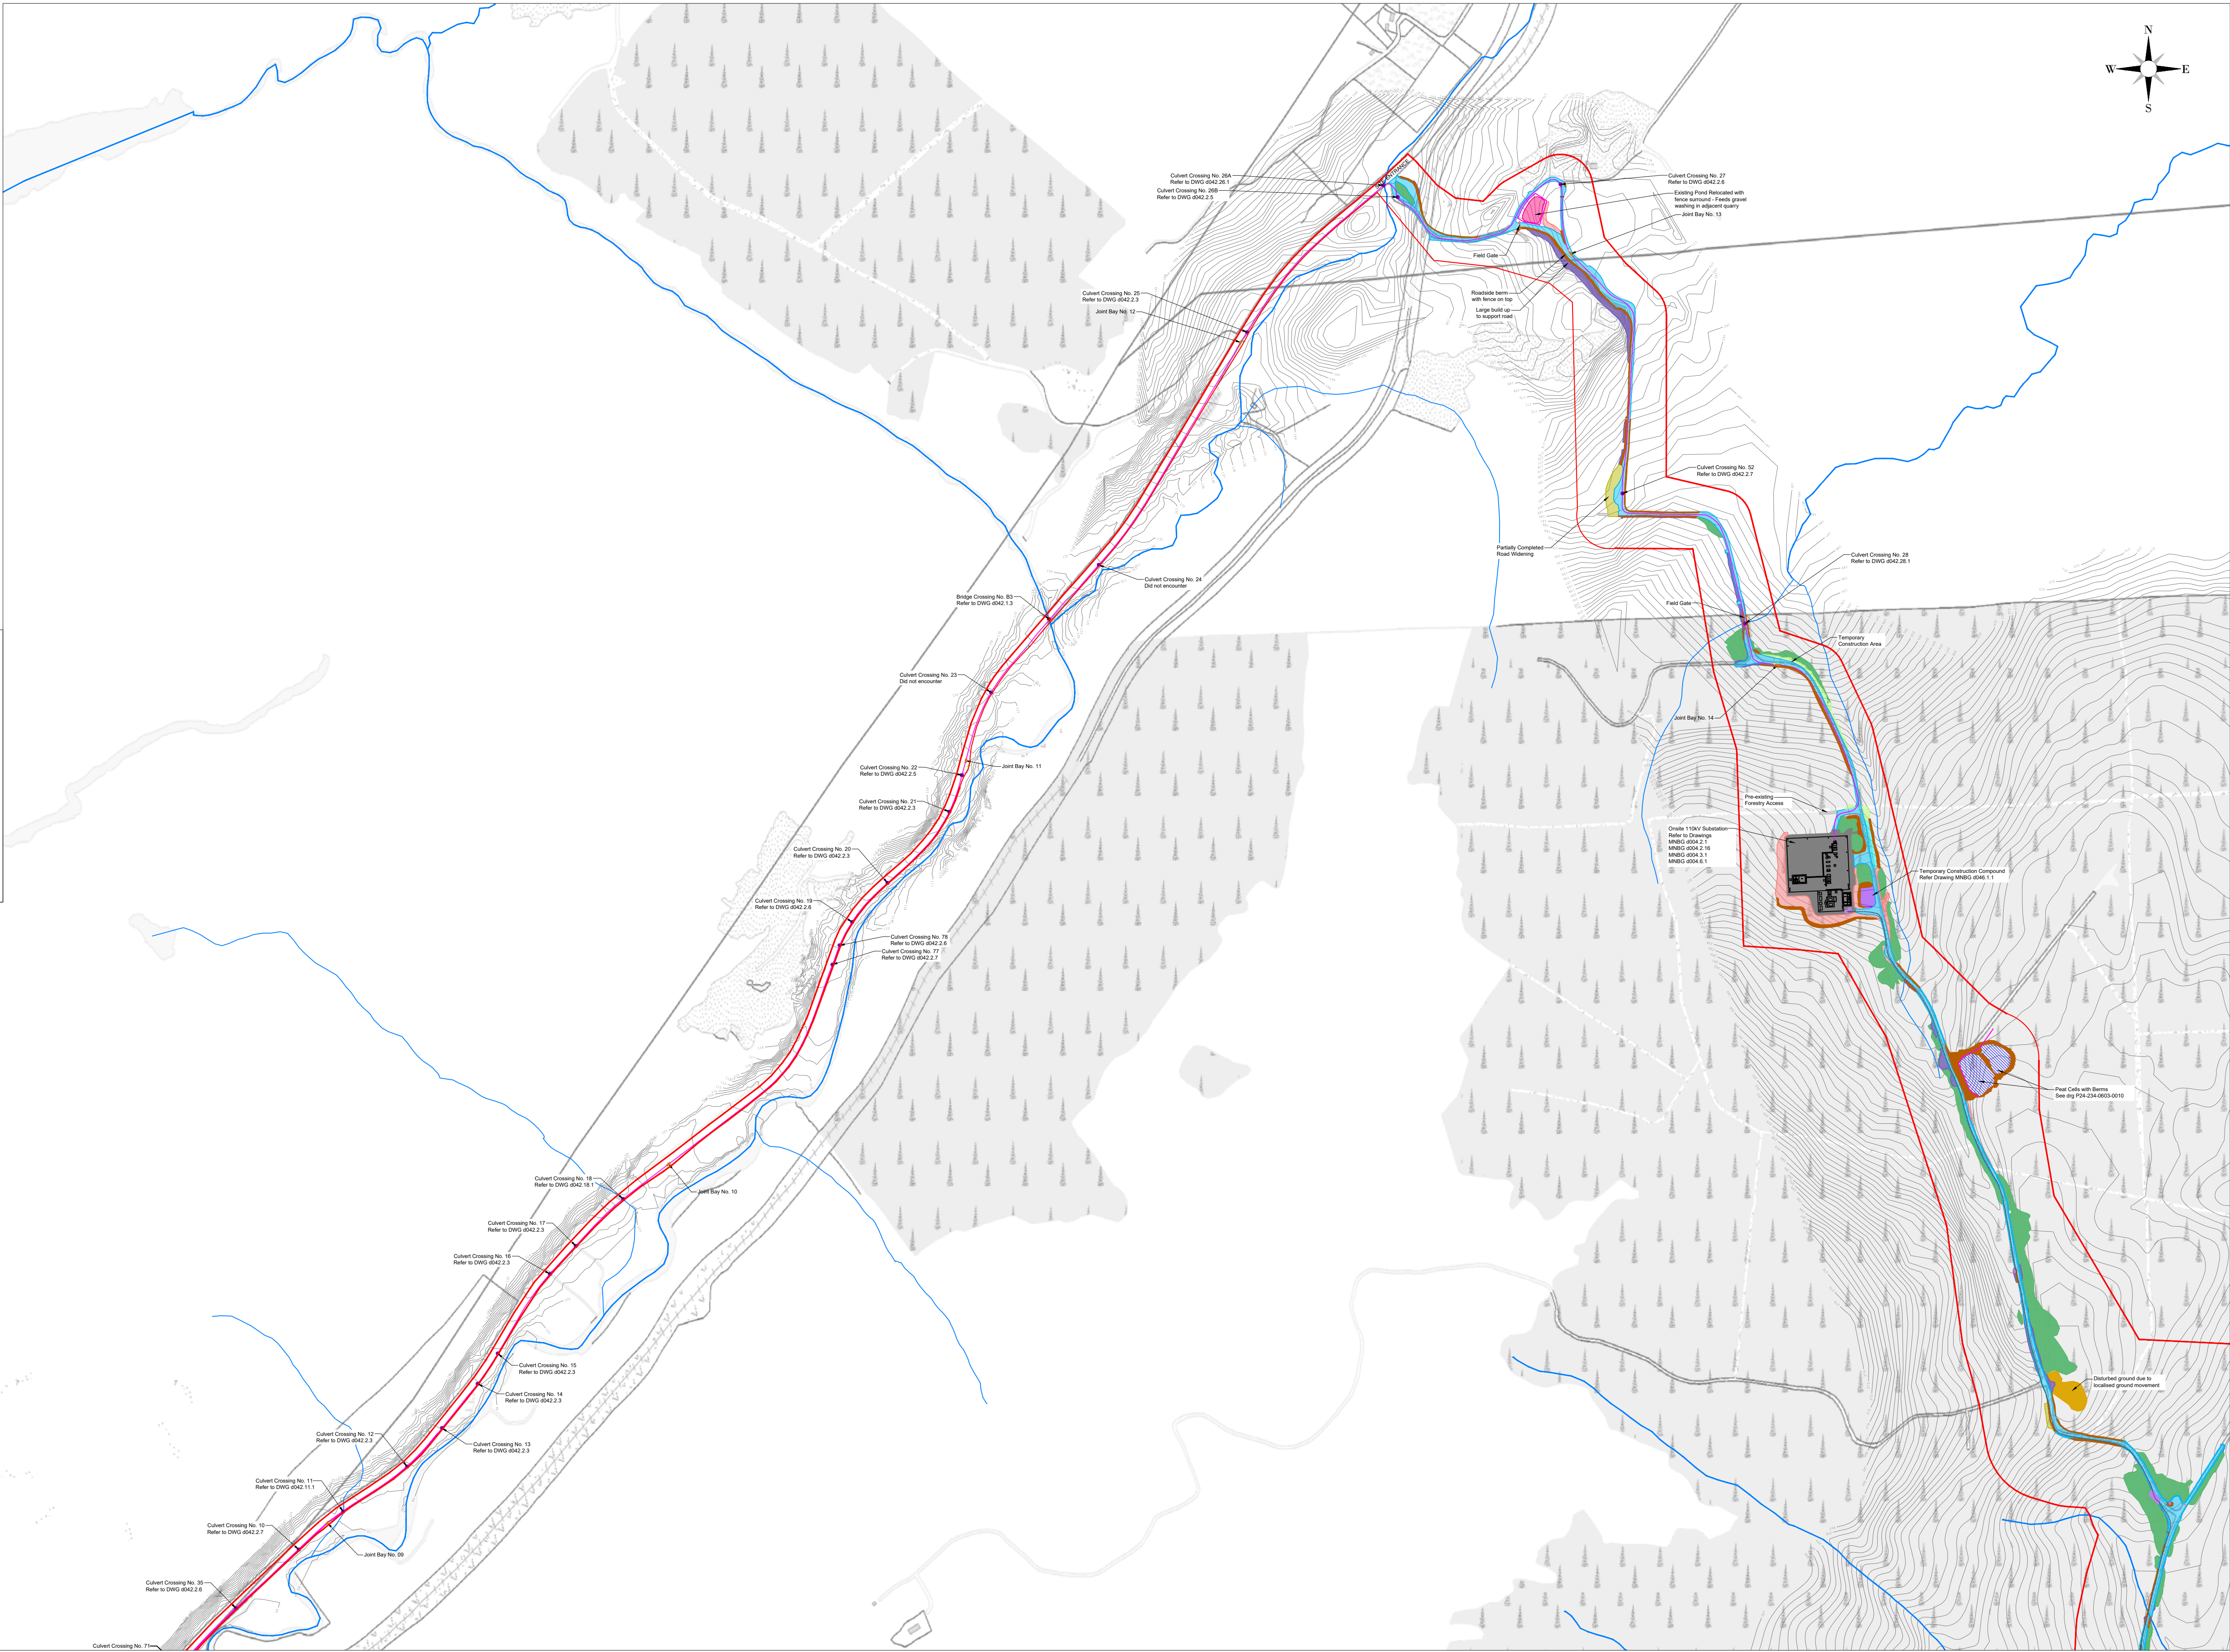

REFER d024.7.1 FOR CONTINUATION

REFER d024.7.3 FOR CONTINUATION

NOTES

Ordnance Survey Ireland License No. EN 0051326
© Ordnance Survey Ireland/Government of Ireland
Sheet No's: 0451,0452,0453,0479,0480,0481,0507, 0508

A	23/06/2026	M.B.	L.P.	FIRST ISSUE
REV	DATE	DRAWN BY	CHECKED BY	DETAILS

ENGINEER



AFRY Ireland Ltd.
The Hyde Building, The Park,
Carrickmines,
D18VC44
Ireland
Tel: +353 (0) 1 845 5031

DRAWN BY

M. BROWNE

DATE

23/06/2026

CHECKED AND APPROVED

L. POWER

DATE

23/06/2026

CLIENT

PAPER SIZE

A1

SCALE

1:5000

STATUS

EXISTING

PROJECT

MEENBOG WIND FARM

TITLE

EXISTING DEVELOPMENT LAYOUT
SHEET 2


REVISION


A

DRAWING NUMBER

MNBG d024.7.2

Printed: 2026/06/23 12:02:52
X:\3-BUVED\afry\projects\meenbog\MNBG\Drawings\MNBG 024-7\Layout 2\meenbog 1:5000.dwg

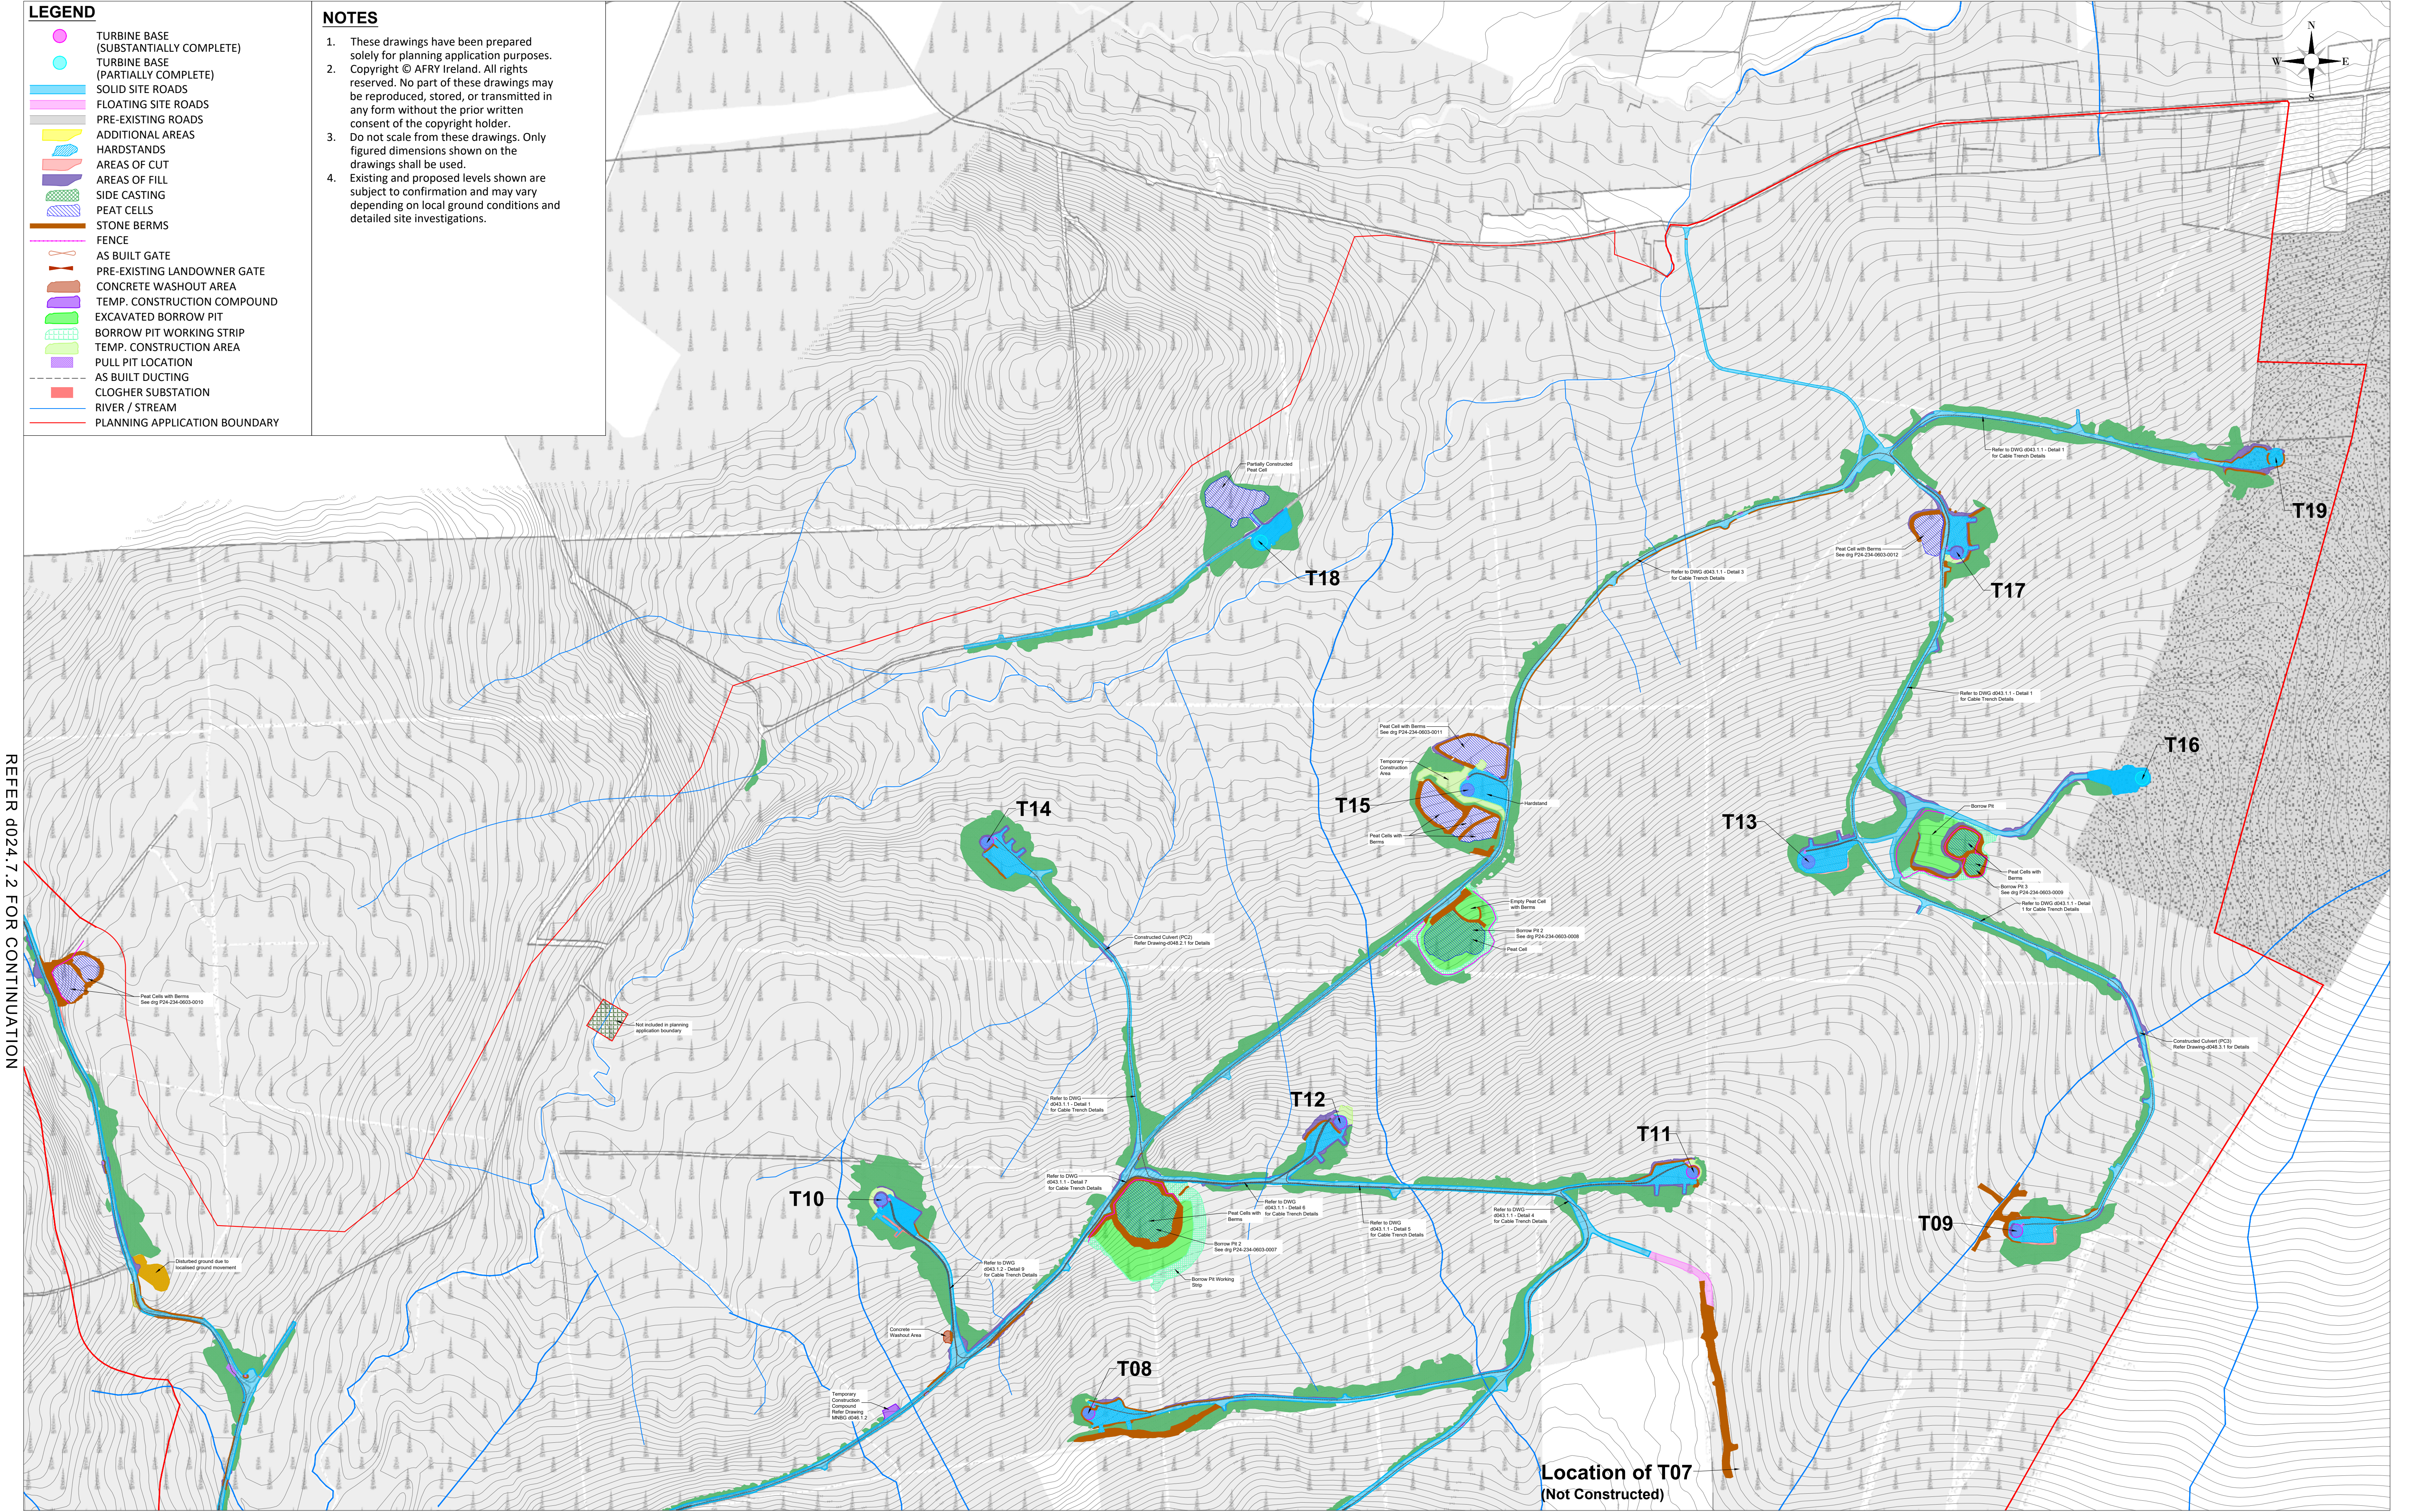

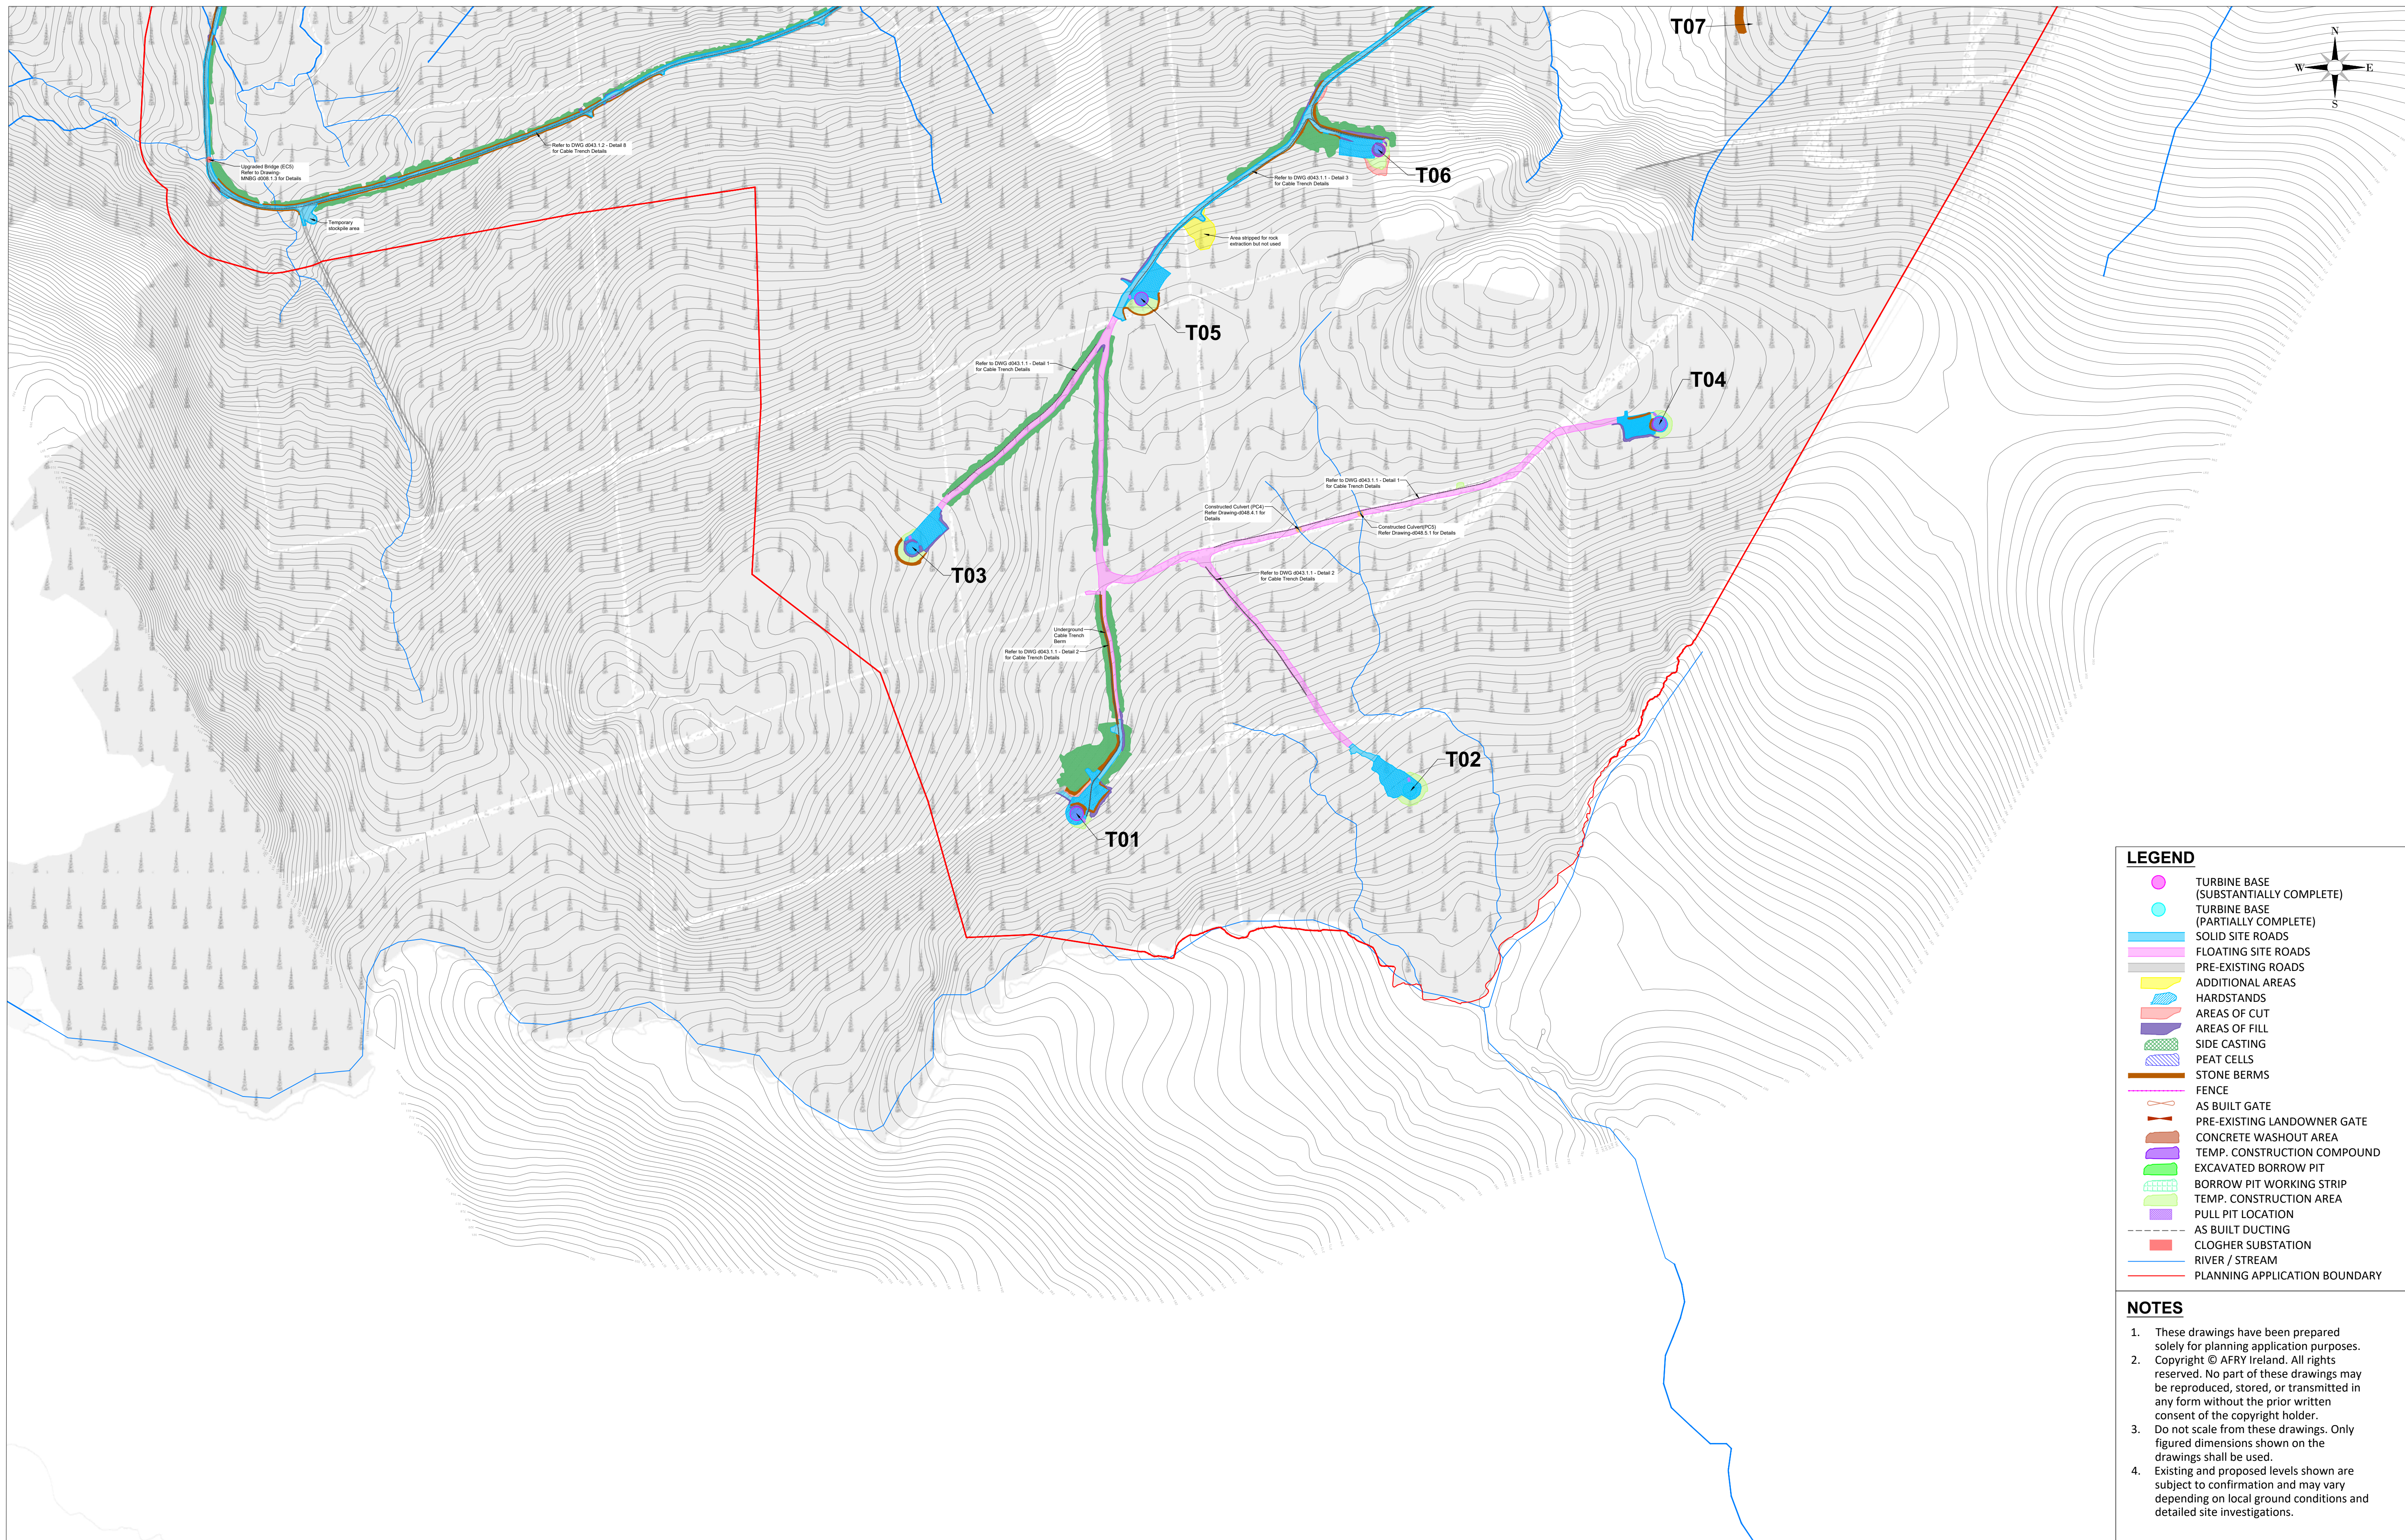

LEGEND

-
-  TURBINE BASE (SUBSTANTIALLY COMPLETE)
 TURBINE BASE (PARTIALLY COMPLETE)
 SOLID SITE ROADS
 FLOATING SITE ROADS
 PRE-EXISTING ROADS
 ADDITIONAL AREAS
 HARDSTANDS
 AREAS OF CUT
 AREAS OF FILL
 SIDE CASTING
 PEAT CELLS
 STONE BERMS
 FENCE
 AS BUILT GATE
 PRE-EXISTING LANDOWNER GATE
 CONCRETE WASHOUT AREA
 TEMP. CONSTRUCTION COMPOUND
 EXCAVATED BORROW PIT
 BORROW PIT WORKING STRIP
 TEMP. CONSTRUCTION AREA
 PULL PIT LOCATION
 AS BUILT DUCTING
 CLOGHER SUBSTATION
 RIVER / STREAM
 PLANNING APPLICATION BOUNDARY

NOTES

1. These drawings have been prepared solely for planning application purposes. Copyright © AFR Limited. All rights reserved. No part of these drawings may be reproduced, stored, or transmitted in any form without the prior written consent of the copyright holder.
3. Do not scale from these drawings. Only figured dimensions shown on the drawings shall be used.
4. Existing and proposed levels shown are subject to confirmation and may vary depending on local ground conditions and detailed site investigations.

MEENBOG WIND FARM

EXISTING DEVELOPMENT LAYOUT
SHEET 4

A

DRAWING NUMBER	MNBG d024.7.4
----------------	---------------

Printed - 23/06/2026 12:30

Ordnance Survey Ireland License No. EN 0051326
© Ordnance Survey Ireland/Government of Ireland
Sheet No.'s: 0451,0452,0453,0479,0480,0481,0507, 0508

A	23/06/2026	M.B.	L.P.	FIRST ISSUE
REV	DATE	DRAWN BY	CHECKED BY	DETAILS

ENGINEER




AFRY Ireland Ltd.
The Hyde Building, The Park
Carrickmines,
D18VC44
Ireland
Tel. +353 (0) 1 845 5031

	CLIENT
--	--------

PAPER SIZE	A1
STATUS	EXISTING

DRAWN BY	M. BROWNE
CHECKED AND APPROVED	L. POWER

DATE	23/06/2026
DATE	23/06/2026

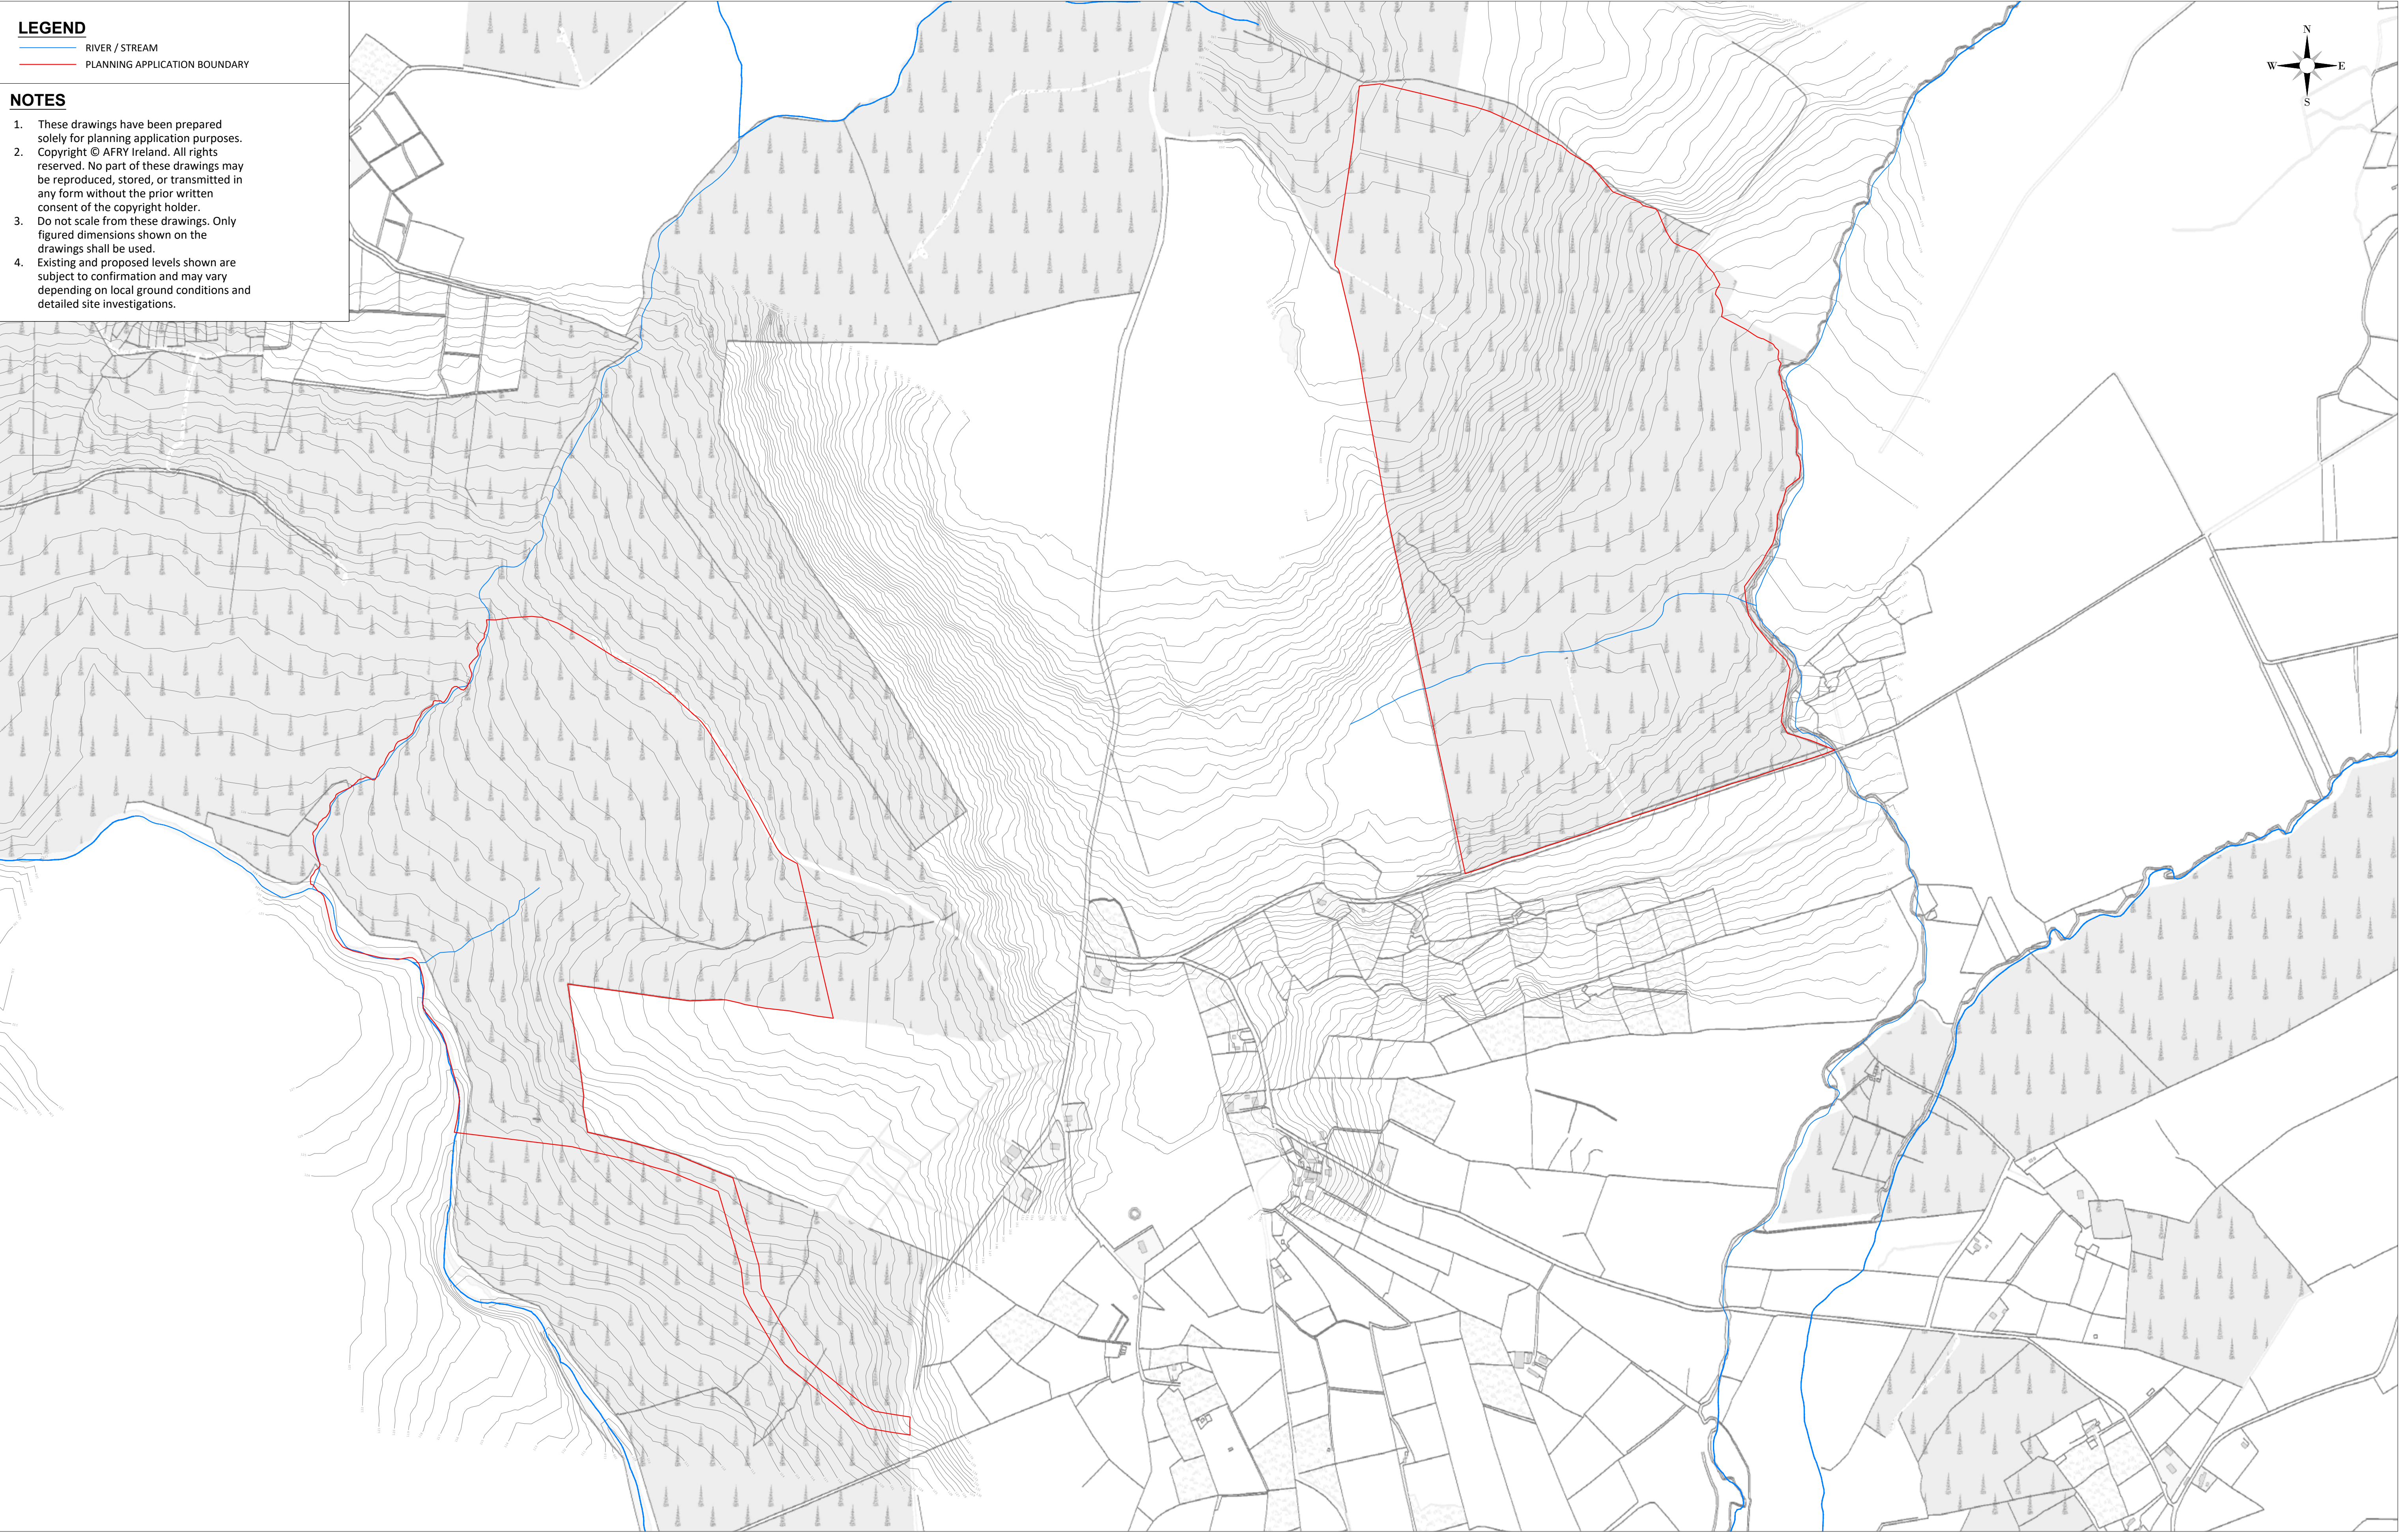

NOTES

A	23/06/2026	M.B.	L.P.	FIRST ISSUE
REV	DATE	DRAWN BY	CHECKED BY	DETAILS

ENGINEER



AFRY Ireland Ltd.
The Hyde Building, The Park,
Carrickmines,
D18VC44
Ireland
Tel: +353 (0) 1 845 5031

CLIENT

PROJECT

MEENBOG WIND FARM

EXISTING DEVELOPMENT LAYOUT
SHEET 5

REVISION

A

DRAWN BY
M. BROWNE

DATE
23/06/2026

CHECKED AND APPROVED
L. POWER

DATE
23/06/2026

PAPER SIZE

A1

SCALE

1:5000

STATUS

EXISTING

DRAWING NUMBER

MNBG d024.7.5