




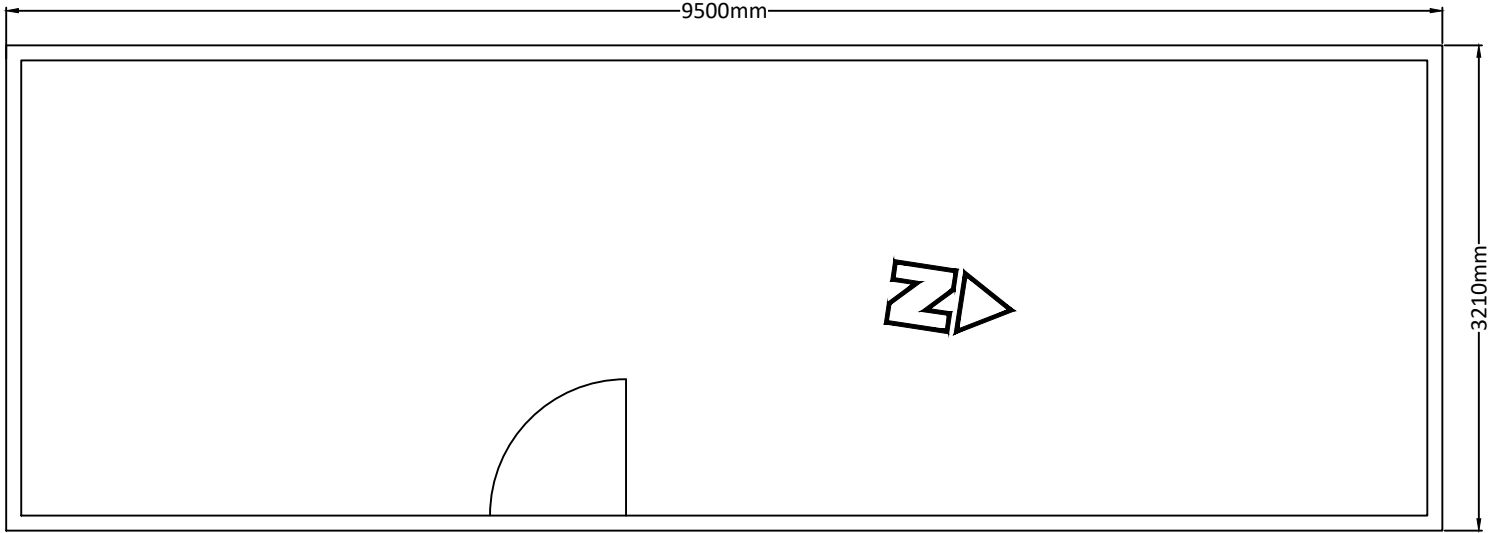


PLAN VIEW

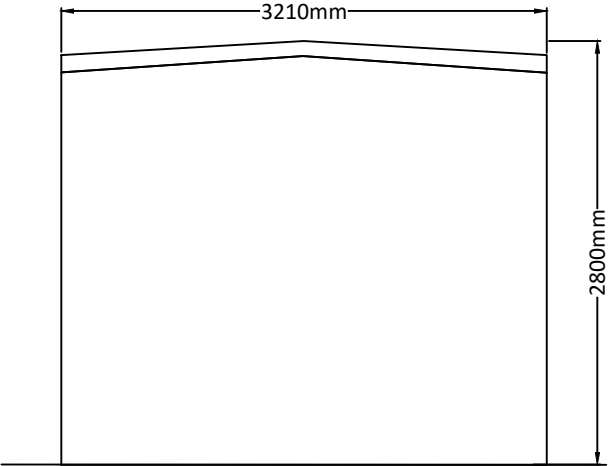

SIDE ELEVATION

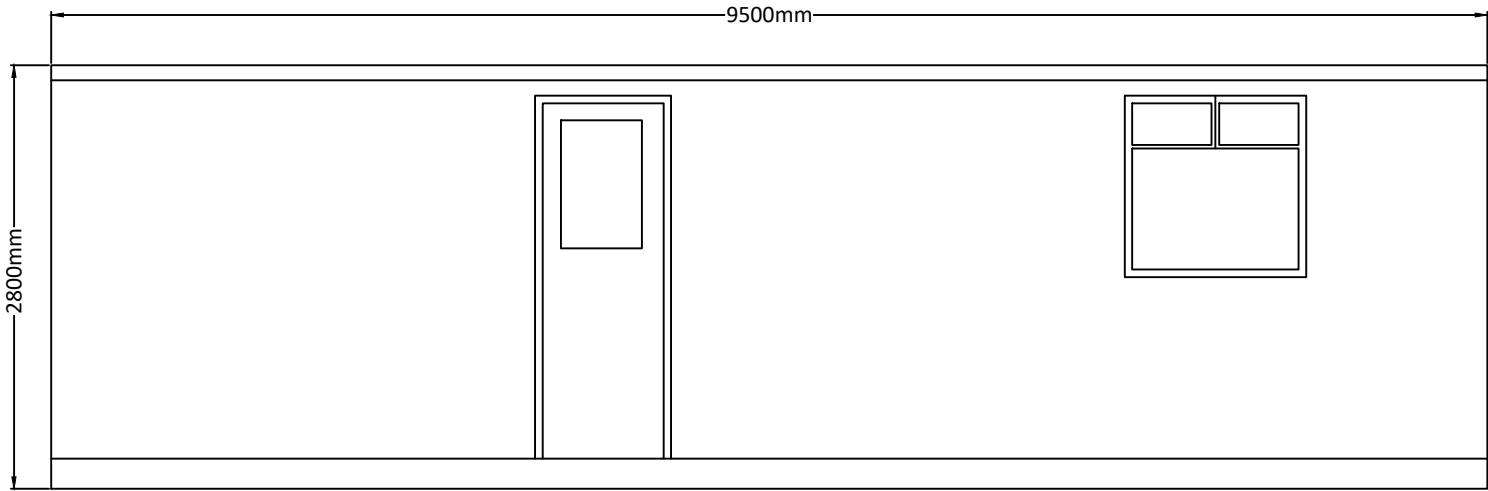

FRONT ELEVATION

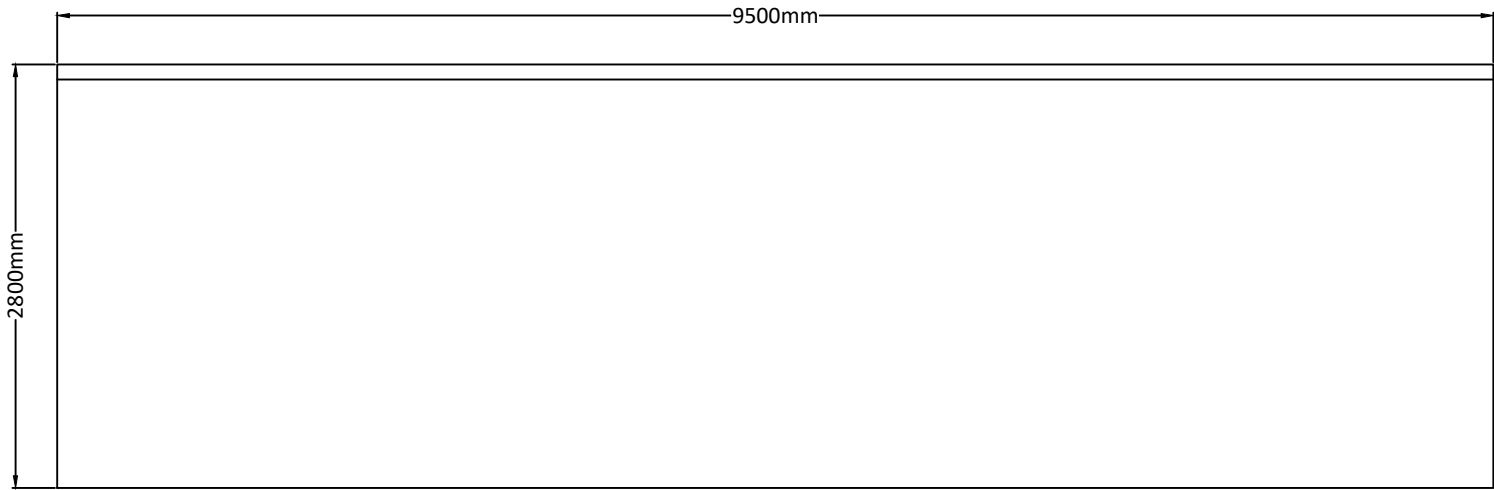

REAR ELEVATION

NOTES

A	23/06/2026	M.B.	L.P.	FIRST ISSUE	ENGINEER	AFRY AFRY Ireland Ltd. The Hyde Building, The Park, Carrickmines, D18VC44 Ireland Tel. +353 (0) 1 845 5031	CLIENT		PROJECT		MEENBOG WIND FARM			
					DRAWN BY		DATE	PAPER SIZE	SCALE	TITLE		REVISION		
					M. BROWNE		23/06/2026	A3	1:50	SECURITY CABIN ELEVATIONS & PLAN			A	
					CHECKED AND APPROVED		DATE	STATUS						DRAWING NUMBER
REV	DATE	DRAWN BY	CHECKED BY	DETAILS	L. POWER	23/06/2026	EXISTING		MNBG d039.1.3					

Printed: 26/06/2026 15:19:12
\\NAS-EU\Draws\Projects\Wind\Meenbog\MB03\Drawings\MNBG 0039 1 Site Office & Staff Facilities