


ALL DIMENSIONS IN mm
UNLESS OTHERWISE NOTED

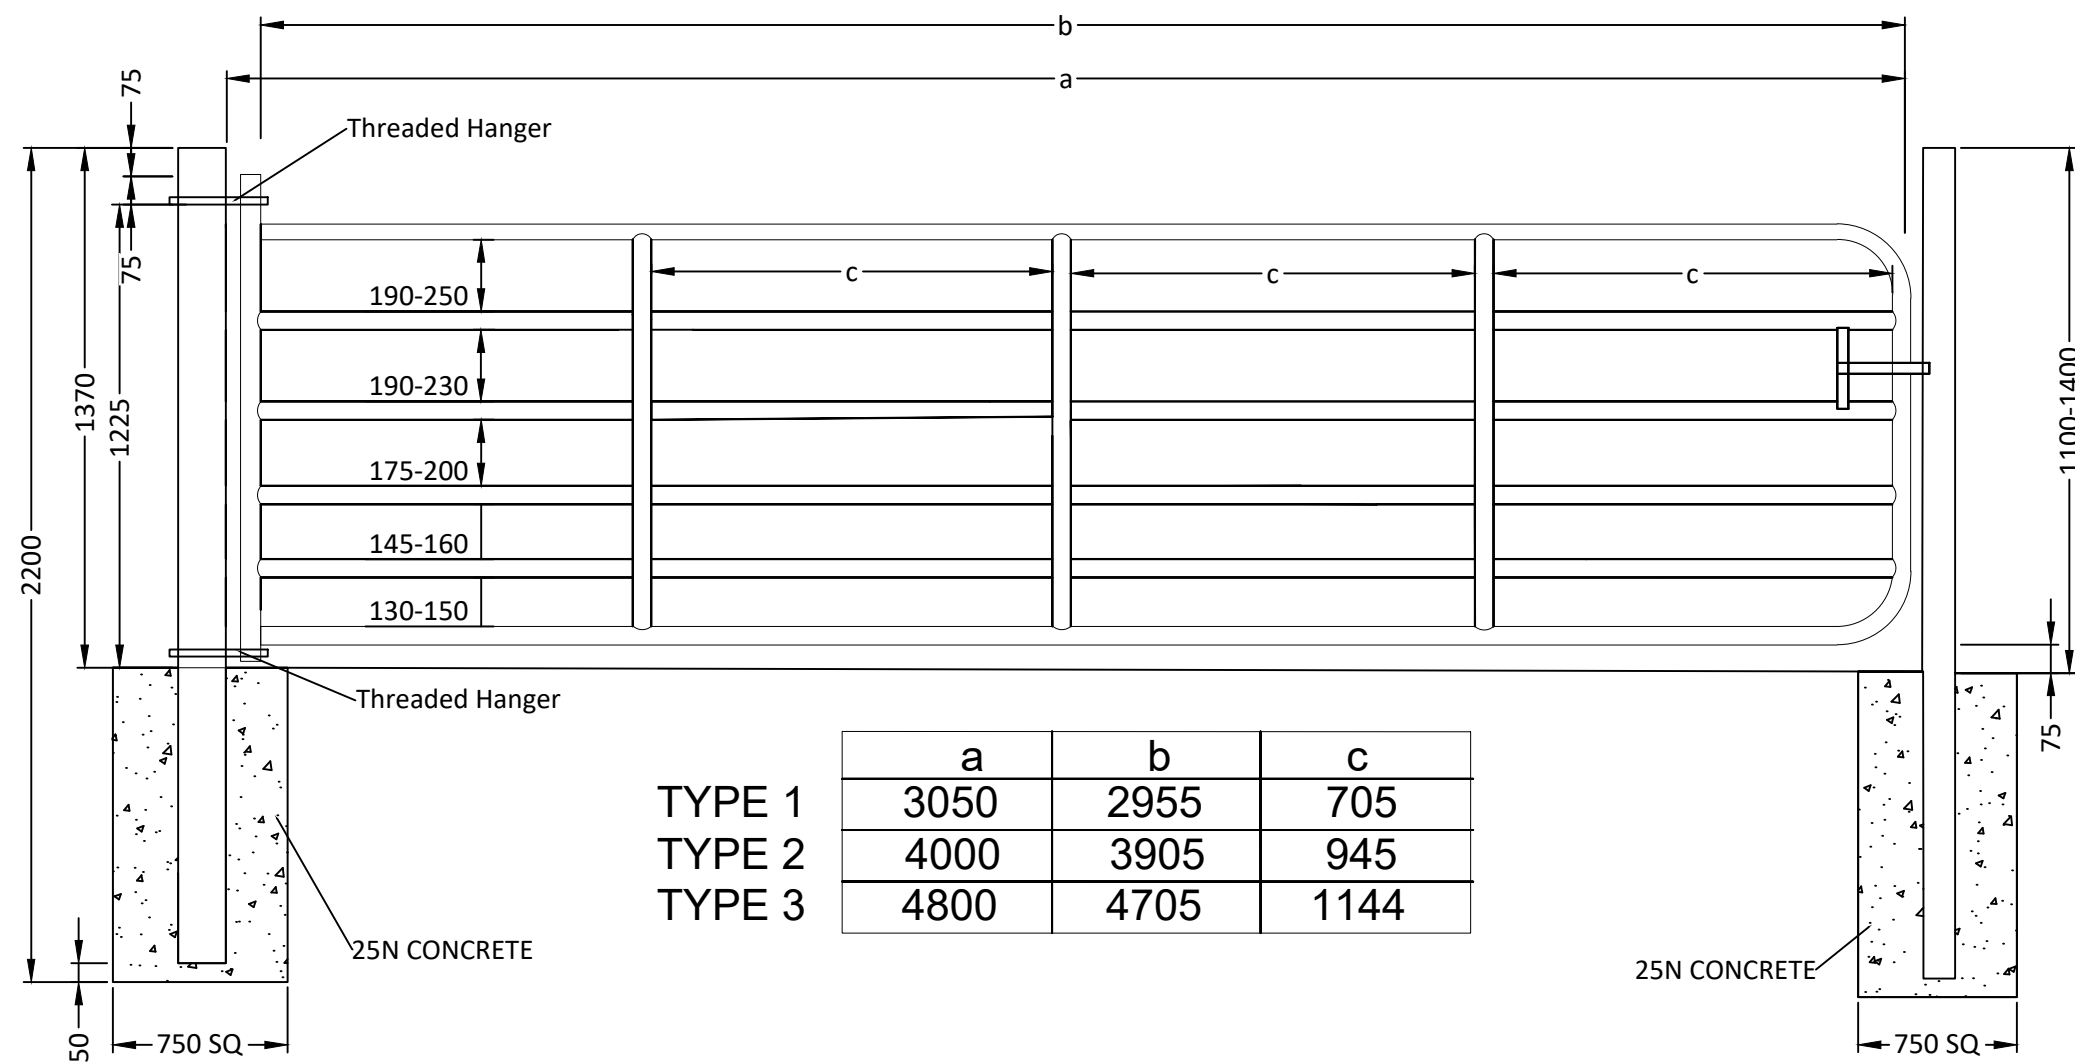

	a	b	c
TYPE 1	3050	2955	705
TYPE 2	4000	3905	945
TYPE 3	4800	4705	1144

NOTES						ENGINEER AFRY AFRY Ireland Ltd. The Hyde Building, The Park, Carrickmines, D18VC44 Ireland Tel. +353 (0) 1 845 5031			CLIENT		PROJECT MEENBOG WIND FARM				
											TITLE FIELD GATE DETAILS		REVISION A		
	A	23/03/2026	M.B.	L.P.	FIRST ISSUE	DRAWN BY M. BROWNE			DATE 23/03/2026		PAPER SIZE A3	SCALE 1:20			
	REV	DATE	DRAWN BY	CHECKED BY	DETAILS	CHECKED AND APPROVED L. POWER			DATE 23/03/2026		STATUS EXISTING		DRAWING NUMBER MNBG d041.1.1		

X:\3-BU\BUE\Draws\Project\Ireland\Meeting\MNBG\Drawings\MNBG D041 Field Gate Details\MNBG D041.1 Field Gate Details

Printed: 25/05/2026 13:52:26