




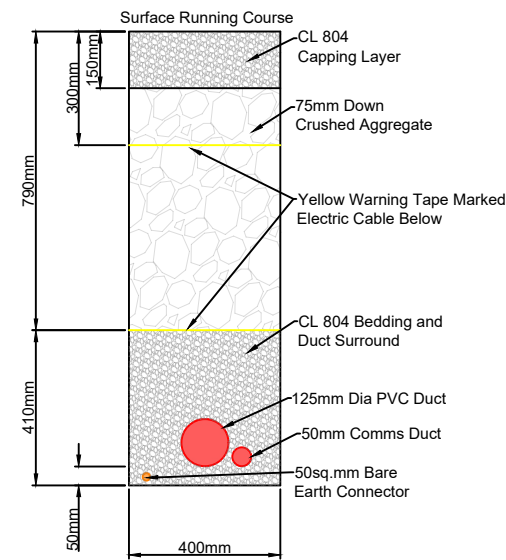


Cable Trench Cross-Section - Detail 1
Refer to Drawings d024.6.5 to d024.6.10 for Locations
Scale: 1:20

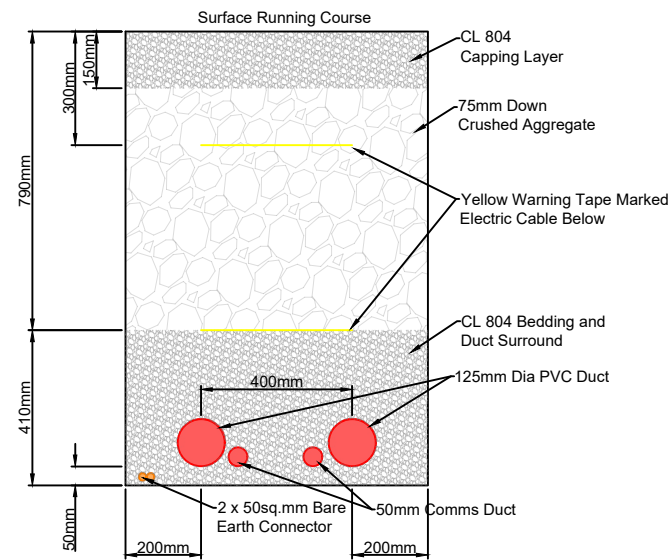


Cable Trench Cross-Section - Detail 2
Refer to Drawings d024.6.5 to d024.6.10 for Locations
Scale: 1:20

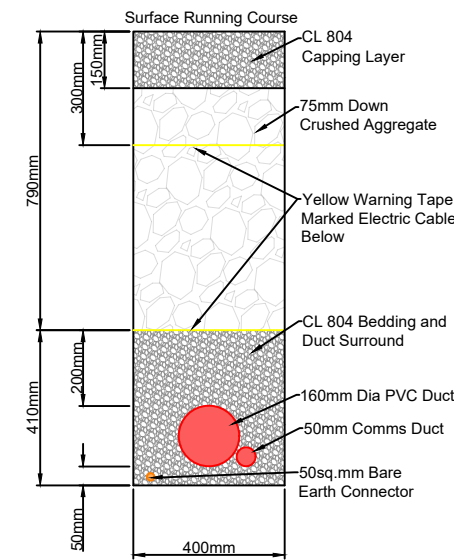


Cable Trench Cross-Section - Detail 3
Refer to Drawings d024.6.5 to d024.6.10 for Locations
Scale: 1:20

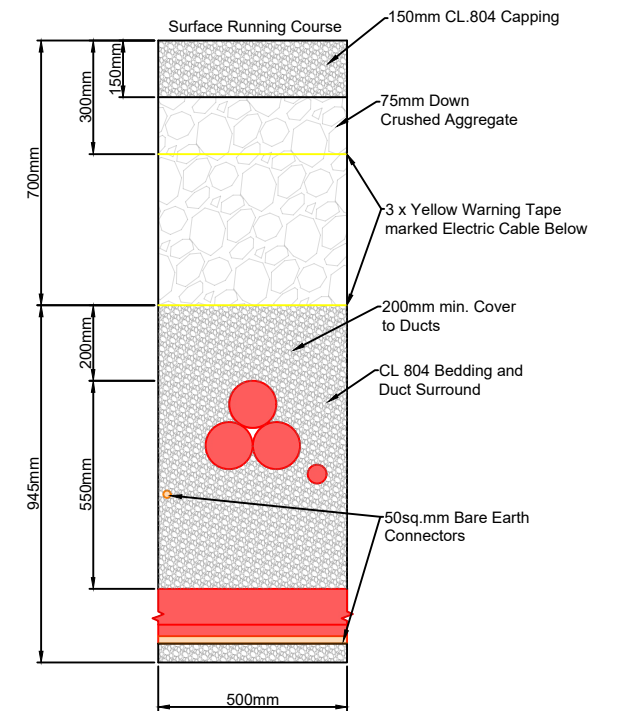


Cable Trench Cross-Section - Detail 4
Refer to Drawings d024.6.5 to d024.6.10 for Locations
Scale: 1:20

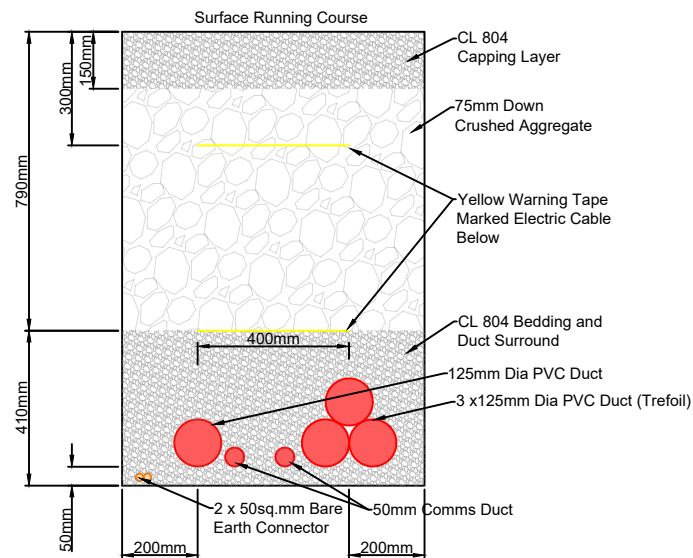

Cable Trench Cross-Section - Detail 5
Refer to Drawings d024.6.5 to d024.6.10 for Locations
Scale: 1:20

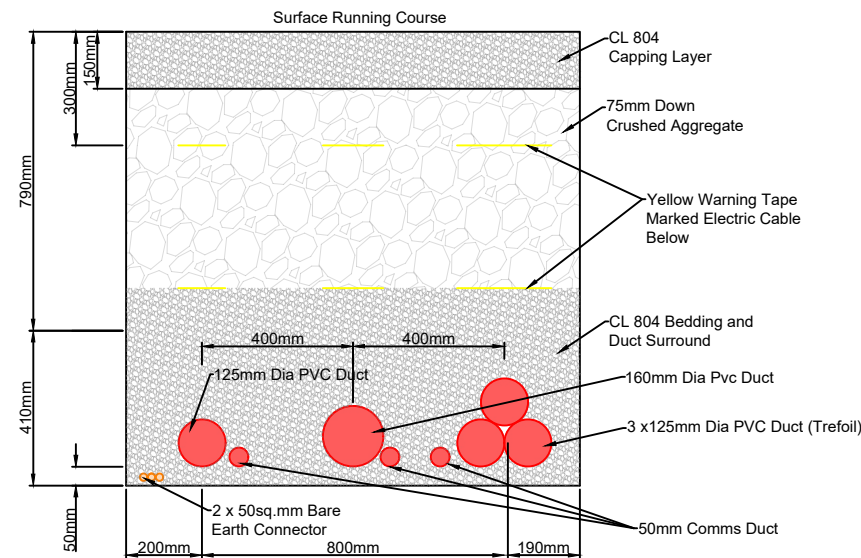

Cable Trench Cross-Section - Detail 6
Refer to Drawings d024.6.5 to d024.6.10 for Locations
Scale: 1:20

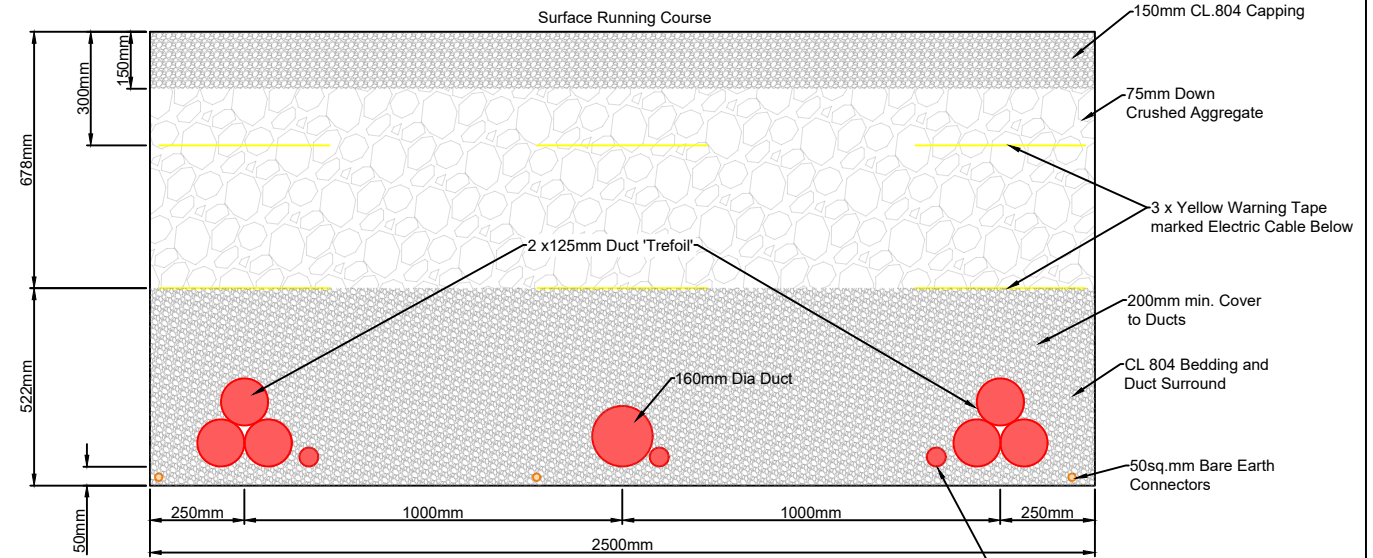

Cable Trench Cross-Section - Detail 7
Refer to Drawings d024.6.5 to d024.6.10 for Locations
Scale: 1:20

NOTES						ENGINEER		CLIENT		PROJECT	
								AFRY Ireland Ltd. The Hyde Building, The Park, Carrickmines, D18VC44 Ireland Tel. +353 (0) 1 845 5031		MEENBOG WIND FARM	
						DRAWN BY M. BROWNE		DATE 09/04/2026		PAPER SIZE A3	
						CHECKED AND APPROVED L. POWER		DATE 09/04/2026		SCALE 1:20	
								STATUS EXISTING		DRAWING NUMBER MNBG d043.1.1	
										REVISION A	
						REV A		DATE 09/04/2026		DRAWN BY M.B.	
										CHECKED BY L.P.	
										DETAILS FIRST ISSUE	