
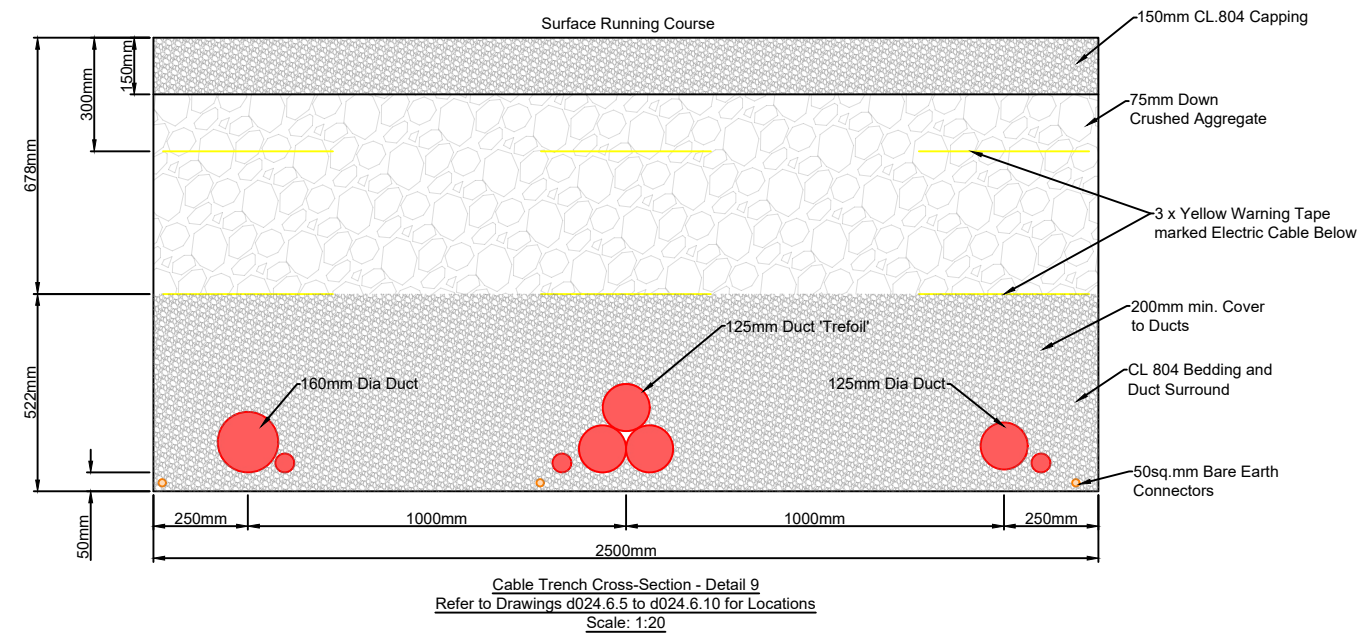


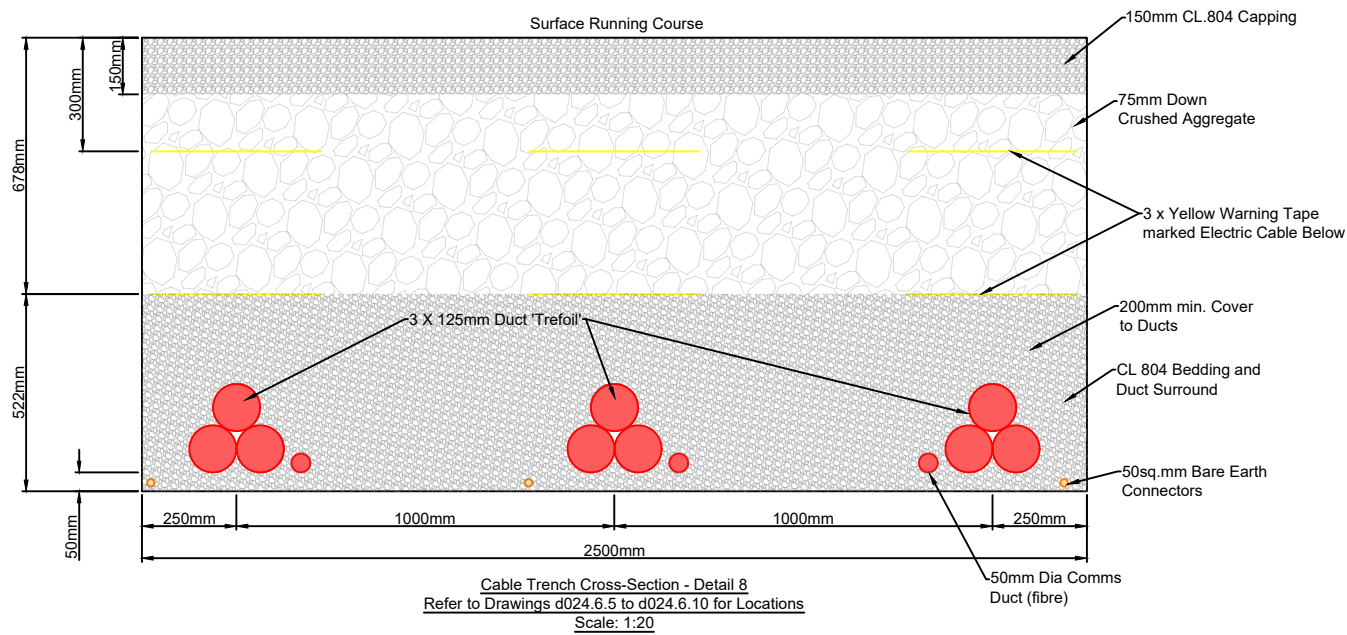

NOTES						ENGINEER AFRY AFRY Ireland Ltd. The Hyde Building, The Park, Carrickmines, D18VC44 Ireland Tel. +353 (0) 1 845 5031		CLIENT		PROJECT MEENBOG WIND FARM			
						DRAWN BY M. BROWNE		DATE 09/04/2026	PAPER SIZE A3	SCALE 1:20	TITLE INTERNAL WIND FARM CABLE TRENCH EXISTING CROSS SECTIONS - SHEET 2		REVISION A
						CHECKED AND APPROVED L. POWER		DATE 09/04/2026	STATUS EXISTING		DRAWING NUMBER MNBG d043.1.2		
	REV	DATE	DRAWN BY	CHECKED BY	DETAILS								

Printed : 20/02/2026 10:26:38

Internal Wind Farm Cable Trench Details