



TITLE: 20190107-017_A3

ESB NETWORKS

- COLOUR CODE:
- BLACK - 38KV & HIGHER VOLTAGE OVERHEAD LINES
 - GREEN - MV(10KV/20KV) OVERHEAD LINES
 - BLUE - LV (400V/230V) OVERHEAD LINES
 - CYAN - 38KV & HIGHER VOLTAGE UNDERGROUND CABLE ROUTES
 - RED - MV/LV (10KV/20KV/400V/230V) UNDERGROUND CABLE ROUTES

DATE: 07-Jan-2019

** SCALE: 1:3200

** SCALE WHEN PRINTED ON AN A3 PAGE
XY COORDINATES DISPLAYED IN IRISH GRID COORDINATE SYSTEM

Maps reproduced by permission: Ordnance Survey Ireland Licence No. EN0023715-19, Copyright Ordnance Survey Ireland Government of Ireland


X.Y: 309732, 275587

ESB NETWORKS HAS ISSUED THIS MAP AS A PDF DOCUMENT. IF VIEWING A PAPER VERSION OF THIS MAP, THE VIEWER MUST ENSURE THAT IT HAS BEEN PRINTED IN COLOUR TO FIT TO AN A3 (OR LARGER) PAGESIZE AND THAT EACH OF THE COLOURS INDICATED ON THE COLOUR CODE LEGEND ABOVE ARE CLEAR AND DISTINCT FROM EACH OTHER TO MAINTAIN A CORRECT REPRESENTATION OF THE ELECTRICAL NETWORK INFORMATION.

WARNING

THIS MAP INDICATES THE APPROXIMATE LOCATION OF ESB TRANSMISSION (400KV, 220KV, 110KV, 38KV) AND DISTRIBUTION (20KV, 10KV, 230V/400V) UNDERGROUND CABLES AND OVERHEAD LINES IN THE GENERAL AREA OF THE PROPOSED WORKS. ESB NETWORKS TAKES NO RESPONSIBILITY FOR THE ACCURACY OR COMPLETENESS OF THE MAP. IT IS THE USER'S RESPONSIBILITY TO INDEPENDENTLY VERIFY THE INFORMATION AND THE LOCATION OF UNDERGROUND CABLES AND OVERHEAD LINES. LOW VOLTAGE (230V/400V) SERVICE CABLES (E.G. HOUSE SERVICES, FACTORY/SHOP SERVICES, PUBLIC LIGHTING LAMP SERVICES, ETC) ARE NOT INCLUDED BUT THEIR PRESENCE SHOULD BE ANTICIPATED. THE DEPTHS OF UNDERGROUND CABLES MUST NEVER BE ASSUMED. ADDITIONAL MORE DETAILED INFORMATION IS AVAILABLE FOR HIGH VOLTAGE TRANSMISSION UNDERGROUND CABLES (38KV, 110KV, 220KV, 400KV) FROM THE LOCAL ESB NETWORKS TRANSMISSION REPRESENTATIVE - SEE ATTACHED LIST FOR CONTACT DETAILS OR CALL 1850 372 757. NO WORK SHOULD BE CARRIED OUT IN THE VICINITY OF 38KV OR HIGHER VOLTAGE UNDERGROUND CABLES WITHOUT PRIOR CONSULTATION WITH ESB NETWORKS. BEFORE ANY MECHANICAL EXCAVATION IS UNDERTAKEN, THE ACTUAL LOCATION OF ALL UNDERGROUND ELECTRICITY CABLES MUST BE ESTABLISHED AND VERIFIED ON THE SITE USING: (A) UP-TO-DATE MAP RECORDS; (B) CABLE LOCATOR EQUIPMENT OPERATED IN BOTH POWER AND RADIO MODES; (C) CAREFUL HAND DIGGING OF TRIAL HOLES USING SAFE DIGGING PRACTICE; REFER ALSO TO HSA CODE OF PRACTICE FOR AVOIDING DANGER FROM UNDERGROUND SERVICES; ESB TAKES NO RESPONSIBILITY FOR AND SHALL BEAR NO LIABILITY, HOWSOEVER ARISING, IN RELATION TO ANY DAMAGE, INJURY/DEATH OR LOSS OF SUPPLY AS A RESULT OF DAMAGE OR INTERFERENCE WITH ITS NETWORKS.

X.Y: 311038, 275587

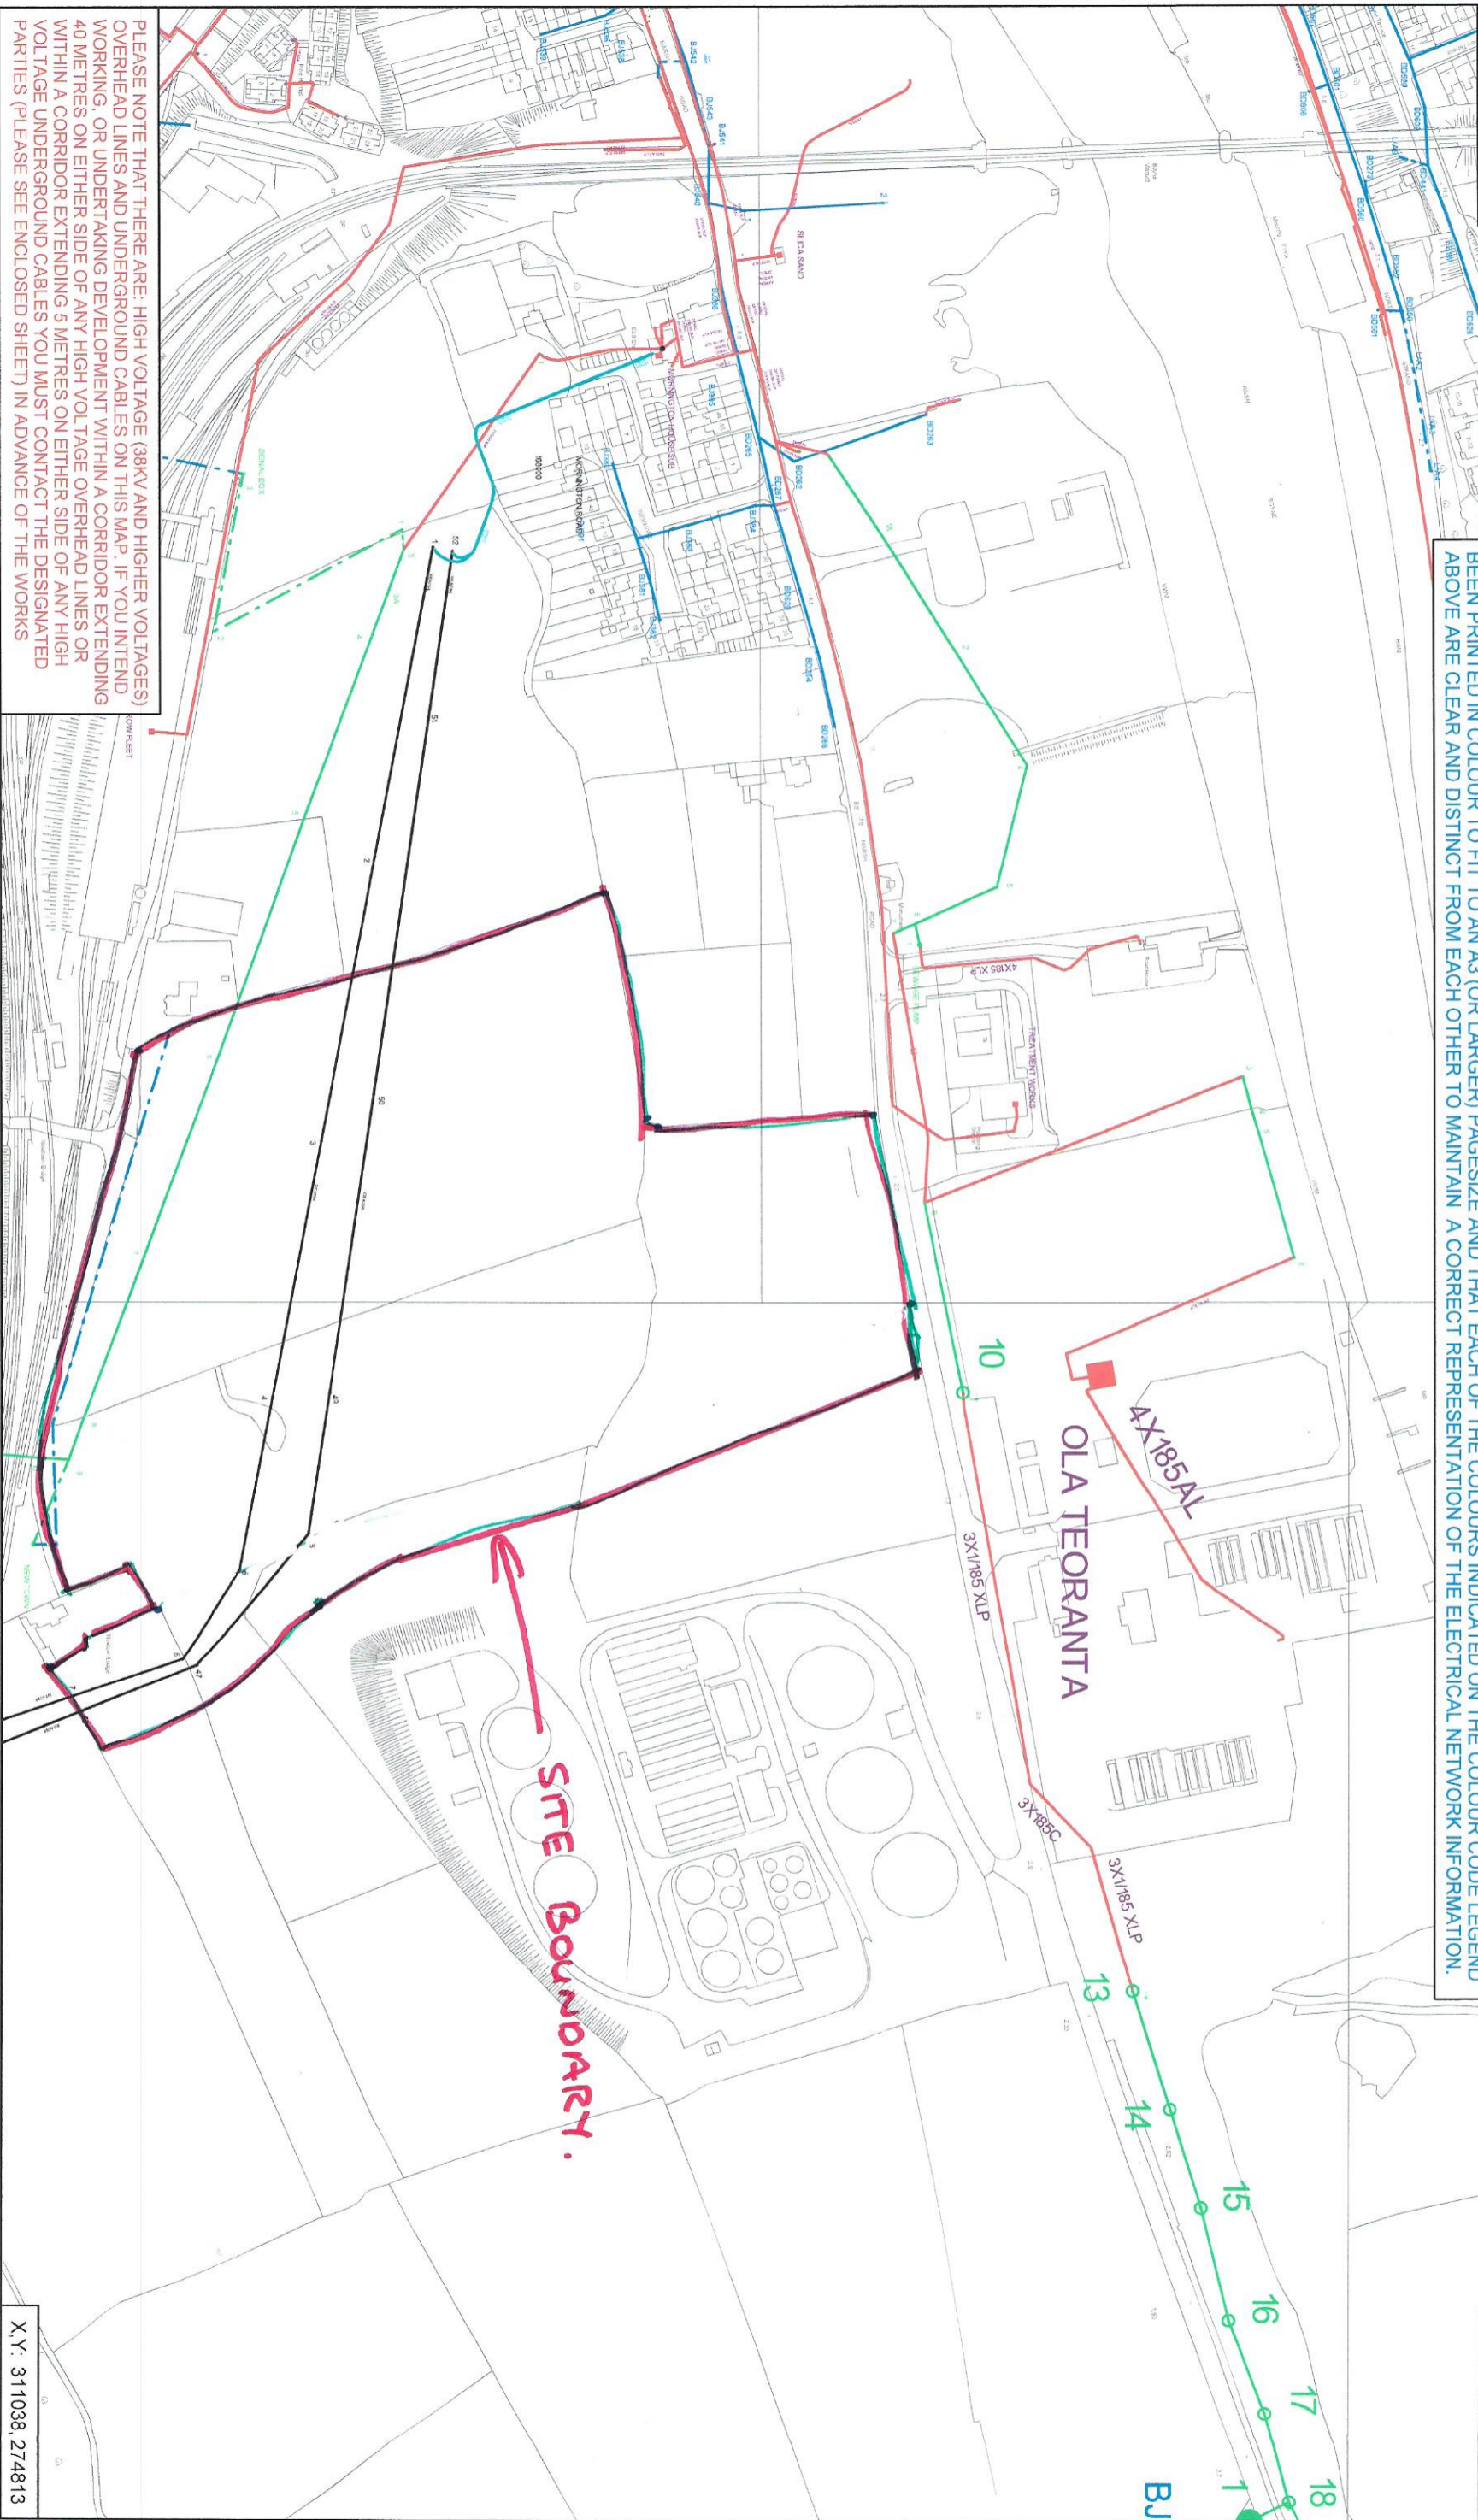

PLEASE NOTE THAT THERE ARE: HIGH VOLTAGE (38KV AND HIGHER VOLTAGES) OVERHEAD LINES AND UNDERGROUND CABLES ON THIS MAP. IF YOU INTEND WORKING, OR UNDERTAKING DEVELOPMENT WITHIN A CORRIDOR EXTENDING 40 METRES ON EITHER SIDE OF ANY HIGH VOLTAGE OVERHEAD LINES OR WITHIN A CORRIDOR EXTENDING 5 METRES ON EITHER SIDE OF ANY HIGH VOLTAGE UNDERGROUND CABLES YOU MUST CONTACT THE DESIGNATED PARTIES (PLEASE SEE ENCLOSED SHEET) IN ADVANCE OF THE WORKS

X.Y: 311038, 274813