



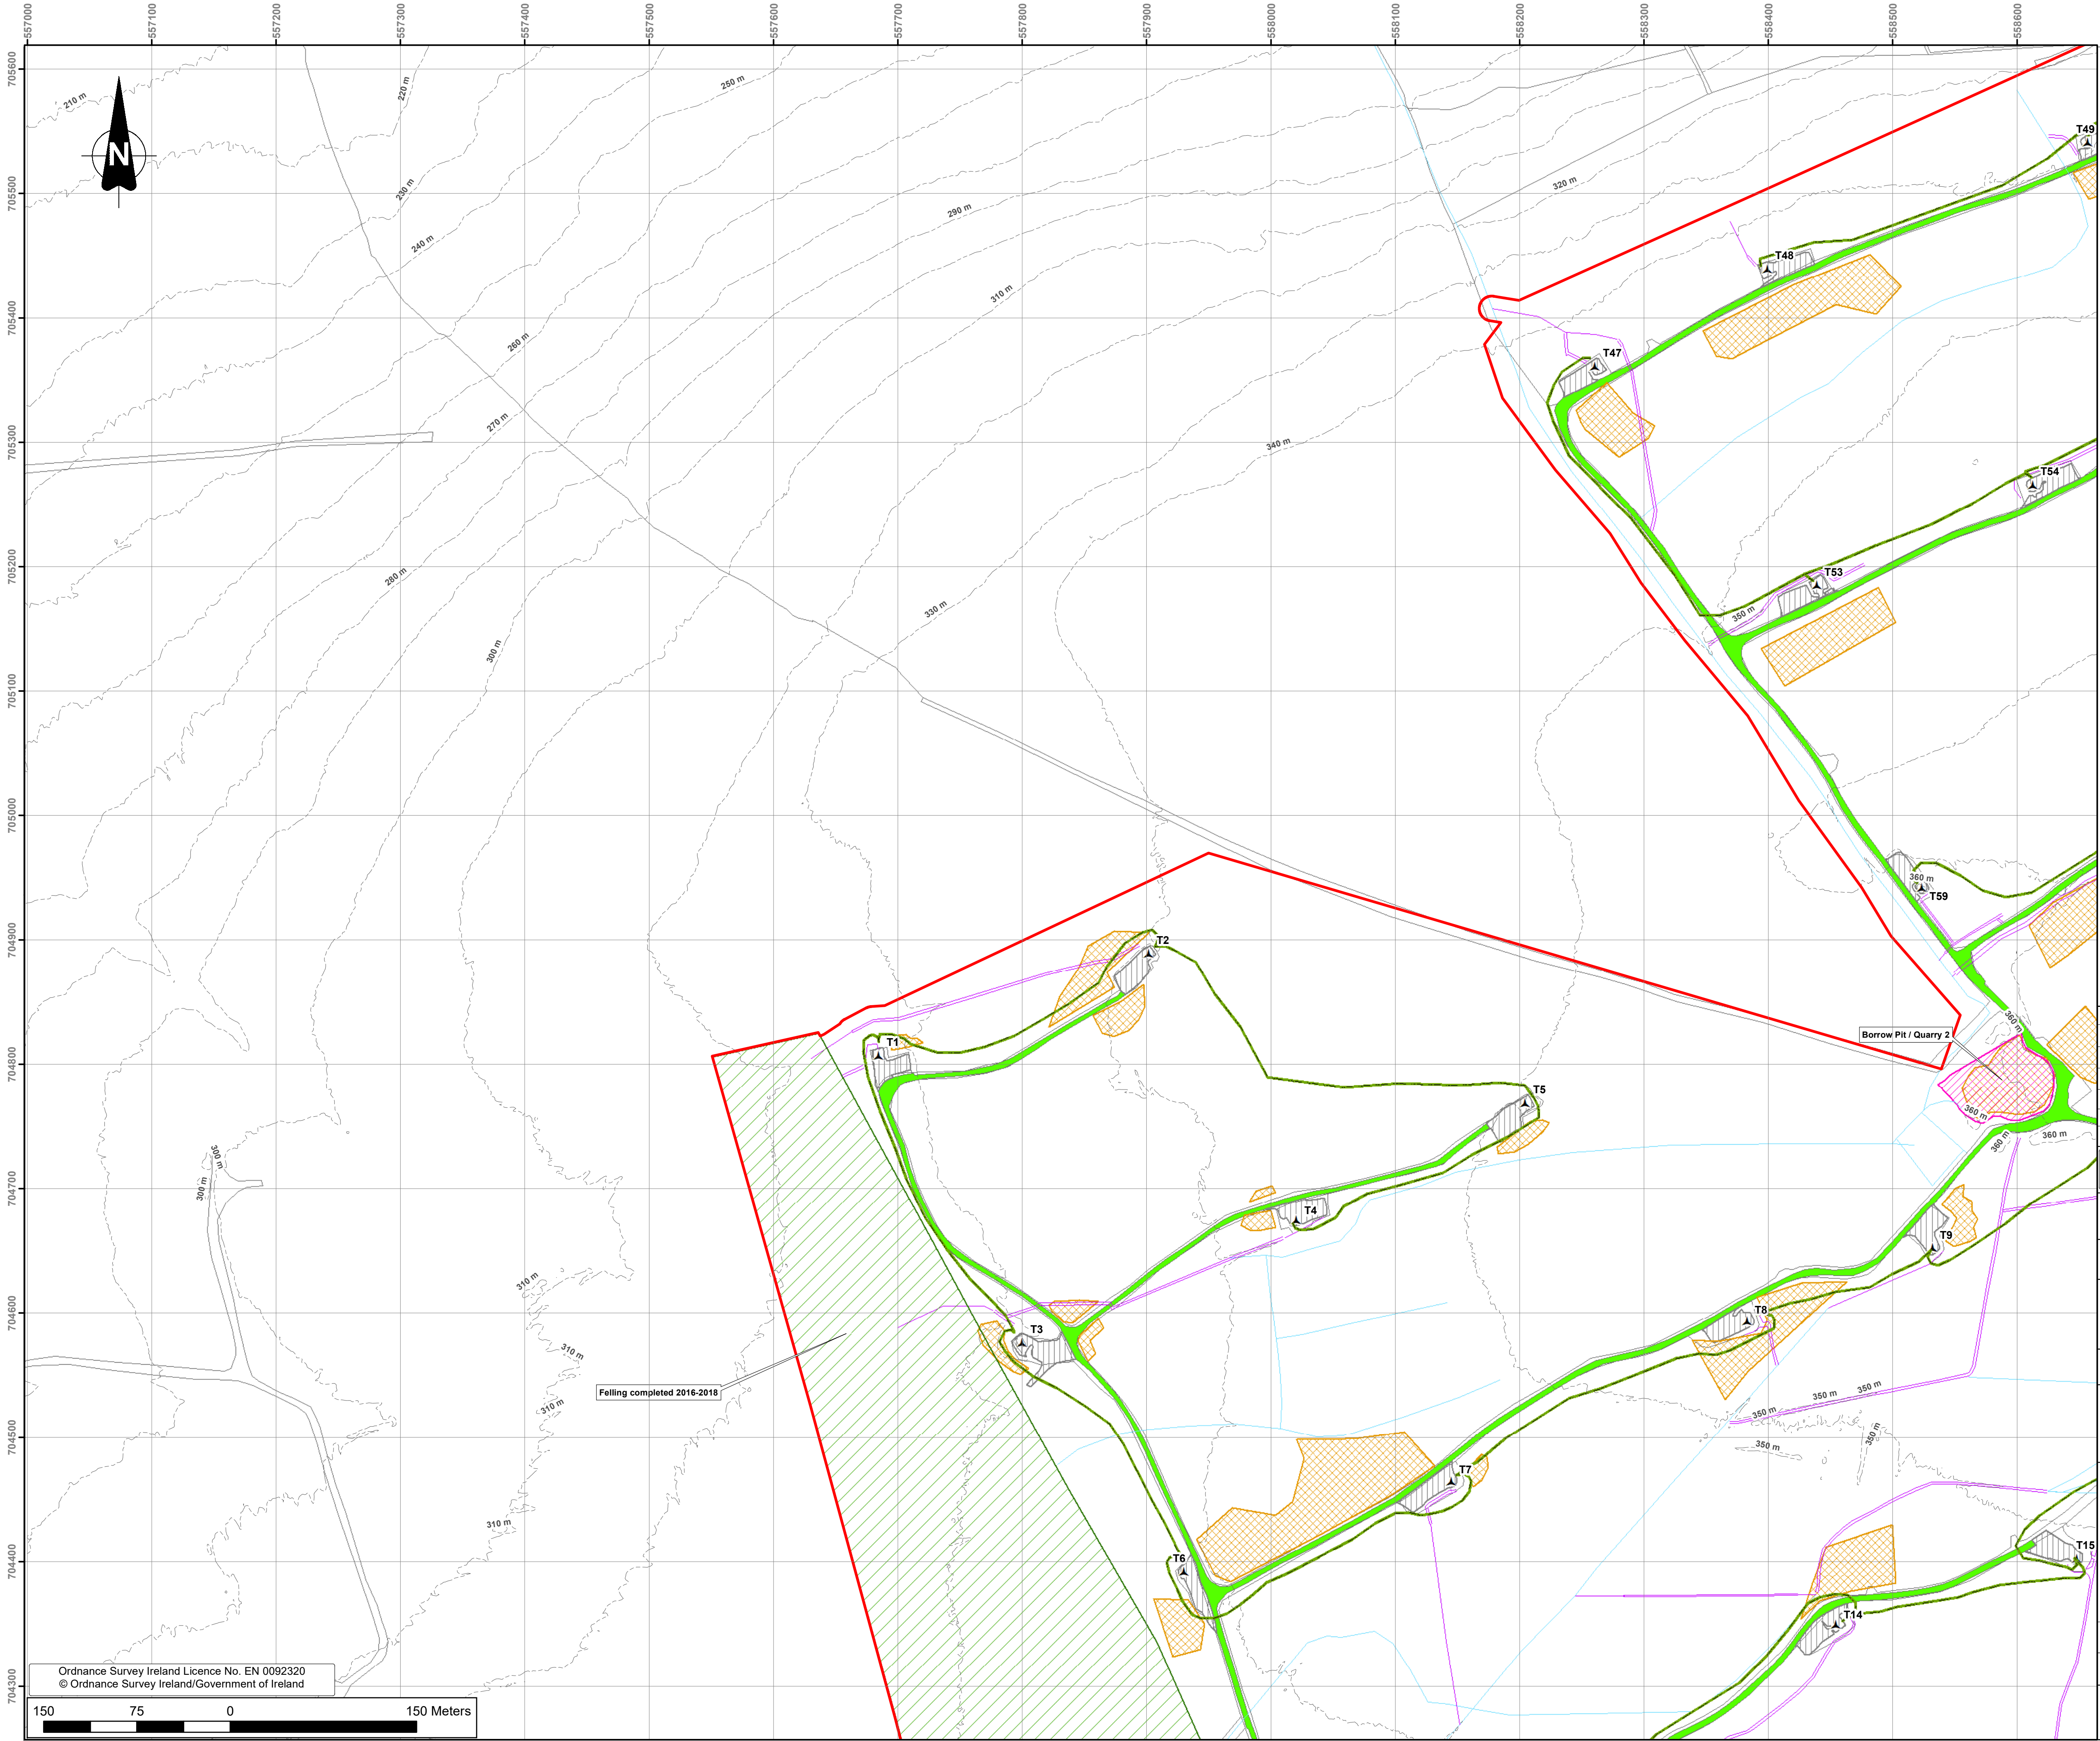

Legend

- Substitute Consent Application Boundary
- Turbines (Existing)
- Floating Road (Existing)
- Turbine Hardstands (Existing)
- Borrow Pits / Quarry (Existing)
- Peat Repository areas (Existing)
- LV cables (approximate location)
- Pre Existing Drainage
- Constructed Drainage (Existing)
- Felling completed 2016-2018
- Contours

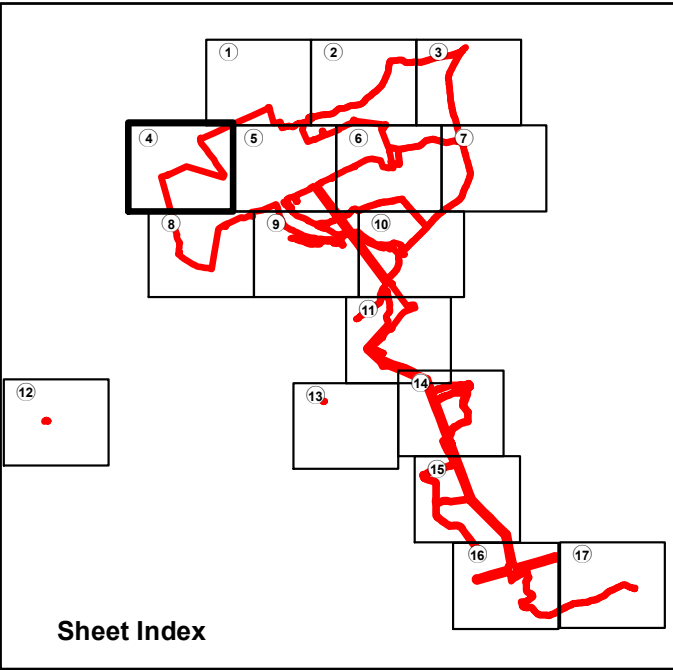

Notes:
- Drawing prepared using Irish Transverse Mercator (ITM) Map Grid
- Turbines
(See drawing QS-000280-01-D460-020-001-000, QS-000280-01-D460-020-002-000 for details)
- Floating & non floating roads
(See drawing QS-000280-01-D460-020-004-000 for details)

Maps shown on drawing:
Galway 5000 sheets 3746,3747,3748,3749, 3804,3805,3806,3807, 3862,3863,3864,3865,3919,3920,3921 & 3922

0	27.07.20	Issued for substitute consent	E.O'S	E.O'S	J.McL	H.O'K
REV	DATE	REVISION DESCRIPTION	DRN	PROD	VER	APP

COPYRIGHT © ESB
ALL RIGHTS RESERVED. NO PART OF THIS WORK MAY BE MODIFIED, REPRODUCED OR COPIED IN ANY FORM OR BY ANY MEANS - GRAPHIC, ELECTRONIC OR MECHANICAL, INCLUDING PHOTOCOPYING, RECORDING, TAPING OR USED FOR ANY PURPOSE OTHER THAN ITS DESIGNATED PURPOSE, WITHOUT THE WRITTEN PERMISSION OF ESB.

PURPOSE OF ISSUE - PRELIMINARY UNLESS INDICATED

CLIENT APPROVAL ☐ PLANNING ☒ TENDER ☐ CONSTRUCTION ☐ AS-BUILT ☐

CLIENT
Gort Wind farms Ltd

PROJECT
Derrybrien Wind Farm Project

CONTRACT

DRAWING TITLE
Existing - Site Layout Sheet 4 of 17

PRODUCTION UNIT
CIVIL & ENVIRONMENTAL ENGINEERING



Energy for generations

Engineering and Major Projects,
One Dublin Airport Central, Dublin Airport,
Cloghran, Co. Dublin, K67 XF72, Ireland.
Tel: +353 (0)1 703 9000 Web: www.esb.ie
Engineering and Major Projects is a division of ESB

DRAWN E.O'Shea	PRODUCED E.O'Shea	VERIFIED J.McLoughlin	APPROVED H.O'Keeffe	APPROVAL DATE 30/07/2020
CLIENT REF.		NO. OF SHEETS 4/17	SIZE A1	SCALE 1:2,500

DRAWING NUMBER
QS-000280-1-D460-019-004-000

Ordnance Survey Ireland Licence No. EN 0092320
© Ordnance Survey Ireland/Government of Ireland

