
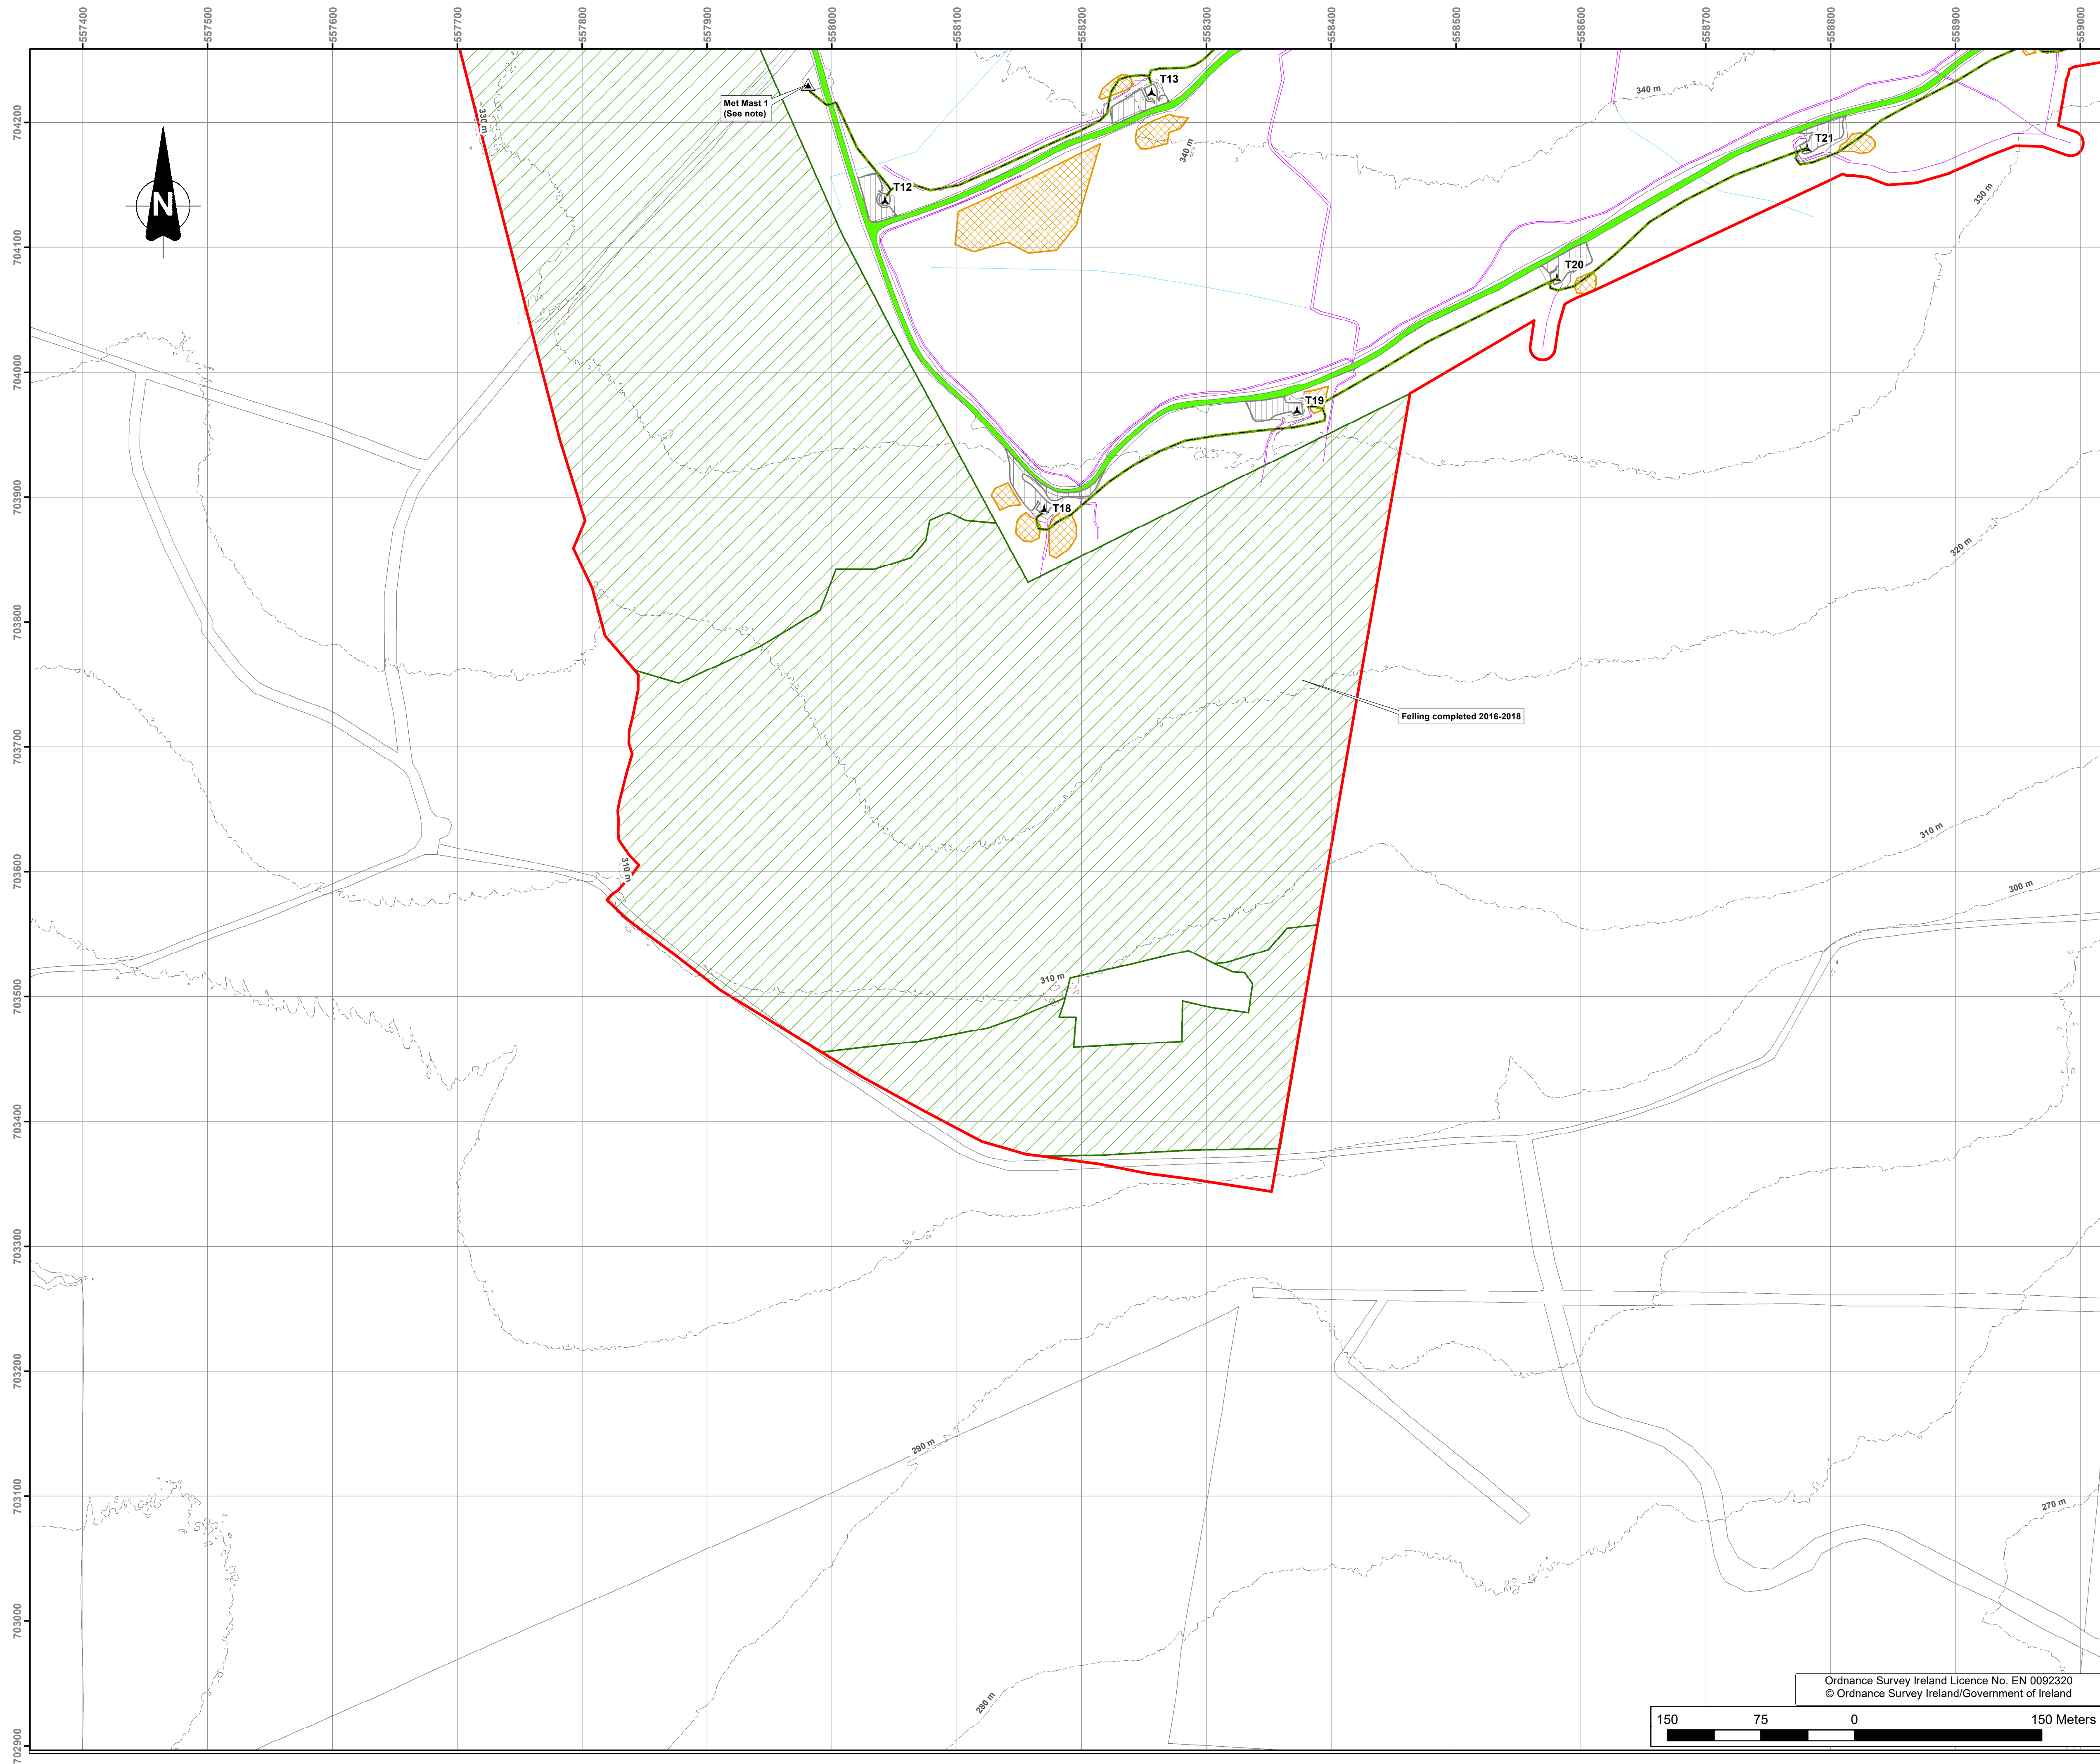


- ### Legend
-  Substitute Consent Application Boundary
 -  Met Mast (Existing)
 -  Turbines (Existing)
 -  Floating Road (Existing)
 -  Turbine Hardstands (Existing)
 -  Felling completed 2016-2018
 -  Peat Repository areas (Existing)
 -  LV cables (approximate location)
 -  Pre Existing Drainage
 -  Constructed Drainage (Existing)
 -  Contours

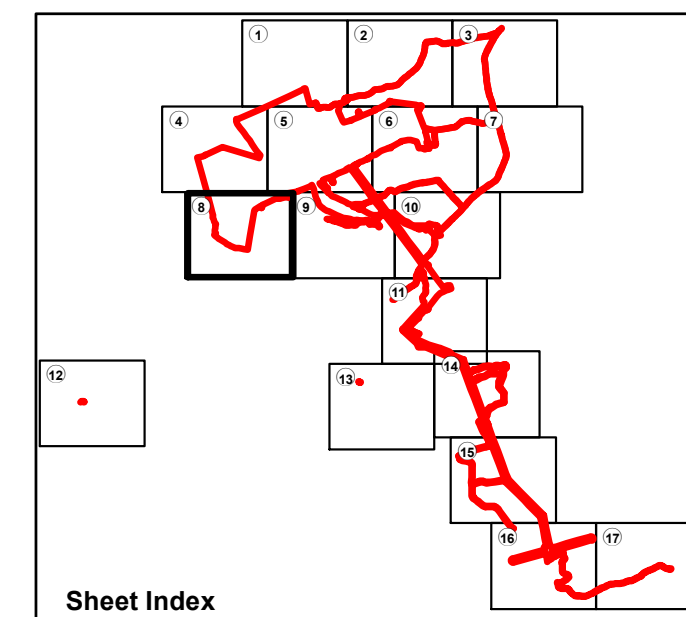

Notes:

- Drawing prepared using Irish Transverse Mercator (ITM) Map Grid
- Turbines

(See drawing QS-000280-01-D460-020-001-000 & QS-000280-01-D460-020-002-000 for details)

- Floating & non floating roads

(See drawing QS-000280-01-D460-020-004-000 for details)

- Met Mast Details

(See drawing QS-000280-01-D460-020-003-000 for details)

Maps shown on drawing:
Galway 5000 sheets 3746,3747,3748,3749, 3804,3805,3806,3807,
3862,3863,3864,3865,3919,3920,3921 & 3922

COPYRIGHT © ESB

ALL RIGHTS RESERVED. NO PART OF THIS WORK MAY BE MODIFIED, REPRODUCED OR COPIED IN ANY FORM OR BY ANY MEANS - GRAPHIC, ELECTRONIC OR MECHANICAL, INCLUDING PHOTOCOPIING, RECORDING, TAPING OR USED FOR ANY PURPOSE OTHER THAN ITS DESIGNATED PURPOSE, WITHOUT THE WRITTEN PERMISSION OF ESB.

PURPOSE OF ISSUE - PRELIMINARY UNLESS INDICATED

CLIENT APPROVAL ☐ PLANNING ☒ TENDER ☐ CONSTRUCTION ☐ AS-BUILT ☐

CLIENT	Gort Wind Farms Ltd
--------	---------------------

PROJECT	Derrybrien Wind Farm Project
---------	------------------------------

CONTRACT

DRAWING TITLE

Existing -
Site Layout
Sheet 8 of 17

PRODUCTION UNIT
CIVIL & ENVIRONMENTAL ENGINEERING



DRAWN	PRODUCED	VERIFIED	APPROVED	APPROVAL DATE
E.O'Shea	E.O'Shea	J.McLoughlin	H.O'Keeffe	27/07/2020
CLIENT REF.			NO. OF SHEETS	SIZE
				SCALE

	8/17	A1	1:2,500
--	------	----	---------

DRAWING NUMBER	SHEET	REV
QS-000280-01-D460-019-008-000		

Ordnance Survey Ireland Licence No. EN 0092320
© Ordnance Survey Ireland/Government of Ireland

