

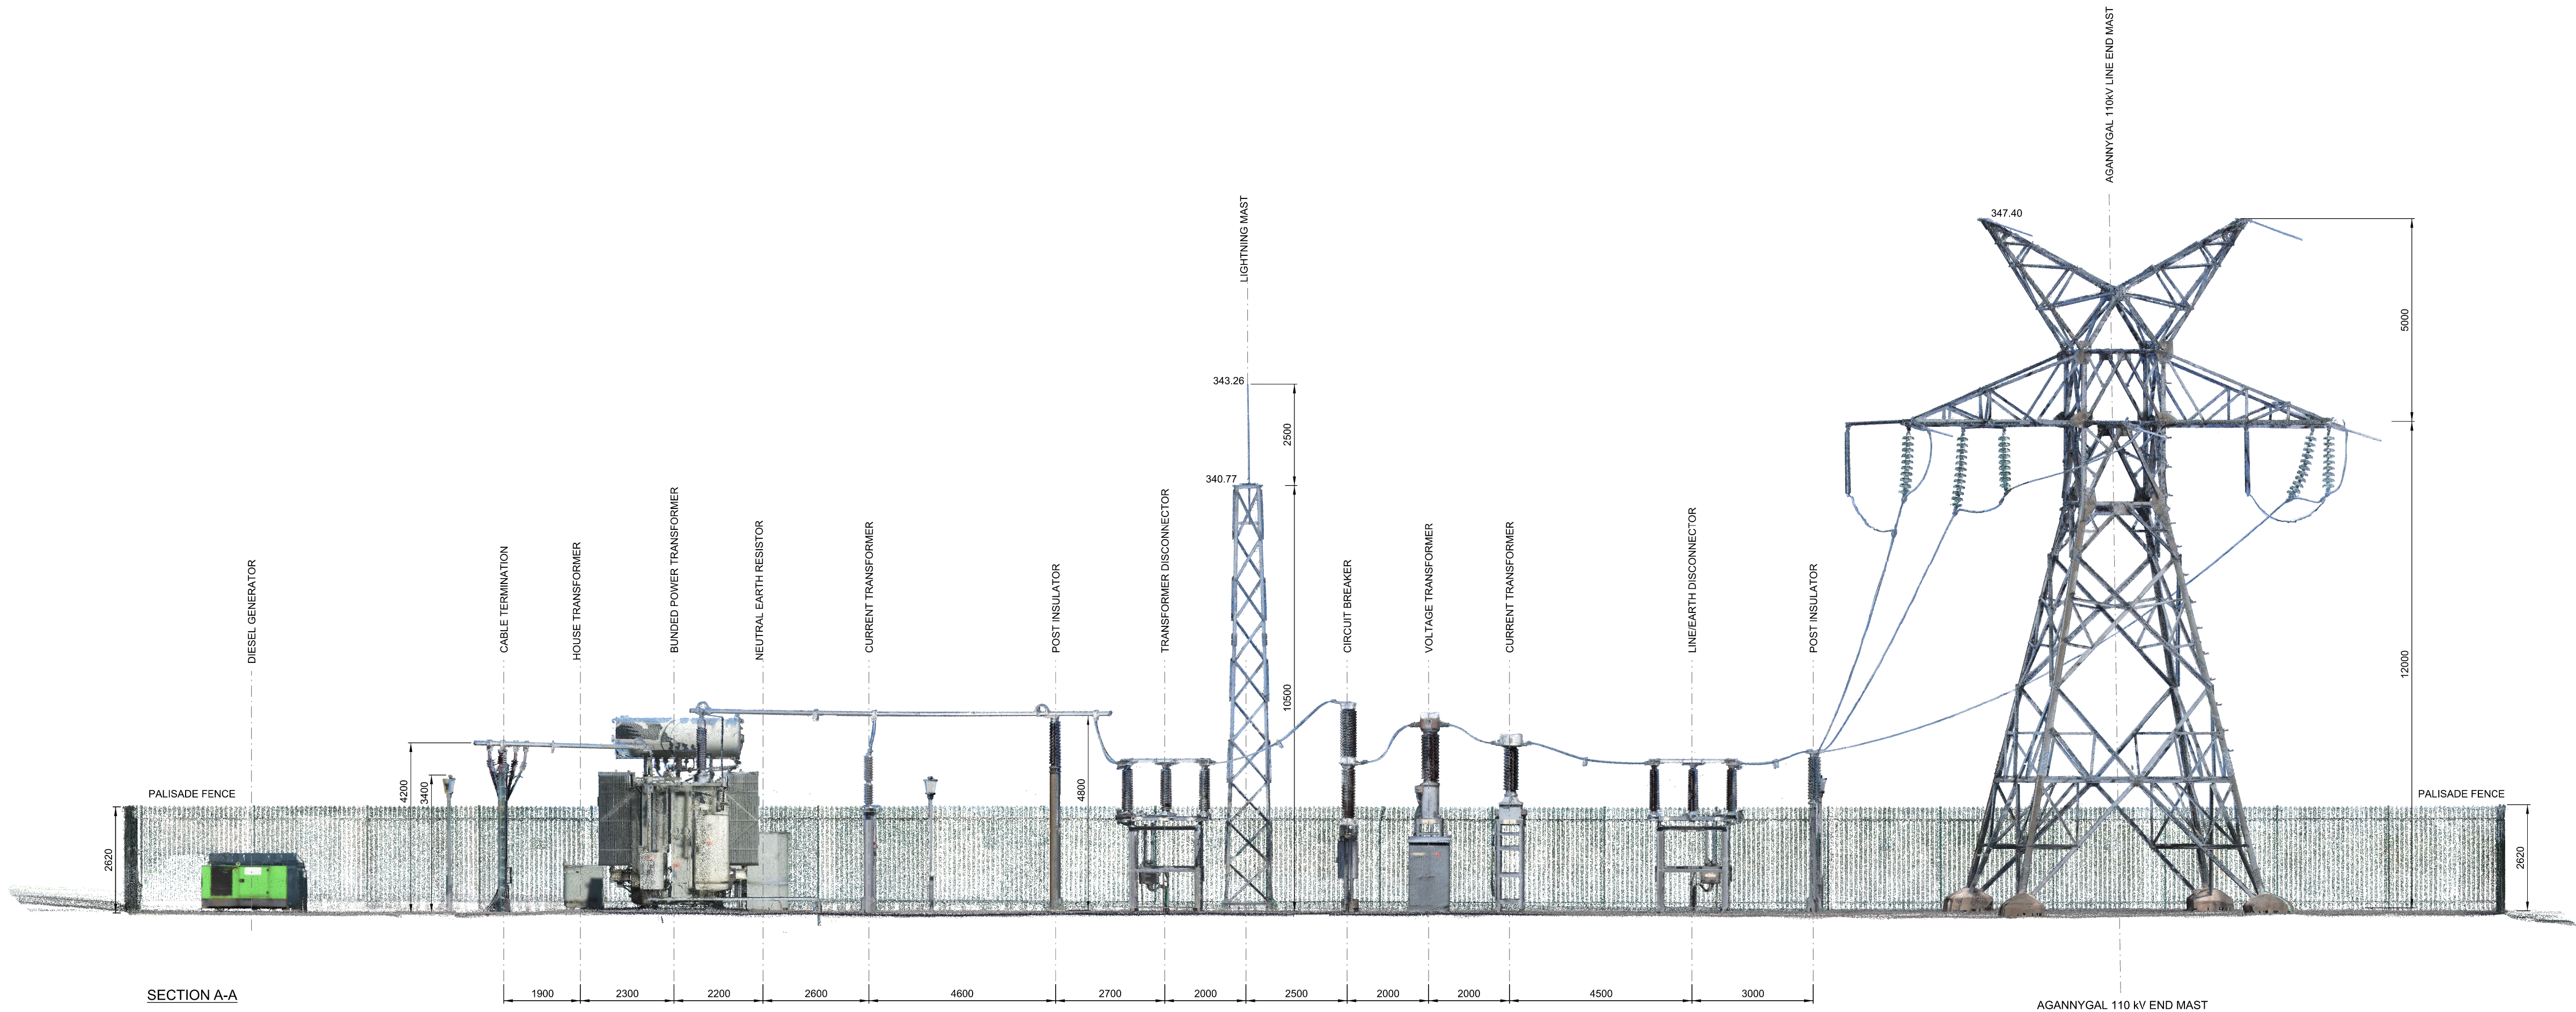


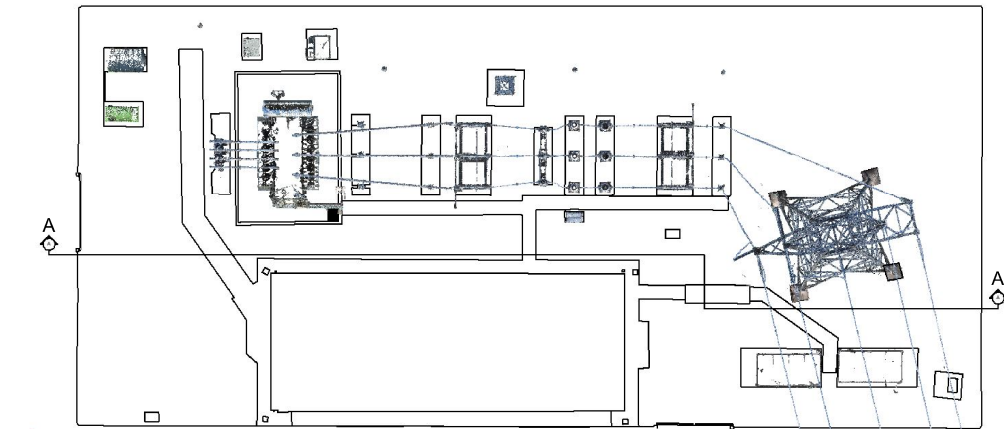

- LEGEND**
- 330.27 SPOT LEVELS/ELEVATIONS
 - LS LAMP STANDARDS
 - MARSH MARSHALLING BOX
 - CAP CAPACITOR BANKS

KEY
SUBSTITUTE CONSENT APPLICATION BOUNDARY

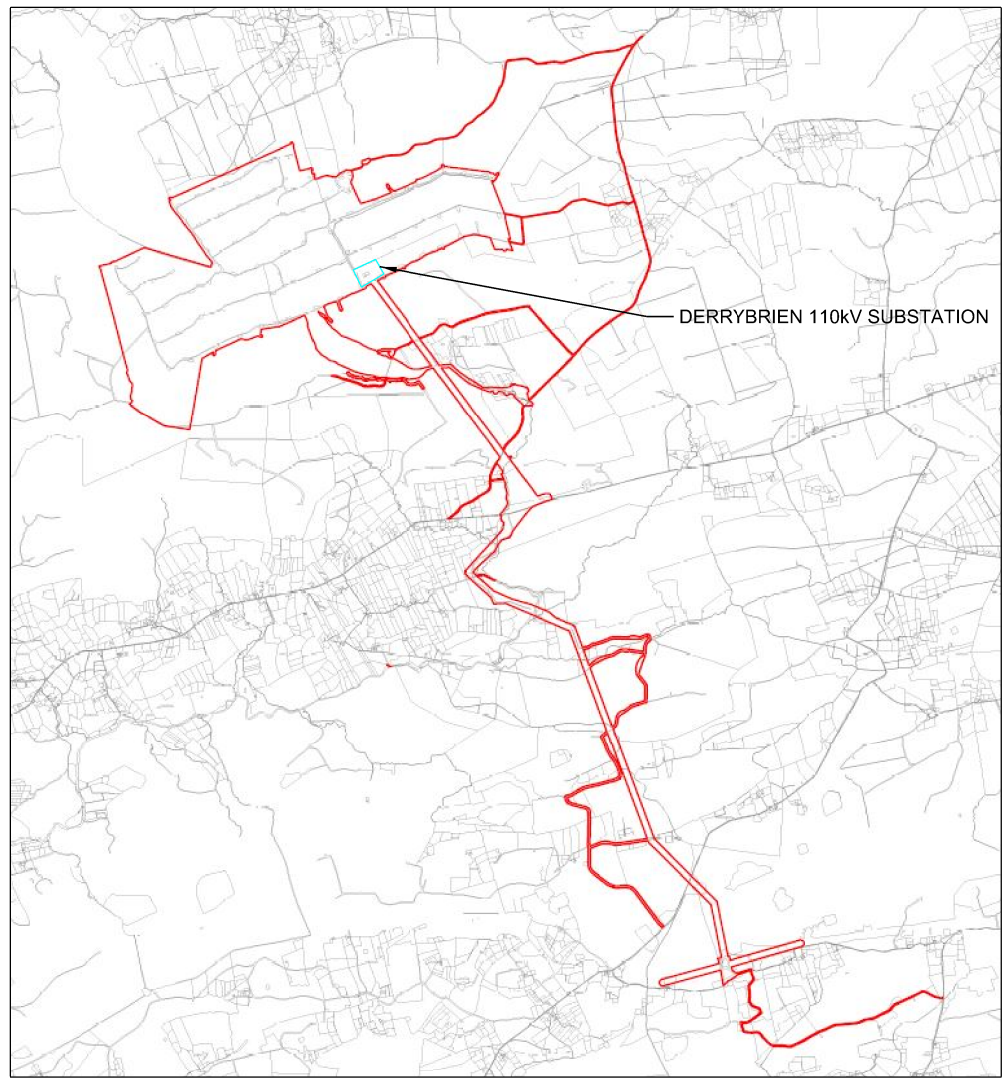

NOTE
ALL DIMENSIONS ARE IN MILLIMETRES
DO NOT SCALE FROM DRAWING
LEVELS ARE IN ITM COORDINATES TO OSI MALIN HEAD DATUM
DRAWING CREATED FROM SURVEY DATA CAPTURED BY
TERRESTRIAL LIDAR (LASER SCANNING) MAY 2019

REV.	DATE	REVISION DESCRIPTION	DRN	PROD	VER.1	VER.2	APP
PURPOSE OF ISSUE - PRELIMINARY UNLESS INDICATED							
CLIENT APPROVAL	☐	PLANNING	☐	TENDER	☐	CONSTRUCTION	☐
AS-BUILT ☐							
Client GORT WINDFARMS LTD.							
Project DERRYBRIEN WIND FARM							
Contract							
Drawing Title SECTIONAL ELEVATION DERRYBRIEN 110 KV SUBSTATION							
PLANNING							
Production Unit CIVIL & ENVIRONMENTAL ENGINEERING							
One Dublin Airport Central, Dublin Airport, Cloghran, Co. Dublin Tel: 353 1 703 8000 Email: marketing@esbi.ie Web: www.esbinternational.ie ESB International is a trading name of ESBI Engineering & Facility Management Ltd Registered Office: as above Registered in Ireland No. 155249							
DRAWN P.CARROLL	PRODUCED P.CARROLL	VERIFIED 1 C.DOLAN	VERIFIED 2 H.McLOUGHLIN	APPROVED H.O'KEEFE	APPROVAL DATE 17/07/2020		
CLIENT REF		Client Ref. No.		No. OF SHTS -	SIZE A1	SCALE 1:100	SHEET REV
DRAWING NUMBER QS-000280-01-D460-21-003-000							