


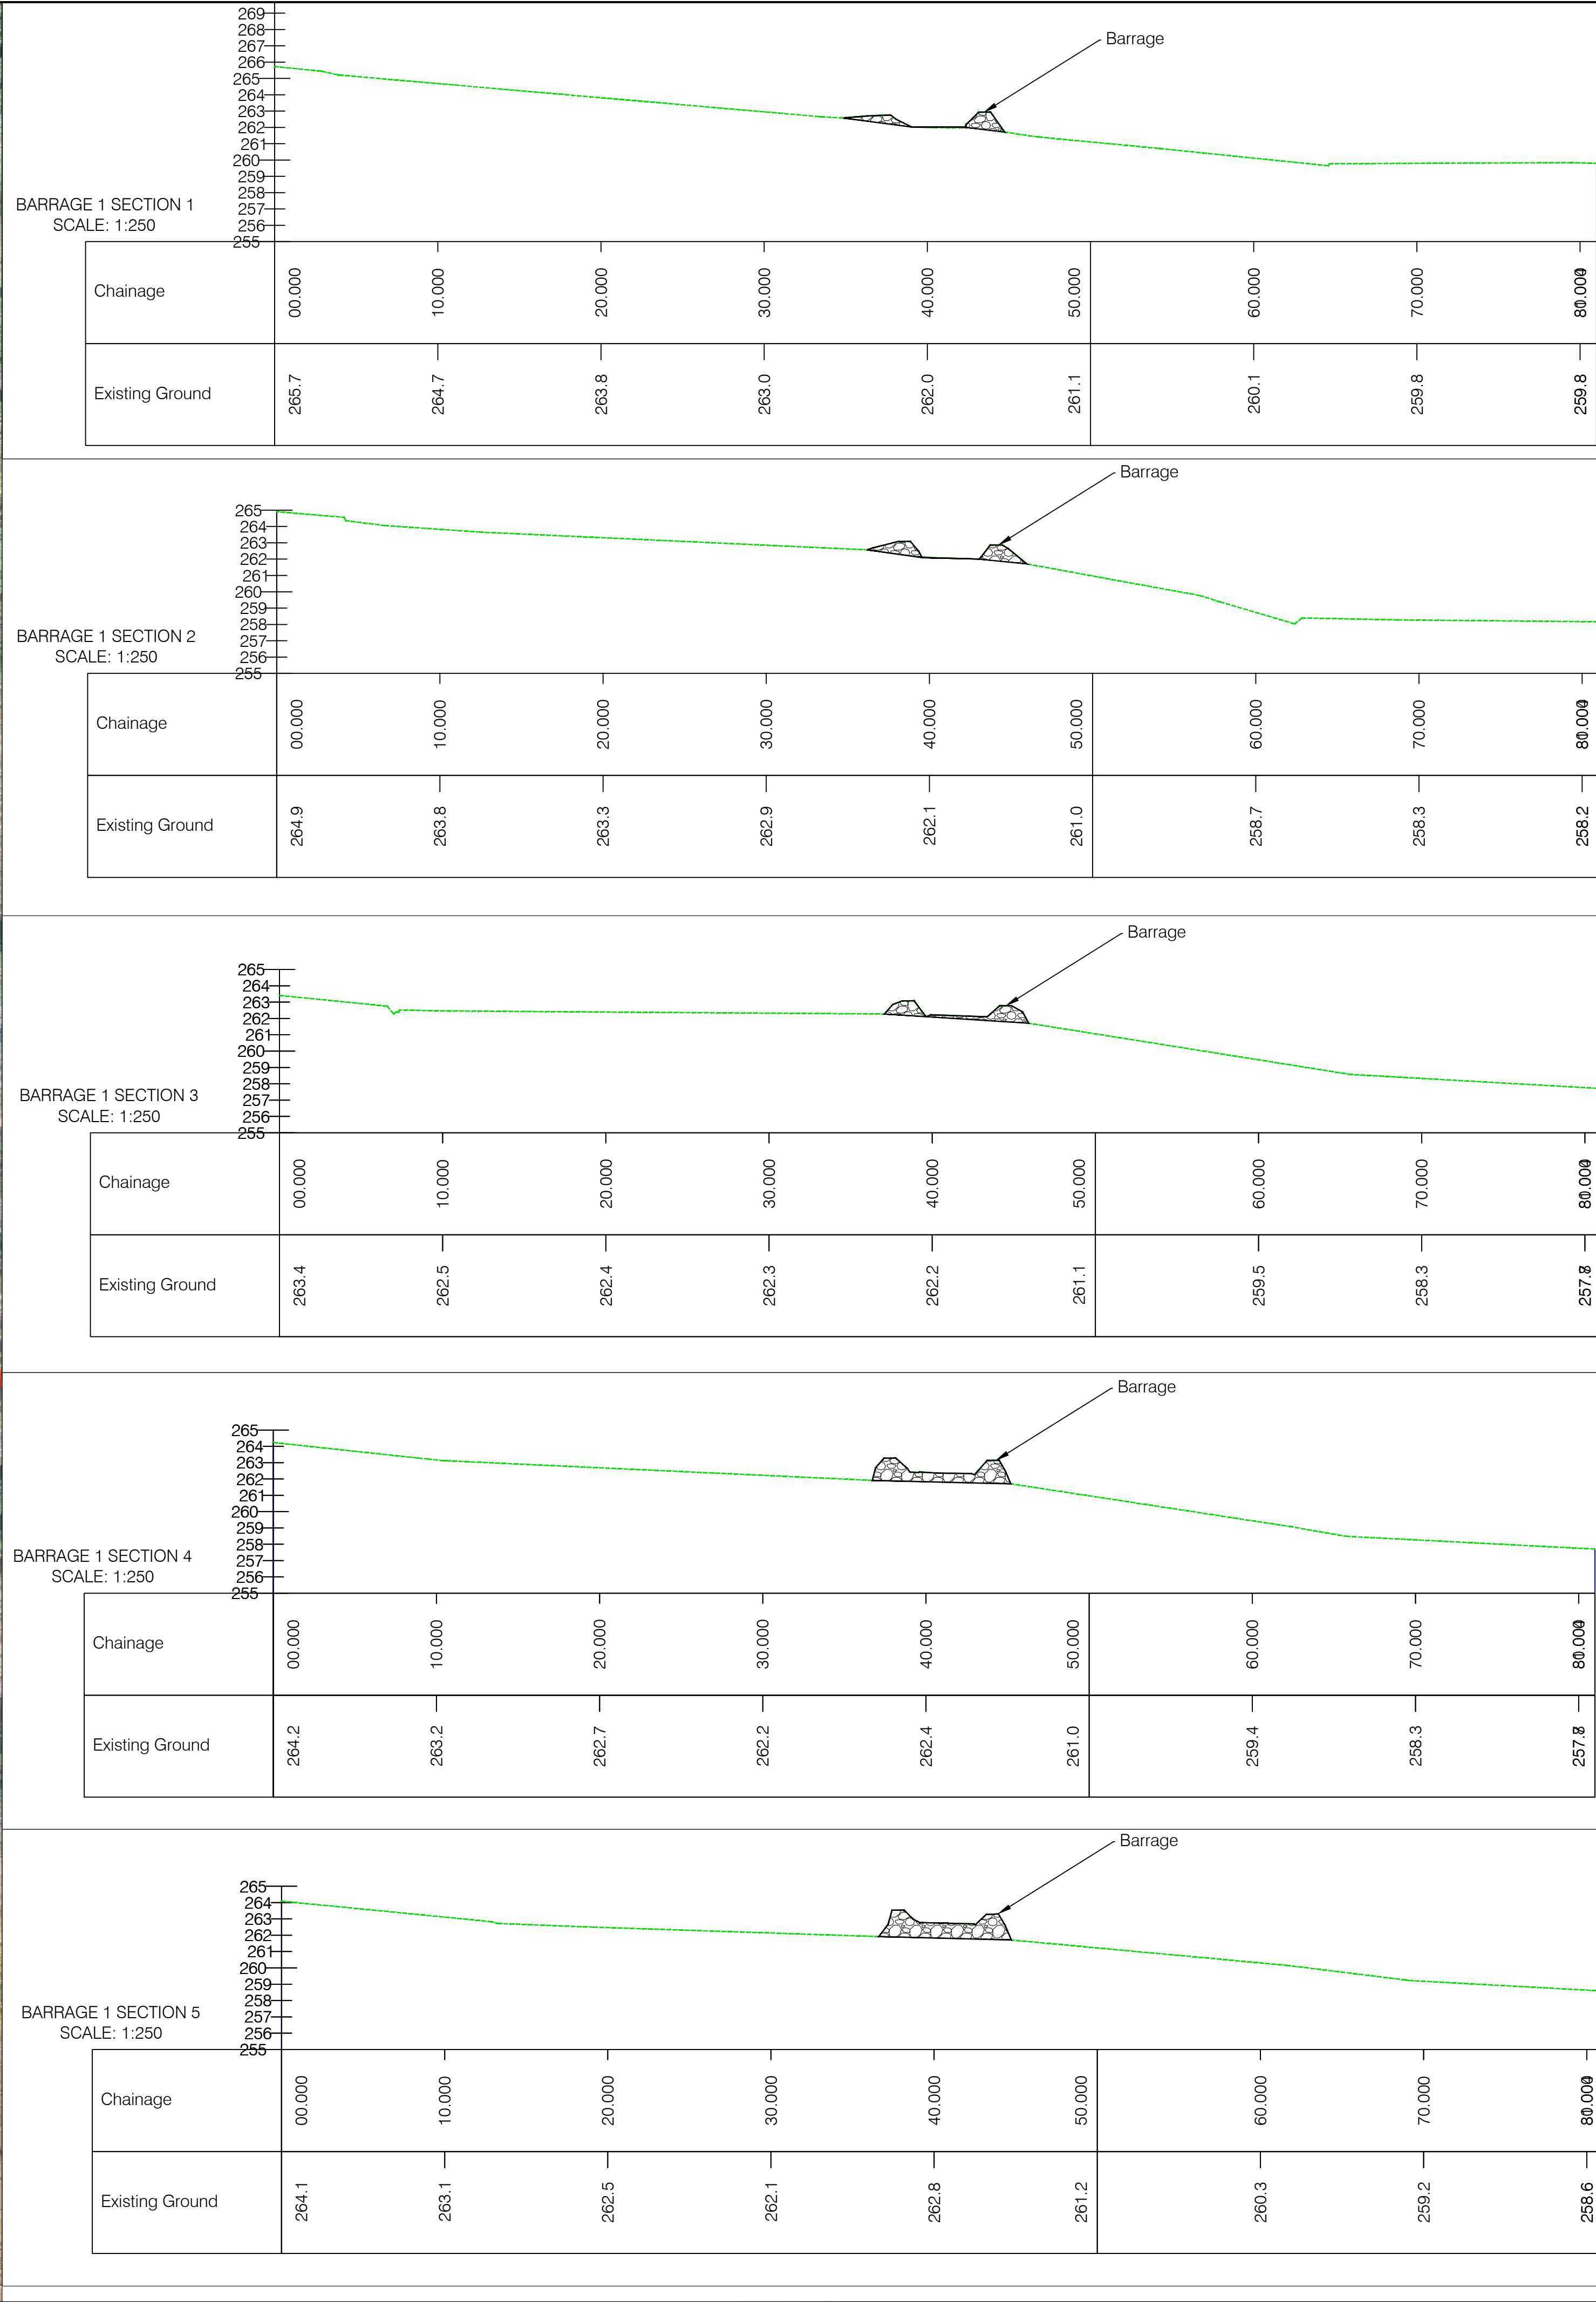

LEGEND

- Substitute Consent Application Boundary
- Bottom Bank
- Existing Ground
- Stone Barrage
- Constructed Access Track

LAYOUT

Barrage 1 Total
Approx Volume=900m3

SCALE 1:5,000

KEY PLAN

SCALE 1:50,000

BARRAGE 1

Note:
All levels in meters above ordnance datum Malin Head
Coordinates are given in Irish Transverse Mercator
coordinate system
Topographical survey undertaken on week commencing
16/09/2019
Background imagery taken from ESB EMP Drone

REV	DATE	REVISION DESCRIPTION	DRN	PROD	VER	APP
0	17.04.20	ISSUED FOR SUBSTITUTE CONSENT				

COPYRIGHT © ESB
ALL RIGHTS RESERVED. NO PART OF THIS WORK MAY BE MODIFIED, REPRODUCED OR COPIED IN ANY FORM
OR BY ANY MEANS - GRAPHIC, ELECTRONIC OR MECHANICAL, INCLUDING PHOTOCOPYING, RECORDING,
TAPING OR USED FOR ANY PURPOSE OTHER THAN ITS DESIGNATED PURPOSE, WITHOUT THE WRITTEN
PERMISSION OF ESB.

PURPOSE OF ISSUE - PRELIMINARY UNLESS INDICATED

CLIENT APPROVAL ☐ PLANNING ☒ TENDER ☐ CONSTRUCTION ☐ AS-BUILT ☐

CLIENT **GORT WINDFARMS LTD**

PROJECT **DERRYBRIEN WIND FARM PROJECT**

CONTRACT

DRAWING TITLE **BARRAGE 1 PLAN AND SECTIONS**

PRODUCTION UNIT **CIVIL & ENVIRONMENTAL ENGINEERING**



Engineering and Major Projects,
One Dublin Airport Central, Dublin Airport,
Cloghran, Co. Dublin, K67 XF72, Ireland.
Tel: +353 (0)1 703 8000 Web: www.esb.ie
Engineering and Major Projects is a division of ESB.

DRAWN	PRODUCED	VERIFIED	APPROVED	APPROVAL DATE
L.McManus	L.McManus	J.McLoughlin	H.O'Keefe	06.07.2020

CLIENT REF	NO. OF SHTS	SIZE	SCALE
	1	A1	As Shown

DRAWING NUMBER **QS-000280-01-D460-024-002-000**

SHEET **1** REV