

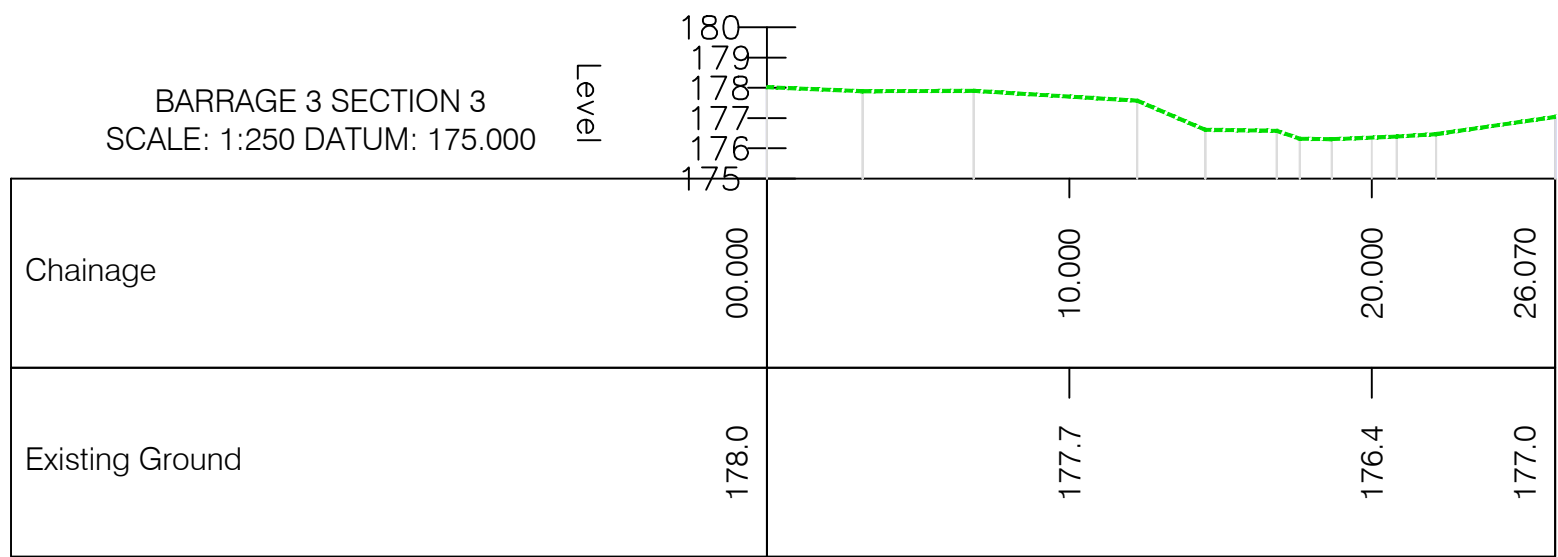
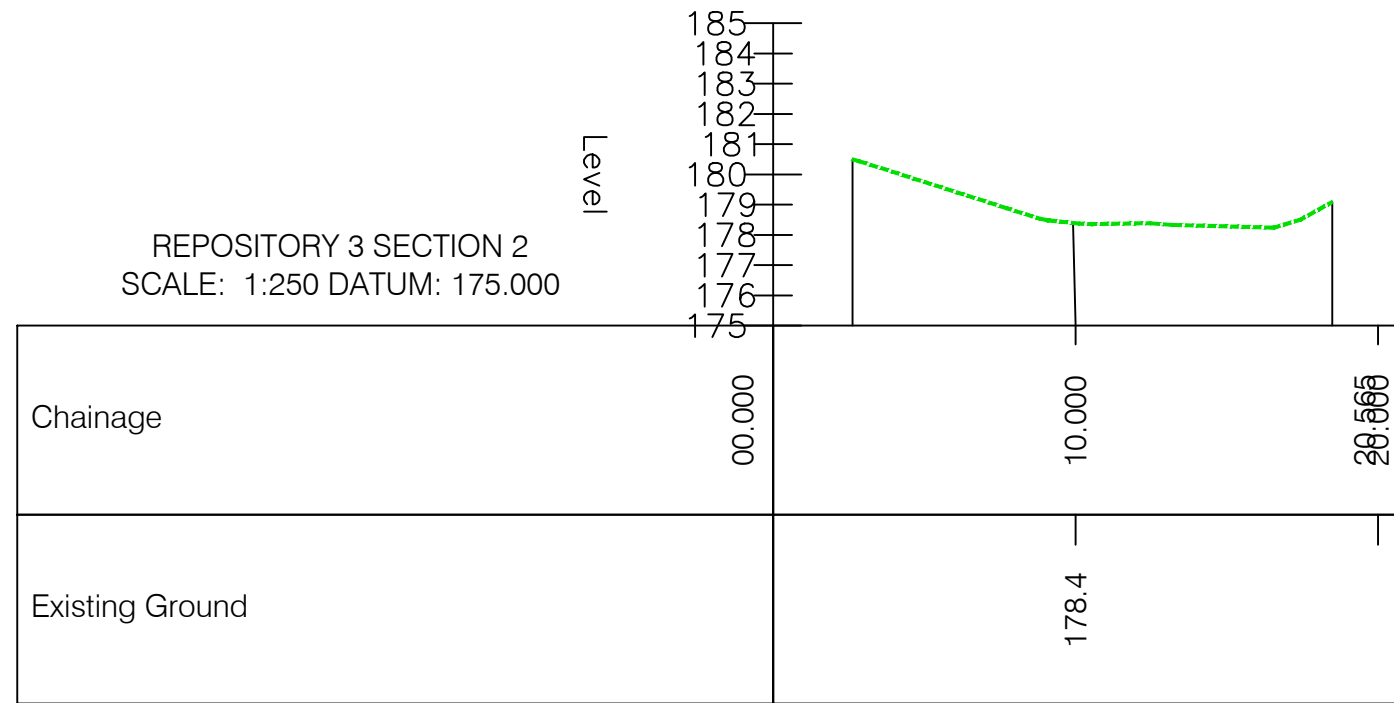
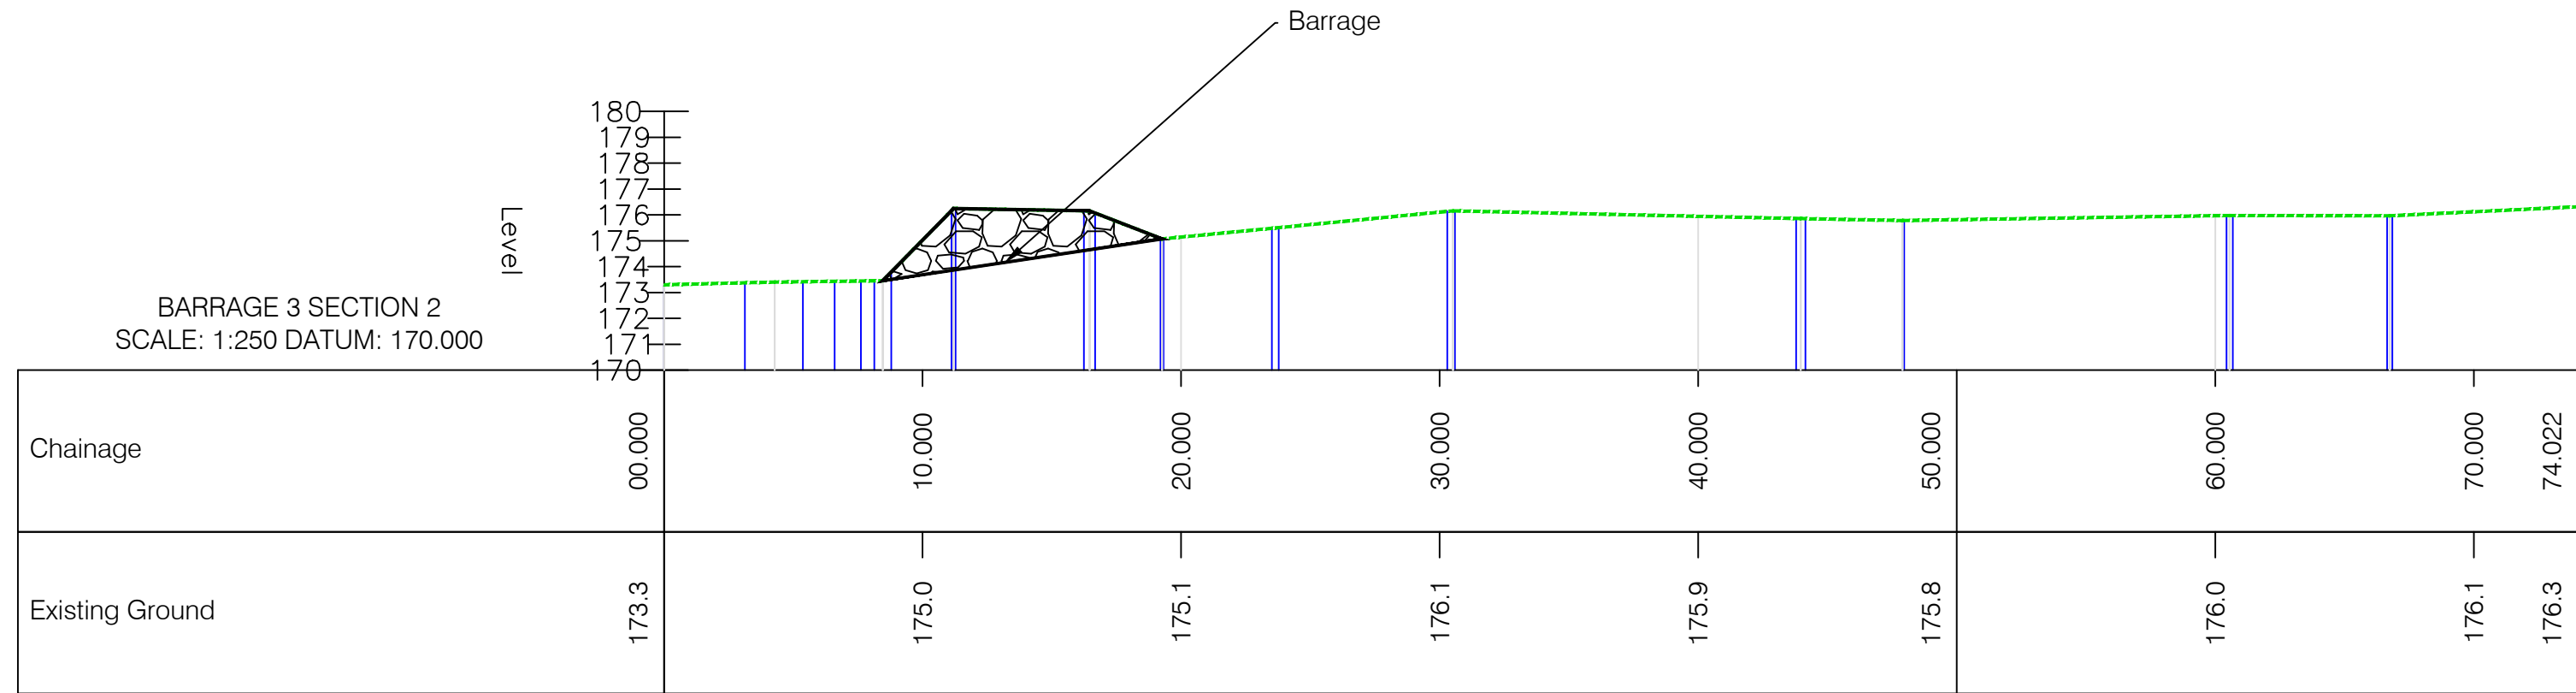
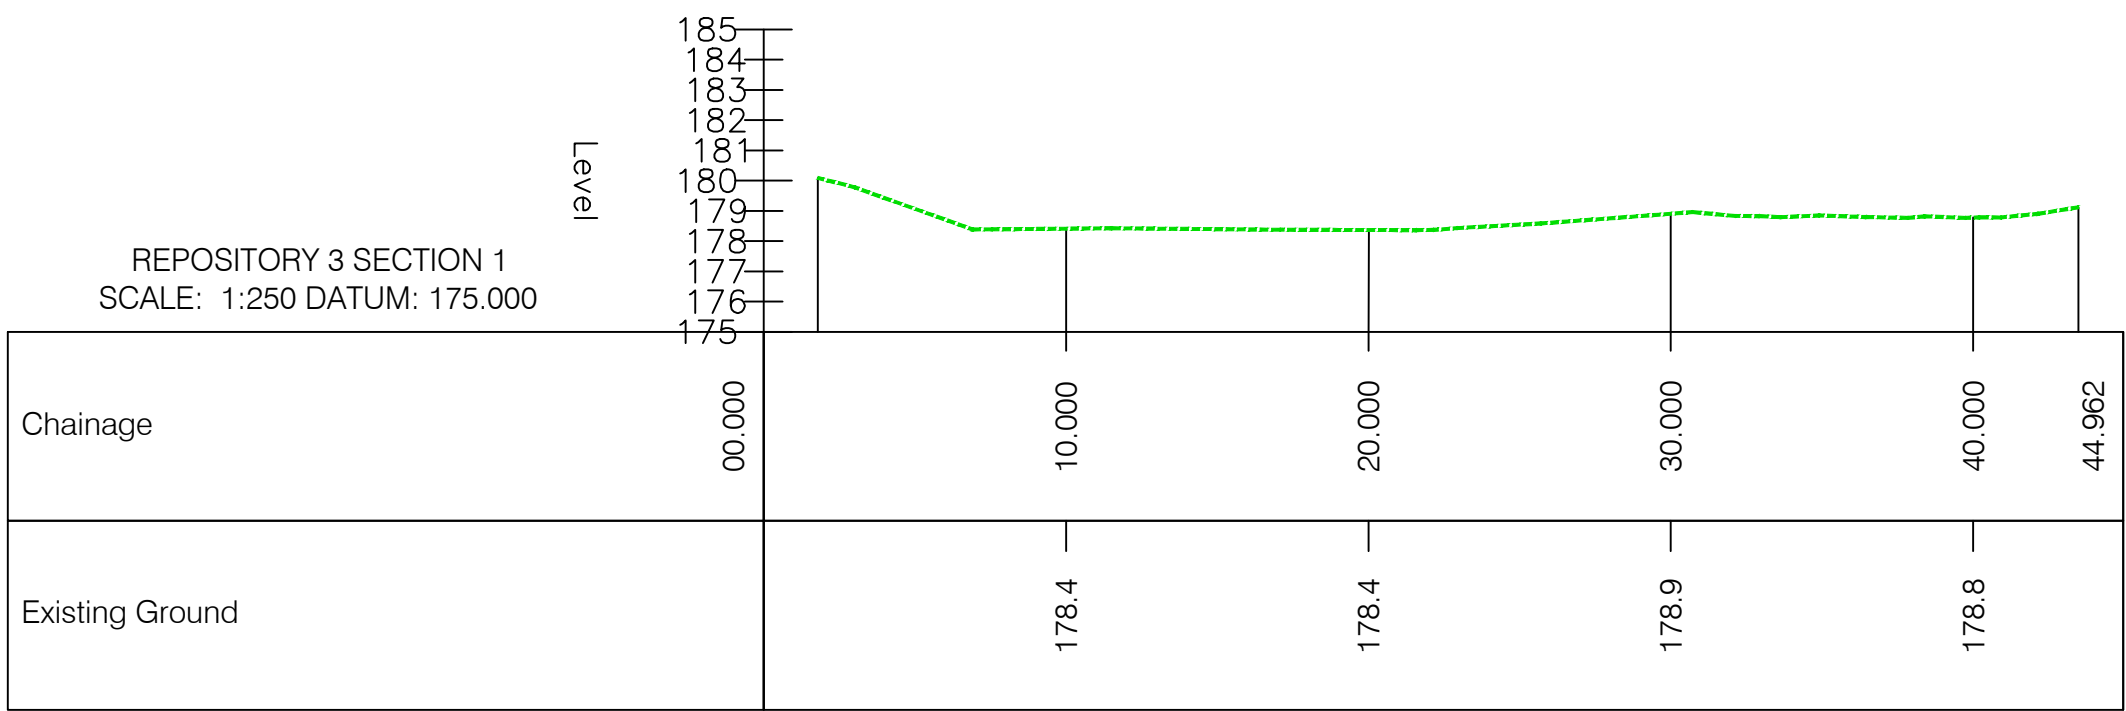
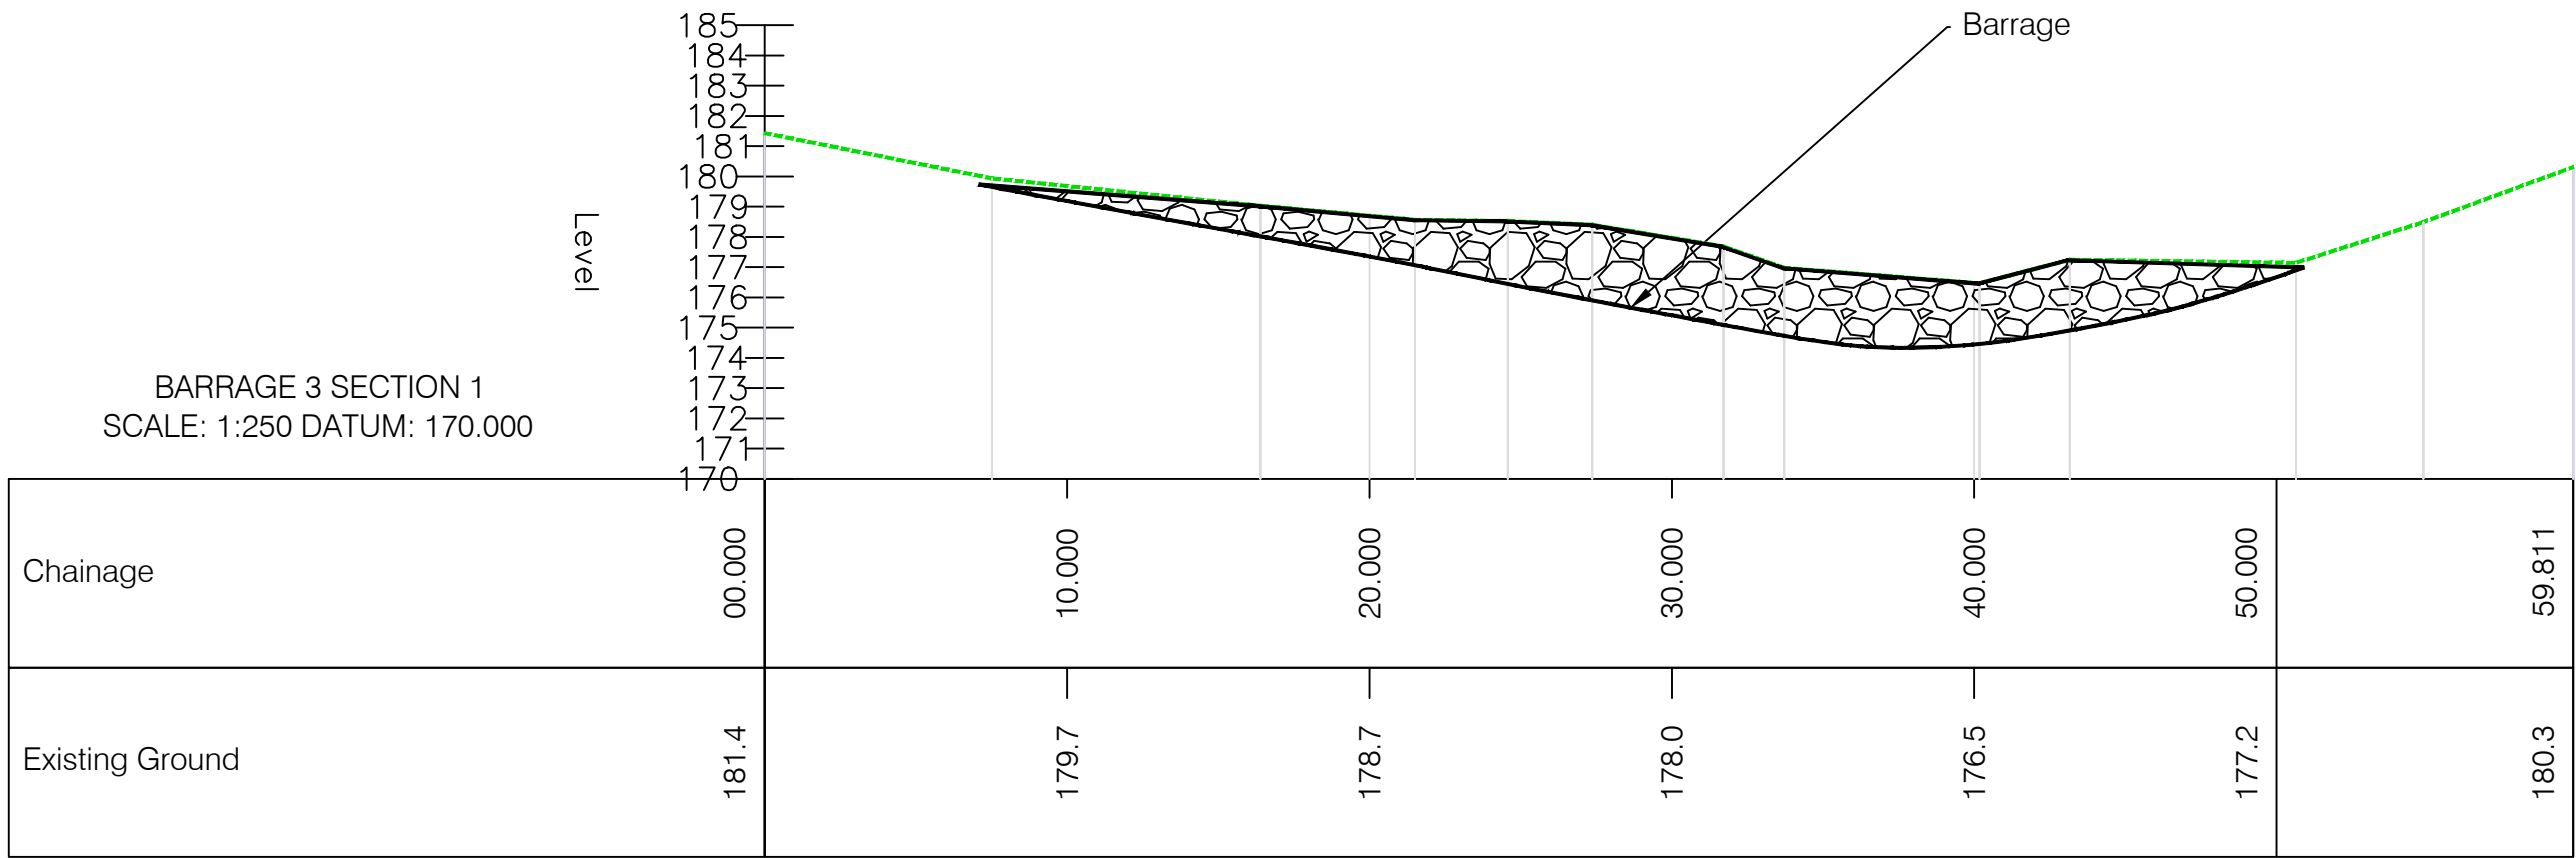


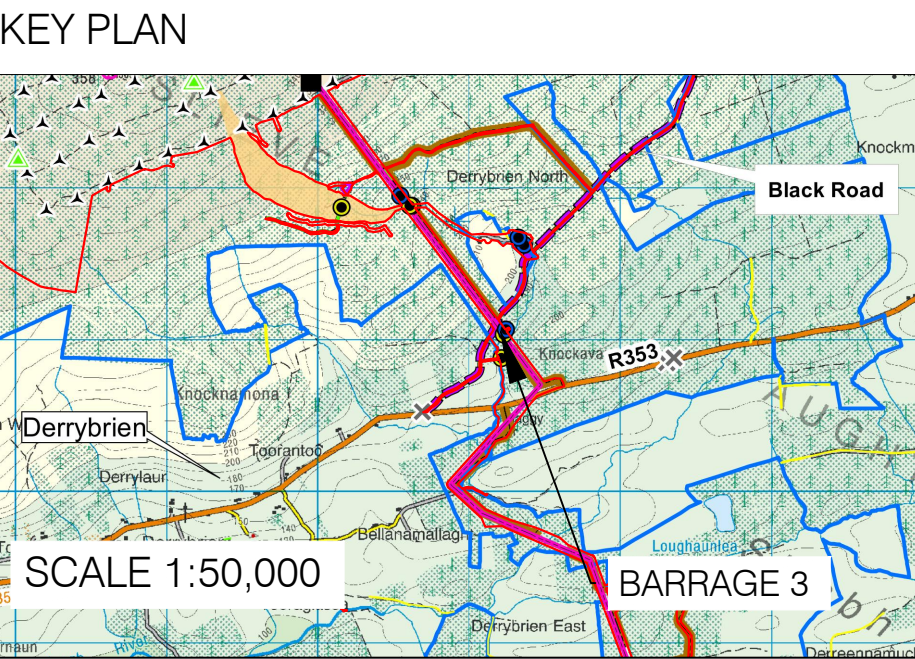

LEGEND

- Substitution Consent Application Boundary
- Existing Ground
- Stone Barrage

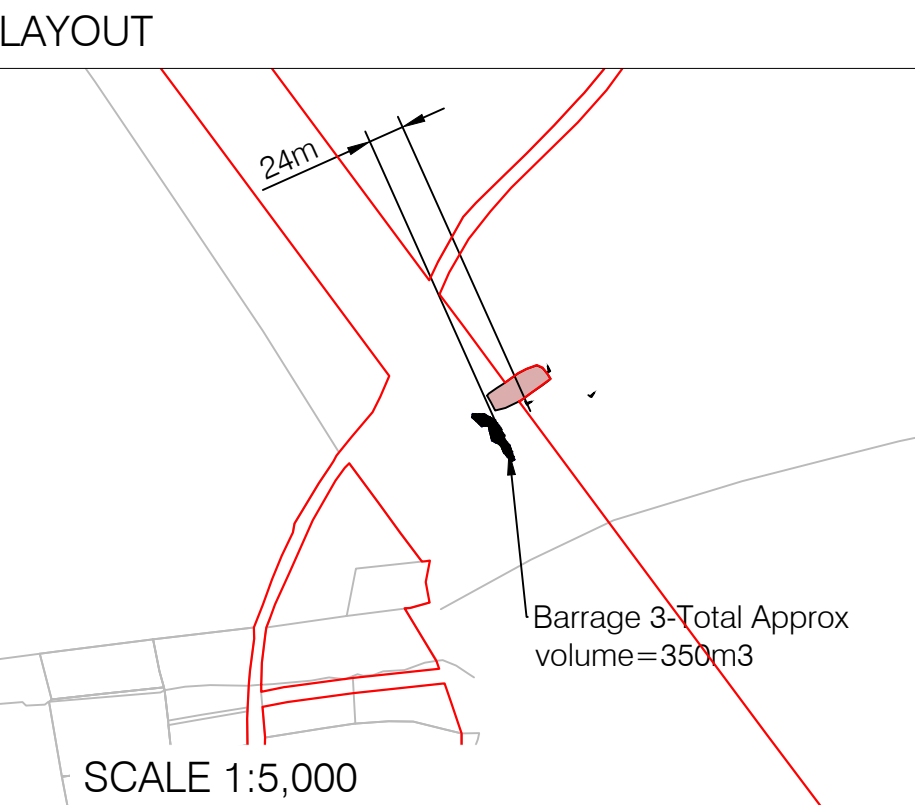

Note:
All levels in meters above ordnance datum Malin Head
Coordinates are given in Irish Transverse Mercator coordinate system
Topographical survey undertaken on week commencing 16/09/2019
Background imagery taken from ESB EMP Drone

0	06.07.20	ISSUED FOR SUBSTITUTE CONSENT	LMcM	LMcM	JMcL	HOK
REV	DATE	REVISION DESCRIPTION	DRN	PROD	VER	APP

COPYRIGHT © ESB
ALL RIGHTS RESERVED. NO PART OF THIS WORK MAY BE MODIFIED, REPRODUCED OR COPIED IN ANY FORM OR BY ANY MEANS - GRAPHIC, ELECTRONIC OR MECHANICAL, INCLUDING PHOTOCOPYING, RECORDING, TAPING OR USED FOR ANY PURPOSE OTHER THAN ITS DESIGNATED PURPOSE, WITHOUT THE WRITTEN PERMISSION OF ESB.

PURPOSE OF ISSUE - PRELIMINARY UNLESS INDICATED
CLIENT APPROVAL ☐ PLANNING ☒ TENDER ☐ CONSTRUCTION ☐ AS-BUILT ☐

CLIENT
GORT WINDFARMS LTD

PROJECT
DERRYBRIEN WIND FARM PROJECT

CONTRACT

DRAWING TITLE
BARRAGE 3 & ASSOCIATED REPOSITORY AREA SECTIONS

PRODUCTION UNIT
CIVIL & ENVIRONMENTAL ENGINEERING

ESB
Energy for generations

Engineering and Major Projects,
One Dublin Airport Central, Dublin Airport,
Cloghran, Co. Dublin, K67 XF72, Ireland.
Tel: +353 (0)1 703 8000 Web: www.esb.ie
Engineering and Major Projects is a division of ESB.

DRAWN L.McManus	PRODUCED L.McManus	VERIFIED J.McLoughlin	APPROVED H.O'Keefe	APPROVAL DATE 06.07.2020
CLIENT REF	NO. OF SHTS 1	SIZE A1	SCALE 1:250	

DRAWING NUMBER
QS-000280-01-D460-024-005-000

SHEET
REV