


APPENDIX 16.3 WATERMAIN EXISTING SERVICES


NOTES:

1. DO NOT SCALE. USE FIGURED DIMENSIONS ONLY.
2. THIS DRAWING IS TO BE READ IN CONJUNCTION WITH ALL OTHER RELEVANT ARCHITECTURAL AND ENGINEERING DRAWINGS.
3. IT IS THE CONTRACTORS RESPONSIBILITY TO ENSURE THAT ALL WORKS ARE CONSTRUCTED IN ACCORDANCE WITH THE IRISH WATER CODE OF PRACTICE AND STANDARD DETAILS. THE CODE OF PRACTICE AND STANDARD DETAILS ARE AVAILABLE TO DOWNLOAD FROM THE IRISH WATER WEB SITE AT WWW.WATER.IE/CONNECTIONS/DEVELOPER-SERVICES/ WHERE THE DETAILS CONTAINED ON THIS DRAWING DIFFER FROM THE IRISH WATER CODE OF PRACTICE OR STANDARD DETAILS THIS MUST BE BROUGHT TO THE ATTENTION OF THE ENGINEER IMMEDIATELY. IRISH WATER STANDARDS WILL TAKE PRECEDENCE.

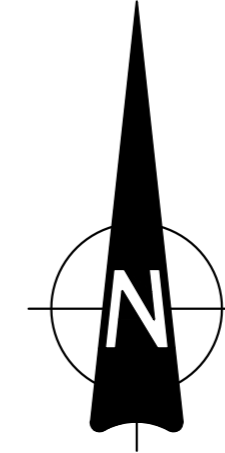

LEGEND:

- SITE BOUNDARY PHASE 2
- SITE BOUNDARY PHASE 1 APPROVED DEVELOPMENT APP REF PL17/241988 UNDER CONSTRUCTION
- EXISTING WATERMAIN

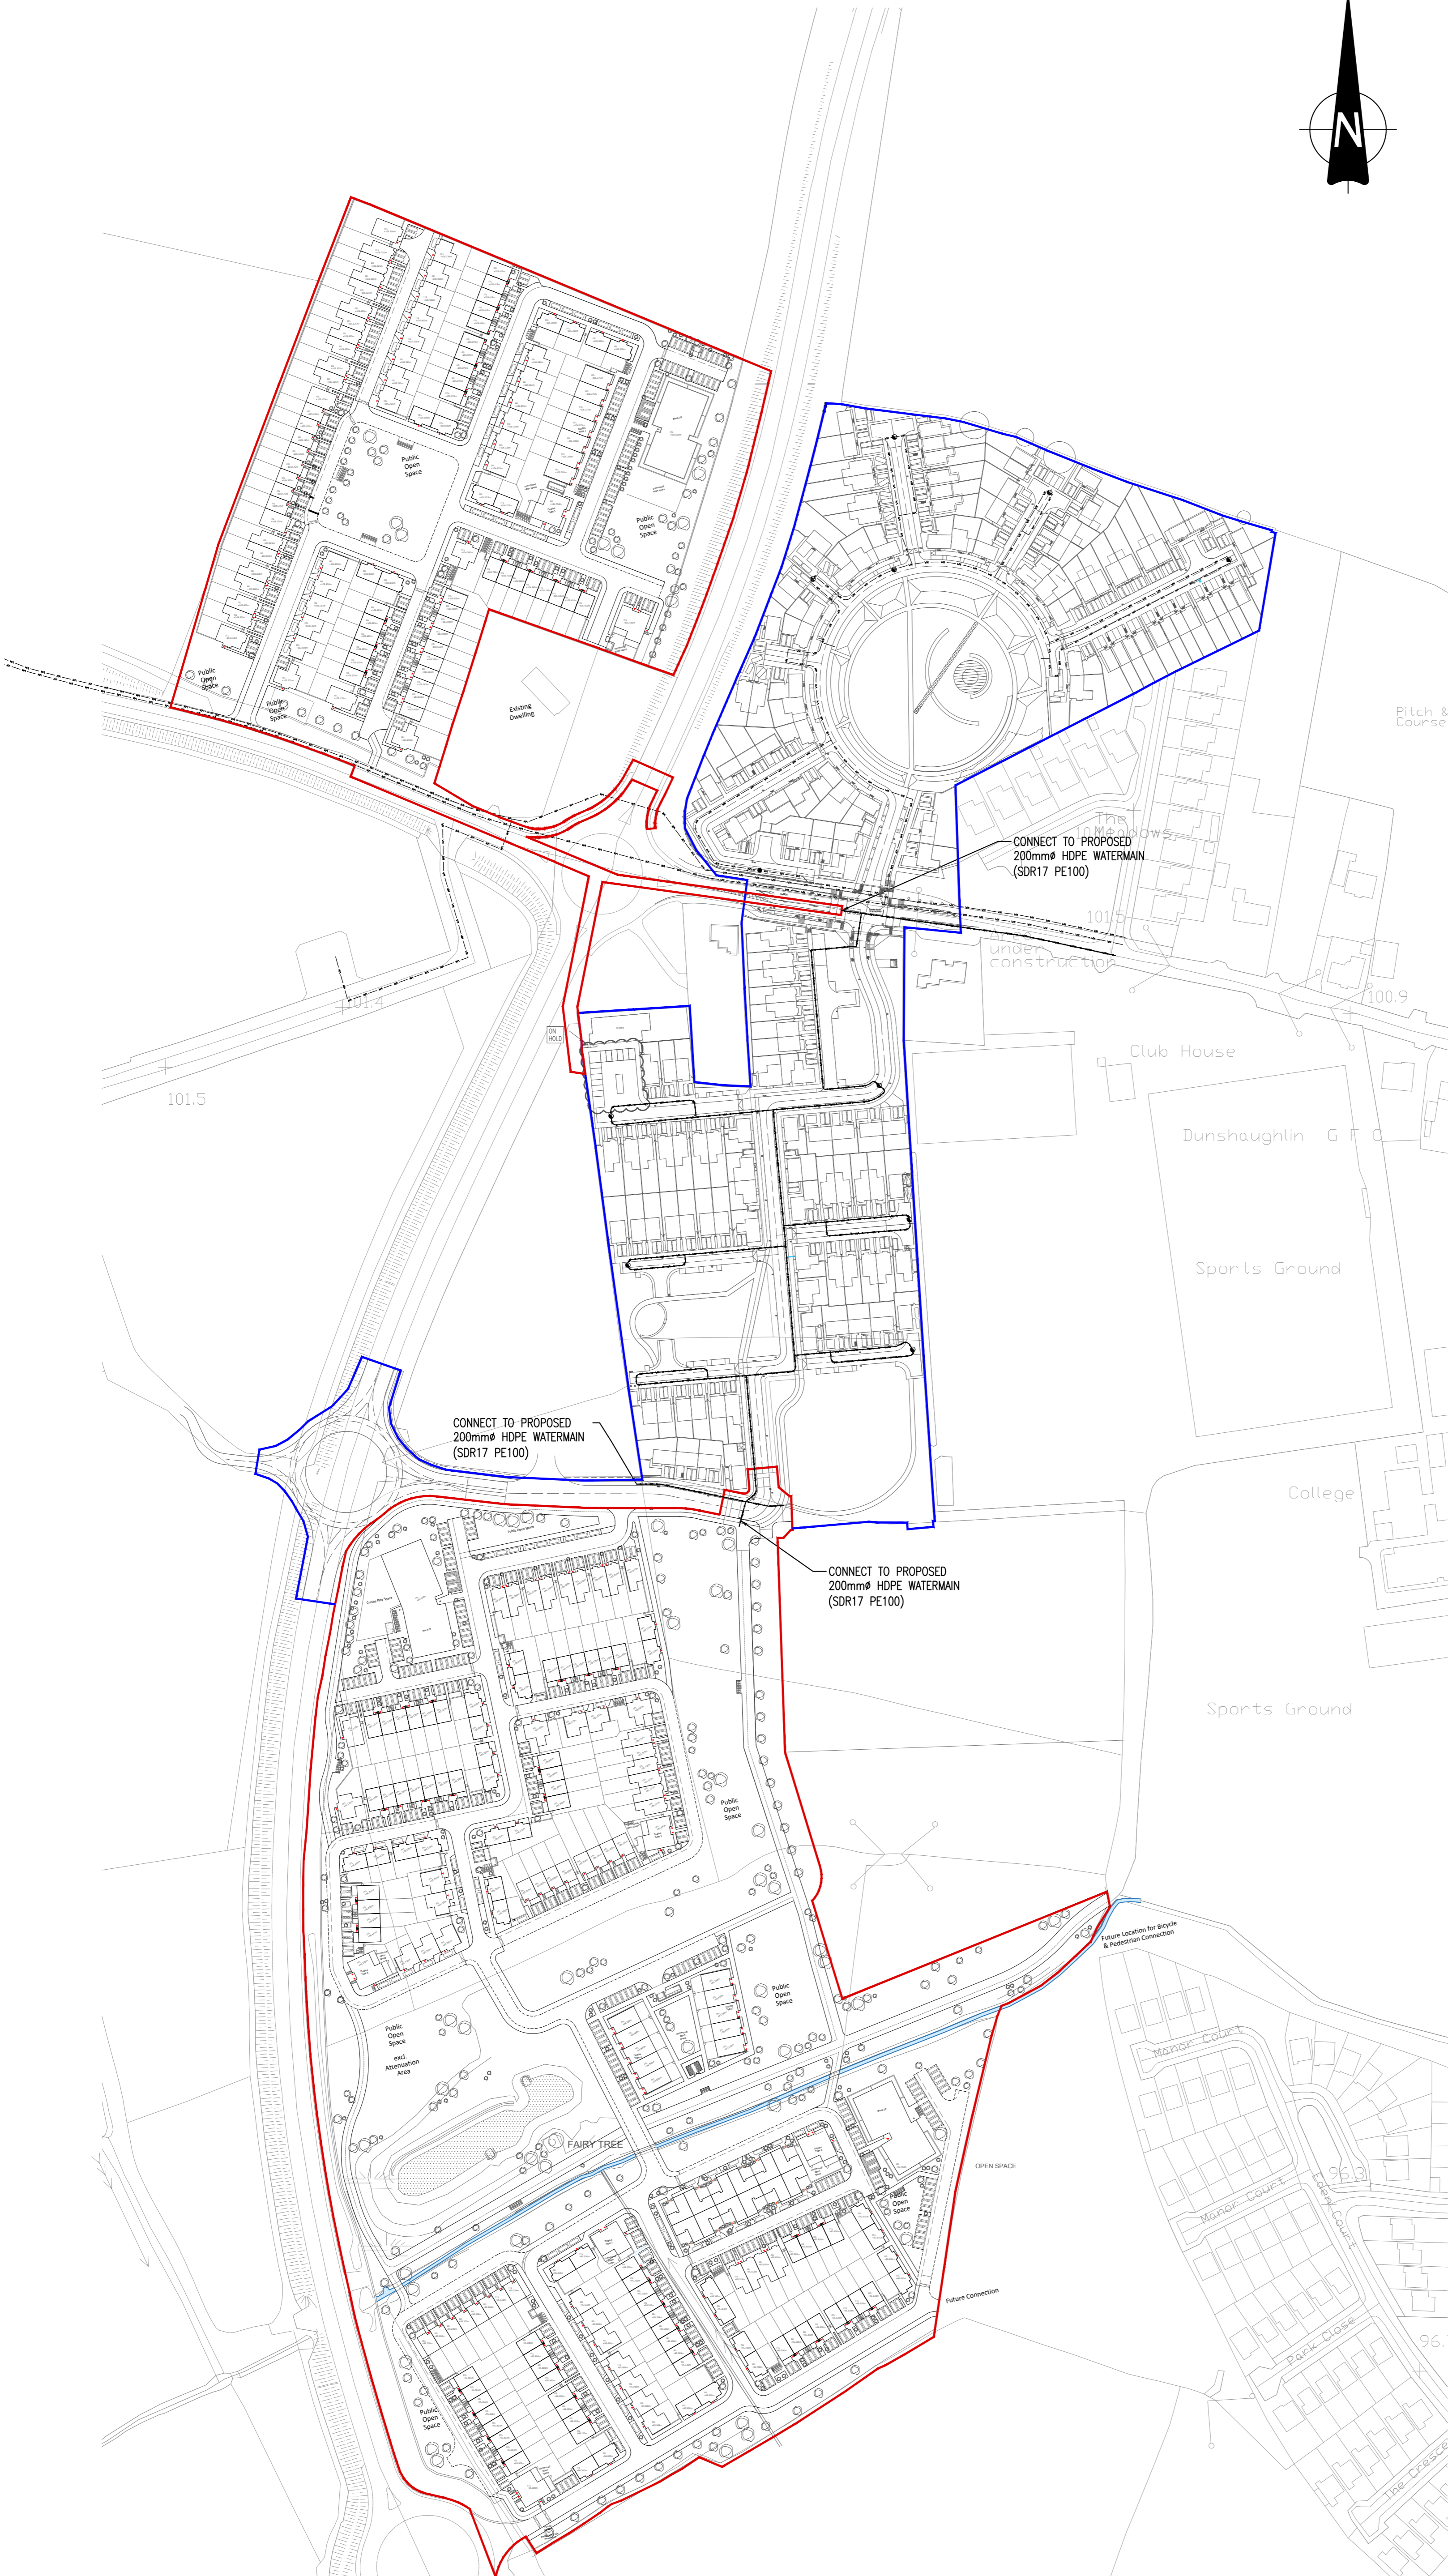

28 August 2020
MARK UP
 Martin Kello

~	xx/xx/20	SHD PRE-APPLICATION ISSUE	MK	IS
REV.	DATE	AMENDMENT	DRN	APPD

STATUS **FOR SHD PRE-APPLICATION**

Waterman Moylan
 Engineering Consultants
 BLOCK 5, EASTPOINT BUSINESS PARK, ALFIE BYRNE ROAD,
 DUBLIN D03 H3F4 IRELAND.
 Tel: (01) 664 8900 Fax: (01) 661 3618
 Email: info@waterman-moylan.ie www.waterman-moylan.ie

CLIENT	CASTELTHORN CONSTRUCTION ULC
ARCHITECT	O'MAHONY PIKE ARCHITECTS
PROJECT	PROPOSED PHASE 2 RESIDENTIAL DEVELOPMENT AT DUNSHAUGHLIN, CO. MEATH
TITLE	WATERMAIN GENERAL ARRANGEMENT

DRAWN	DESIGNED	APPROVED	DATE
MK	KV	IS	AUG. 2020
SCALE	JOB NO.	DRG. NO.	REVISION
1:1500 @ A1	12-081A	SK007EXWM	~