


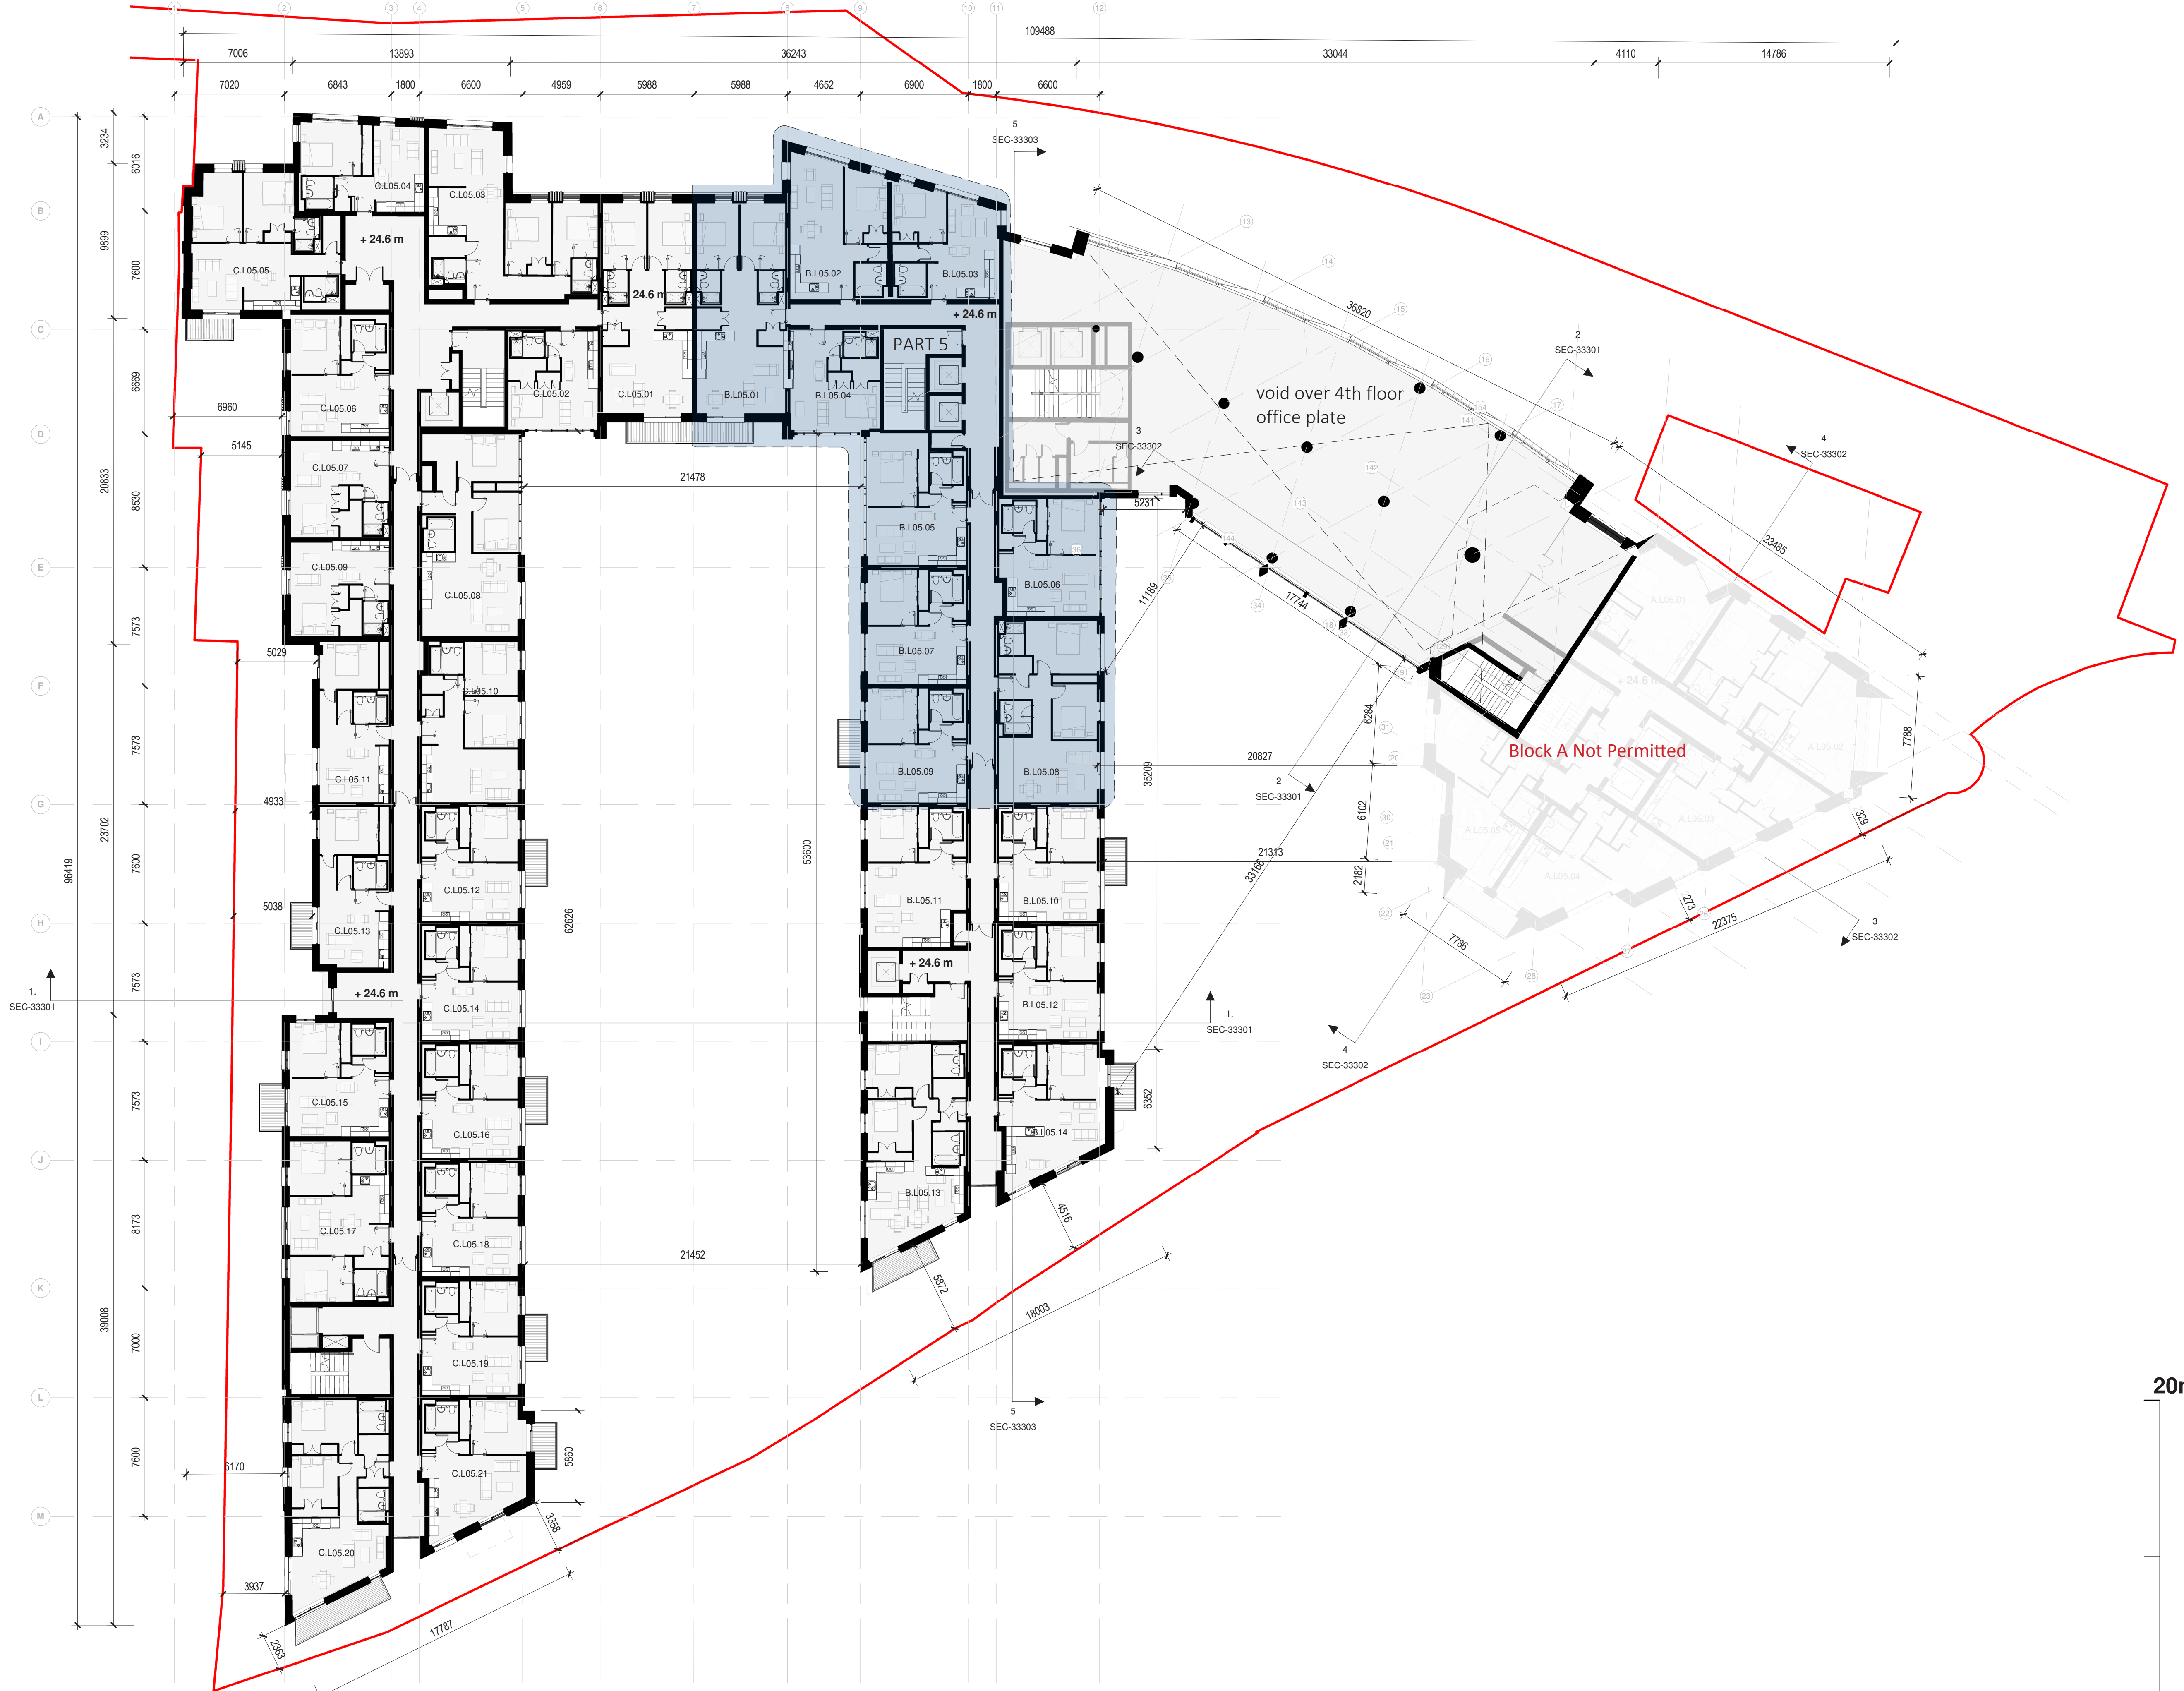


Proposed 5th Floor Plan  
1 : 200

20m 0

Notes:  
DO NOT SCALE FROM THIS DRAWING. USE FIGURED DIMENSIONS  
IN ALL CASES. VERIFY DIMENSIONS ON SITE AND REPORT ANY  
DISCREPANCIES TO THE ARCHITECTS IMMEDIATELY. THIS  
DRAWING TO BE READ IN CONJUNCTION WITH THE ARCHITECTS  
SPECIFICATION. © THIS DRAWING IS COPYRIGHT AND MAY ONLY  
BE REPRODUCED WITH THE ARCHITECTS PERMISSION.

OSI License Number - AR 0052219  
Projection / Spatial Reference:  
Projection= IRENET96 Irish Transverse Mercator  
Centre Point Coordinates:  
X,Y= 713657.3699,734403.2446  
Reference Index:  
Map Series | Map Sheets  
1:1,000 | 3263-02  
1:1,000 | 3263-03  
1:1,000 | 3263-07  
1:1,000 | 3263-03  
Vertical Datum:  
MALIN HEAD

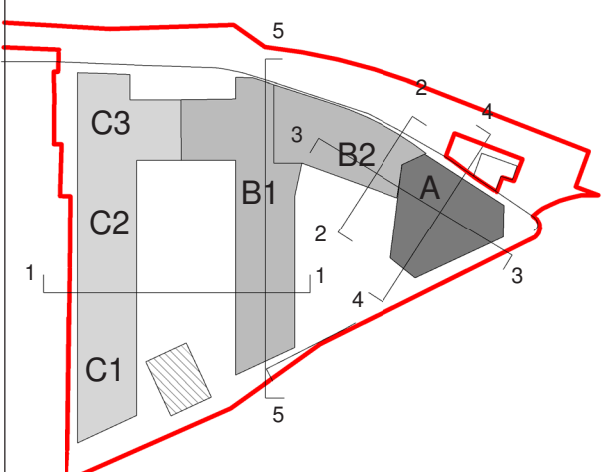

**PLANNING LEGEND**

| SYMBOL            | DESCRIPTION             |
|-------------------|-------------------------|
| [Red line]        | SITE BOUNDARY LINE      |
| [Black outline]   | EXISTING STRUCTURES     |
| [Yellow fill]     | WAYLEAVE / RIGHT OF WAY |
| [Green triangle]  | RESIDENTIAL ENTRANCE    |
| [Orange triangle] | PUBLIC ENTRANCE         |

**PART V LEGEND**

| SYMBOL      | DESCRIPTION        |
|-------------|--------------------|
| [Blue fill] | SITE BOUNDARY LINE |

As permitted under ABP Reg.  
Ref 306569-20

|     |          |     |                         |
|-----|----------|-----|-------------------------|
| P02 | 27/01/20 | EOB | Full Planning ABP issue |
| P01 | 14/06/19 | EOB | Pre-Planning ABP issue  |

| Rev | Date | DRN | Description |
|-----|------|-----|-------------|
|-----|------|-----|-------------|

**reddyarchitecture +urbanism**

Reddy Architecture + Urbanism  
Dartly Lane,  
Dublin 6, D06 Y0E3.  
T: +353 (0)1 4987000  
W: www.reddyarchitecture.com  
E: info@reddyarchitecture.com

Client Details:  
Ruirsde Developments Ltd.

Project Details:  
PGATE  
42A Parkgate Street, Dublin 8

Drawing Title:  
Permitted 5th Floor Plan  
ABP Ref. 306569-20

|                                |             |           |
|--------------------------------|-------------|-----------|
| Job No                         | Date        | Scale@A1  |
| P18-107D                       | 27/01/20    | 1:200     |
| Status                         | Drawn By:   | McGuire   |
| Planning                       | Checked By: | E.O'Brien |
| Purpose                        | Checked By: | E.O'Brien |
| Planning Permission            |             |           |
| Drawing Number                 | Revision    |           |
| PGATE-RAU-ZZ-05-DR-A-GAP-31106 | P02         |           |