
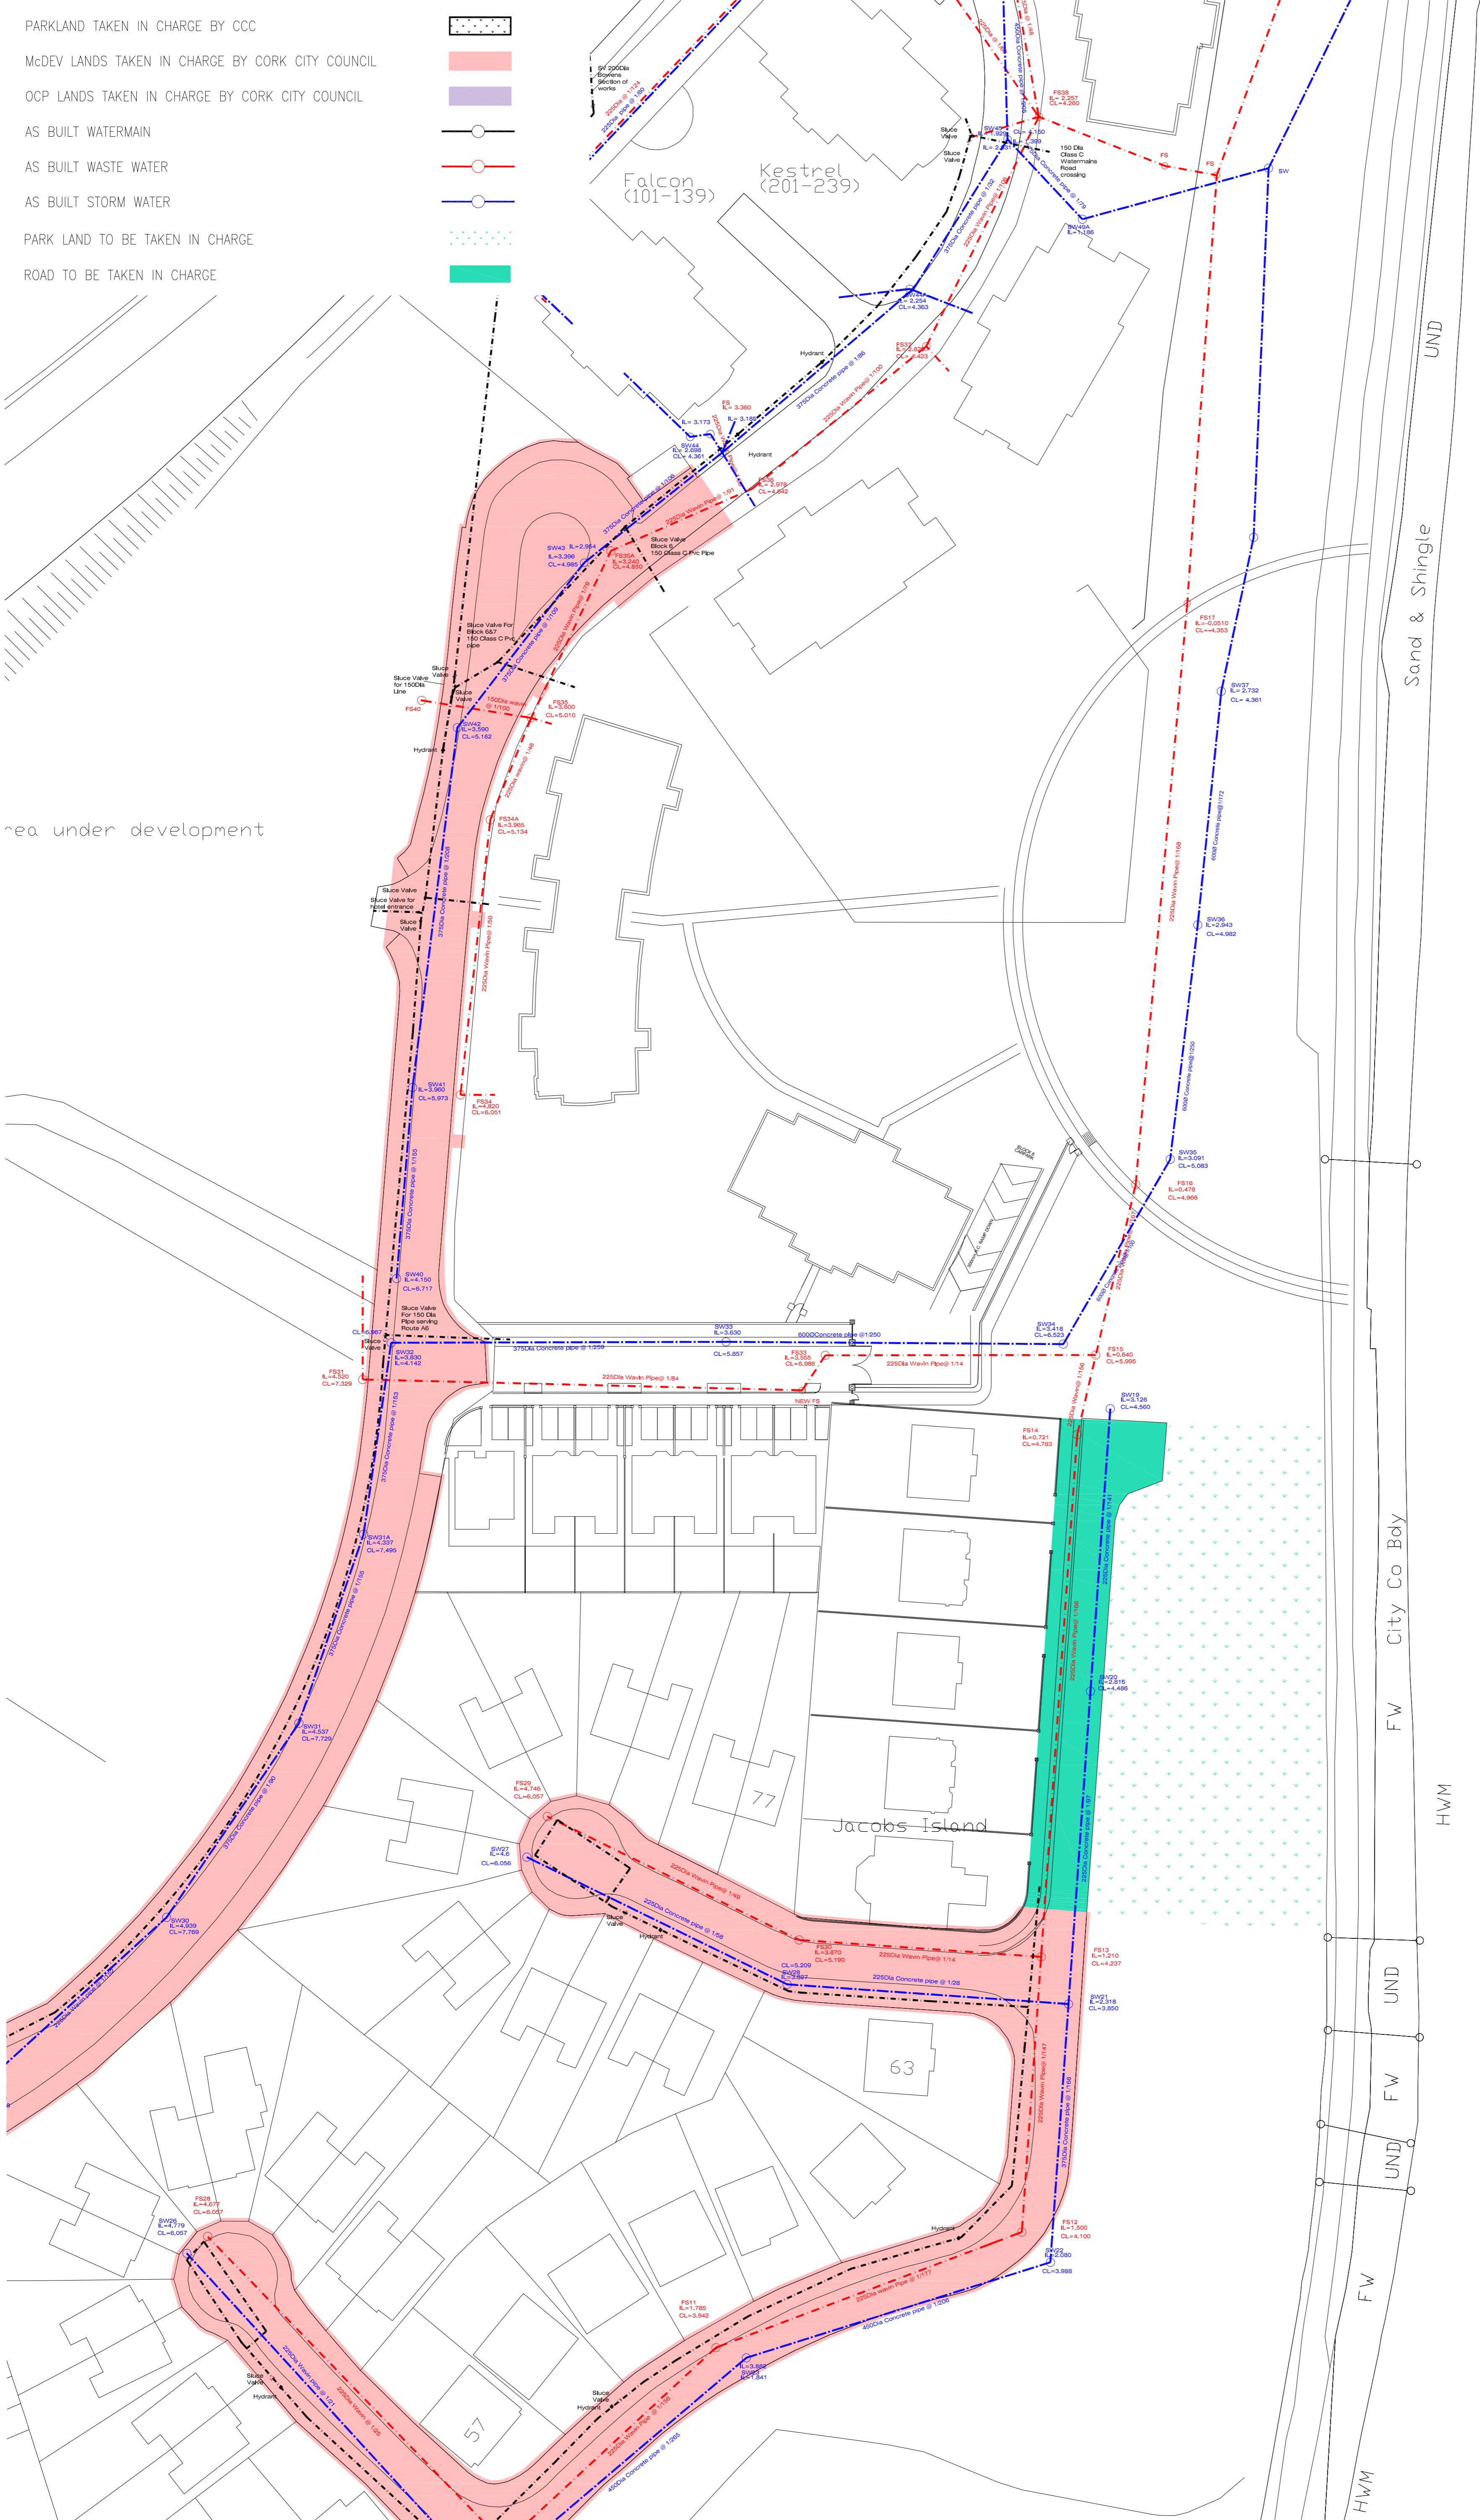


- PARKLAND TAKEN IN CHARGE BY CCC
- McDEV LANDS TAKEN IN CHARGE BY CORK CITY COUNCIL
- OCP LANDS TAKEN IN CHARGE BY CORK CITY COUNCIL
- AS BUILT WATERMAIN
- AS BUILT WASTE WATER
- AS BUILT STORM WATER
- PARK LAND TO BE TAKEN IN CHARGE
- ROAD TO BE TAKEN IN CHARGE

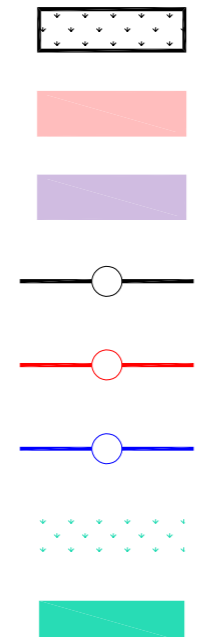

Rev	Description	Date
P01	FOR INFORMATION	03.04.19

MMOS Lane Business Park, Monahan Road, Cork.
 MURPHY · MATSON · O'SULLIVAN
 CONSULTING CIVIL & STRUCTURAL ENGINEERS Tel : 353 21 4317608

PROJECT
 Services / Taking in Charge
 Jacobs Island

TITLE
 Road to be Taken in Charge

CLIENT
 O Callaghan Properties

DRAWN BY T.O.C CHECKED BY M.M DATE 2019

SCALE (@ A1) 1:500 PROJECT NUMBER 11032

DOCUMENT REFERENCE 11032-MMS-ZZ-ST-DR-C-10004 STATUS: S2

EXISTING SERVICES / TAKING IN CHARGE MASTER PLAN
JACOBS ISLAND
 Scale 1:1000 at A1