


LEGEND: (GROUND INVESTIGATION CONTRACT)

- CABLE PERCUSSION BOREHOLE
- ROTARY/POLYMER GEL BOREHOLE
- ELECTRICAL RESISTIVITY
- SEISMIC REFLECTION/REFRACTION
- MULTI-CHANNEL ANALYSIS OF SURFACE WAVES
- GROUND PENETRATING RADAR
- NOISE ASSESSMENT LOCATIONS REQUIRED
- TRIAL PIT / STRUCTURAL CORING
- WINDOW SAMPLE
- DYNAMIC PROBE
- SLIT TRENCH



CONNOLLY STATION LOWER LEVEL

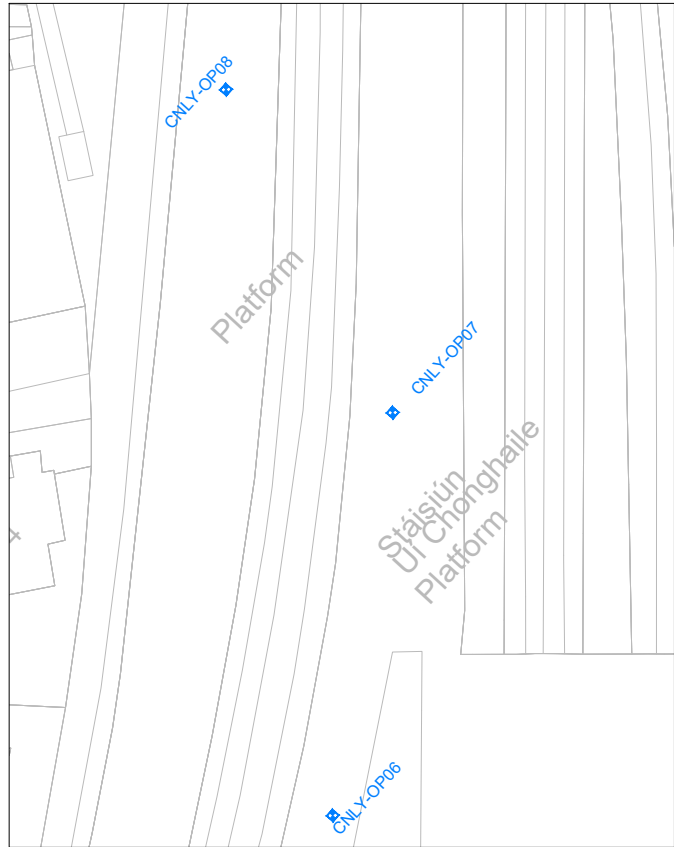

CONNOLLY STATION UPPER LEVEL

V01	May 2022	PLANNING ISSUE	MAH	MAH	MK
REV.	DATE	DESCRIPTION	PRODUCED BY	REVIEWED BY	APPROVED BY

© Irish Rail (2021). This drawing is confidential and the copyright in it is owned by Irish Rail. This drawing must not be either loaned, copied or otherwise reproduced in whole or in part or used for any purpose without the prior permission of Irish Rail.
 © Ordnance Survey, Ireland and Government of Ireland. All O.S. data used for plans are printed under "Copyright Ordnance Survey Ireland".
 Survey No. 0039721 (OSi Aerial Data or OSi Lidar Data) & Survey No. 2021031_NMA_180 (OSi Vector Data).
 All elevations are in metres and relate to OSi Geoid Model (OSGM02) Mean Head as defined by existing Project Control.
 All Co-ordinates are in Irish Transverse Mercator Grid (ITM) as defined by OSi active GPS station Tallaght College (TLG0).

Client

Consultant

Project



Drawing Title

GROUND INVESTIGATION AS-BUILT LOCATIONS SHEET 1

Scale: 1:2,500 @ A1 1:5,000 @ A3

Drawing Number | Project | Originator | Discipline | Location | Type | Role | Number | Phase
 MAY MDC GEO ROUT DR G 96001 D

Date: May 2022 | Job No: P/101086 | Status: F1 - Approved & Accepted | Rev: V 01 | Sheet: 01 of 24

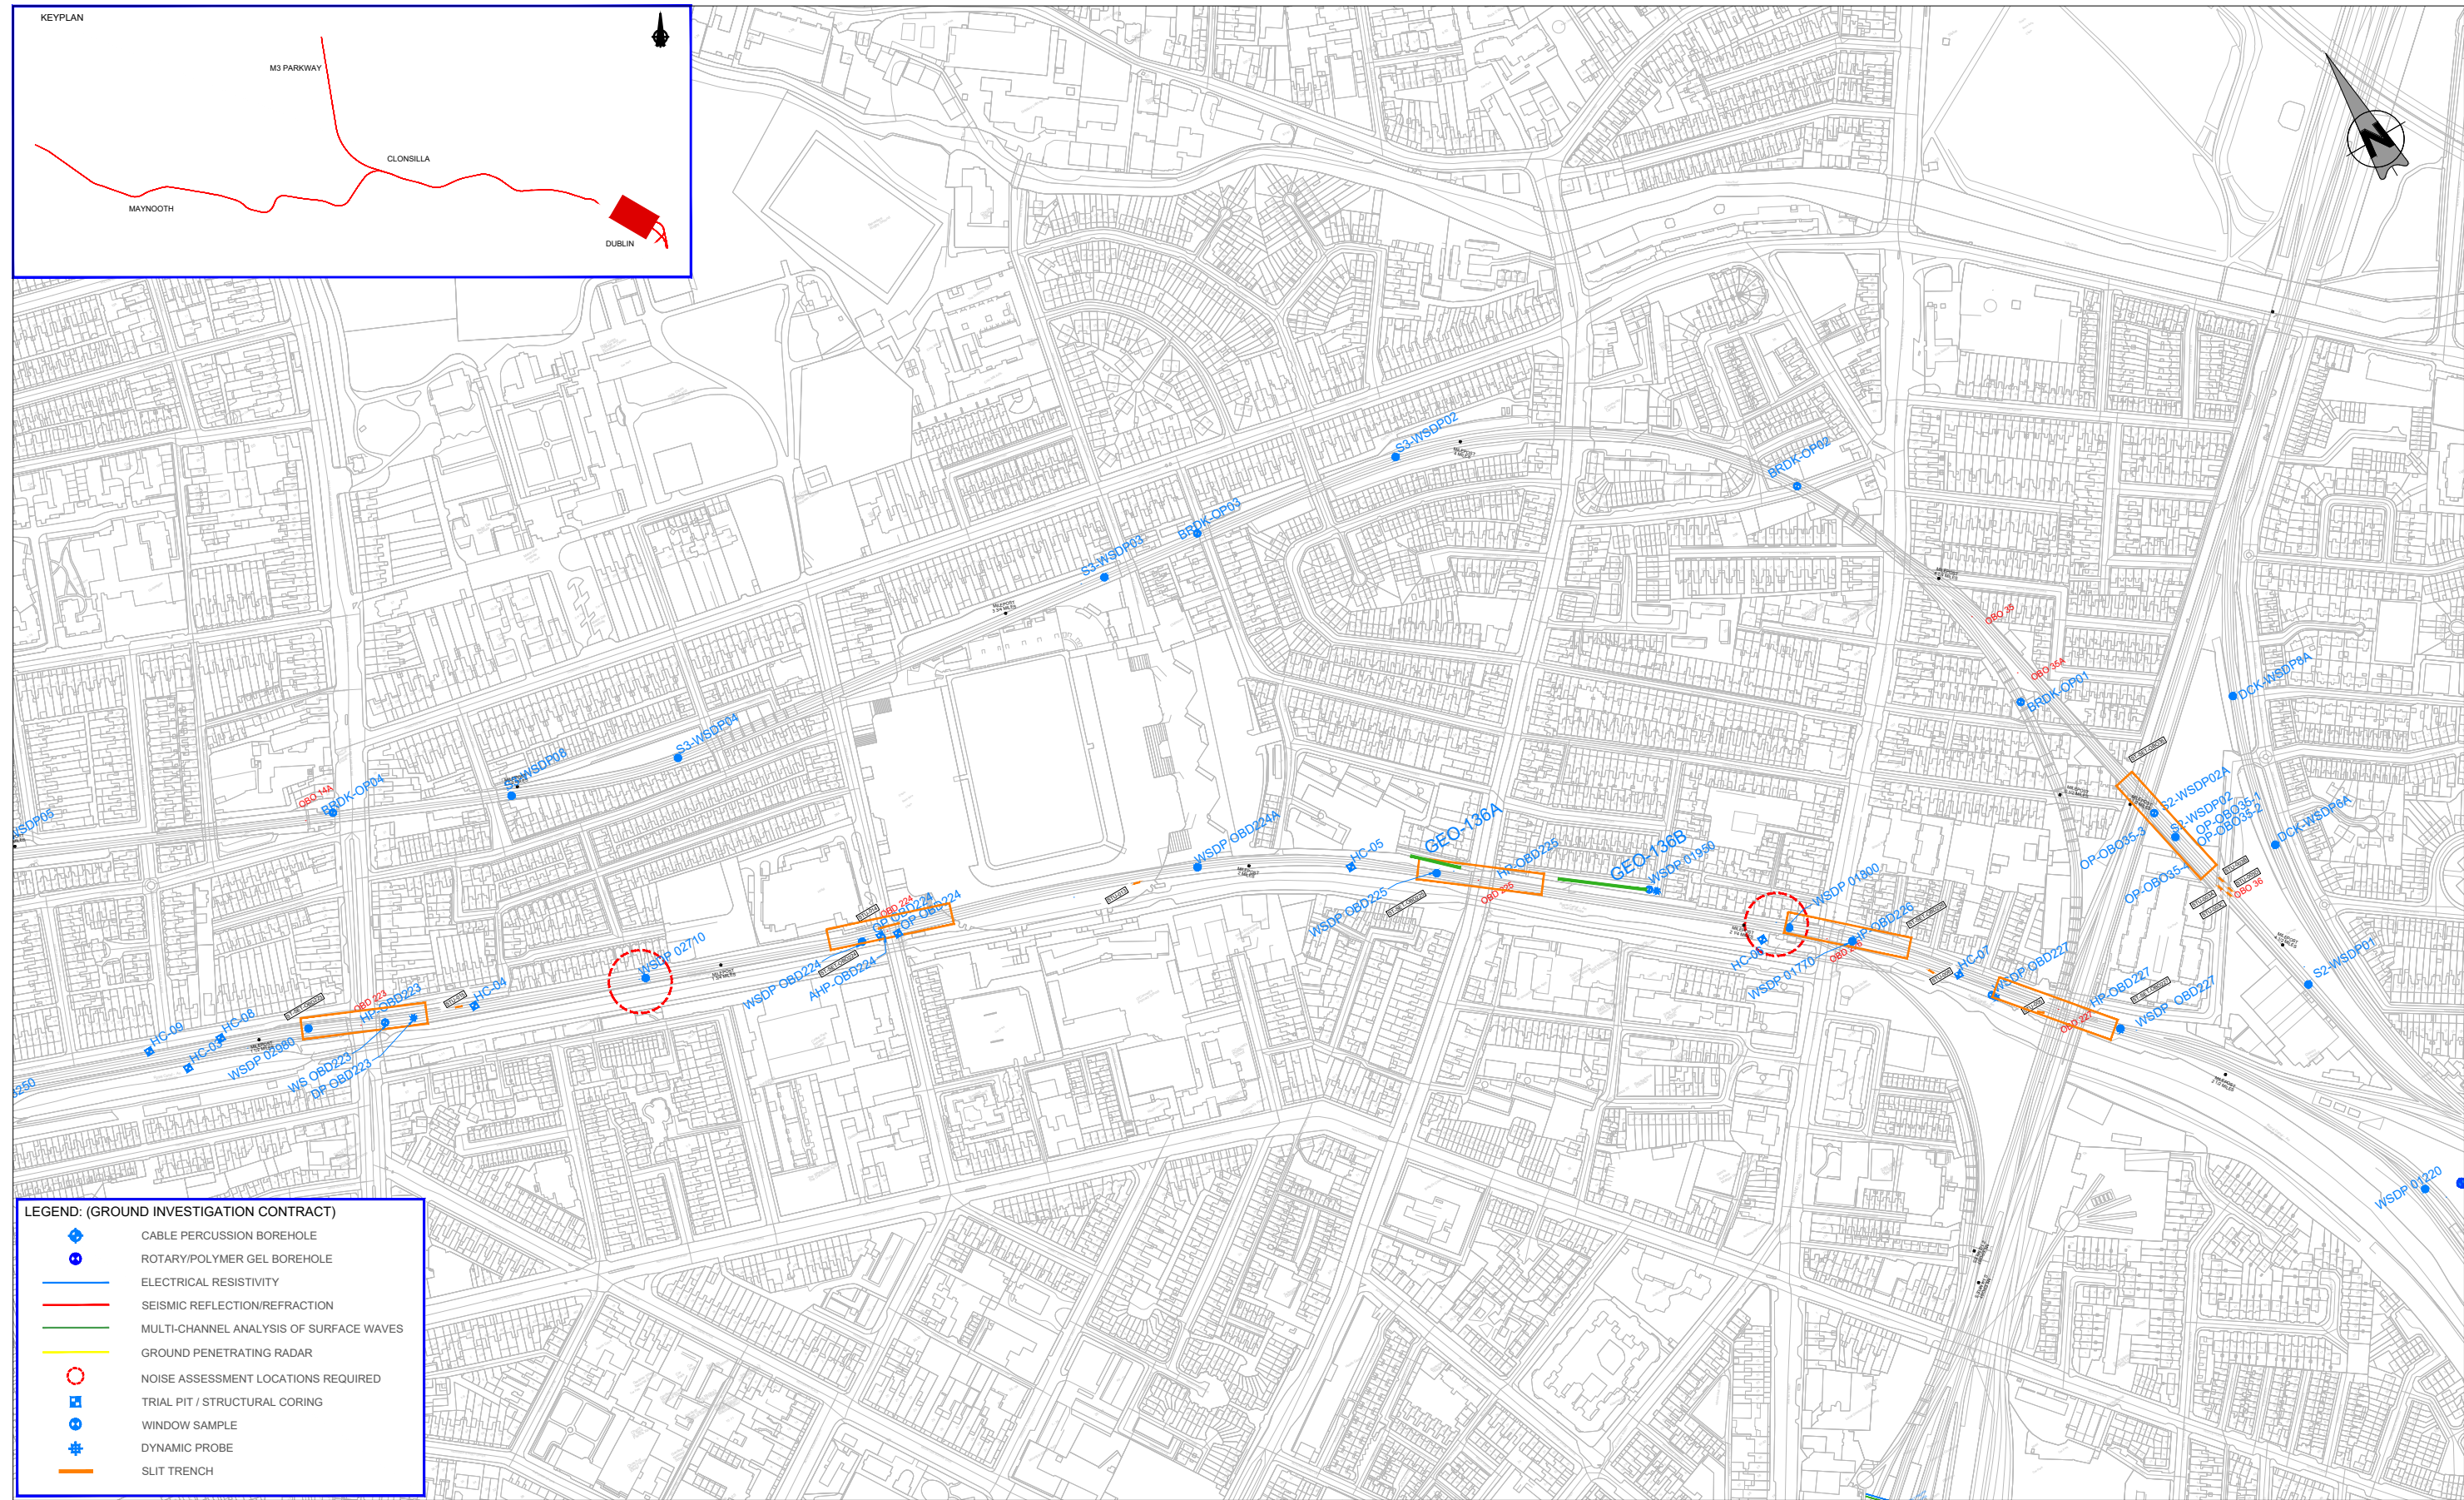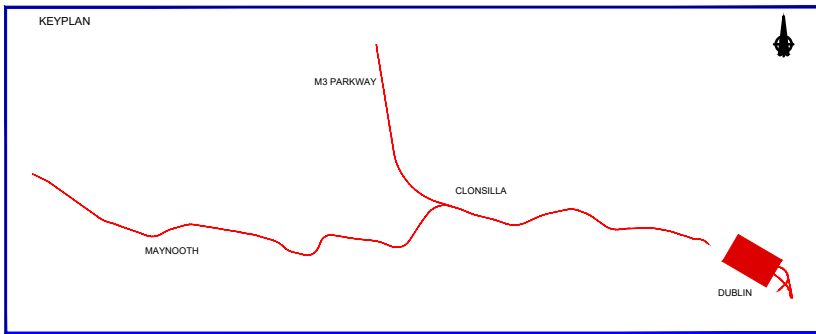

LEGEND: (GROUND INVESTIGATION CONTRACT)

- CABLE PERCUSSION BOREHOLE
- ROTARY/POLYMER GEL BOREHOLE
- ELECTRICAL RESISTIVITY
- SEISMIC REFLECTION/REFRACTION
- MULTI-CHANNEL ANALYSIS OF SURFACE WAVES
- GROUND PENETRATING RADAR
- NOISE ASSESSMENT LOCATIONS REQUIRED
- TRIAL PIT / STRUCTURAL CORING
- WINDOW SAMPLE
- DYNAMIC PROBE
- SLIT TRENCH

REV	DATE	DESCRIPTION	MAH	MAH	MK
V01	May 2022	PLANNING ISSUE			
<small>© Irish Rail (2021). This drawing is confidential and the copyright in it is owned by Irish Rail. This drawing must not be either loaned, copied or otherwise reproduced in whole or in part or used for any purpose without the prior permission of Irish Rail. © Ordnance Survey Ireland and Government of Ireland. All O.S. data used for plans are printed under "Copyright Ordnance Survey Ireland". Survey No. 0039721 (OSI Aerial Data or OSI Lidar Data) & Survey No. 2021/051_NMA_180 (OSI Vector Data). All elevations are in metres and relate to OSI Geoid Model (OSGM02) Mean Head as defined by existing Project Control. All Co-ordinates are in Irish Transverse Mercator Grid (ITM) as defined by OSI active GPS station Tallaght College (TLLG).</small>					

Client

Project

Consultant



Drawing Title

GROUND INVESTIGATION AS-BUILT LOCATIONS SHEET 2

Scale: 1:2,500 @ A1 1:5,000 @ A3

Drawing Number | Project | Originator | Discipline | Location | Type | Role | Number | Phase
 MAY MDC GEO ROUT DR G 96002 D

Date: May 2022 | Job No: P/101086 | Status: F1 - Approved & Accepted | Rev: V 01 | Sheet: 02 of 24

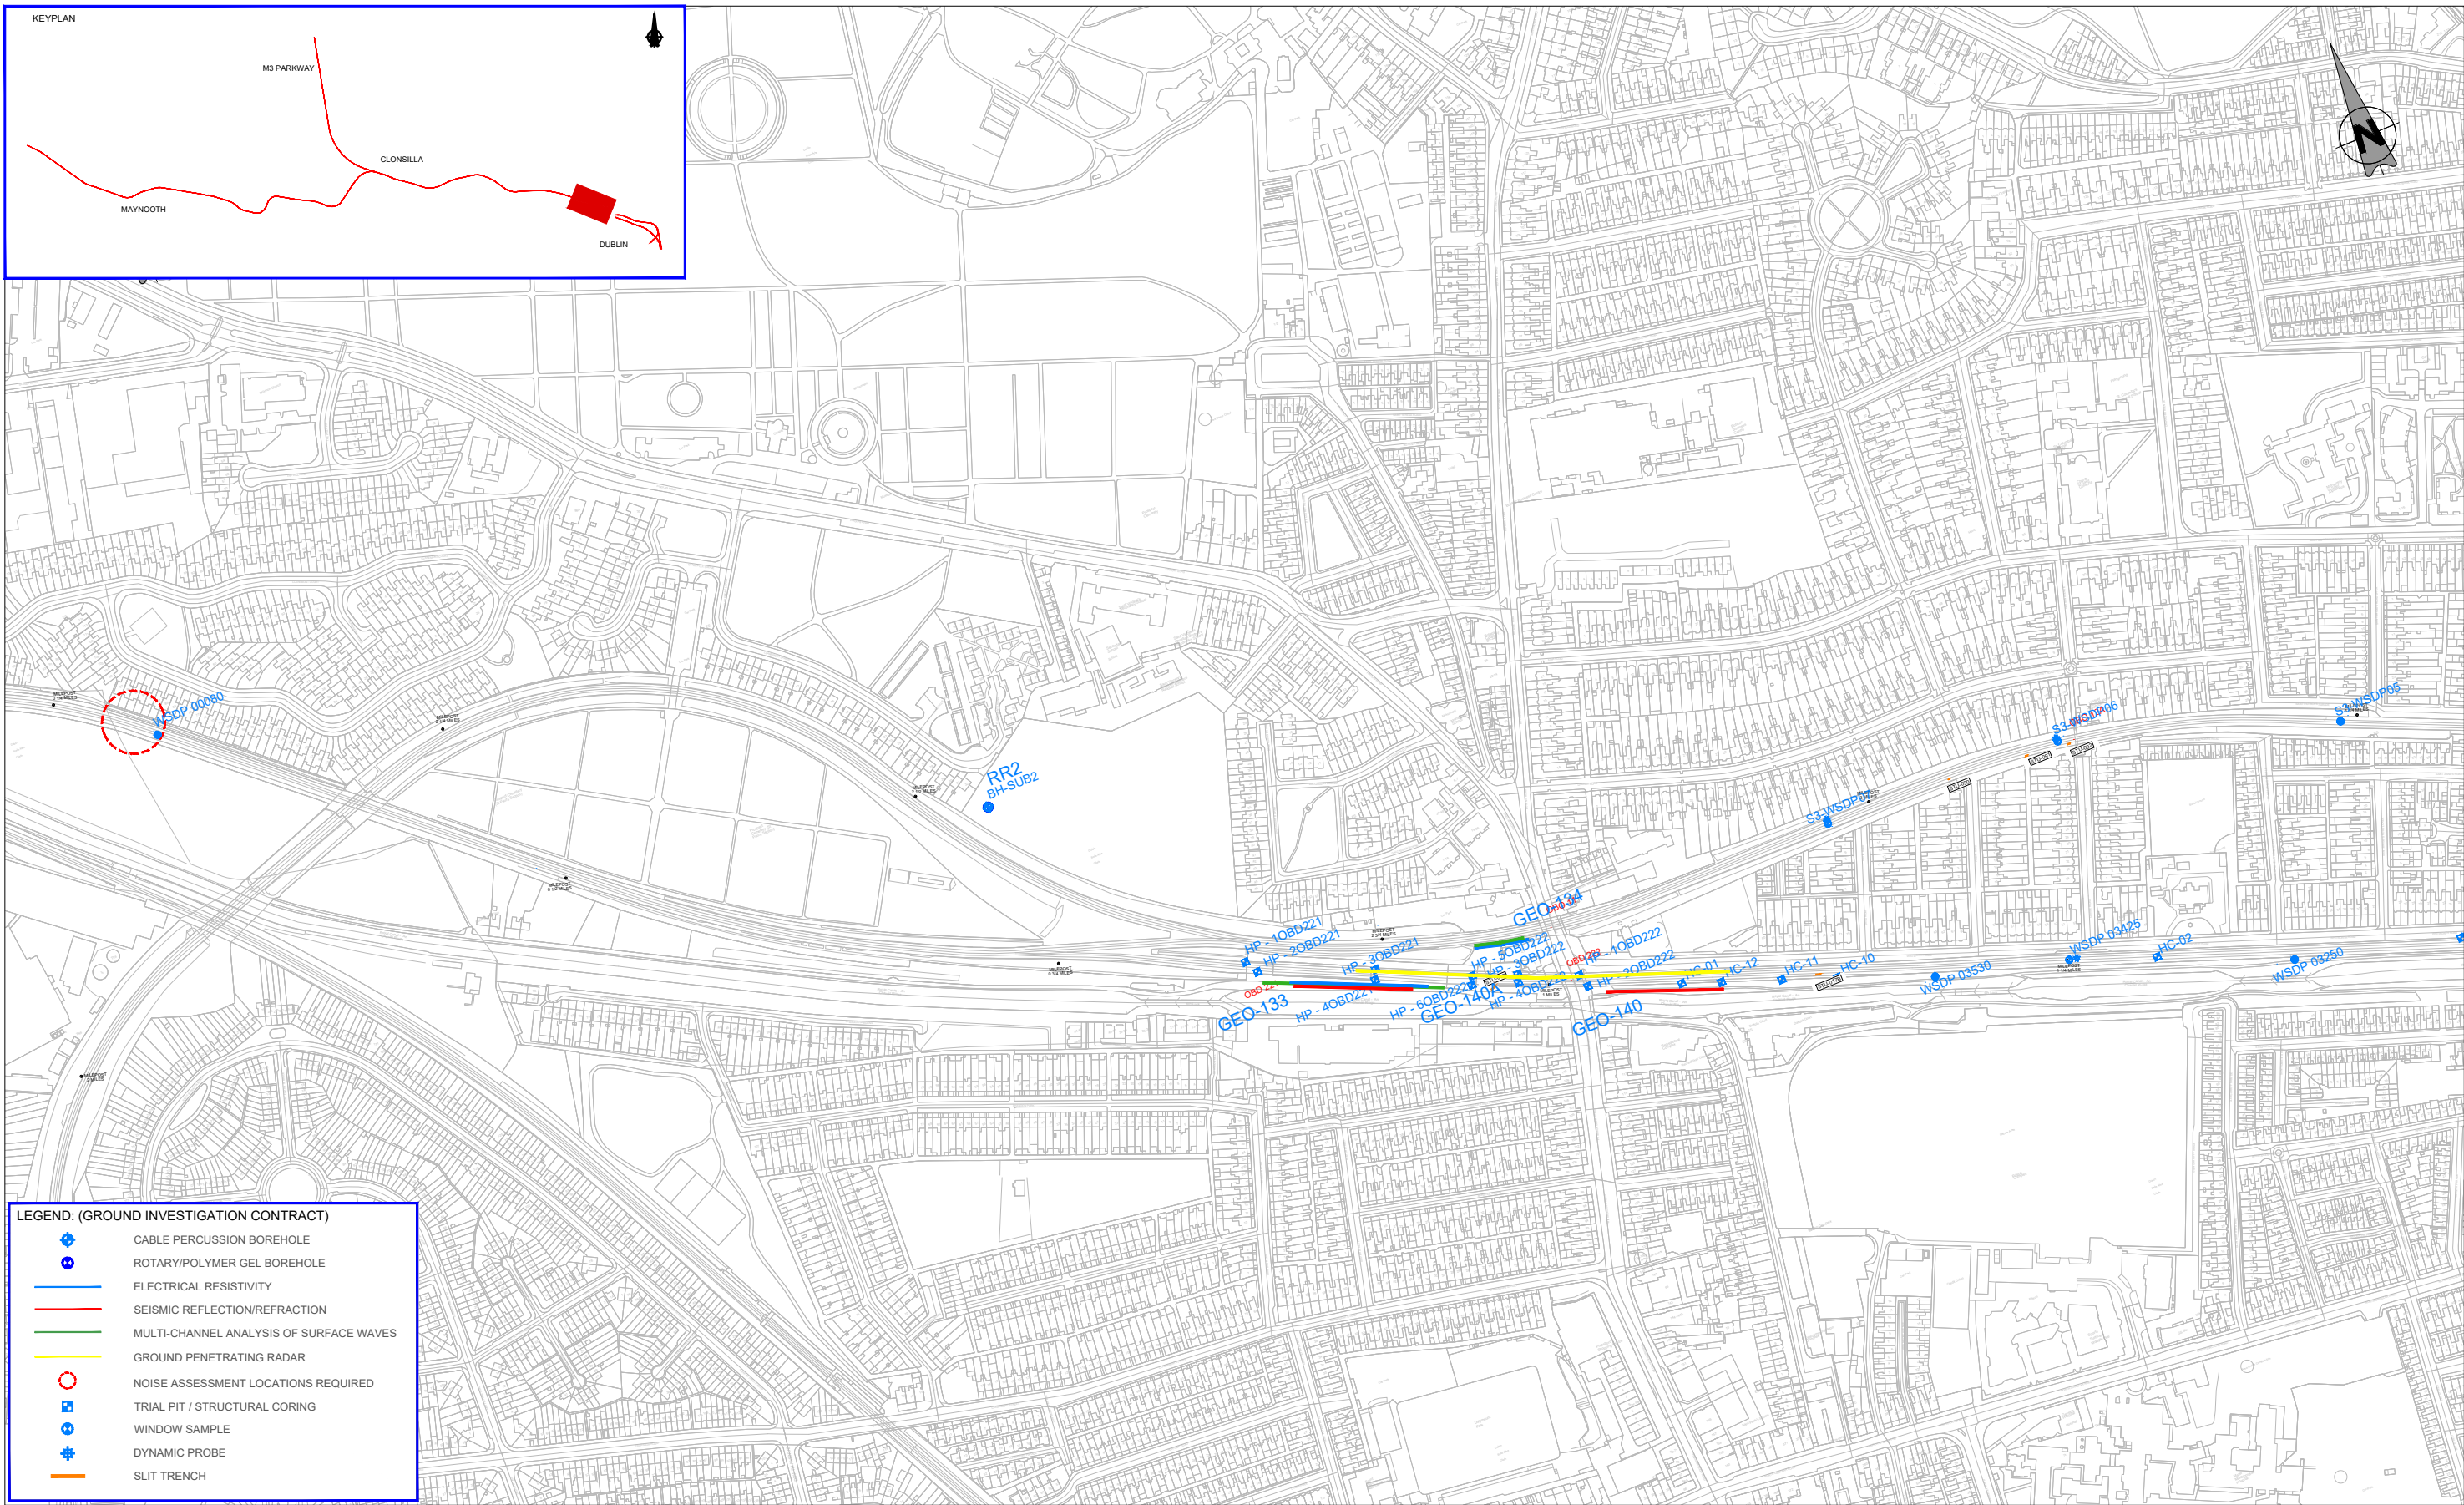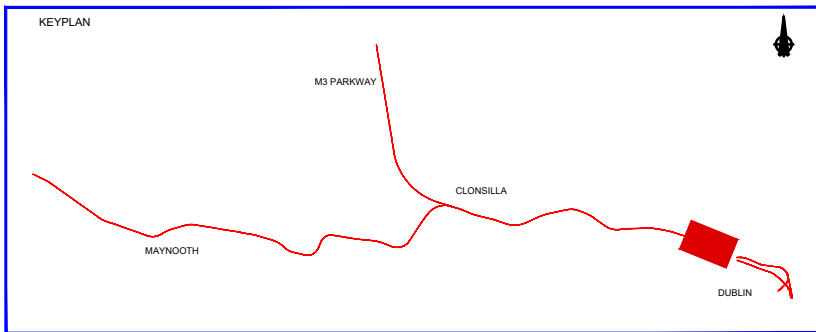

LEGEND: (GROUND INVESTIGATION CONTRACT)

- CABLE PERCUSSION BOREHOLE
- ROTARY/POLYMER GEL BOREHOLE
- ELECTRICAL RESISTIVITY
- SEISMIC REFLECTION/REFRACTION
- MULTI-CHANNEL ANALYSIS OF SURFACE WAVES
- GROUND PENETRATING RADAR
- NOISE ASSESSMENT LOCATIONS REQUIRED
- TRIAL PIT / STRUCTURAL CORING
- WINDOW SAMPLE
- DYNAMIC PROBE
- SLIT TRENCH

REV	DATE	DESCRIPTION	MAH	MAH	MK
V01	May 2022	PLANNING ISSUE			
PRODUCED BY			REVIEWED BY		
APPROVED BY					

© Irish Rail (2021). This drawing is confidential and the copyright in it is owned by Irish Rail. This drawing must not be either loaned, copied or otherwise reproduced in whole or in part or used for any purpose without the prior permission of Irish Rail.
 © Ordnance Survey Ireland and Government of Ireland. All O.S. data used for plans are printed under "Copyright Ordnance Survey Ireland".
 Survey No. 6039721 (OSi Aerial Data or OSi Lidar Data) & Survey No. 2021081_NMA_180 (OSi Vector Data).
 All elevations are in metres and relate to OSi Geoid Model (OSGM02) Mean Head as defined by existing Project Control.
 All Co-ordinates are in Irish Transverse Mercator Grid (ITM) as defined by OSi active GPS station Tallaght College (TLG0).

Client

Consultant

Project



Drawing Title

GROUND INVESTIGATION AS-BUILT LOCATIONS SHEET 3

Scale: 1:2,500 @ A1 1:5,000 @ A3

Drawing Number | Project | Originator | Discipline | Location | Type | Role | Number | Phase
 MAY MDC GEO ROUT DR G 96003 D

Date: May 2022 | Job No: P/101086 | Status: F1 - Approved & Accepted | Rev: V 01 | Sheet: 03 of 24

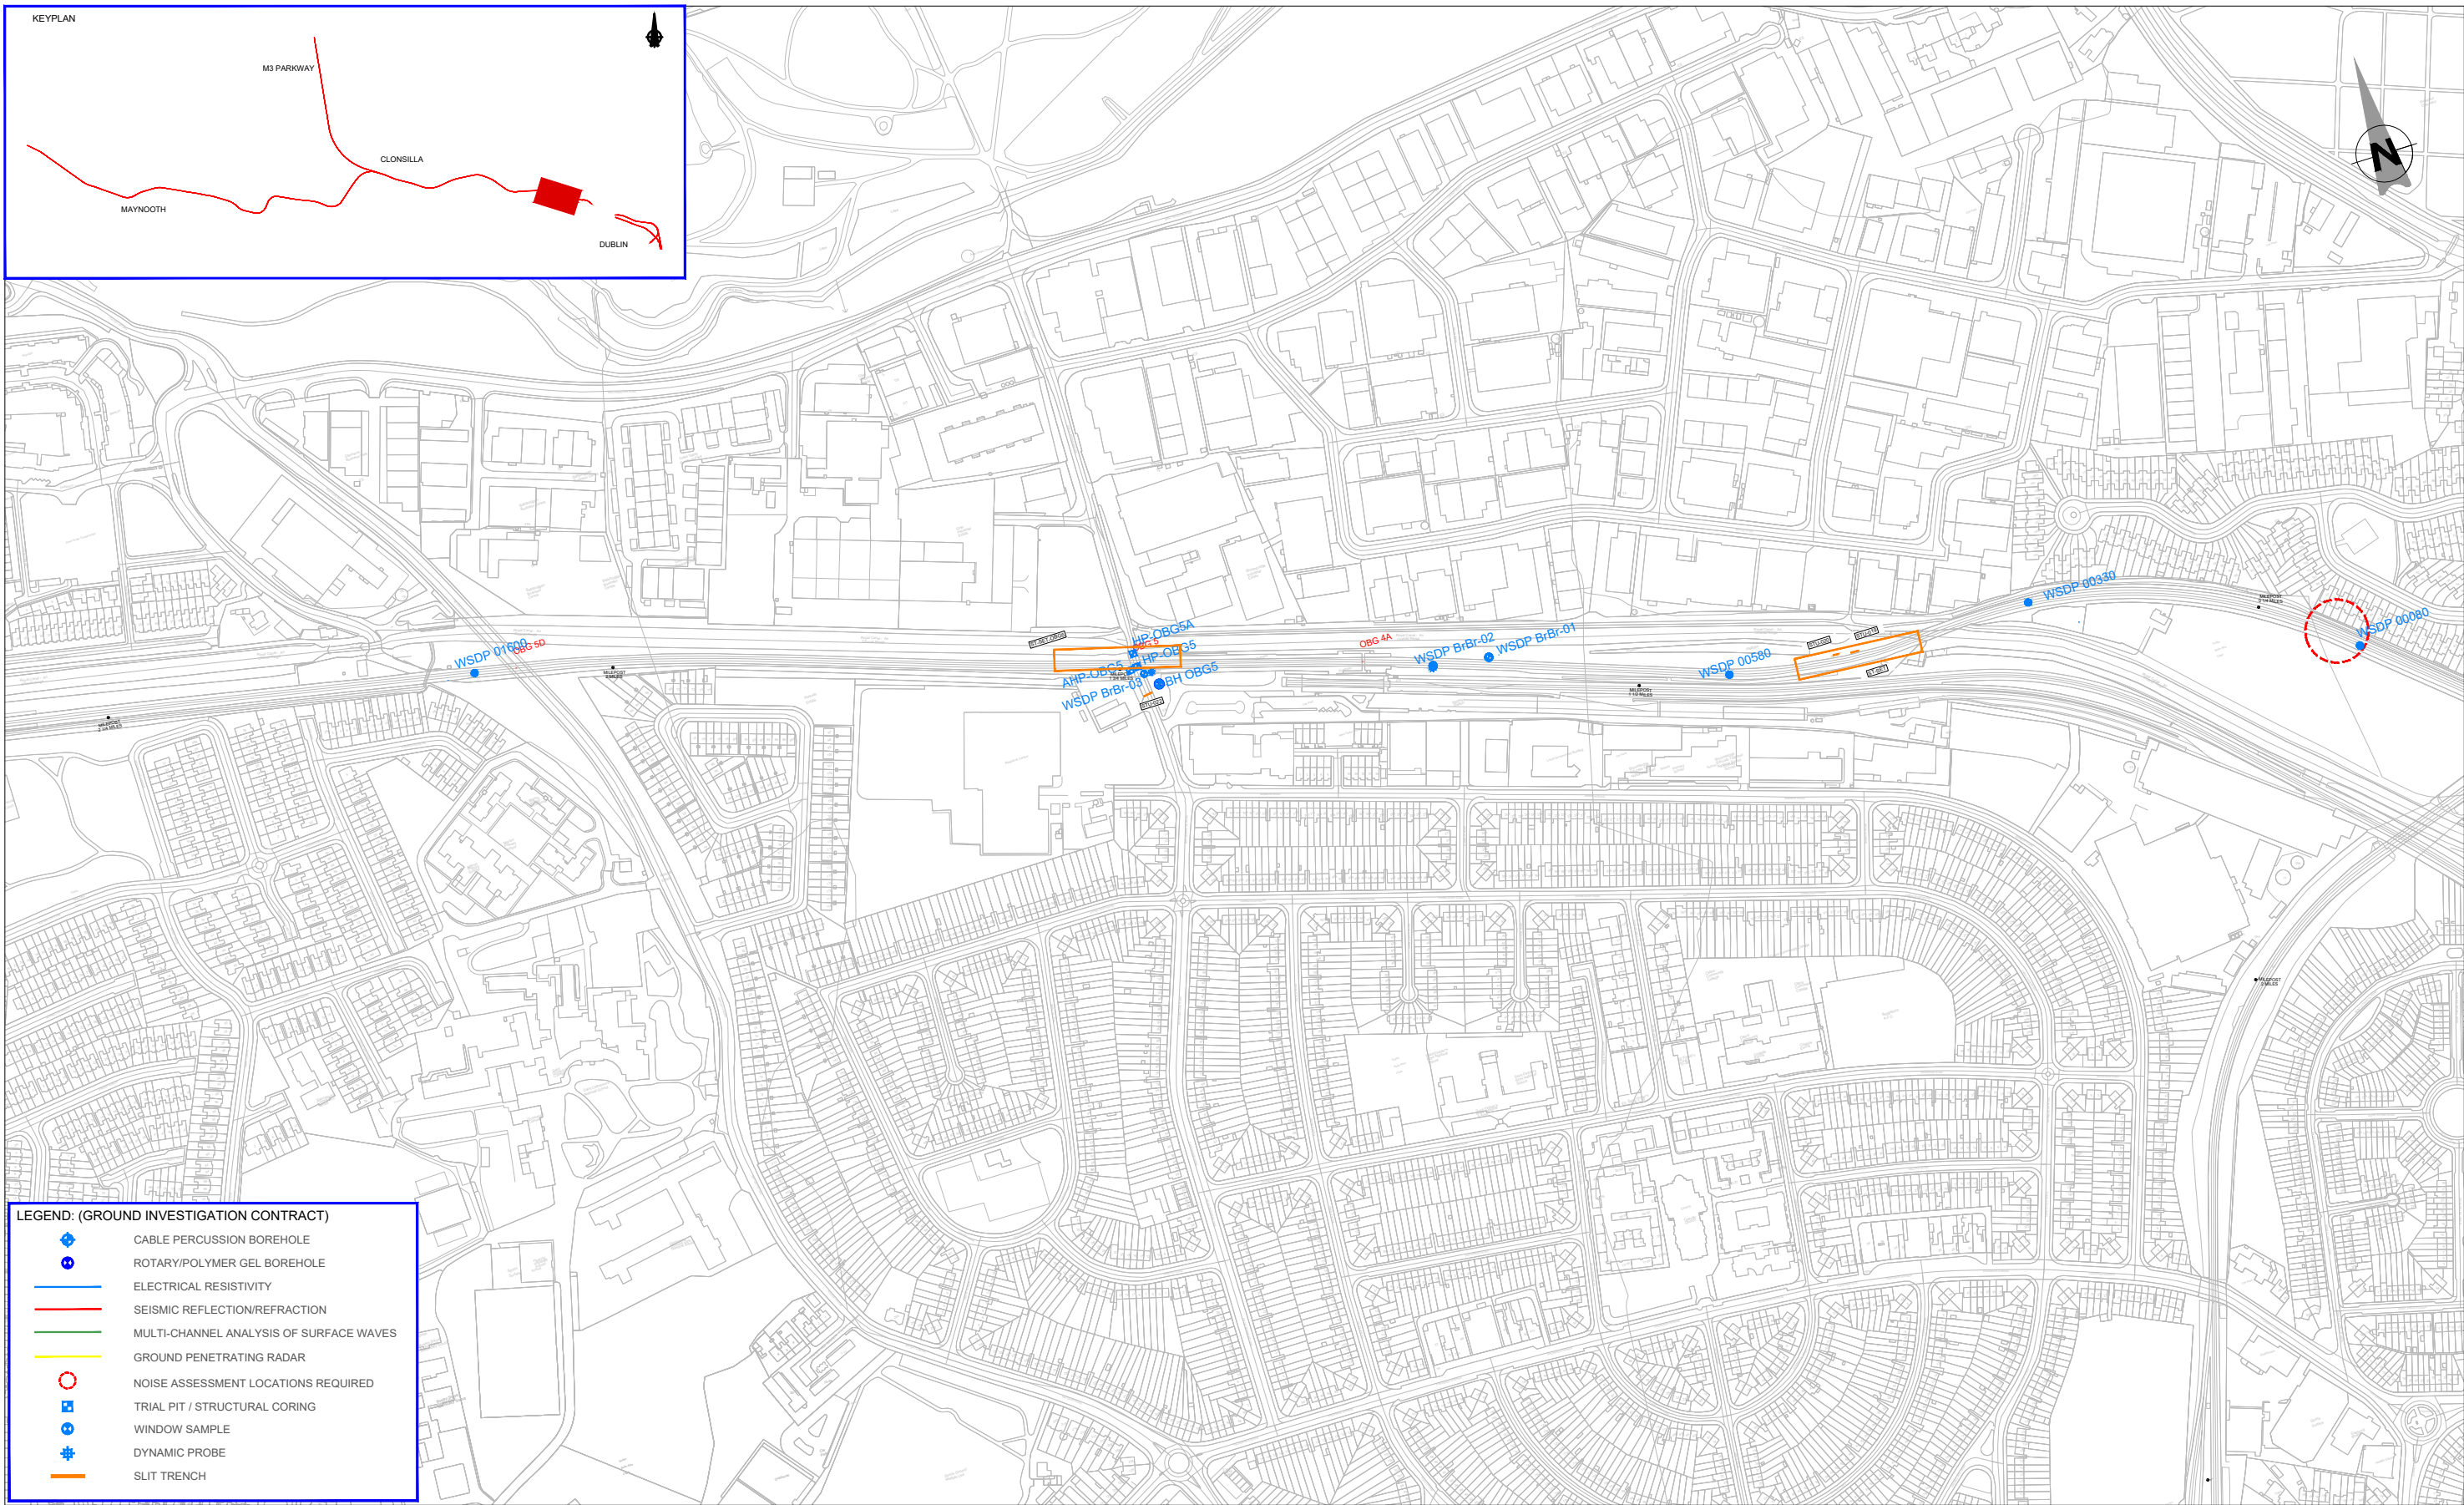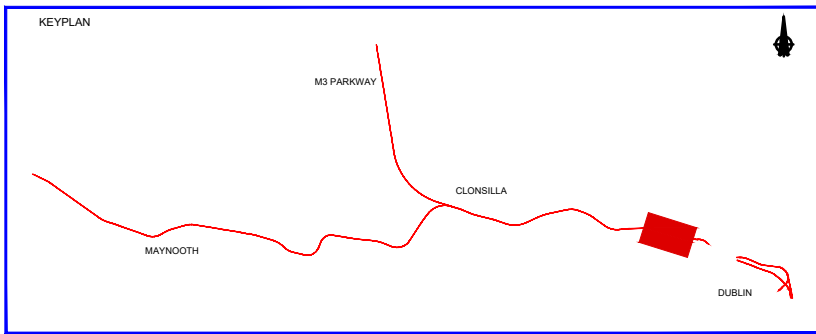

LEGEND: (GROUND INVESTIGATION CONTRACT)

- CABLE PERCUSSION BOREHOLE
- ROTARY/POLYMER GEL BOREHOLE
- ELECTRICAL RESISTIVITY
- SEISMIC REFLECTION/REFRACTION
- MULTI-CHANNEL ANALYSIS OF SURFACE WAVES
- GROUND PENETRATING RADAR
- NOISE ASSESSMENT LOCATIONS REQUIRED
- TRIAL PIT / STRUCTURAL CORING
- WINDOW SAMPLE
- DYNAMIC PROBE
- SLIT TRENCH

REV	DATE	DESCRIPTION	PRODUCED BY	REVIEWED BY	APPROVED BY
V01	May 2022	PLANNING ISSUE	MAH	MAH	MK

© Irish Rail (2021). This drawing is confidential and the copyright in it is owned by Irish Rail. This drawing must not be either loaned, copied or otherwise reproduced in whole or in part or used for any purpose without the prior permission of Irish Rail.
 © Ordnance Survey Ireland and Government of Ireland. All O.S. data used for plans are printed under "Copyright Ordnance Survey Ireland".
 Survey No. 0039721 (OS Aerial Data or OS Lidar Data) & Survey No. 2021/081_NMA_100 (OS Vector Data).
 All elevations are in metres and relate to OS Geoid Model (OSGM02) Mean Head as defined by existing Project Control.
 All Co-ordinates are in Irish Transverse Mercator Grid (ITM) as defined by OSi active GPS station Tallaght College (TLG0).

Client

Consultant

Project



Drawing Title

GROUND INVESTIGATION AS-BUILT LOCATIONS SHEET 4

Scale: 1:2,500 @ A1 1:5,000 @ A3

Drawing Number | Project | Originator | Discipline | Location | Type | Role | Number | Phase
 MAY MDC GEO ROUT DR G 96004 D

Date: May 2022 | Job No: P/101086 | Status: F1 - Approved & Accepted | Rev: V 01 | Sheet: 04 of 24

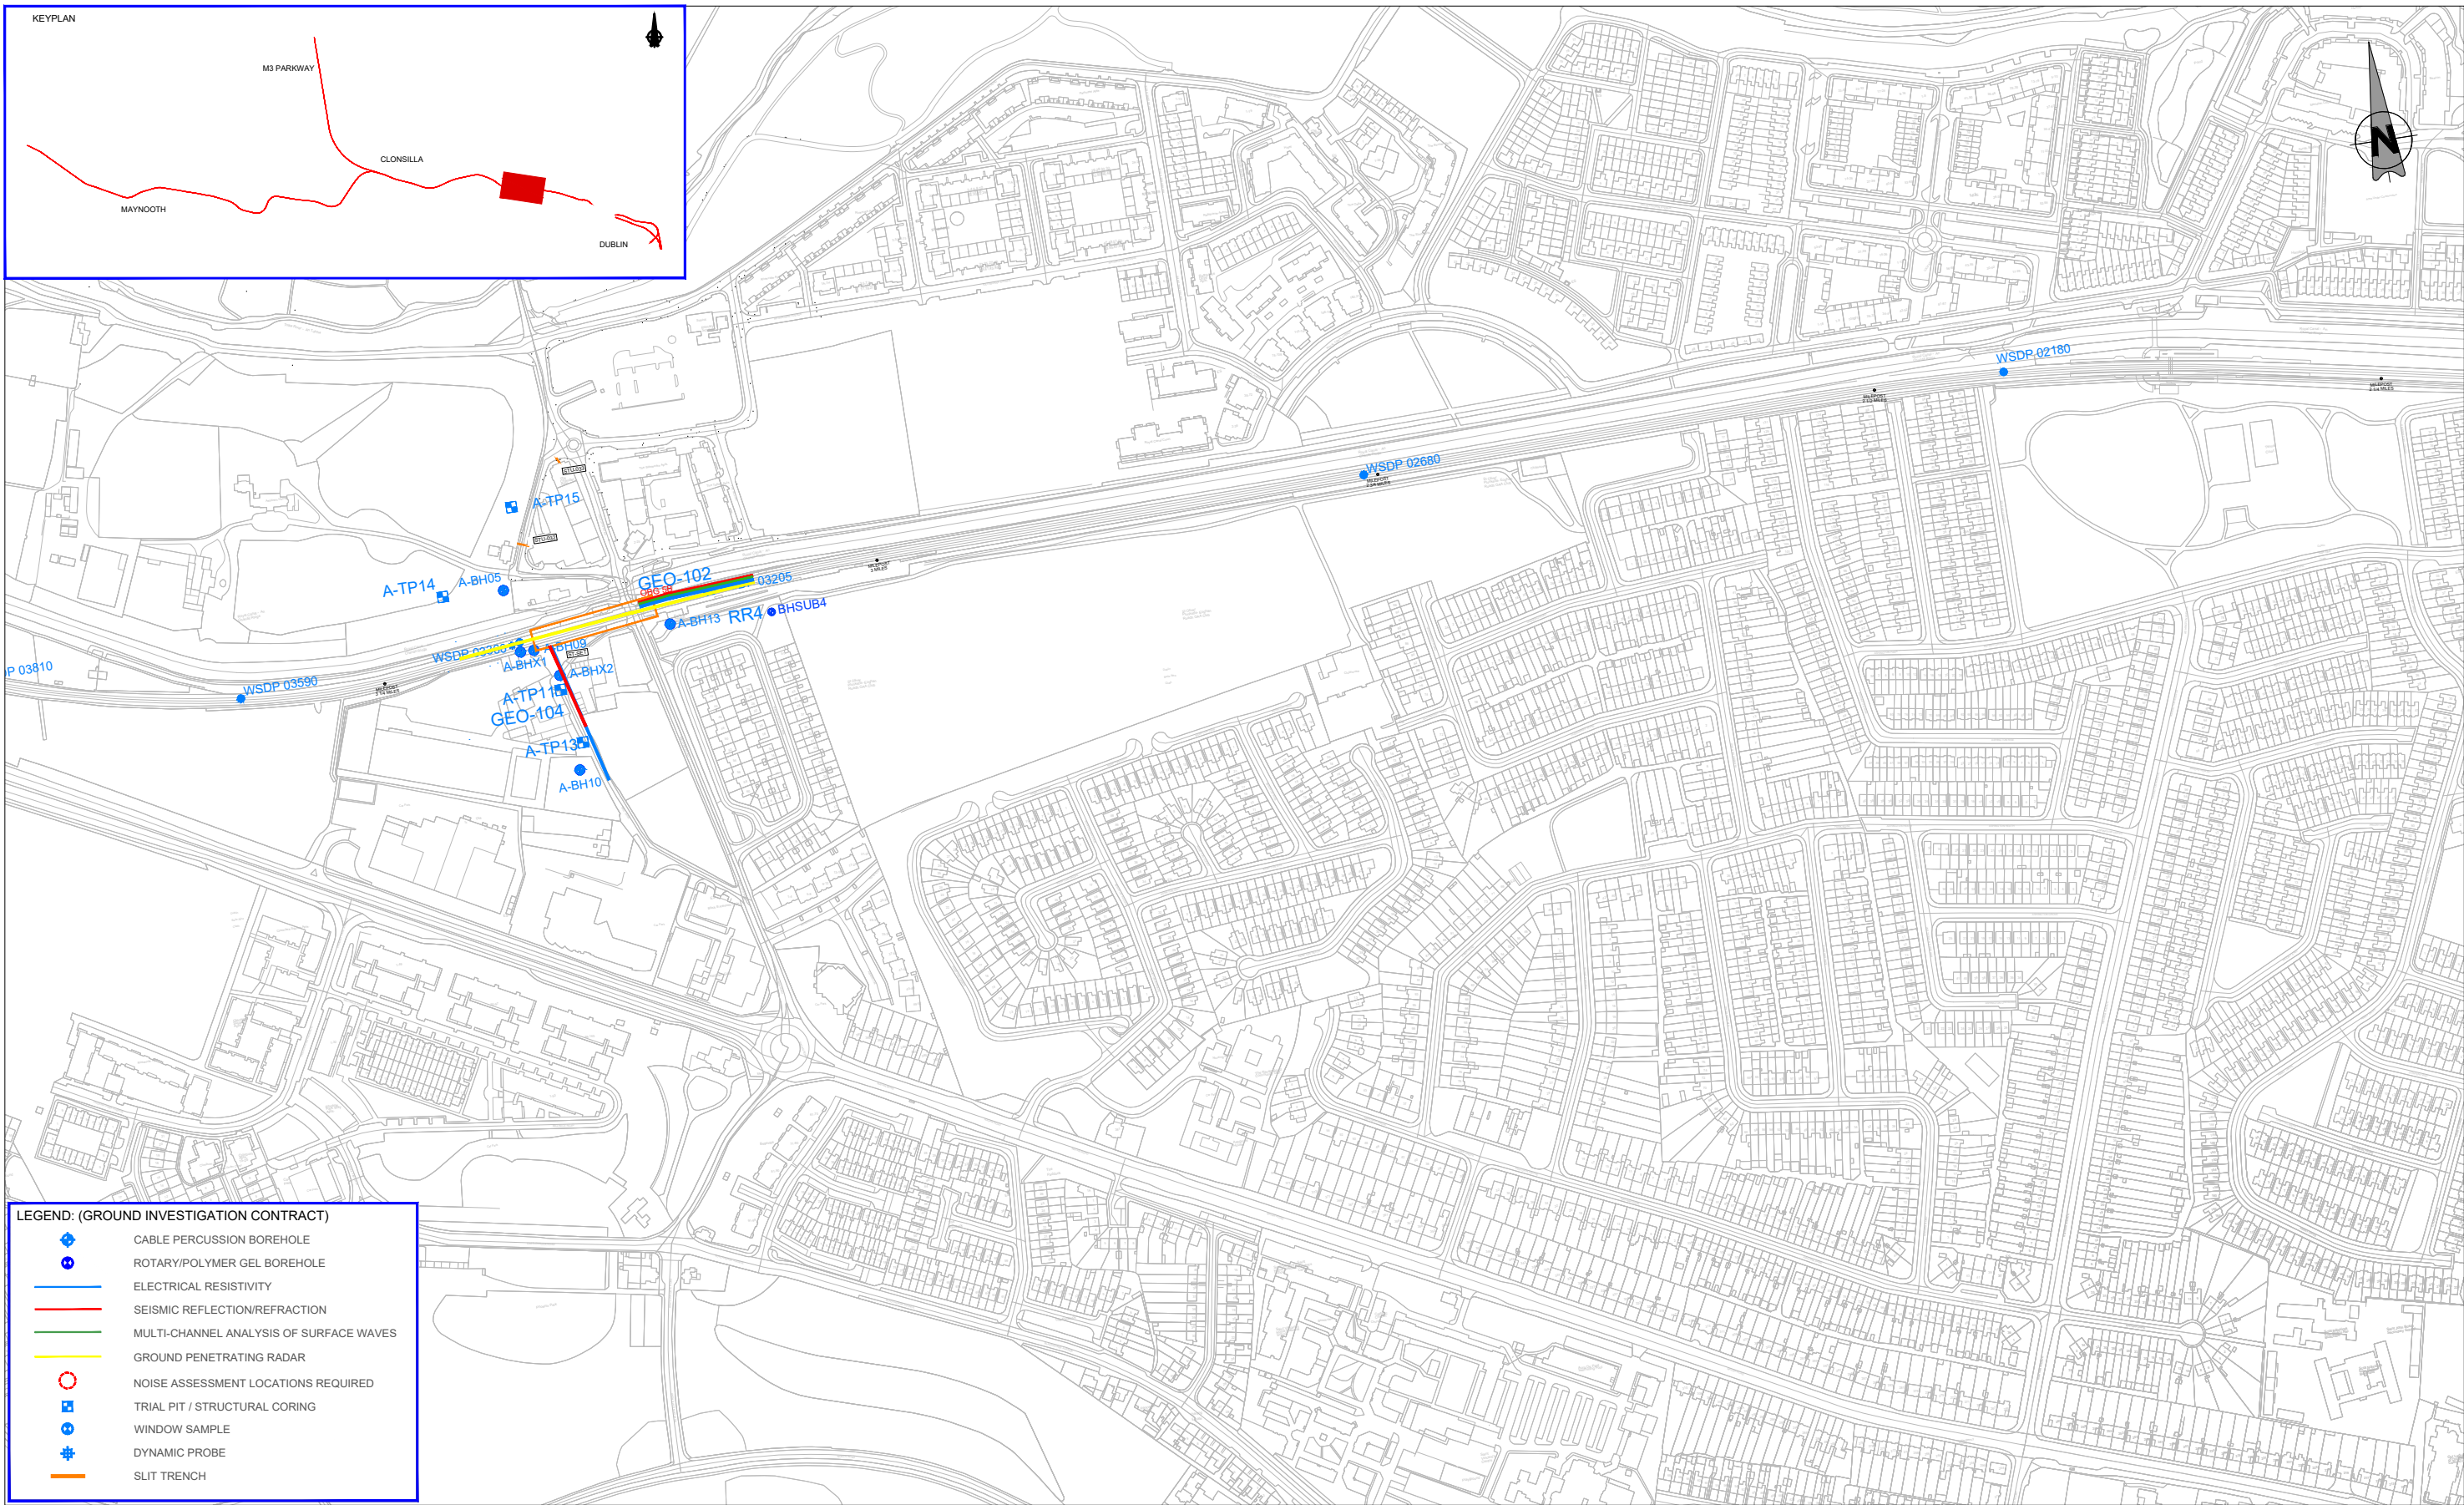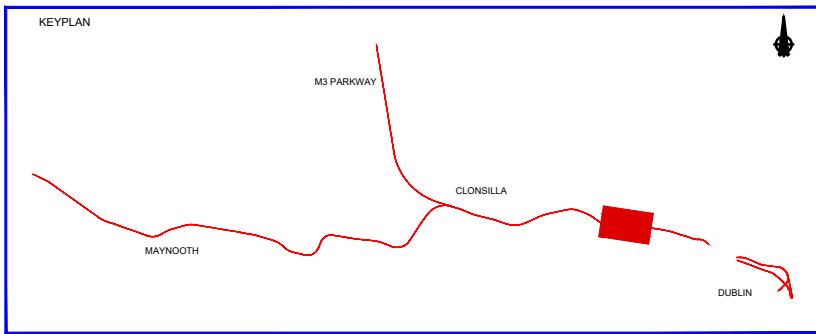

LEGEND: (GROUND INVESTIGATION CONTRACT)

- CABLE PERCUSSION BOREHOLE
- ROTARY/POLYMER GEL BOREHOLE
- ELECTRICAL RESISTIVITY
- SEISMIC REFLECTION/REFRACTION
- MULTI-CHANNEL ANALYSIS OF SURFACE WAVES
- GROUND PENETRATING RADAR
- NOISE ASSESSMENT LOCATIONS REQUIRED
- TRIAL PIT / STRUCTURAL CORING
- WINDOW SAMPLE
- DYNAMIC PROBE
- SLIT TRENCH

REV	DATE	DESCRIPTION	MAH	MAH	MK
V01	May 2022	PLANNING ISSUE			
PRODUCED BY			REVIEWED BY		
APPROVED BY					

© Irish Rail (2021). This drawing is confidential and the copyright in it is owned by Irish Rail. This drawing must not be either loaned, copied or otherwise reproduced in whole or in part or in any form without the prior permission of Irish Rail.
 © Ordnance Survey Ireland and Government of Ireland. All O.S. data used for plans are printed under "Copyright Ordnance Survey Ireland".
 Survey No. 0039721 (OSi Aerial Data or OSi Lidar Data) & Survey No. 2021/081_NMA_180 (OSi Vector Data).
 All elevations are in metres and relate to OSi Geoid Model (OSGM02) Mean Head as defined by existing Project Control.
 All Co-ordinates are in Irish Transverse Mercator Grid (ITM) as defined by OSi active GPS station Tallaght College (TLG0).

Client

Consultant

Project



Drawing Title

GROUND INVESTIGATION AS-BUILT LOCATIONS SHEET 5

Scale: 1:2,500 @ A1 1:5,000 @ A3

Drawing Number | Project | Originator | Discipline | Location | Type | Role | Number | Phase
 MAY MDC GEO ROUT DR G 96005 D

Date: May 2022 Job No: P/101086 Status: F1 - Approved & Accepted Rev: V 01 Sheet: 05 of 24

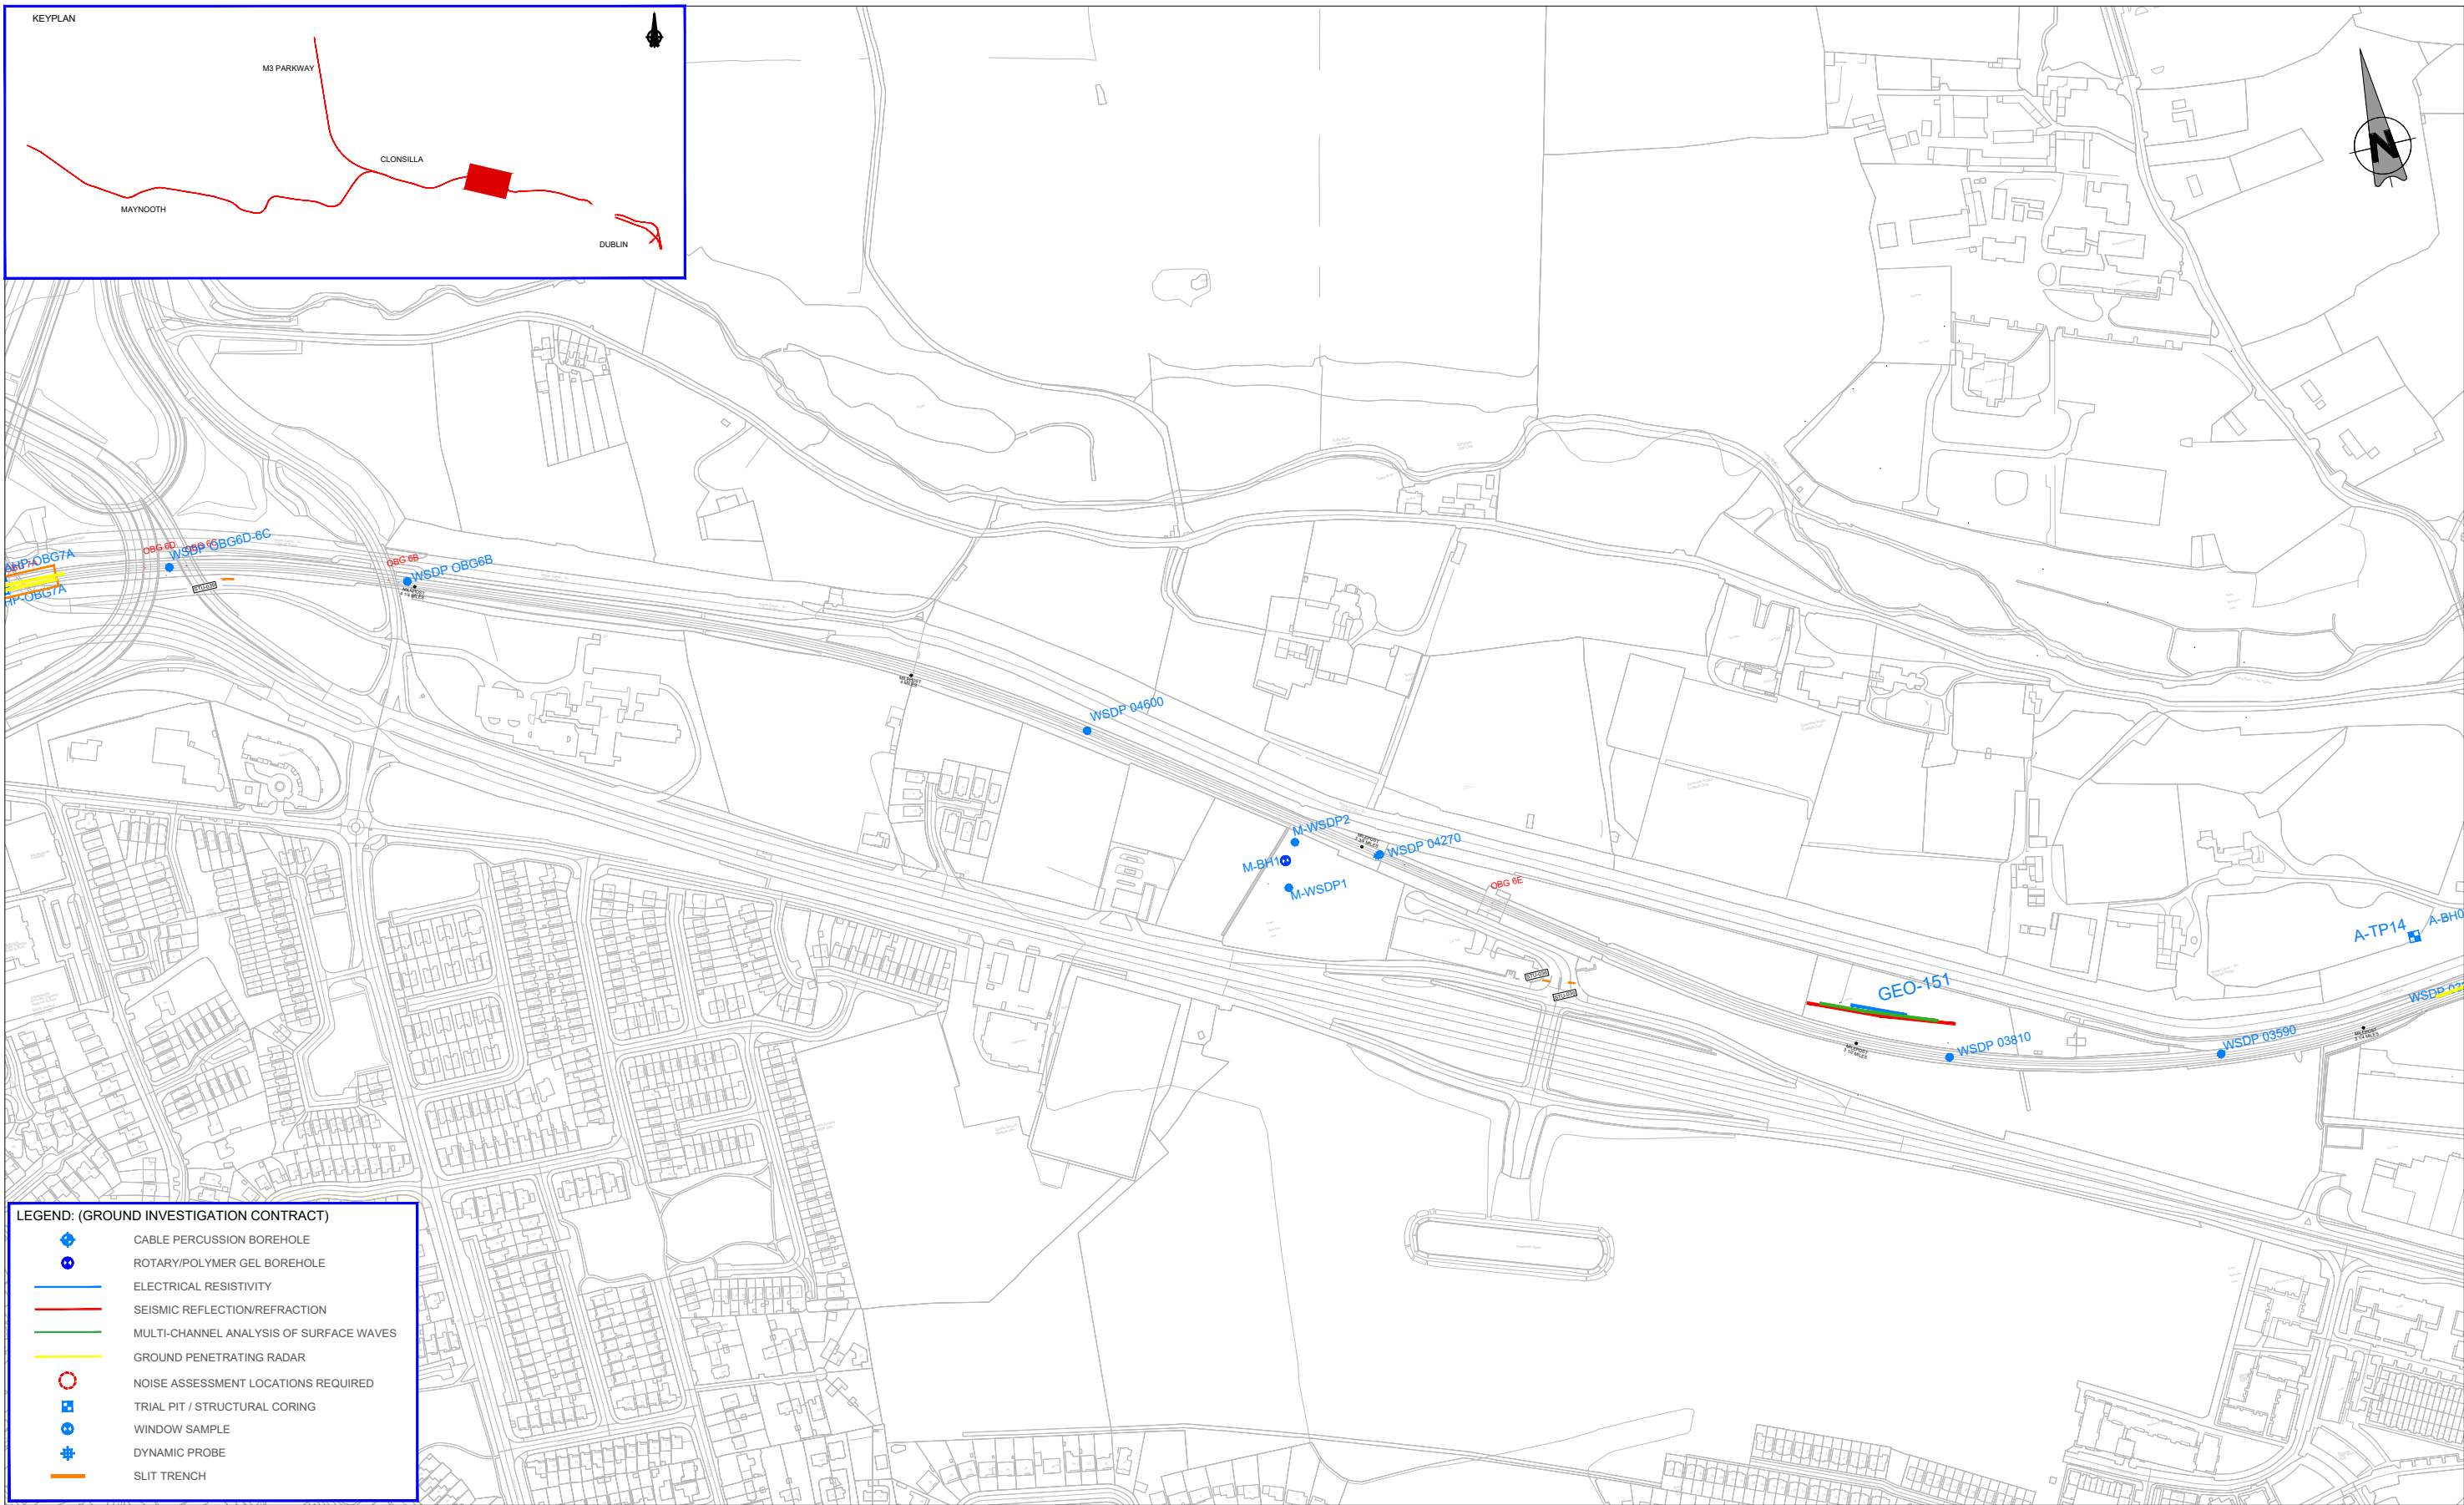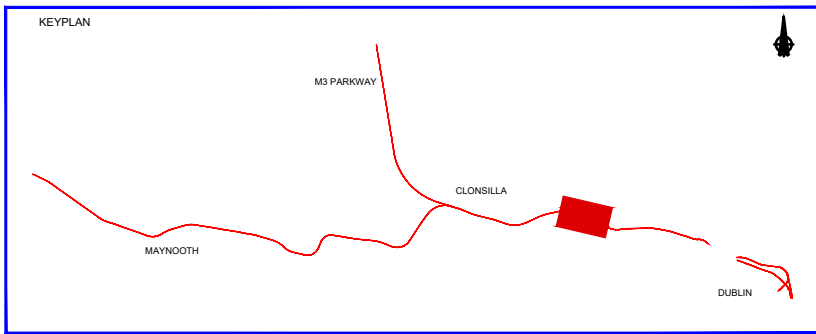

LEGEND: (GROUND INVESTIGATION CONTRACT)

- CABLE PERCUSSION BOREHOLE
- ROTARY/POLYMER GEL BOREHOLE
- ELECTRICAL RESISTIVITY
- SEISMIC REFLECTION/REFRACTION
- MULTI-CHANNEL ANALYSIS OF SURFACE WAVES
- GROUND PENETRATING RADAR
- NOISE ASSESSMENT LOCATIONS REQUIRED
- TRIAL PIT / STRUCTURAL CORING
- WINDOW SAMPLE
- DYNAMIC PROBE
- SLIT TRENCH

REV	DATE	DESCRIPTION	MAH	MAH	MK
V01	May 2022	PLANNING ISSUE			
<small>© Irish Rail (2021). This drawing is confidential and the copyright in it is owned by Irish Rail. This drawing must not be either loaned, copied or otherwise reproduced in whole or in part or used for any purpose without the prior permission of Irish Rail. © Ordnance Survey Ireland and Government of Ireland. All O.S. data used for plans are printed under "Copyright Ordnance Survey Ireland". Survey No. 0039721 (OSi Aerial Data or OSi Lidar Data) & Survey No. 2021/OSI_NMA_180 (OSi Vector Data). All elevations are in metres and relate to OSi Geoid Model (OSGM02) Mean Head as defined by existing Project Contract. All Co-ordinates are in Irish Transverse Mercator Grid (ITM) as defined by OSi active GPS station Tallaght College (TLG0).</small>					

Client

Consultant

Project




Drawing Title

GROUND INVESTIGATION AS-BUILT LOCATIONS SHEET 6

Scale: 1:2,500 @ A1 1:5,000 @ A3

Drawing Number | Project | Originator | Discipline | Location | Type | Role | Number | Phase
 MAY MDC GEO ROUT DR G 96006 D

Date: May 2022 | Job No: P/101086 | Status: F1 - Approved & Accepted | Rev: V 01 | Sheet: 06 of 24

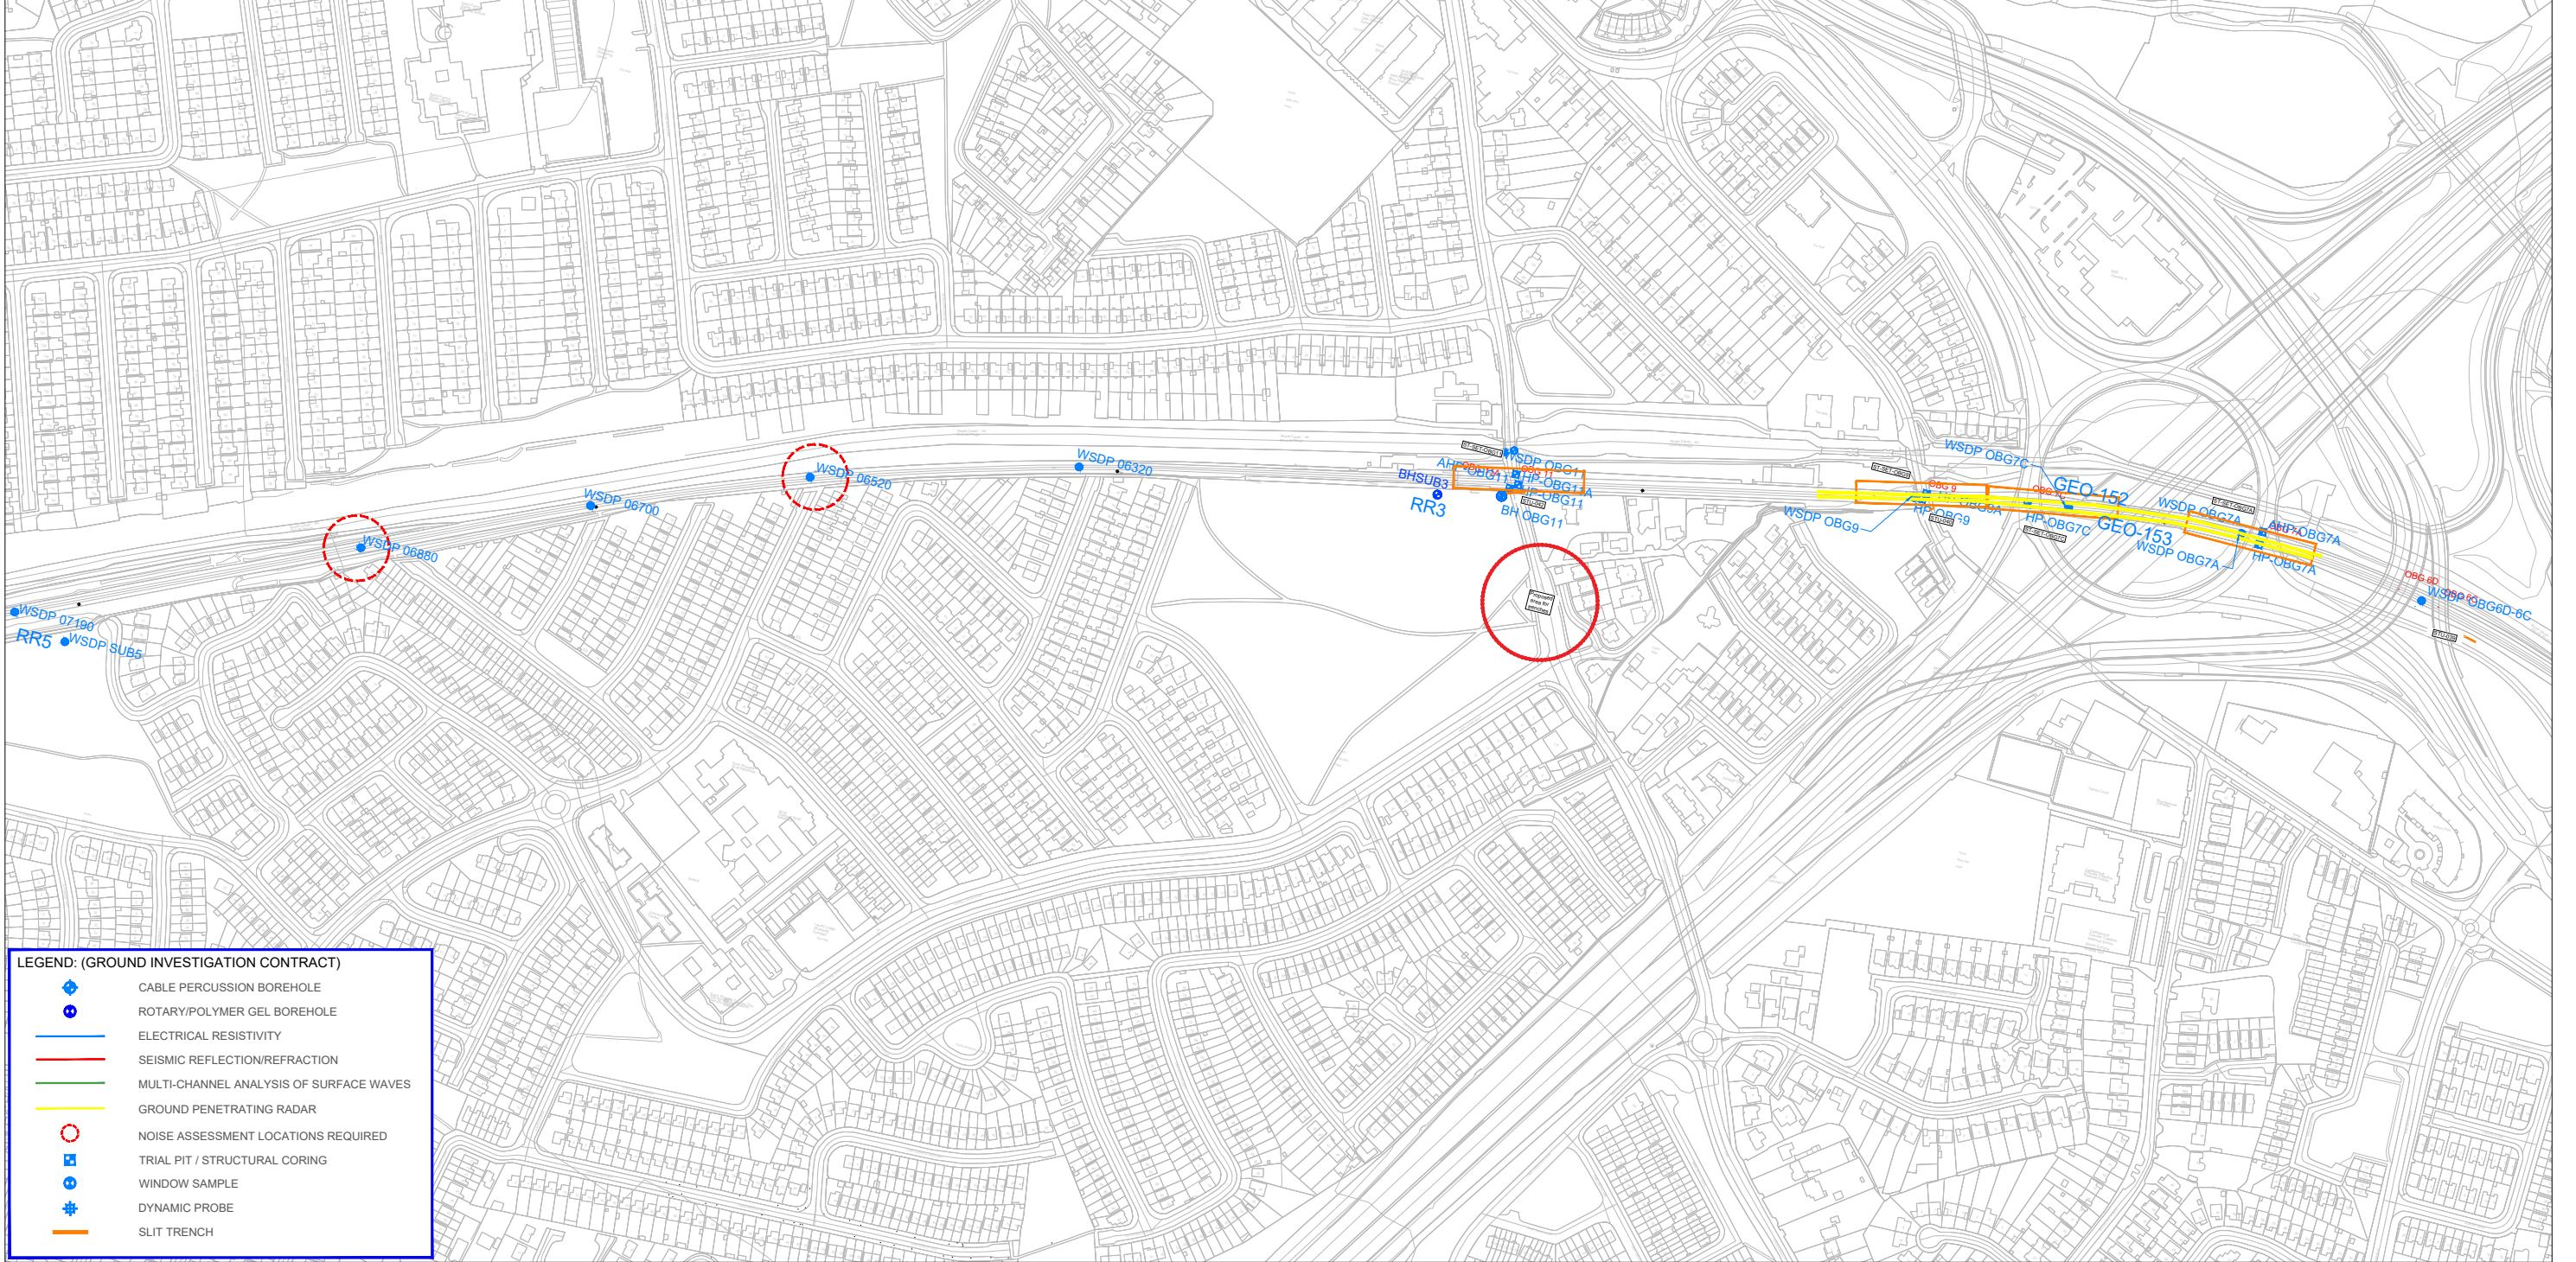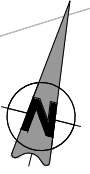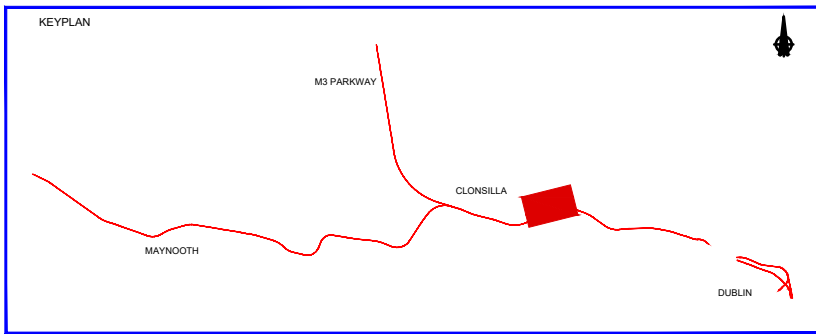

LEGEND: (GROUND INVESTIGATION CONTRACT)

- CABLE PERCUSSION BOREHOLE
- ROTARY/POLYMER GEL BOREHOLE
- ELECTRICAL RESISTIVITY
- SEISMIC REFLECTION/REFRACTION
- MULTI-CHANNEL ANALYSIS OF SURFACE WAVES
- GROUND PENETRATING RADAR
- NOISE ASSESSMENT LOCATIONS REQUIRED
- TRIAL PIT / STRUCTURAL CORING
- WINDOW SAMPLE
- DYNAMIC PROBE
- SLIT TRENCH

REV.	DATE	DESCRIPTION	MAH	MAH	MK
V01	May 2022	PLANNING ISSUE			

PRODUCED BY MAH | REVIEWED BY MAH | APPROVED BY MK

© Irish Rail (2021). This drawing is confidential and the copyright in it is owned by Irish Rail. This drawing must not be either loaned, copied or otherwise reproduced in whole or in part or used for any purpose without the prior permission of Irish Rail.
 © Ordnance Survey Ireland and Government of Ireland. All O.S. data used for plans are printed under 'Copyright Ordnance Survey Ireland'.
 Survey No. 6039721 (OSi Aerial Data or OSi Lidar Data) & Survey No. 2021081_NMA_180 (OSi Vector Data).
 All elevations are in metres and relate to OSi Geoid Model (OSGM02) Mean Head as defined by existing Project Control.
 All Co-ordinates are in Irish Transverse Mercator Grid (ITM) as defined by OSi active GPS station Tallaght College (TLG0).

Client:

Consultant:



Project:

Drawing Title: **GROUND INVESTIGATION AS-BUILT LOCATIONS SHEET 7**

Scale: 1:2,500 @ A1 1:5,000 @ A3

Drawing Number: MAY MDC GEO ROUT DR G 96007 D

Date: May 2022 | Job No: P/101086 | Status: F1 - Approved & Accepted | Rev: V 01 | Sheet: 07 of 24

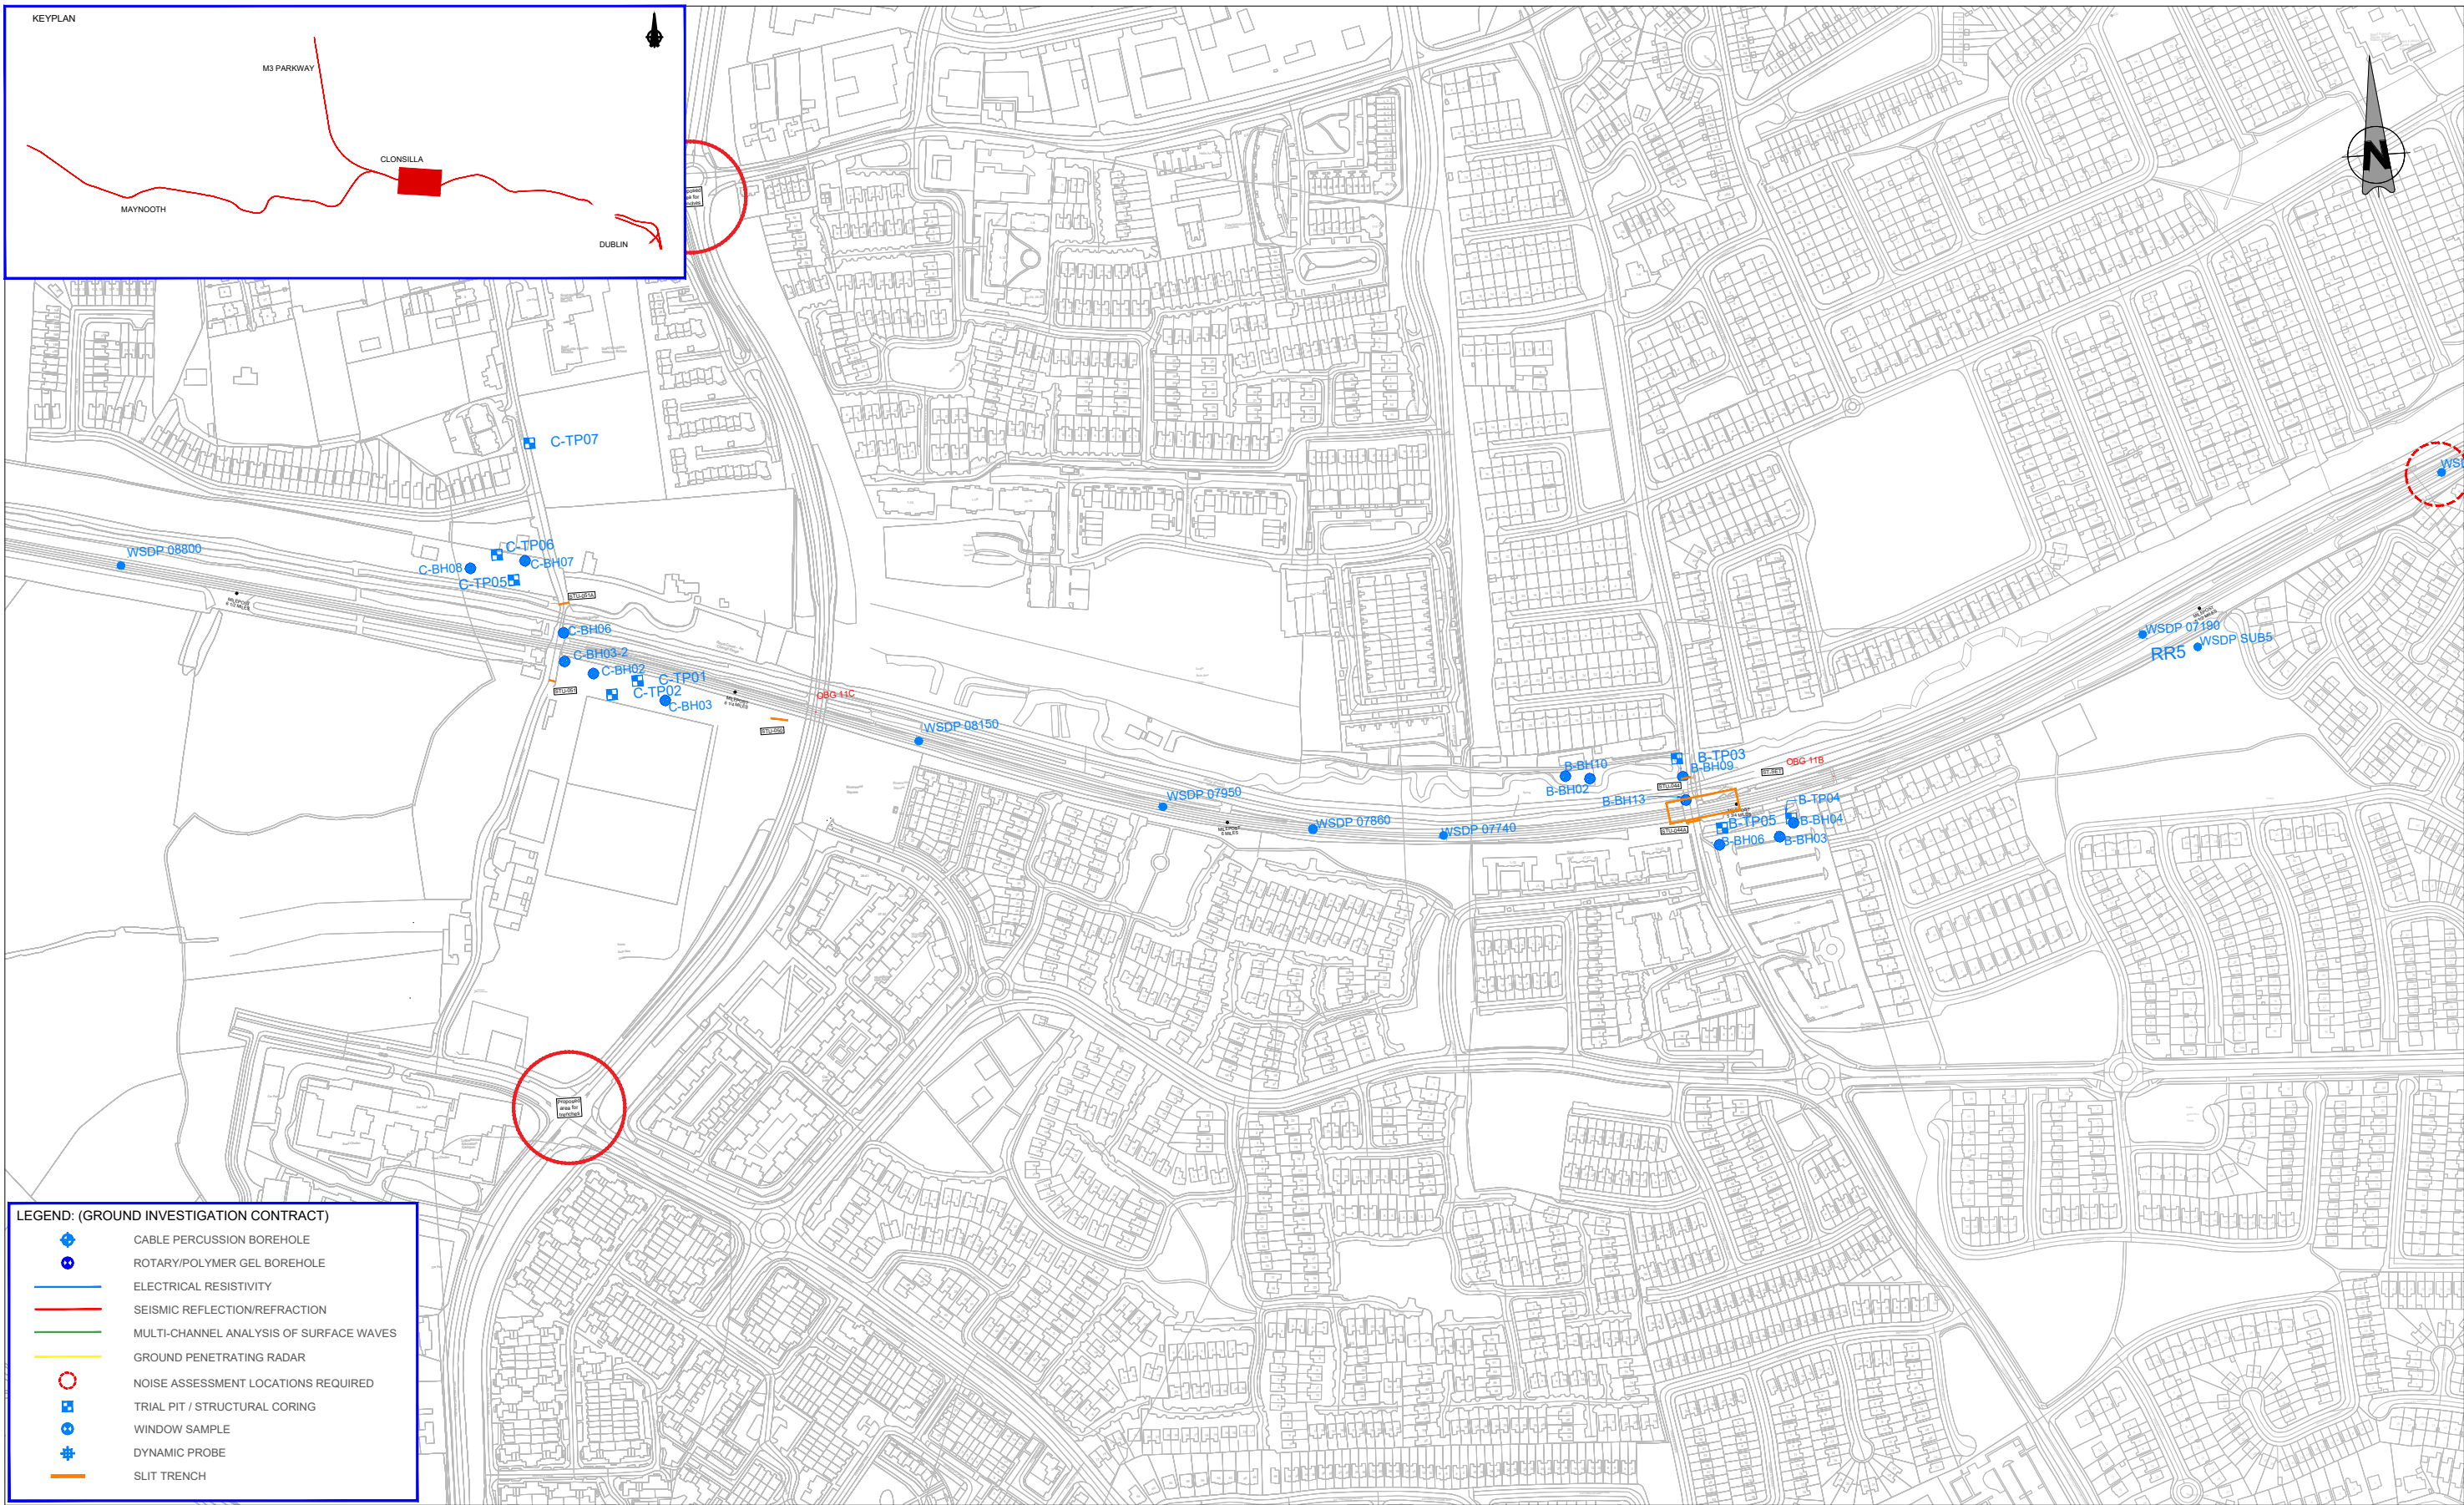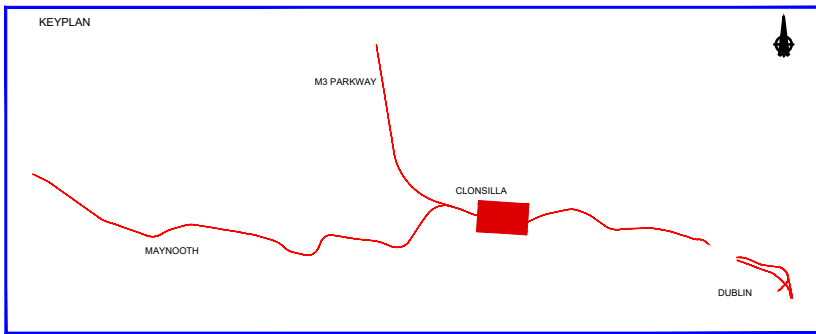

LEGEND: (GROUND INVESTIGATION CONTRACT)

- CABLE PERCUSSION BOREHOLE
- ROTARY/POLYMER GEL BOREHOLE
- ELECTRICAL RESISTIVITY
- SEISMIC REFLECTION/REFRACTION
- MULTI-CHANNEL ANALYSIS OF SURFACE WAVES
- GROUND PENETRATING RADAR
- NOISE ASSESSMENT LOCATIONS REQUIRED
- TRIAL PIT / STRUCTURAL CORING
- WINDOW SAMPLE
- DYNAMIC PROBE
- SLIT TRENCH

REV	DATE	DESCRIPTION	MAH	MAH	MK
V01	May 2022	PLANNING ISSUE			
PRODUCED BY			REVIEWED BY		
APPROVED BY					

© Irish Rail (2021). This drawing is confidential and the copyright in it is owned by Irish Rail. This drawing must not be either loaned, copied or otherwise reproduced in whole or in part or used for any purpose without the prior permission of Irish Rail.
 © Ordnance Survey Ireland and Government of Ireland. All O.S. data used for plans are printed under "Copyright Ordnance Survey Ireland".
 Survey No. 0039721 (OSi Aerial Data or OSi Lidar Data) & Survey No. 2021081_NMA_180 (OSi Vector Data).
 All elevations are in metres and relate to OSi Geoid Model (OSGM02) Mean Head as defined by existing Project Control.
 All Co-ordinates are in Irish Transverse Mercator Grid (ITM) as defined by OSi active GPS station Tallaght College (TLG0).

Client

Consultant

Project

Drawing Title



GROUND INVESTIGATION AS-BUILT LOCATIONS SHEET 8

Scale: 1:2,500 @ A1 1:5,000 @ A3

Drawing Number | Project | Originator | Discipline | Location | Type | Role | Number | Phase

MAY MDC GEO ROUT DR G 96008 D

Date: May 2022 | Job No: P/101086 | Status: F1 - Approved & Accepted | Rev: V 01 | Sheet: 08 of 24

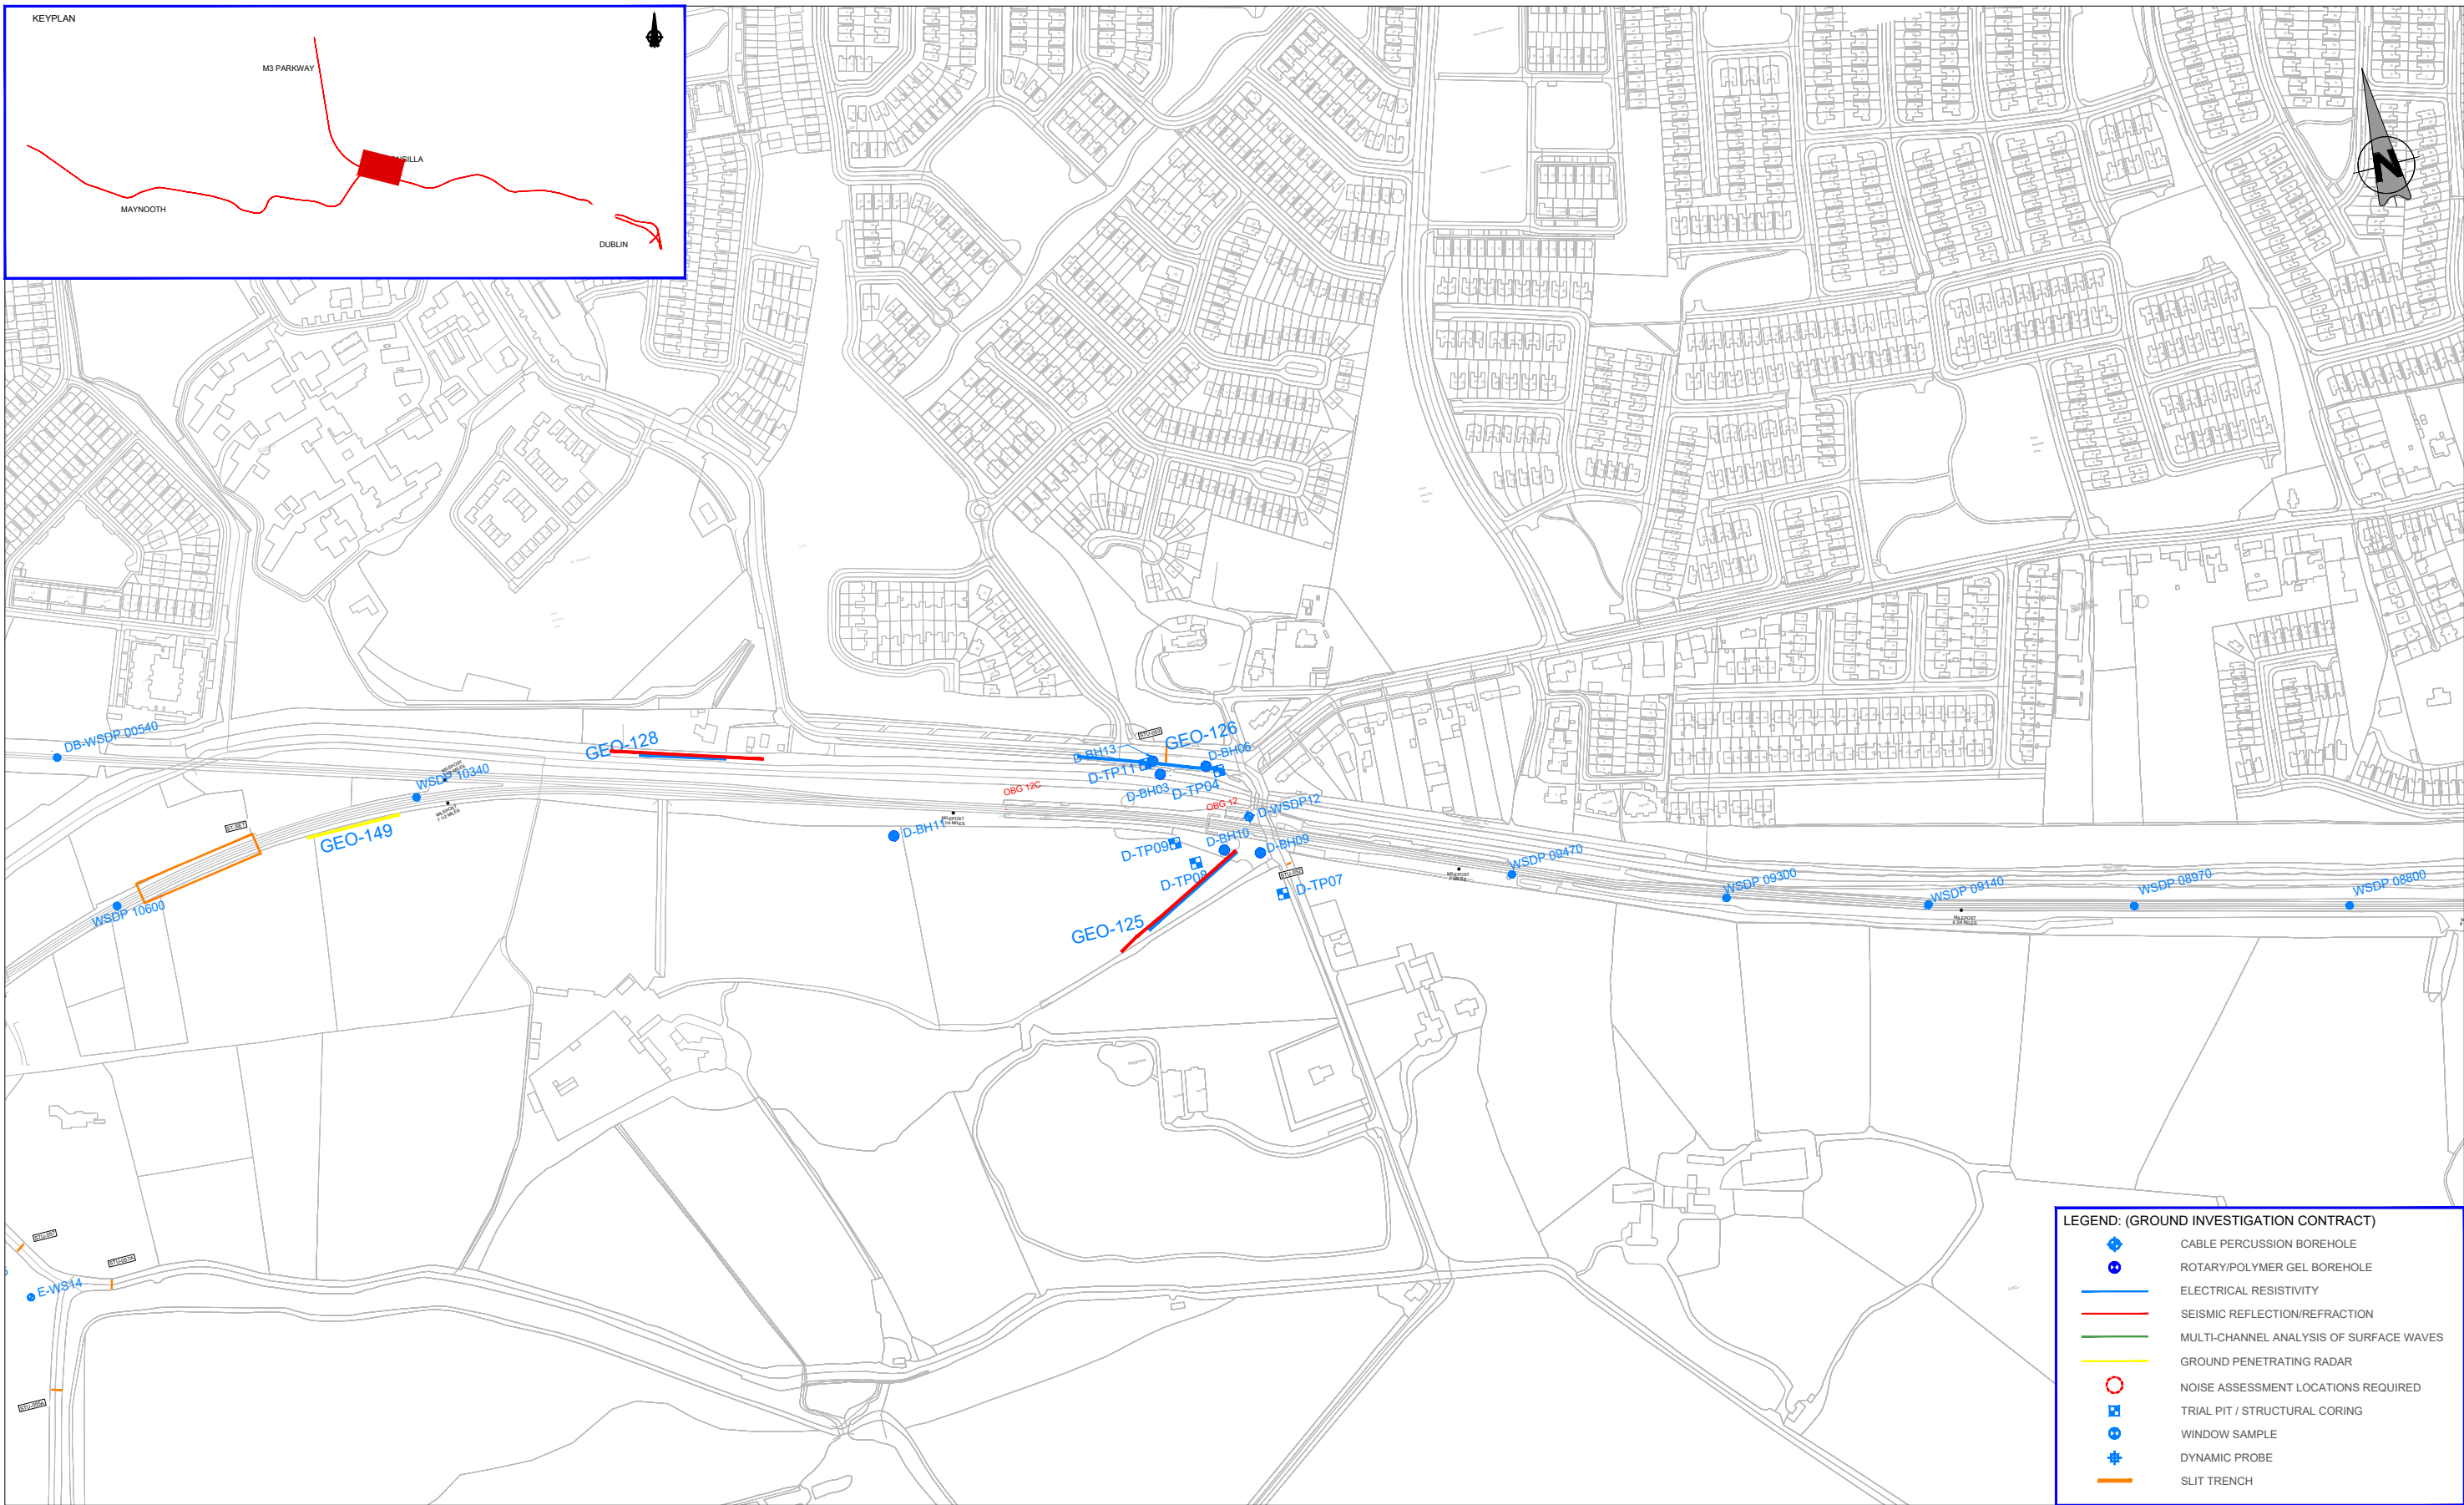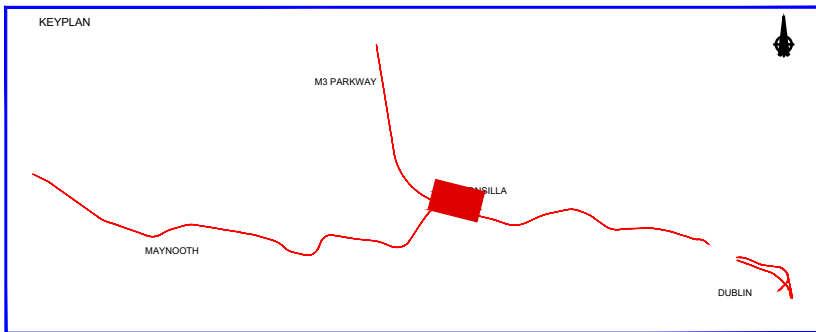

LEGEND: (GROUND INVESTIGATION CONTRACT)

- CABLE PERCUSSION BOREHOLE
- ROTARY/POLYMER GEL BOREHOLE
- ELECTRICAL RESISTIVITY
- SEISMIC REFLECTION/REFRACTION
- MULTI-CHANNEL ANALYSIS OF SURFACE WAVES
- GROUND PENETRATING RADAR
- NOISE ASSESSMENT LOCATIONS REQUIRED
- TRIAL PIT / STRUCTURAL CORING
- WINDOW SAMPLE
- DYNAMIC PROBE
- SLIT TRENCH

REV	DATE	DESCRIPTION	MAH	MAH	MK
V01	May 2022	PLANNING ISSUE			
PRODUCED BY			REVIEWED BY		
APPROVED BY					

© Irish Rail (2021). This drawing is confidential and the copyright in it is owned by Irish Rail. This drawing must not be either loaned, copied or otherwise reproduced in whole or in part or used for any purpose without the prior permission of Irish Rail.
 © Ordnance Survey Ireland and Government of Ireland. All O.S. data used for plans are printed under "Copyright Ordnance Survey Ireland".
 Survey No. 0039721 (OSi Aerial Data or OSi Lidar Data) & Survey No. 2021/081_NMA_180 (OSi Vector Data).
 All elevations are in metres and relate to OSi Geoid Model (OSGM02) Malin Head as defined by existing Project Contract.
 All Co-ordinates are in Irish Transverse Mercator Grid (ITM) as defined by OSi active GPS station Tallaght College (TLG0).

Client

Consultant

Project


Drawing Title

GROUND INVESTIGATION AS-BUILT LOCATIONS SHEET 9

Scale: 1:2,500 @ A1 1:5,000 @ A3

Drawing Number | Project | Originator | Discipline | Location | Type | Role | Number | Phase
 MAY MDC GEO ROUT DR G 96009 D

Date: May 2022 | Job No: P/101086 | Status: F1 - Approved & Accepted | Rev: V 01 | Sheet: 09 of 24

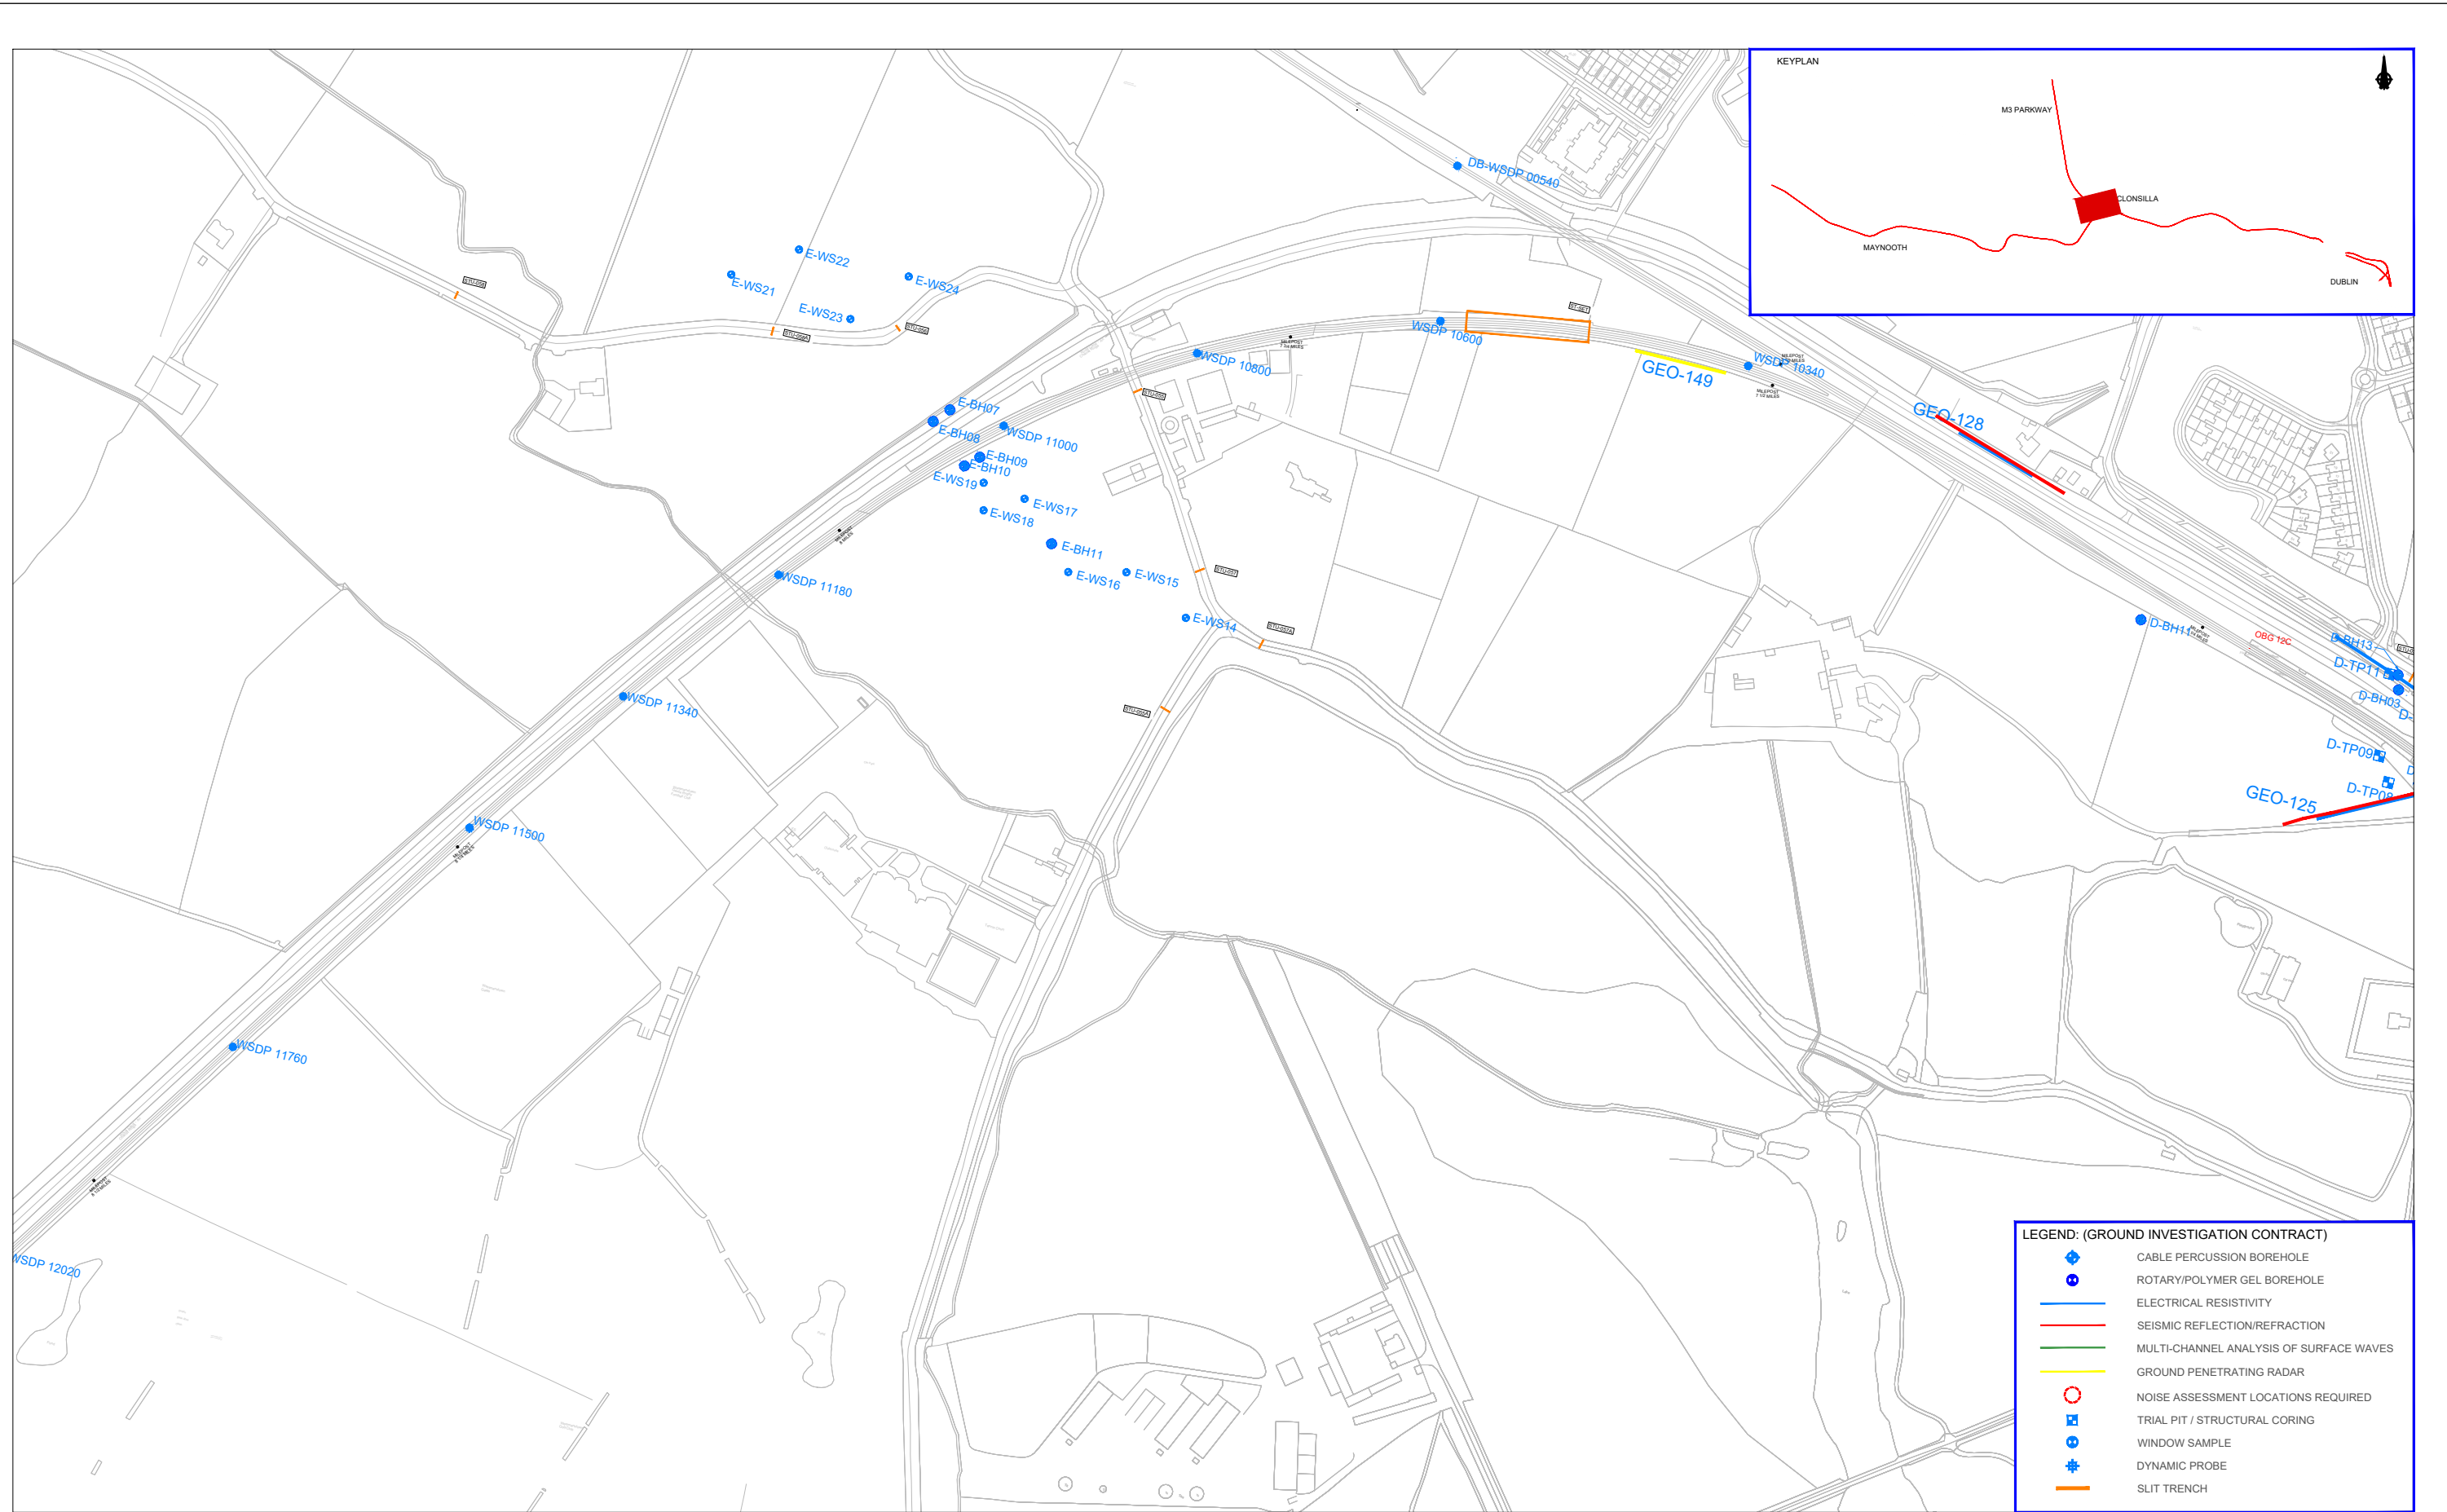



REV	DATE	DESCRIPTION	PRODUCED BY	REVIEWED BY	APPROVED BY
V01	May 2022	PLANNING ISSUE	MAH	MAH	MK

© Irish Rail (2021). This drawing is confidential and the copyright in it is owned by Irish Rail. This drawing must not be either loaned, copied or otherwise reproduced in whole or in part or used for any purpose without the prior permission of Irish Rail.
 © Ordnance Survey Ireland and Government of Ireland. All O.S. data used for plans are printed under "Copyright Ordnance Survey Ireland".
 Survey No. 0039721 (OSI Aerial Data or OSI Lidar Data) & Survey No. 2021OSI_NMA_180 (OSI Vector Data).
 All elevations are in metres and relate to OSI Geoid Model (OSGM02) Malin Head as defined by existing Project Control.
 All Co-ordinates are in Irish Transverse Mercator Grid (ITM) as defined by OSI active GPS station Talaght College (TLG0).

Client
 Consultant



Drawing Title GROUND INVESTIGATION AS-BUILT LOCATIONS SHEET 10	Scale: 1:2,500 @ A1 1:5,000 @ A3	Drawing Number MAY MDC GEO ROUT DR G 96010 D	Project MAY MDC GEO ROUT DR G 96010 D	Originator MAY MDC GEO ROUT DR G 96010 D	Discipline MAY MDC GEO ROUT DR G 96010 D	Location MAY MDC GEO ROUT DR G 96010 D	Type MAY MDC GEO ROUT DR G 96010 D	Role MAY MDC GEO ROUT DR G 96010 D	Number MAY MDC GEO ROUT DR G 96010 D	Phase MAY MDC GEO ROUT DR G 96010 D
Date May 2022	Job No. P/101086	Status F1 - Approved & Accepted	Rev. V 01	Sheet: 10 of 24						

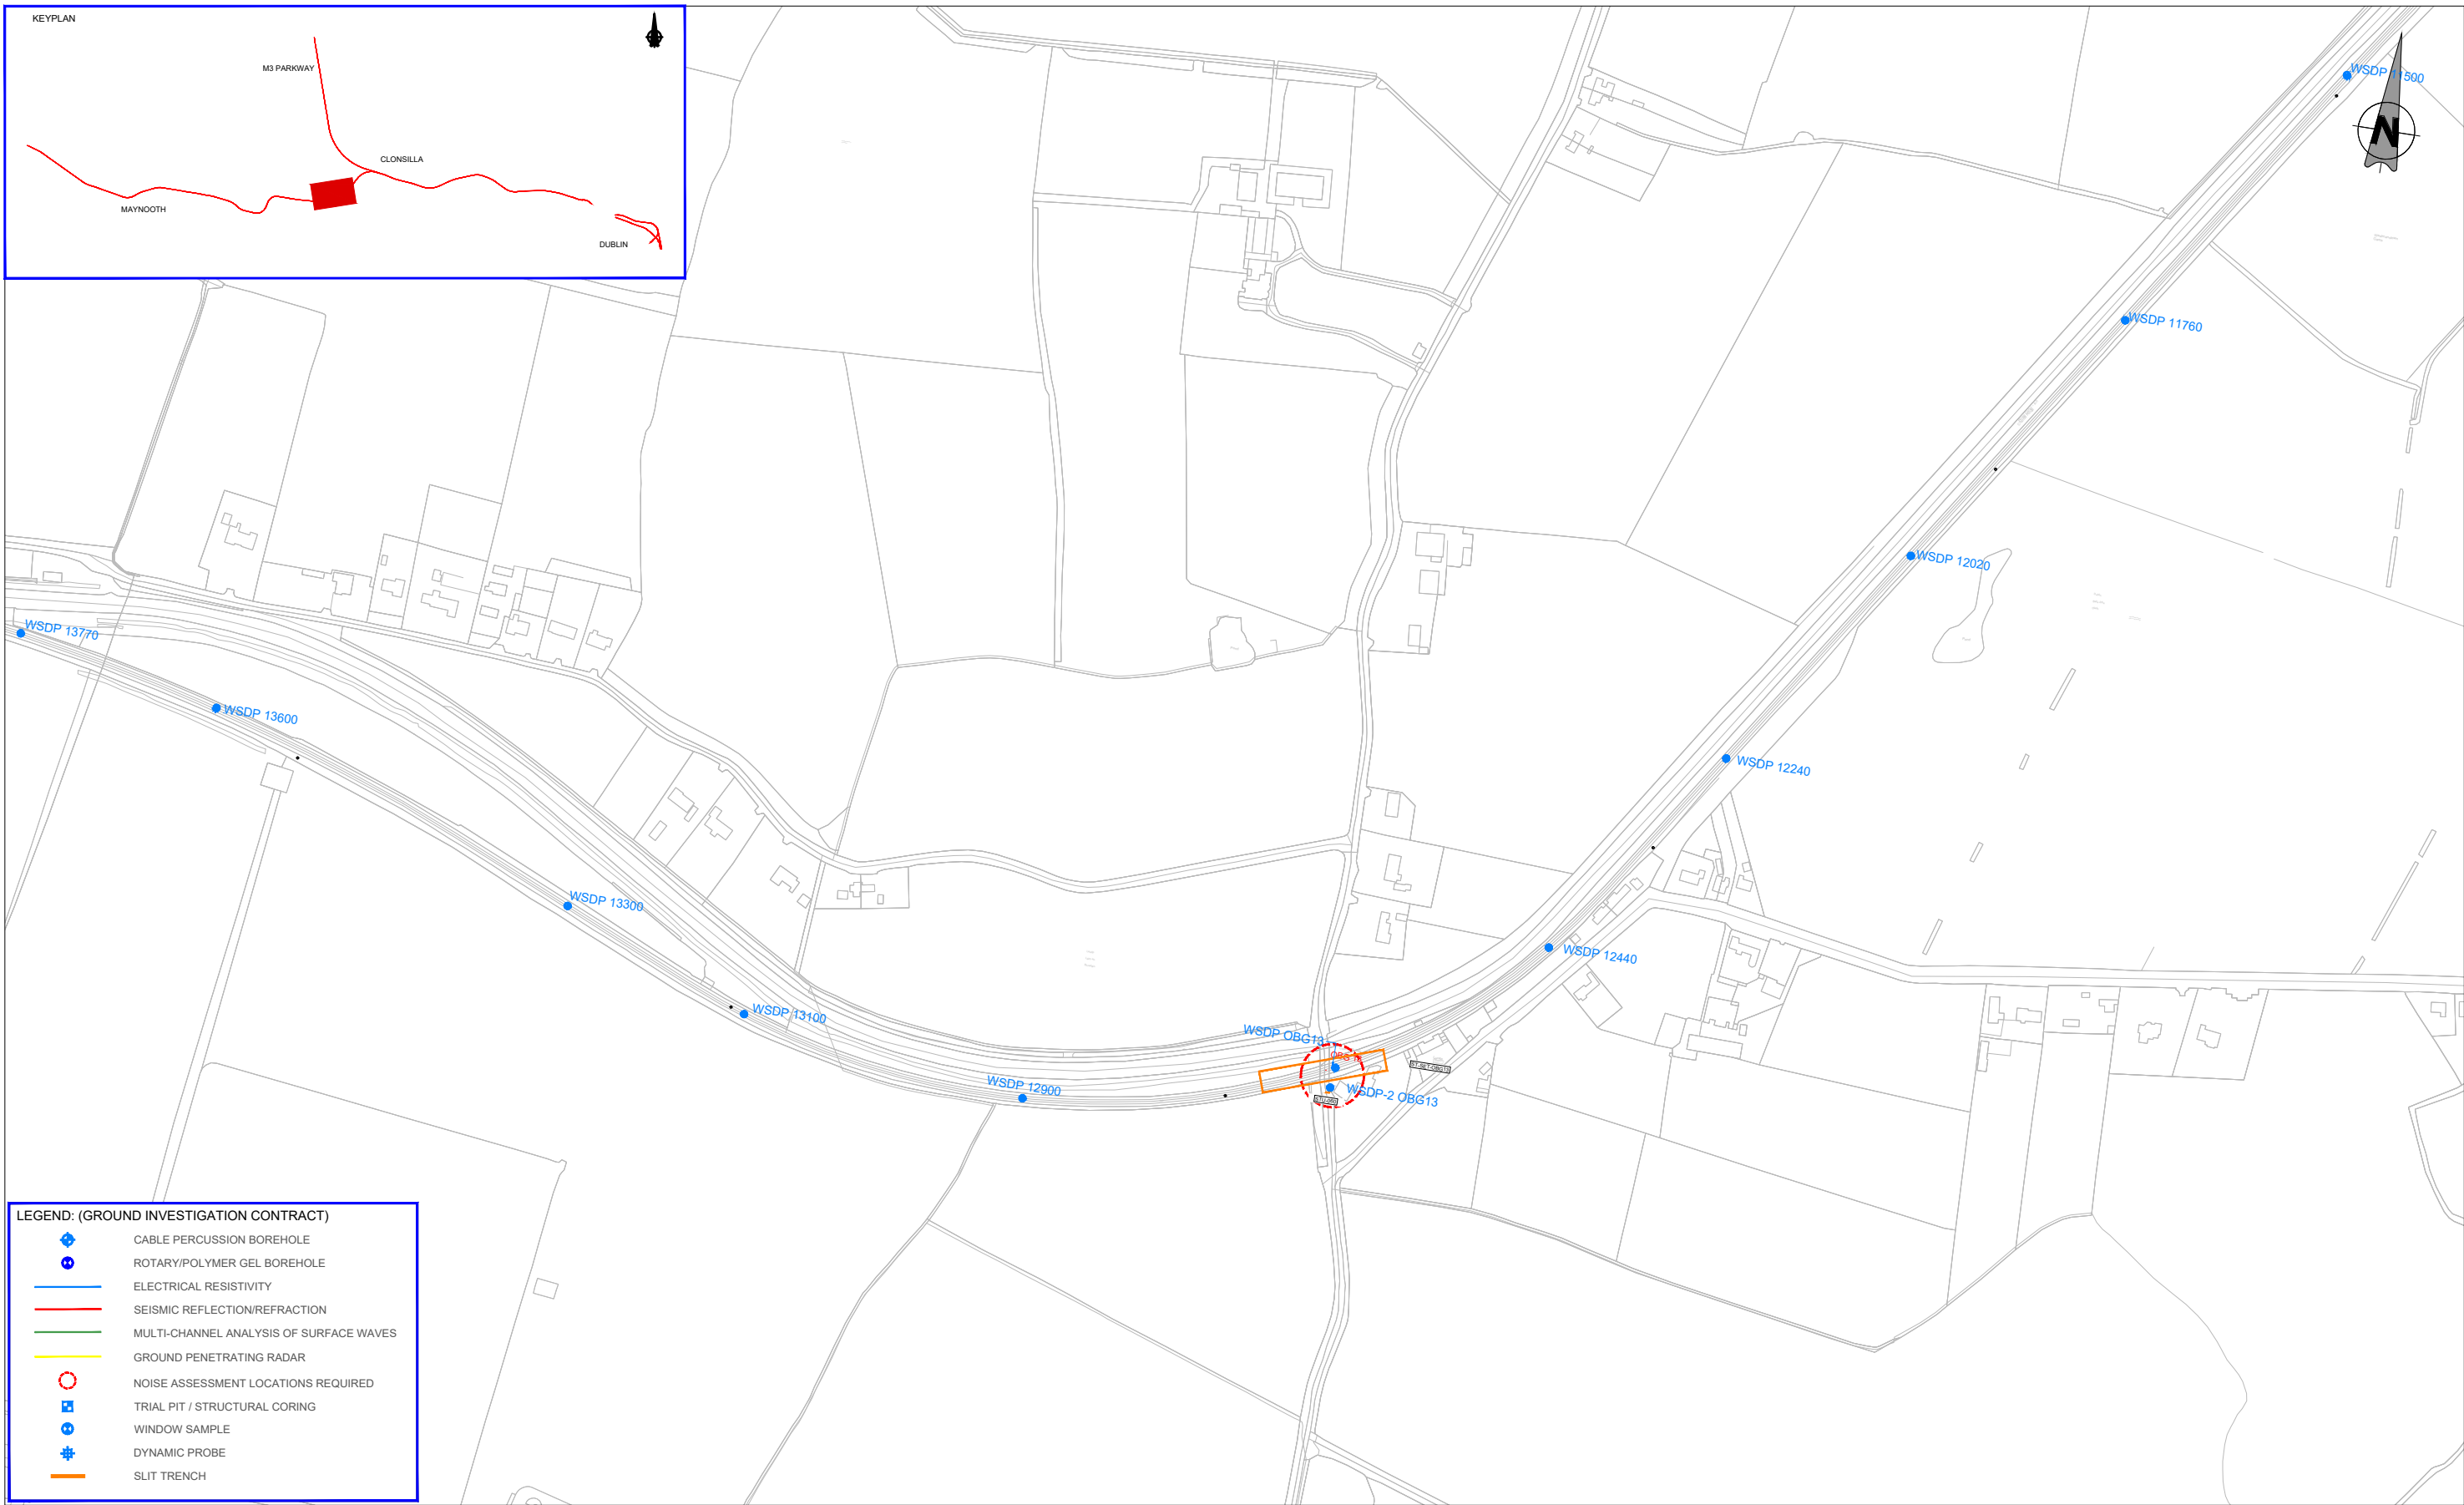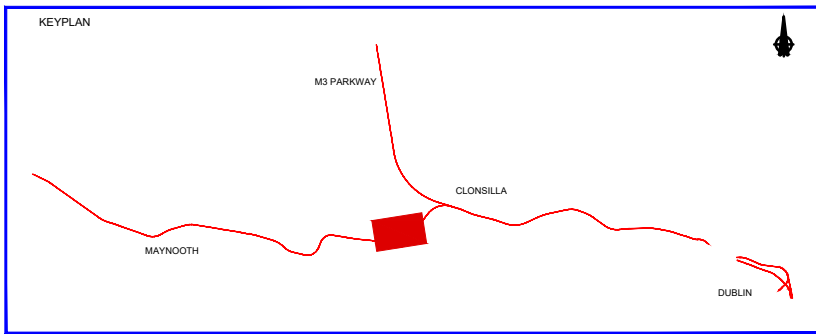

LEGEND: (GROUND INVESTIGATION CONTRACT)

- CABLE PERCUSSION BOREHOLE
- ROTARY/POLYMER GEL BOREHOLE
- ELECTRICAL RESISTIVITY
- SEISMIC REFLECTION/REFRACTION
- MULTI-CHANNEL ANALYSIS OF SURFACE WAVES
- GROUND PENETRATING RADAR
- NOISE ASSESSMENT LOCATIONS REQUIRED
- TRIAL PIT / STRUCTURAL CORING
- WINDOW SAMPLE
- DYNAMIC PROBE
- SLIT TRENCH

REV	DATE	DESCRIPTION	MAH	MAH	MK
V01	May 2022	PLANNING ISSUE			
PRODUCED BY			REVIEWED BY		
APPROVED BY					

© Irish Rail (2021). This drawing is confidential and the copyright in it is owned by Irish Rail. This drawing must not be either loaned, copied or otherwise reproduced in whole or in part or used for any purpose without the prior permission of Irish Rail.
 © Ordnance Survey Ireland and Government of Ireland. All O.S. data used for plans are printed under "Copyright Ordnance Survey Ireland".
 Survey No. 6039721 (OSi Aerial Data or OSi Lidar Data) & Survey No. 2021081_NMA_180 (OSi Vector Data).
 All elevations are in metres and relate to OSi Geoid Model (OSGM02) Malin Head as defined by existing Project Control.
 All Co-ordinates are in Irish Transverse Mercator Grid (ITM) as defined by OSi active GPS station Tallaght College (TLTG).

Client

Consultant

Project

Drawing Title




GROUND INVESTIGATION AS-BUILT LOCATIONS SHEET 11

Scale: 1:2,500 @ A1 1:5,000 @ A3

Drawing Number | Project | Originator | Discipline | Location | Type | Role | Number | Phase

MAY MDC GEO ROUT DR G 96011 D

Date: May 2022 Job No: P/101086 Status: F1 - Approved & Accepted Rev: V 01 Sheet: 11 of 24

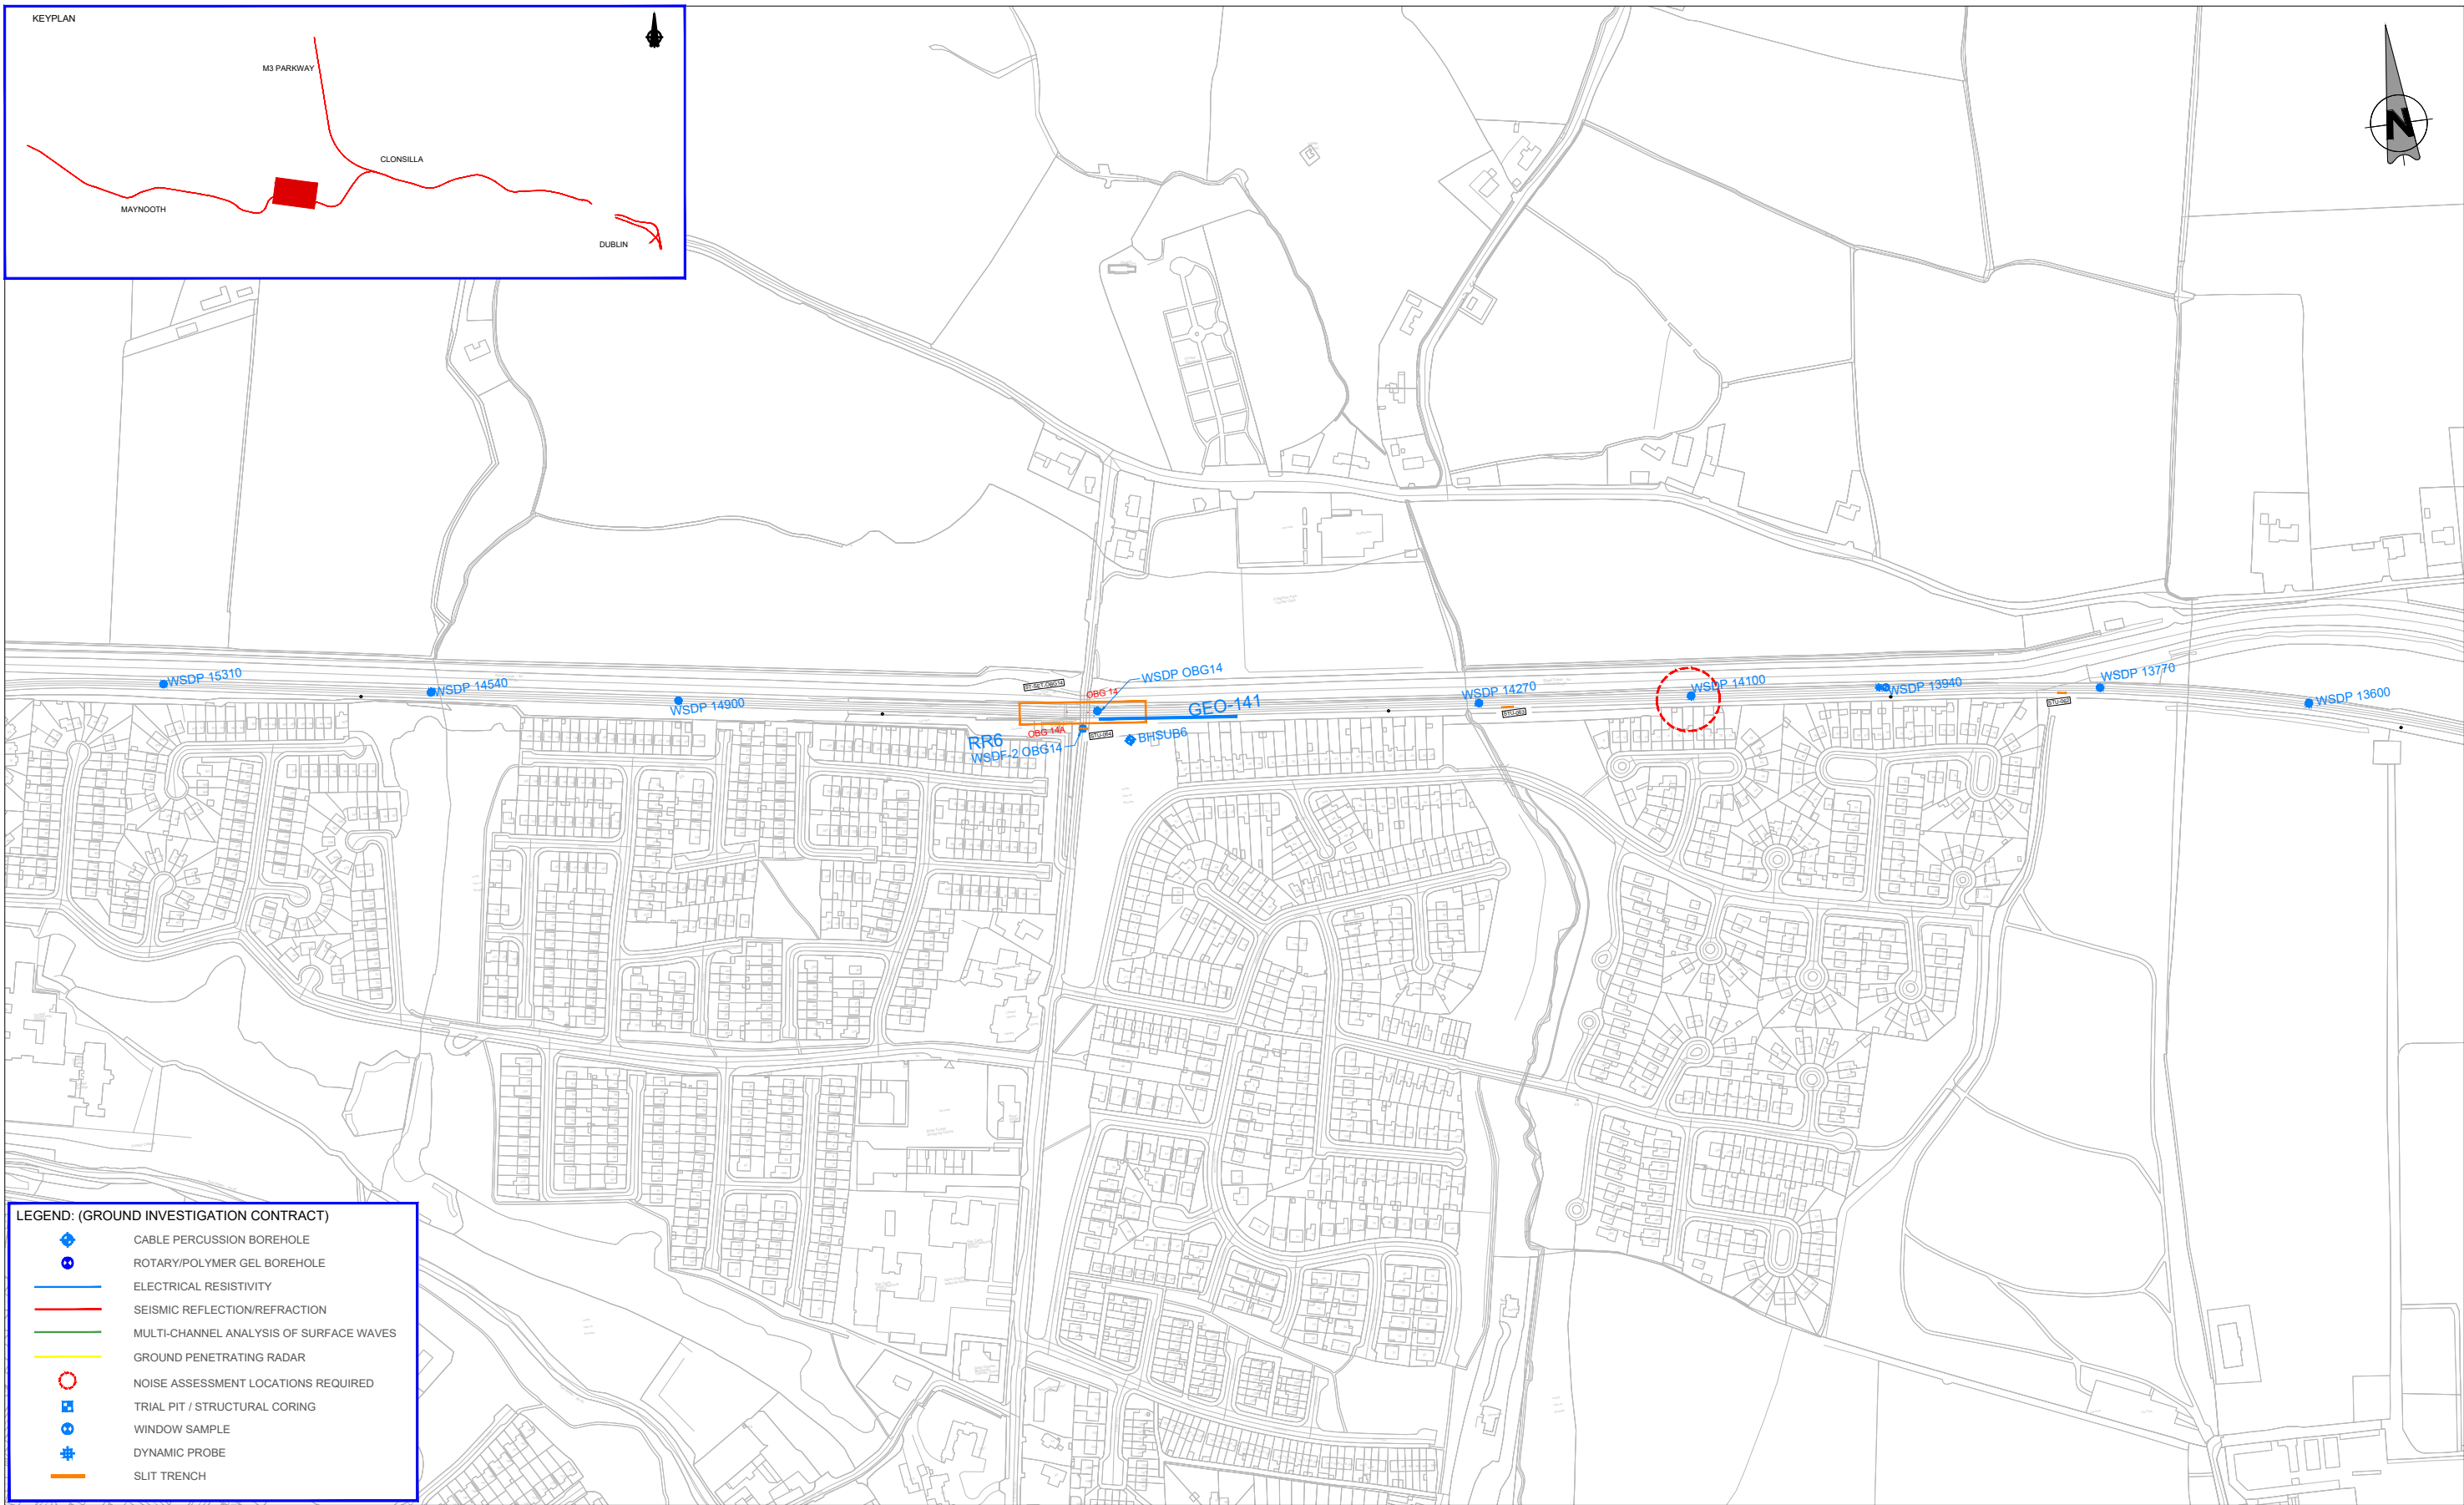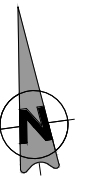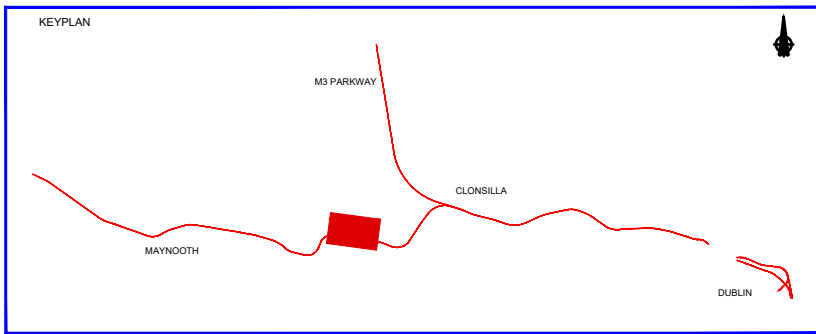

LEGEND: (GROUND INVESTIGATION CONTRACT)

- CABLE PERCUSSION BOREHOLE
- ROTARY/POLYMER GEL BOREHOLE
- ELECTRICAL RESISTIVITY
- SEISMIC REFLECTION/REFRACTION
- MULTI-CHANNEL ANALYSIS OF SURFACE WAVES
- GROUND PENETRATING RADAR
- NOISE ASSESSMENT LOCATIONS REQUIRED
- TRIAL PIT / STRUCTURAL CORING
- WINDOW SAMPLE
- DYNAMIC PROBE
- SLIT TRENCH

REV	DATE	DESCRIPTION	PRODUCED BY	REVIEWED BY	APPROVED BY
V01	May 2022	PLANNING ISSUE	MAH	MAH	MK

© Irish Rail (2021). This drawing is confidential and the copyright in it is owned by Irish Rail. This drawing must not be either loaned, copied or otherwise reproduced in whole or in part or used for any purpose without the prior permission of Irish Rail.
 © Ordnance Survey Ireland and Government of Ireland. All O.S. data used for plans are printed under "Copyright Ordnance Survey Ireland".
 Survey No. 0039721 (OSI Aerial Data or OS Lidar Data) & Survey No. 2021051_NMA_100 (OSI Vector Data).
 All elevations are in metres and relate to OSI Geoid Model (OSGM02) Mean Head as defined by existing Project Control.
 All Co-ordinates are in Irish Transverse Mercator Grid (ITM) as defined by OSI active GPS station Tallaght College (TLG0).

Client

Consultant

Project



Drawing Title

GROUND INVESTIGATION AS-BUILT LOCATIONS SHEET 12

Scale: 1:2,500 @ A1 1:5,000 @ A3

Drawing Number | Project | Originator | Discipline | Location | Type | Role | Number | Phase
 MAY MDC GEO ROUT DR G 96012 D

Date: May 2022 | Job No: P/101086 | Status: F1 - Approved & Accepted | Rev: V 01 | Sheet: 12 of 24

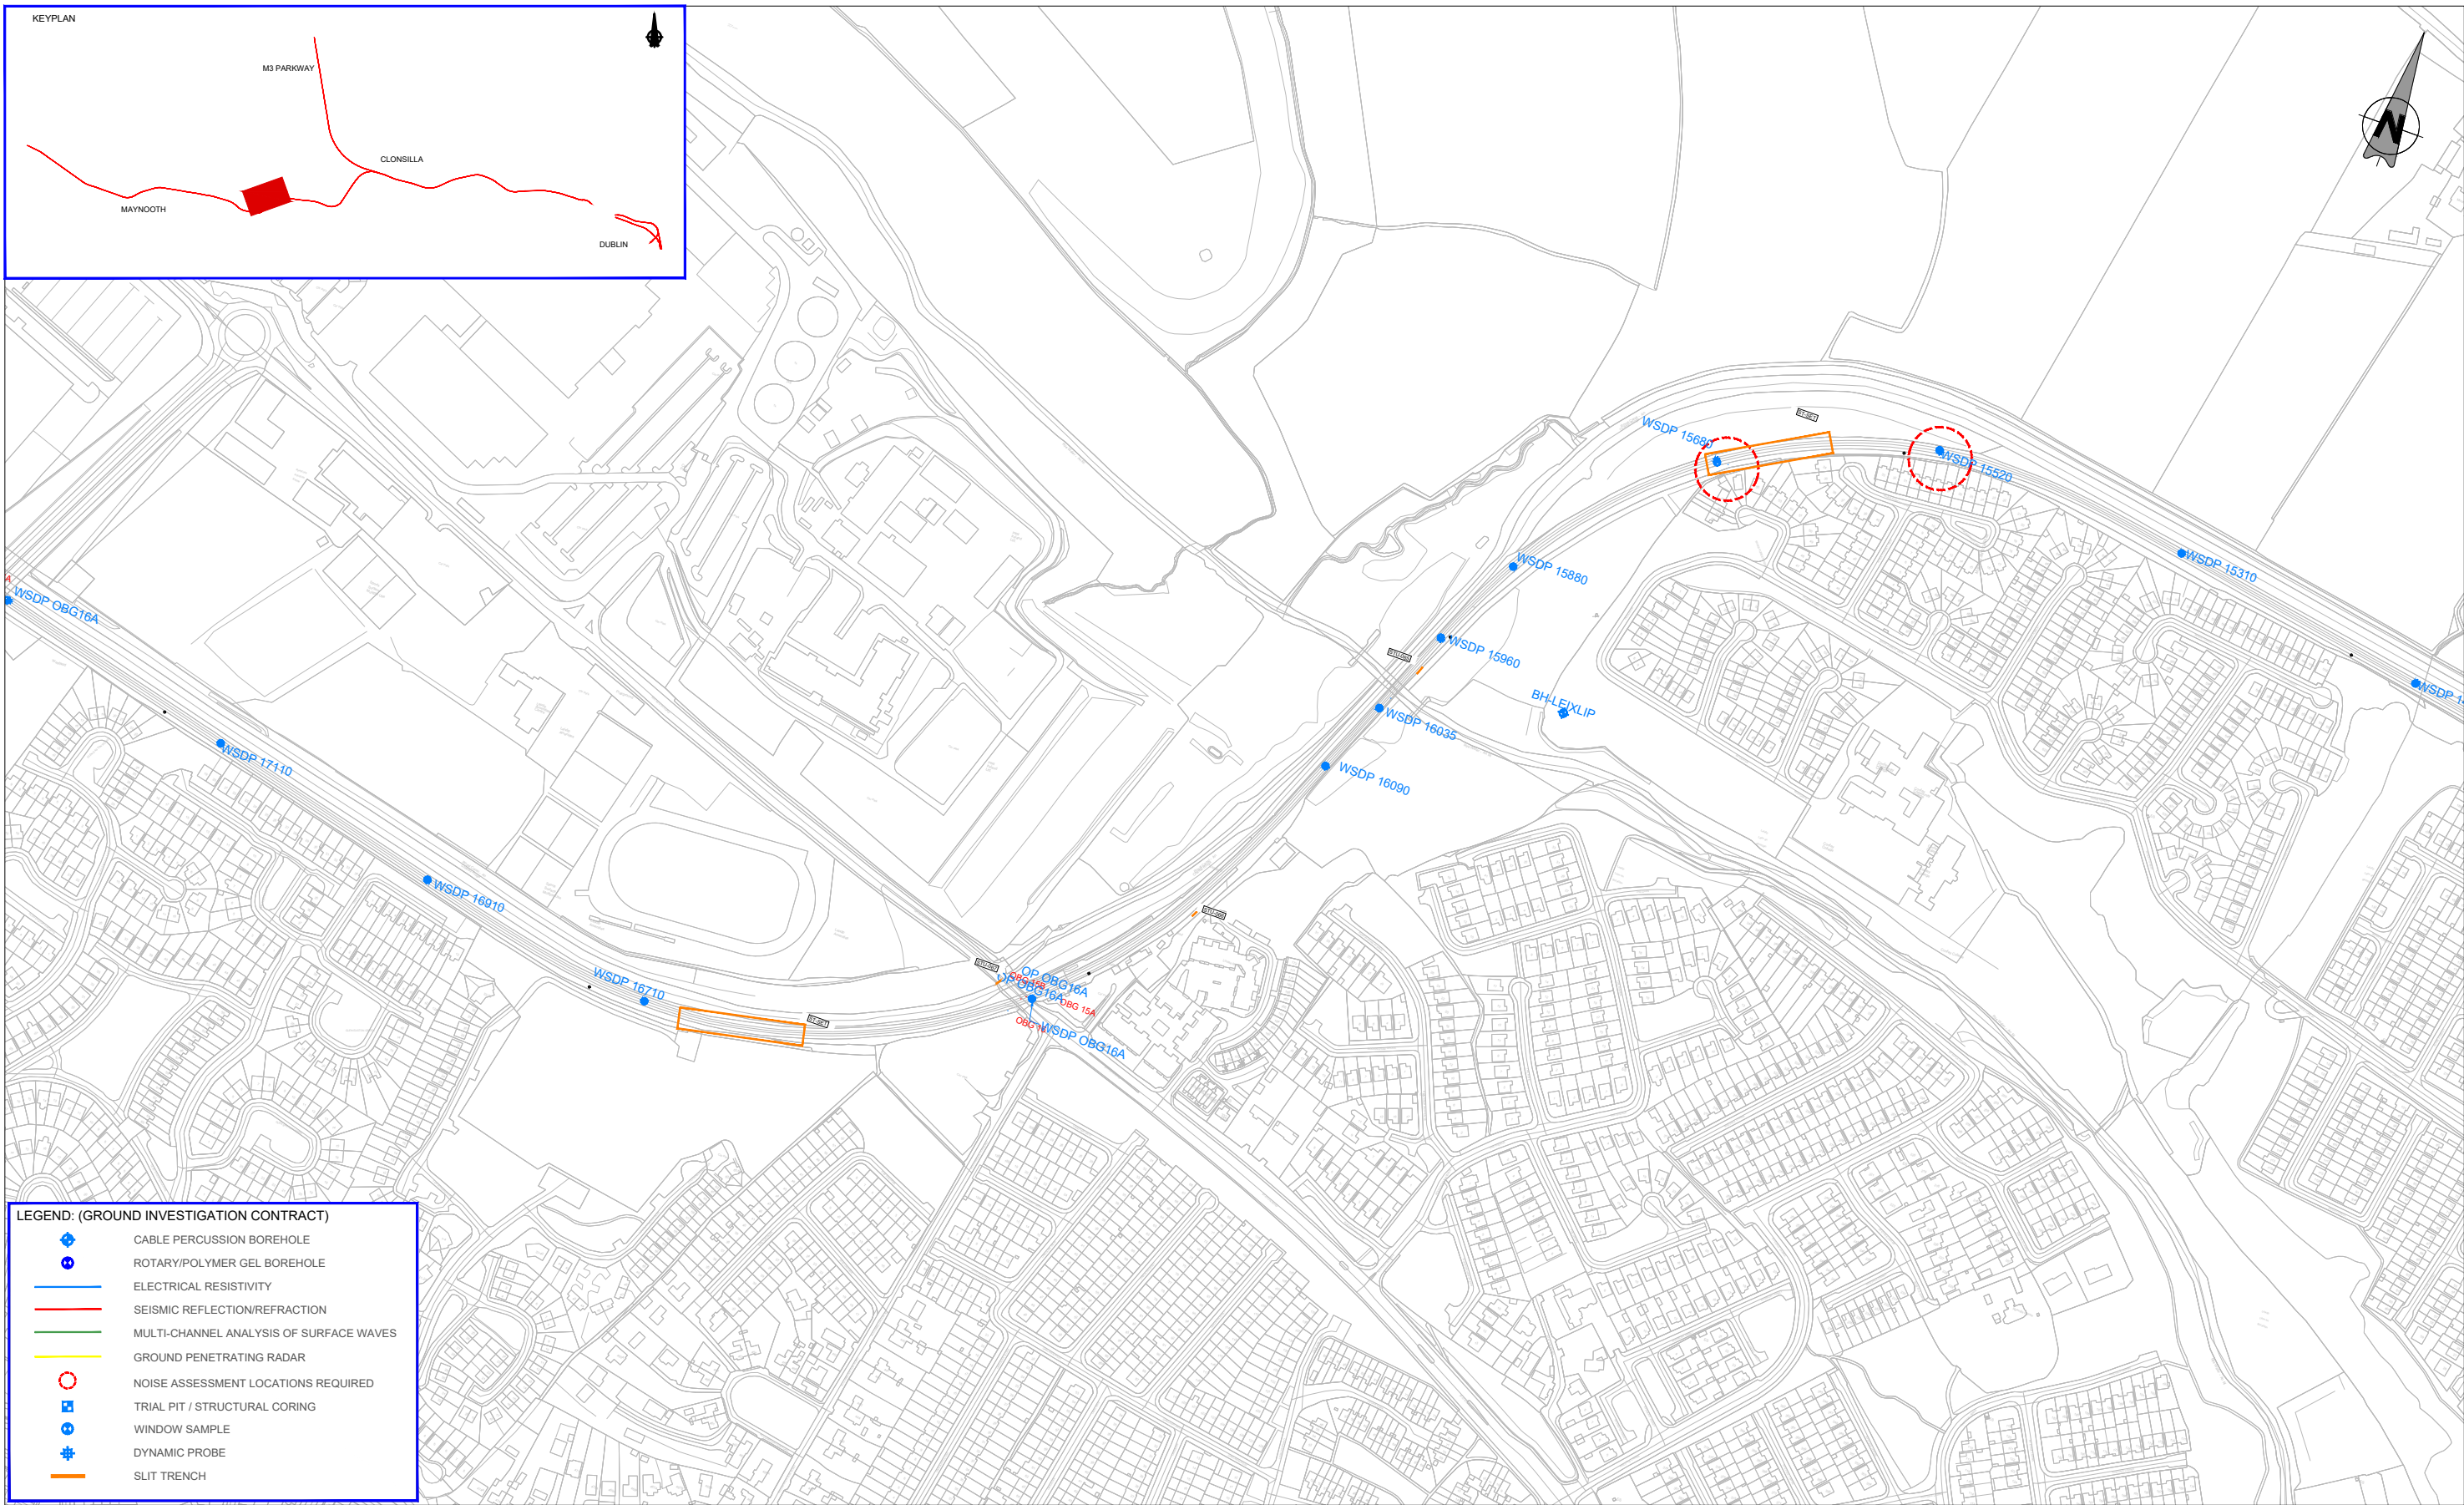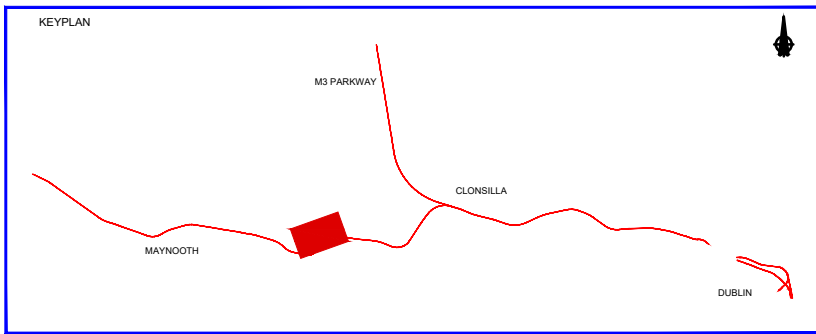

LEGEND: (GROUND INVESTIGATION CONTRACT)

- CABLE PERCUSSION BOREHOLE
- ROTARY/POLYMER GEL BOREHOLE
- ELECTRICAL RESISTIVITY
- SEISMIC REFLECTION/REFRACTION
- MULTI-CHANNEL ANALYSIS OF SURFACE WAVES
- GROUND PENETRATING RADAR
- NOISE ASSESSMENT LOCATIONS REQUIRED
- TRIAL PIT / STRUCTURAL CORING
- WINDOW SAMPLE
- DYNAMIC PROBE
- SLIT TRENCH

REV	DATE	DESCRIPTION	PRODUCED BY	REVIEWED BY	APPROVED BY
V01	May 2022	PLANNING ISSUE	MAH	MAH	MK

© Irish Rail (2021). This drawing is confidential and the copyright in it is owned by Irish Rail. This drawing must not be either loaned, copied or otherwise reproduced in whole or in part or used for any purpose without the prior permission of Irish Rail.
 © Ordnance Survey Ireland and Government of Ireland. All O.S. data used for plans are printed under "Copyright Ordnance Survey Ireland".
 Survey No. 0039721 (OSI Aerial Data or OSI Lidar Data) & Survey No. 2021081_NMA_180 (OSI Vector Data).
 All elevations are in metres and relate to OSI Geoid Model (OSGM02) Mean Head as defined by existing Project Control.
 All Co-ordinates are in Irish Transverse Mercator Grid (ITM) as defined by OSI active GPS station Tallaght College (TLG0).

Client

Consultant

Project



Drawing Title

GROUND INVESTIGATION AS-BUILT LOCATIONS SHEET 13

Scale: 1:2,500 @ A1 1:5,000 @ A3

Drawing Number | Project | Originator | Discipline | Location | Type | Role | Number | Phase
 MAY MDC GEO ROUT DR G 96013 D

Date: May 2022 | Job No: P/101086 | Status: F1 - Approved & Accepted | Rev: V 01 | Sheet: 13 of 24

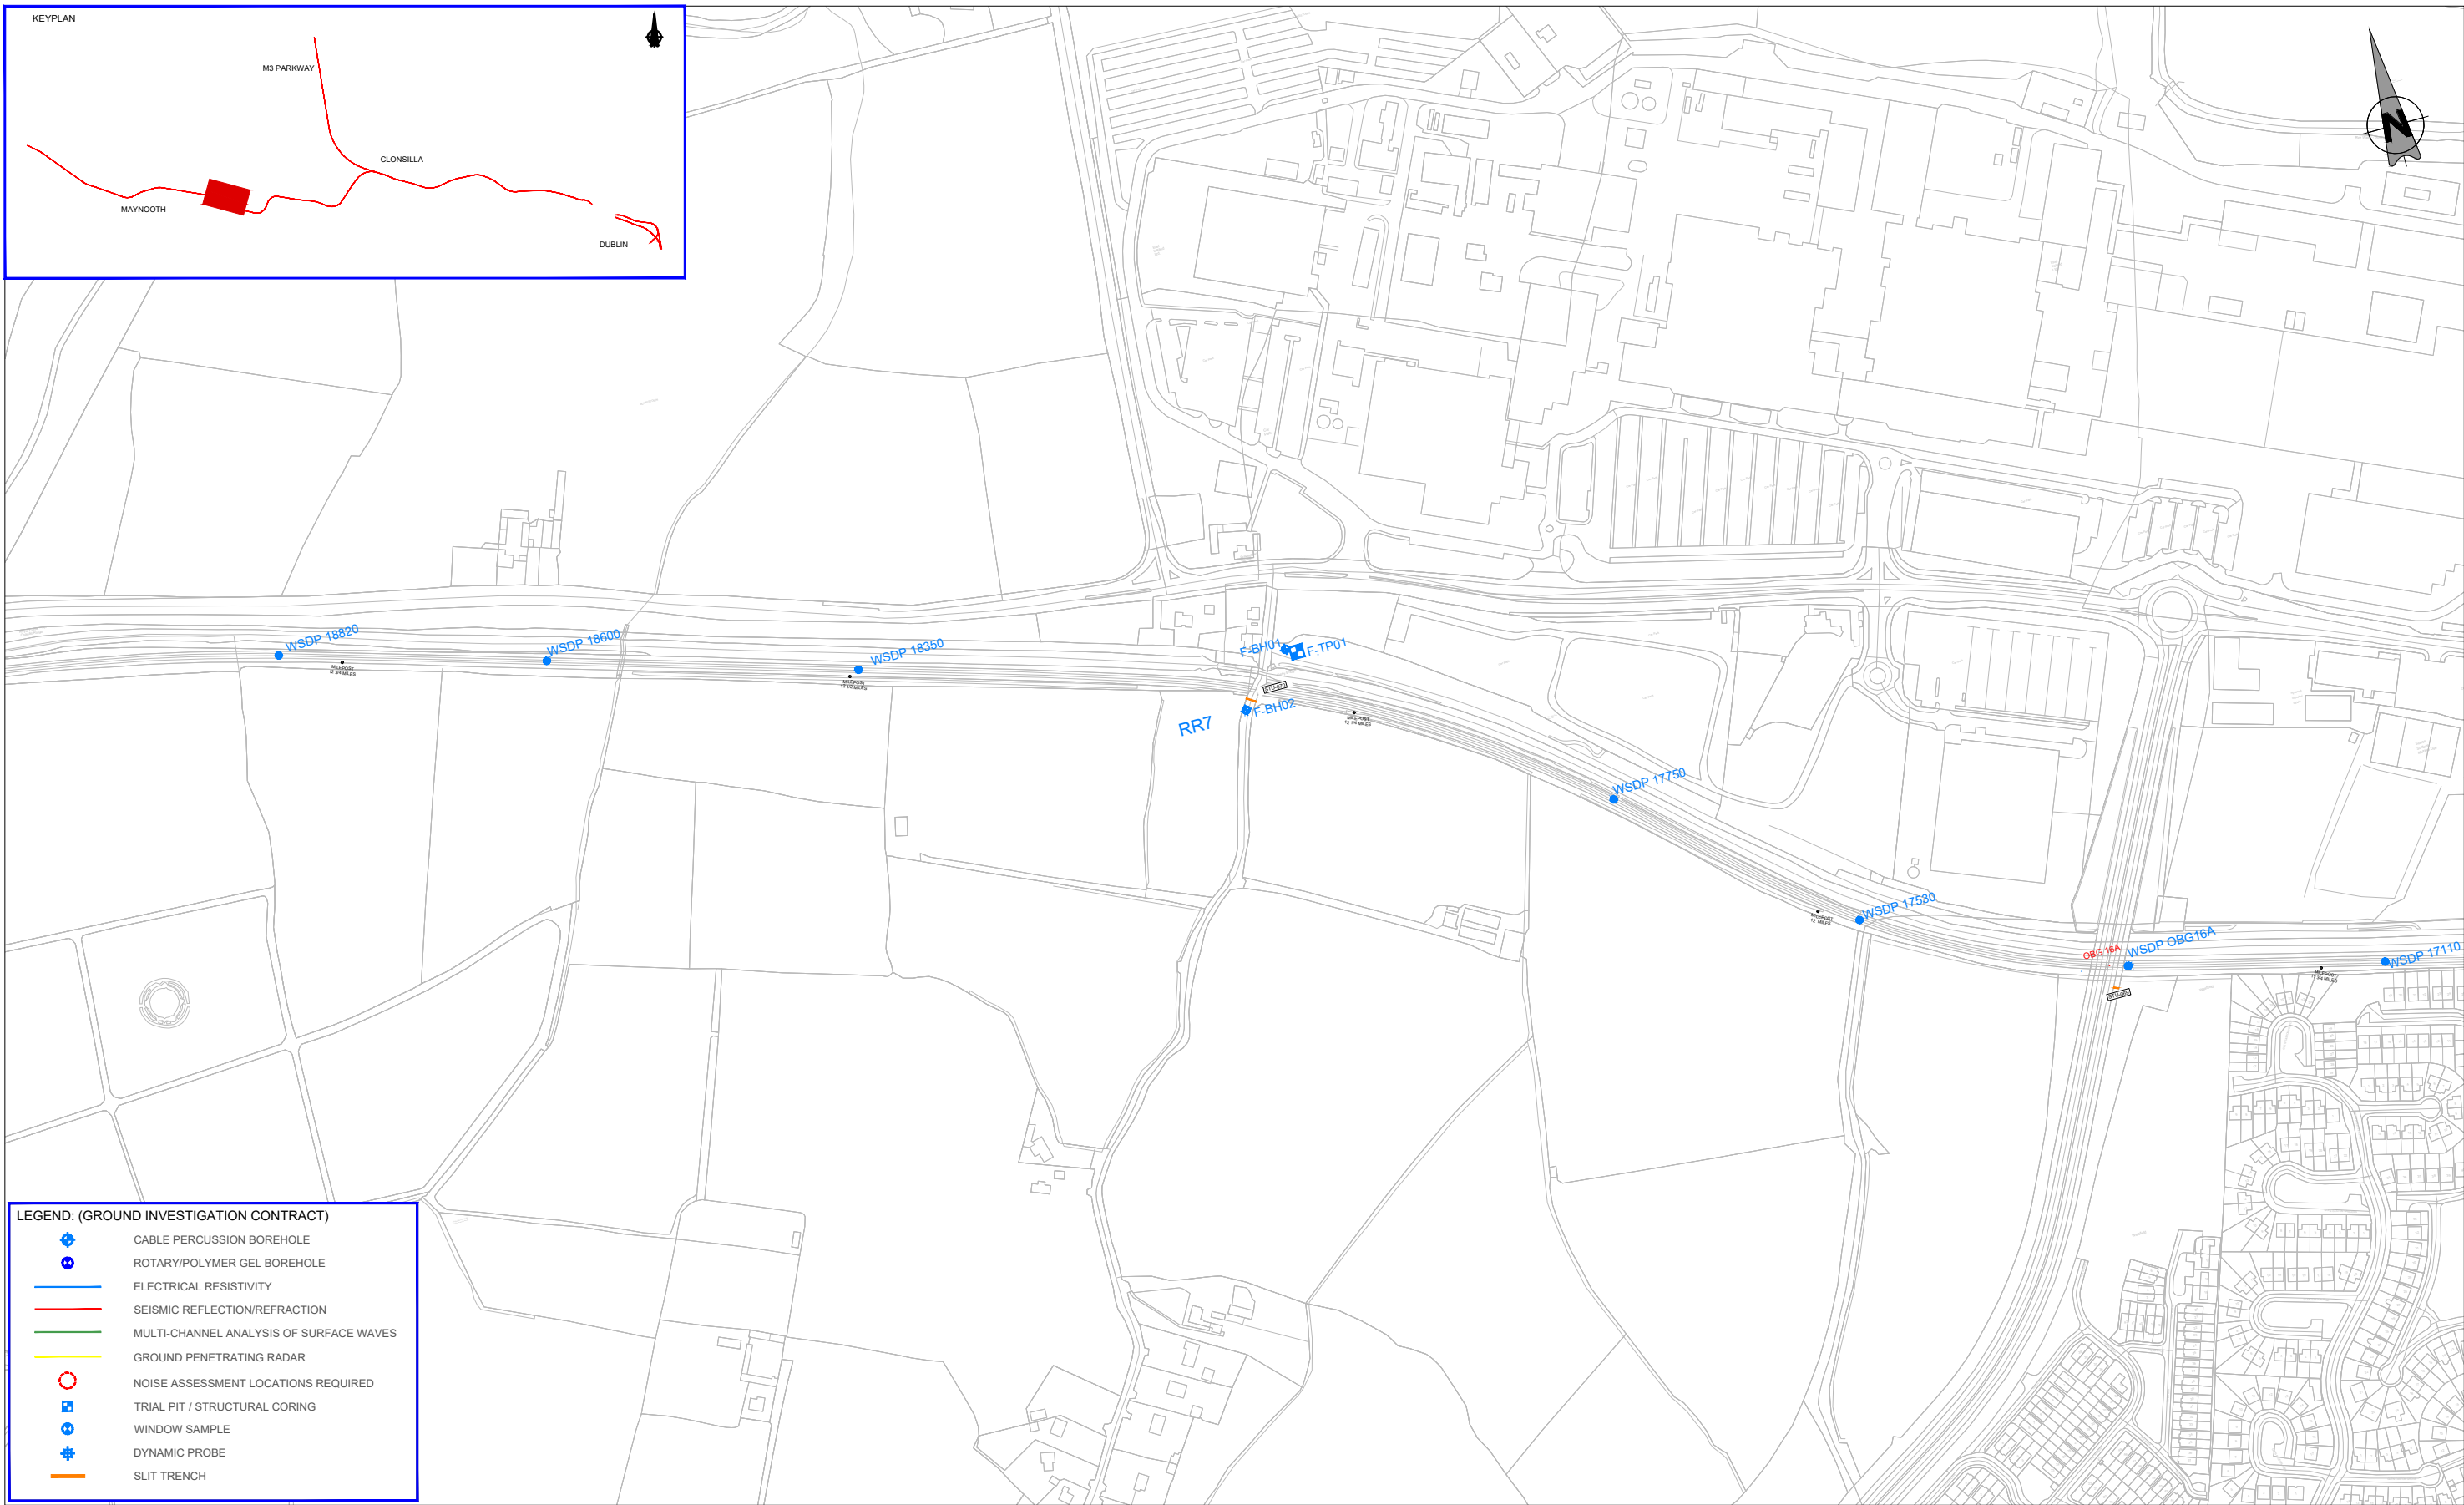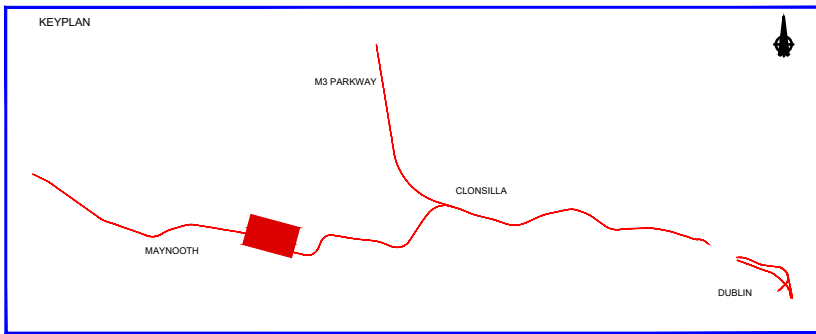

LEGEND: (GROUND INVESTIGATION CONTRACT)

- CABLE PERCUSSION BOREHOLE
- ROTARY/POLYMER GEL BOREHOLE
- ELECTRICAL RESISTIVITY
- SEISMIC REFLECTION/REFRACTION
- MULTI-CHANNEL ANALYSIS OF SURFACE WAVES
- GROUND PENETRATING RADAR
- NOISE ASSESSMENT LOCATIONS REQUIRED
- TRIAL PIT / STRUCTURAL CORING
- WINDOW SAMPLE
- DYNAMIC PROBE
- SLIT TRENCH

REV	DATE	DESCRIPTION	PRODUCED BY	REVIEWED BY	APPROVED BY
V01	May 2022	PLANNING ISSUE	MAH	MAH	MK

© Irish Rail (2021). This drawing is confidential and the copyright in it is owned by Irish Rail. This drawing must not be either loaned, copied or otherwise reproduced in whole or in part or used for any purpose without the prior permission of Irish Rail.
 © Ordnance Survey Ireland and Government of Ireland. All O.S. data used for plans are printed under "Copyright Ordnance Survey Ireland".
 Survey No. 6039721 (OSi Aerial Data or OSi Lidar Data) & Survey No. 2021081_NMA_180 (OSi Vector Data).
 All elevations are in metres and relate to OSi Geoid Model (OSGM02) Mean Head as defined by existing Project Contract.
 All Co-ordinates are in Irish Transverse Mercator Grid (ITM) as defined by OSi active GPS station: Talaght College (TLG0).

Client

Consultant

Project



Drawing Title

GROUND INVESTIGATION AS-BUILT LOCATIONS SHEET 14

Scale: 1:2,500 @ A1 1:5,000 @ A3

Drawing Number | Project | Originator | Discipline | Location | Type | Role | Number | Phase
 MAY MDC GEO ROUT DR G 96014 D

Date: May 2022 | Job No: P/101086 | Status: F1 - Approved & Accepted | Rev: V 01 | Sheet: 14 of 24

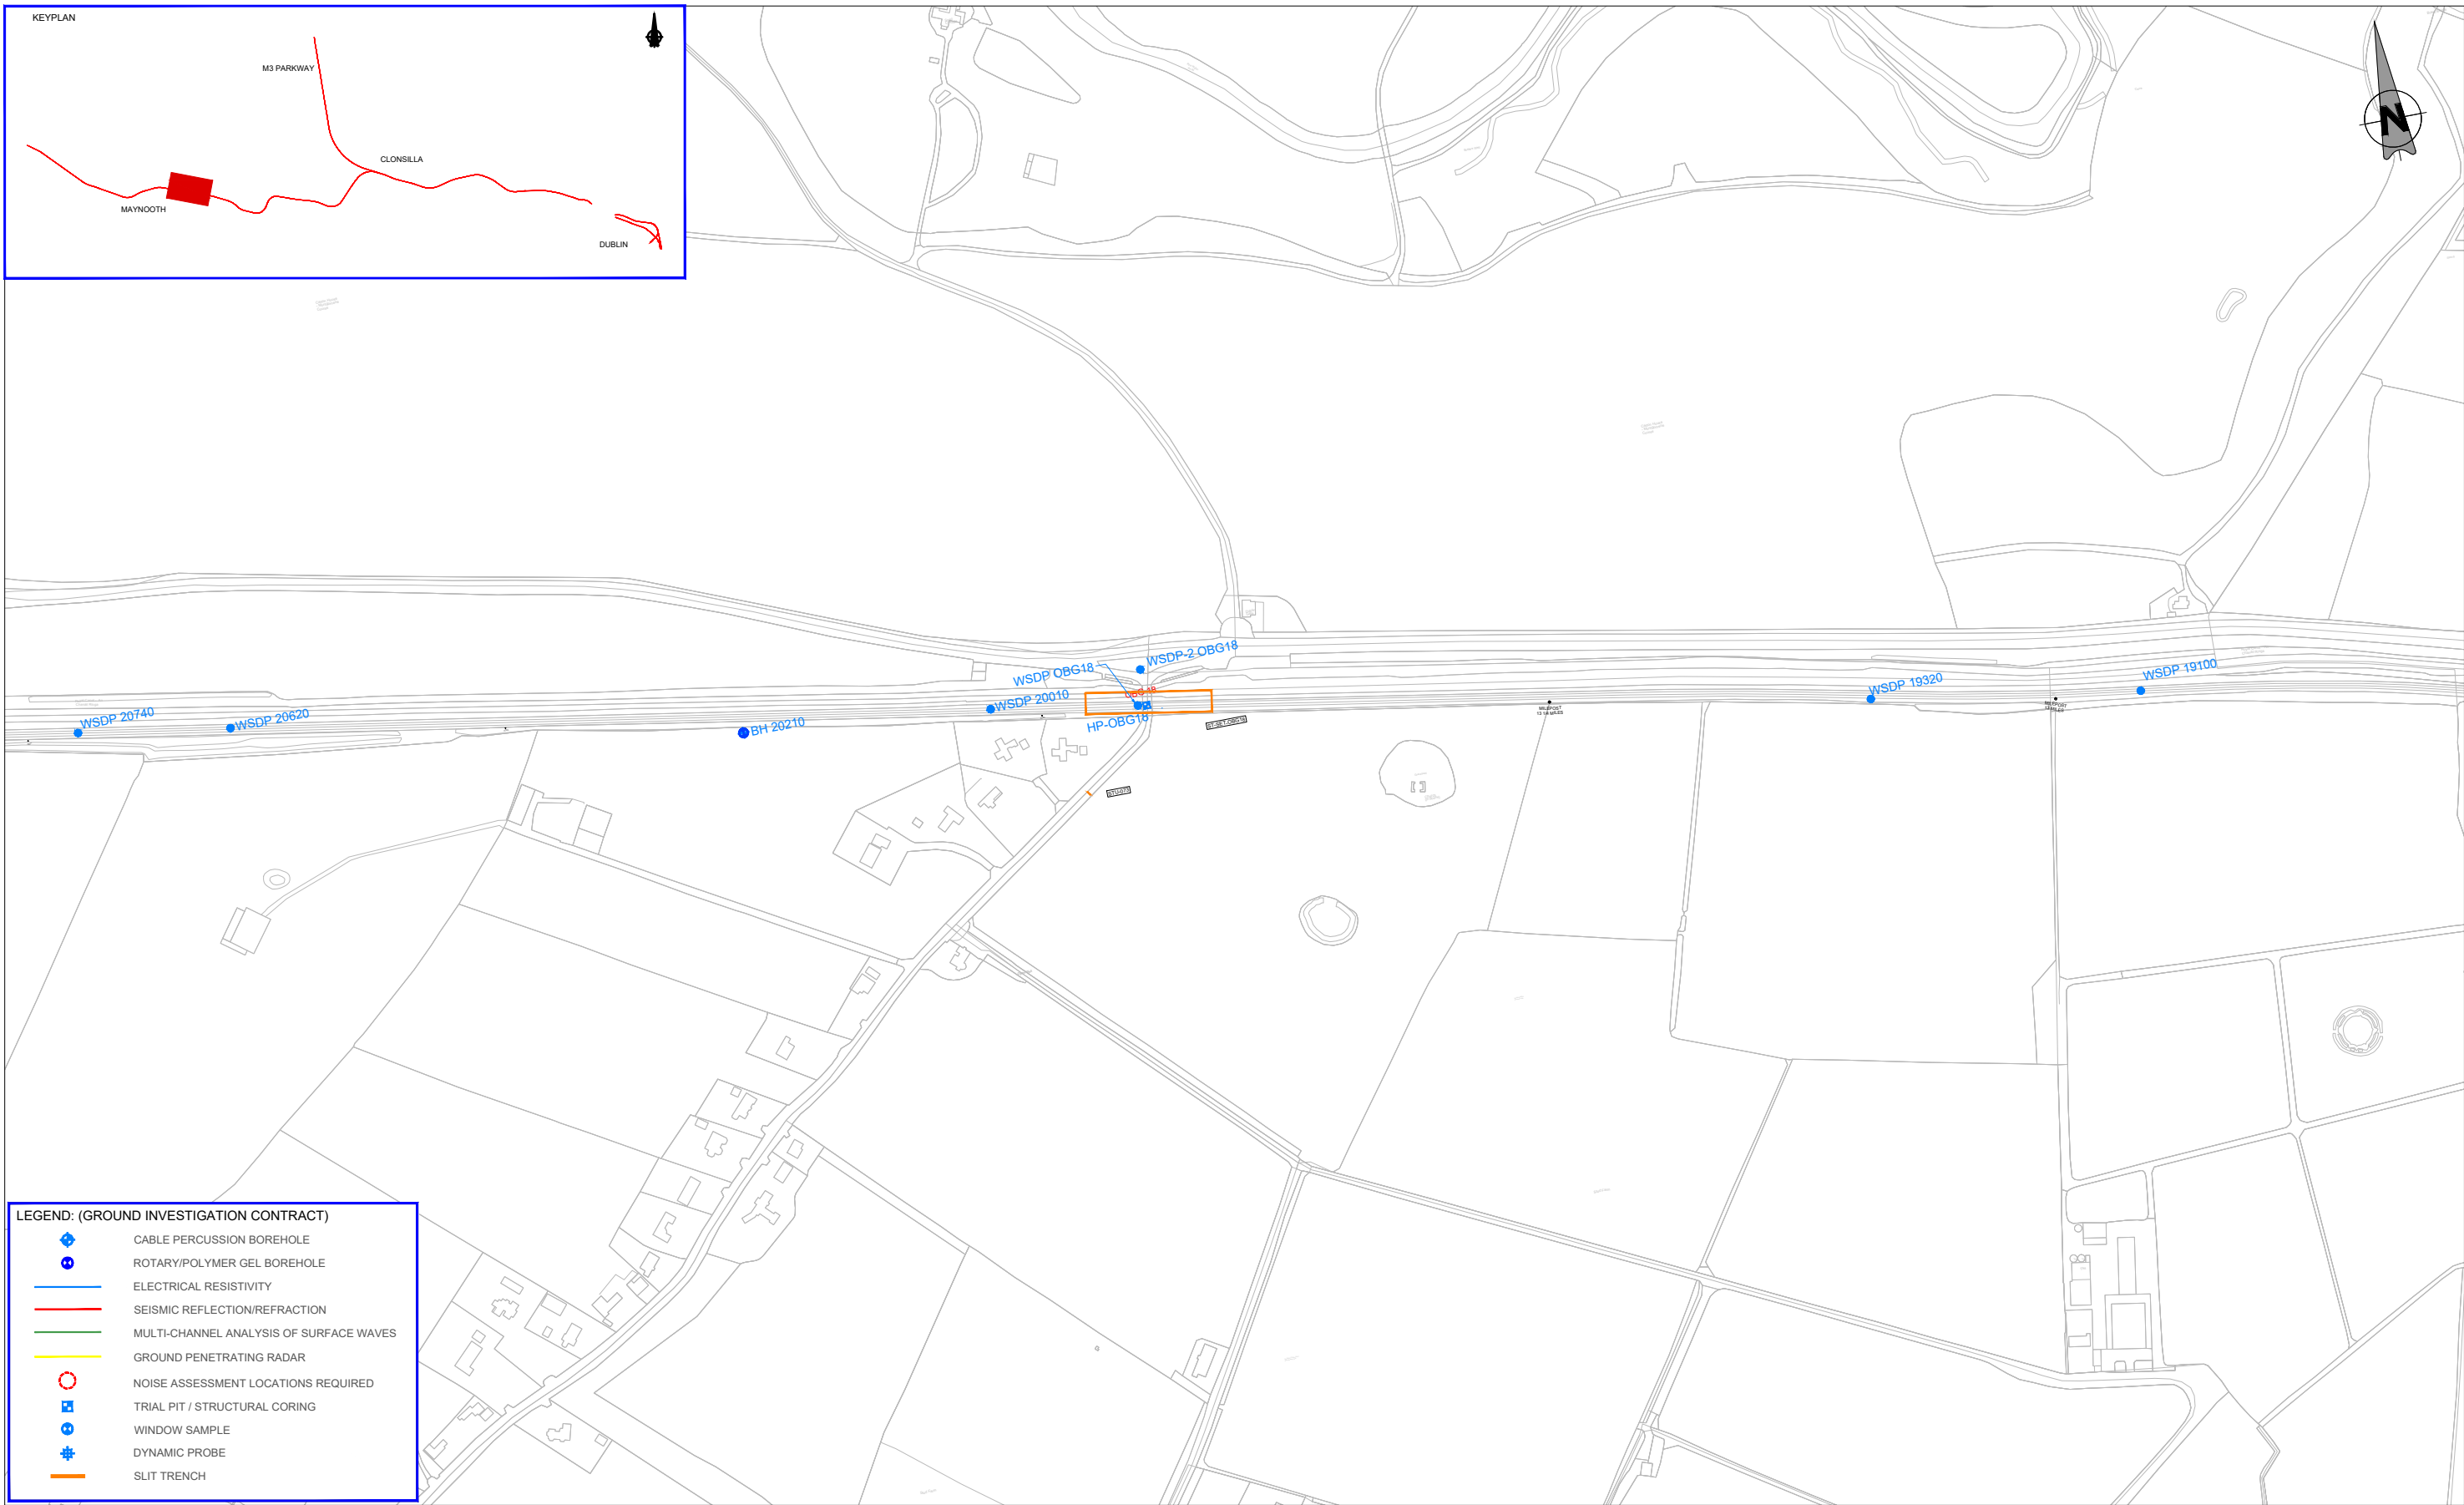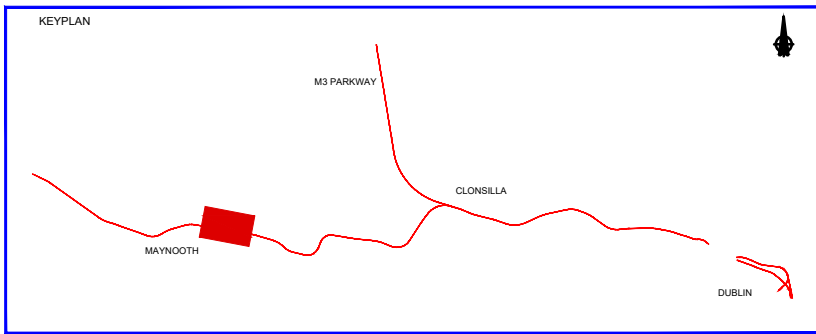

LEGEND: (GROUND INVESTIGATION CONTRACT)

- CABLE PERCUSSION BOREHOLE
- ROTARY/POLYMER GEL BOREHOLE
- ELECTRICAL RESISTIVITY
- SEISMIC REFLECTION/REFRACTION
- MULTI-CHANNEL ANALYSIS OF SURFACE WAVES
- GROUND PENETRATING RADAR
- NOISE ASSESSMENT LOCATIONS REQUIRED
- TRIAL PIT / STRUCTURAL CORING
- WINDOW SAMPLE
- DYNAMIC PROBE
- SLIT TRENCH

REV	DATE	DESCRIPTION	PRODUCED BY	REVIEWED BY	APPROVED BY
V01	May 2022	PLANNING ISSUE	MAH	MAH	MK

© Irish Rail (2021). This drawing is confidential and the copyright in it is owned by Irish Rail. This drawing must not be either loaned, copied or otherwise reproduced in whole or in part or used for any purpose without the prior permission of Irish Rail.
 © Ordnance Survey Ireland and Government of Ireland. All O.S. data used for plans are printed under "Copyright Ordnance Survey Ireland".
 Survey No. 0039721 (OSI Aerial Data or OSI Lidar Data) & Survey No. 2021081_NMA_180 (OSI Vector Data).
 All elevations are in metres and relate to OSI Geoid Model (OSGM02) Mean Head as defined by existing Project Control.
 All Co-ordinates are in Irish Transverse Mercator Grid (ITM) as defined by OSI active GPS station Tallaght College (TLLO).

Client

Consultant

Project




Drawing Title

GROUND INVESTIGATION AS-BUILT LOCATIONS SHEET 15

Scale: 1:2,500 @ A1 1:5,000 @ A3

Drawing Number | Project | Originator | Discipline | Location | Type | Role | Number | Phase
 MAY MDC GEO ROUT DR G 96015 D

Date: May 2022 | Job No: P/101086 | Status: F1 - Approved & Accepted | Rev: V 01 | Sheet: 15 of 24

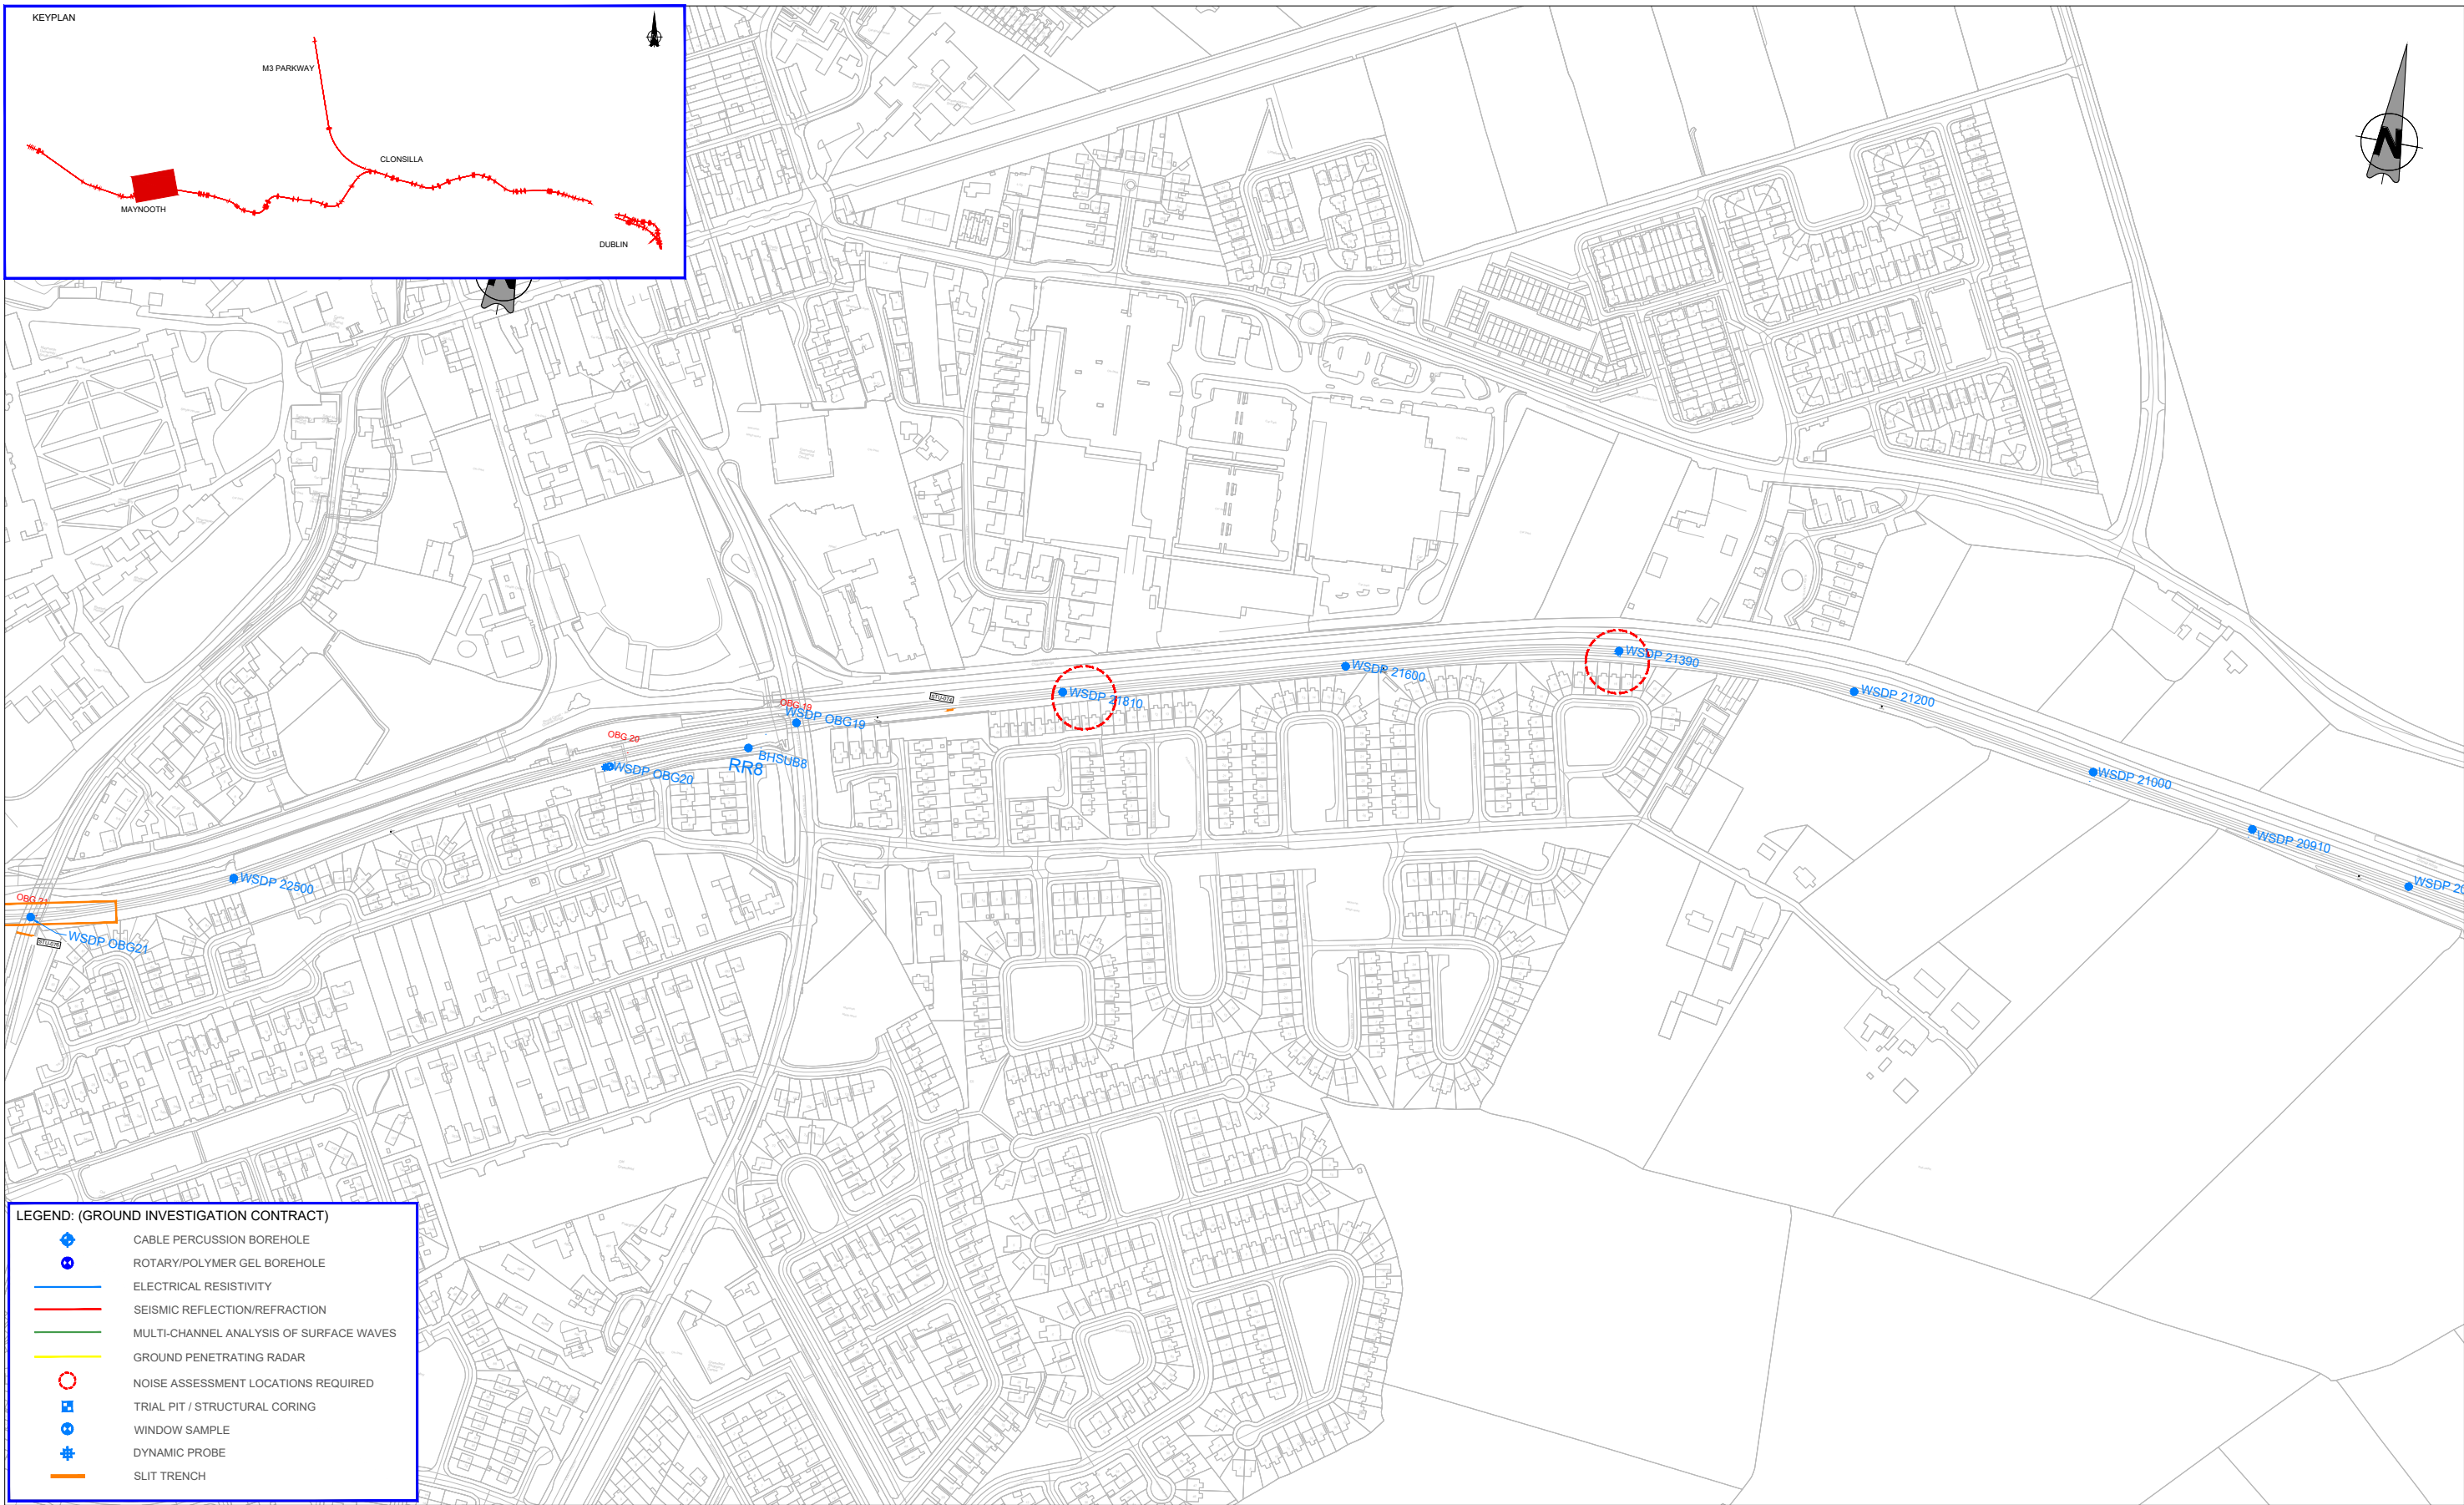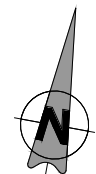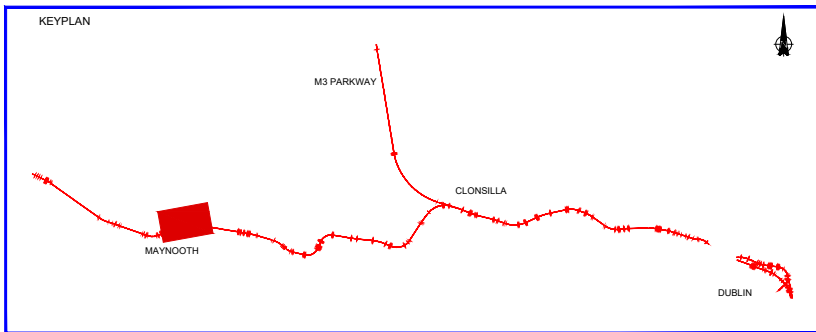

LEGEND: (GROUND INVESTIGATION CONTRACT)

- CABLE PERCUSSION BOREHOLE
- ROTARY/POLYMER GEL BOREHOLE
- ELECTRICAL RESISTIVITY
- SEISMIC REFLECTION/REFRACTION
- MULTI-CHANNEL ANALYSIS OF SURFACE WAVES
- GROUND PENETRATING RADAR
- NOISE ASSESSMENT LOCATIONS REQUIRED
- TRIAL PIT / STRUCTURAL CORING
- WINDOW SAMPLE
- DYNAMIC PROBE
- SLIT TRENCH

REV	DATE	DESCRIPTION	MAH	MAH	MK
V01	May 2022	PLANNING ISSUE			
<small>© Irish Rail (2021). This drawing is confidential and the copyright in it is owned by Irish Rail. This drawing must not be either loaned, copied or otherwise reproduced in whole or in part or used for any purpose without the prior permission of Irish Rail. © Ordnance Survey Ireland and Government of Ireland. All O.S. data used for plans are printed under "Copyright Ordnance Survey Ireland". Survey No. 0039721 (OS Aerial Data or OS Lidar Data) & Survey No. 2021/081_NMA_180 (OS Vector Data). All elevations are in metres and relate to OS Geoid Model (OSGM02) Mean Head as defined by existing Project Control. All Co-ordinates are in Irish Transverse Mercator Grid (ITM) as defined by OSi active GPS station Tallaght College (TLG0).</small>					

Client

Consultant

Project

Drawing Title



GROUND INVESTIGATION AS-BUILT LOCATIONS SHEET 16

Scale: 1:2,500 @ A1 1:5,000 @ A3

Drawing Number | Project | Originator | Discipline | Location | Type | Role | Number | Phase

MAY MDC GEO ROUT DR G 96016 D

Date: May 2022 Job No: P/101086 Status: F1 - Approved & Accepted Rev: V 01 Sheet: 16 of 24

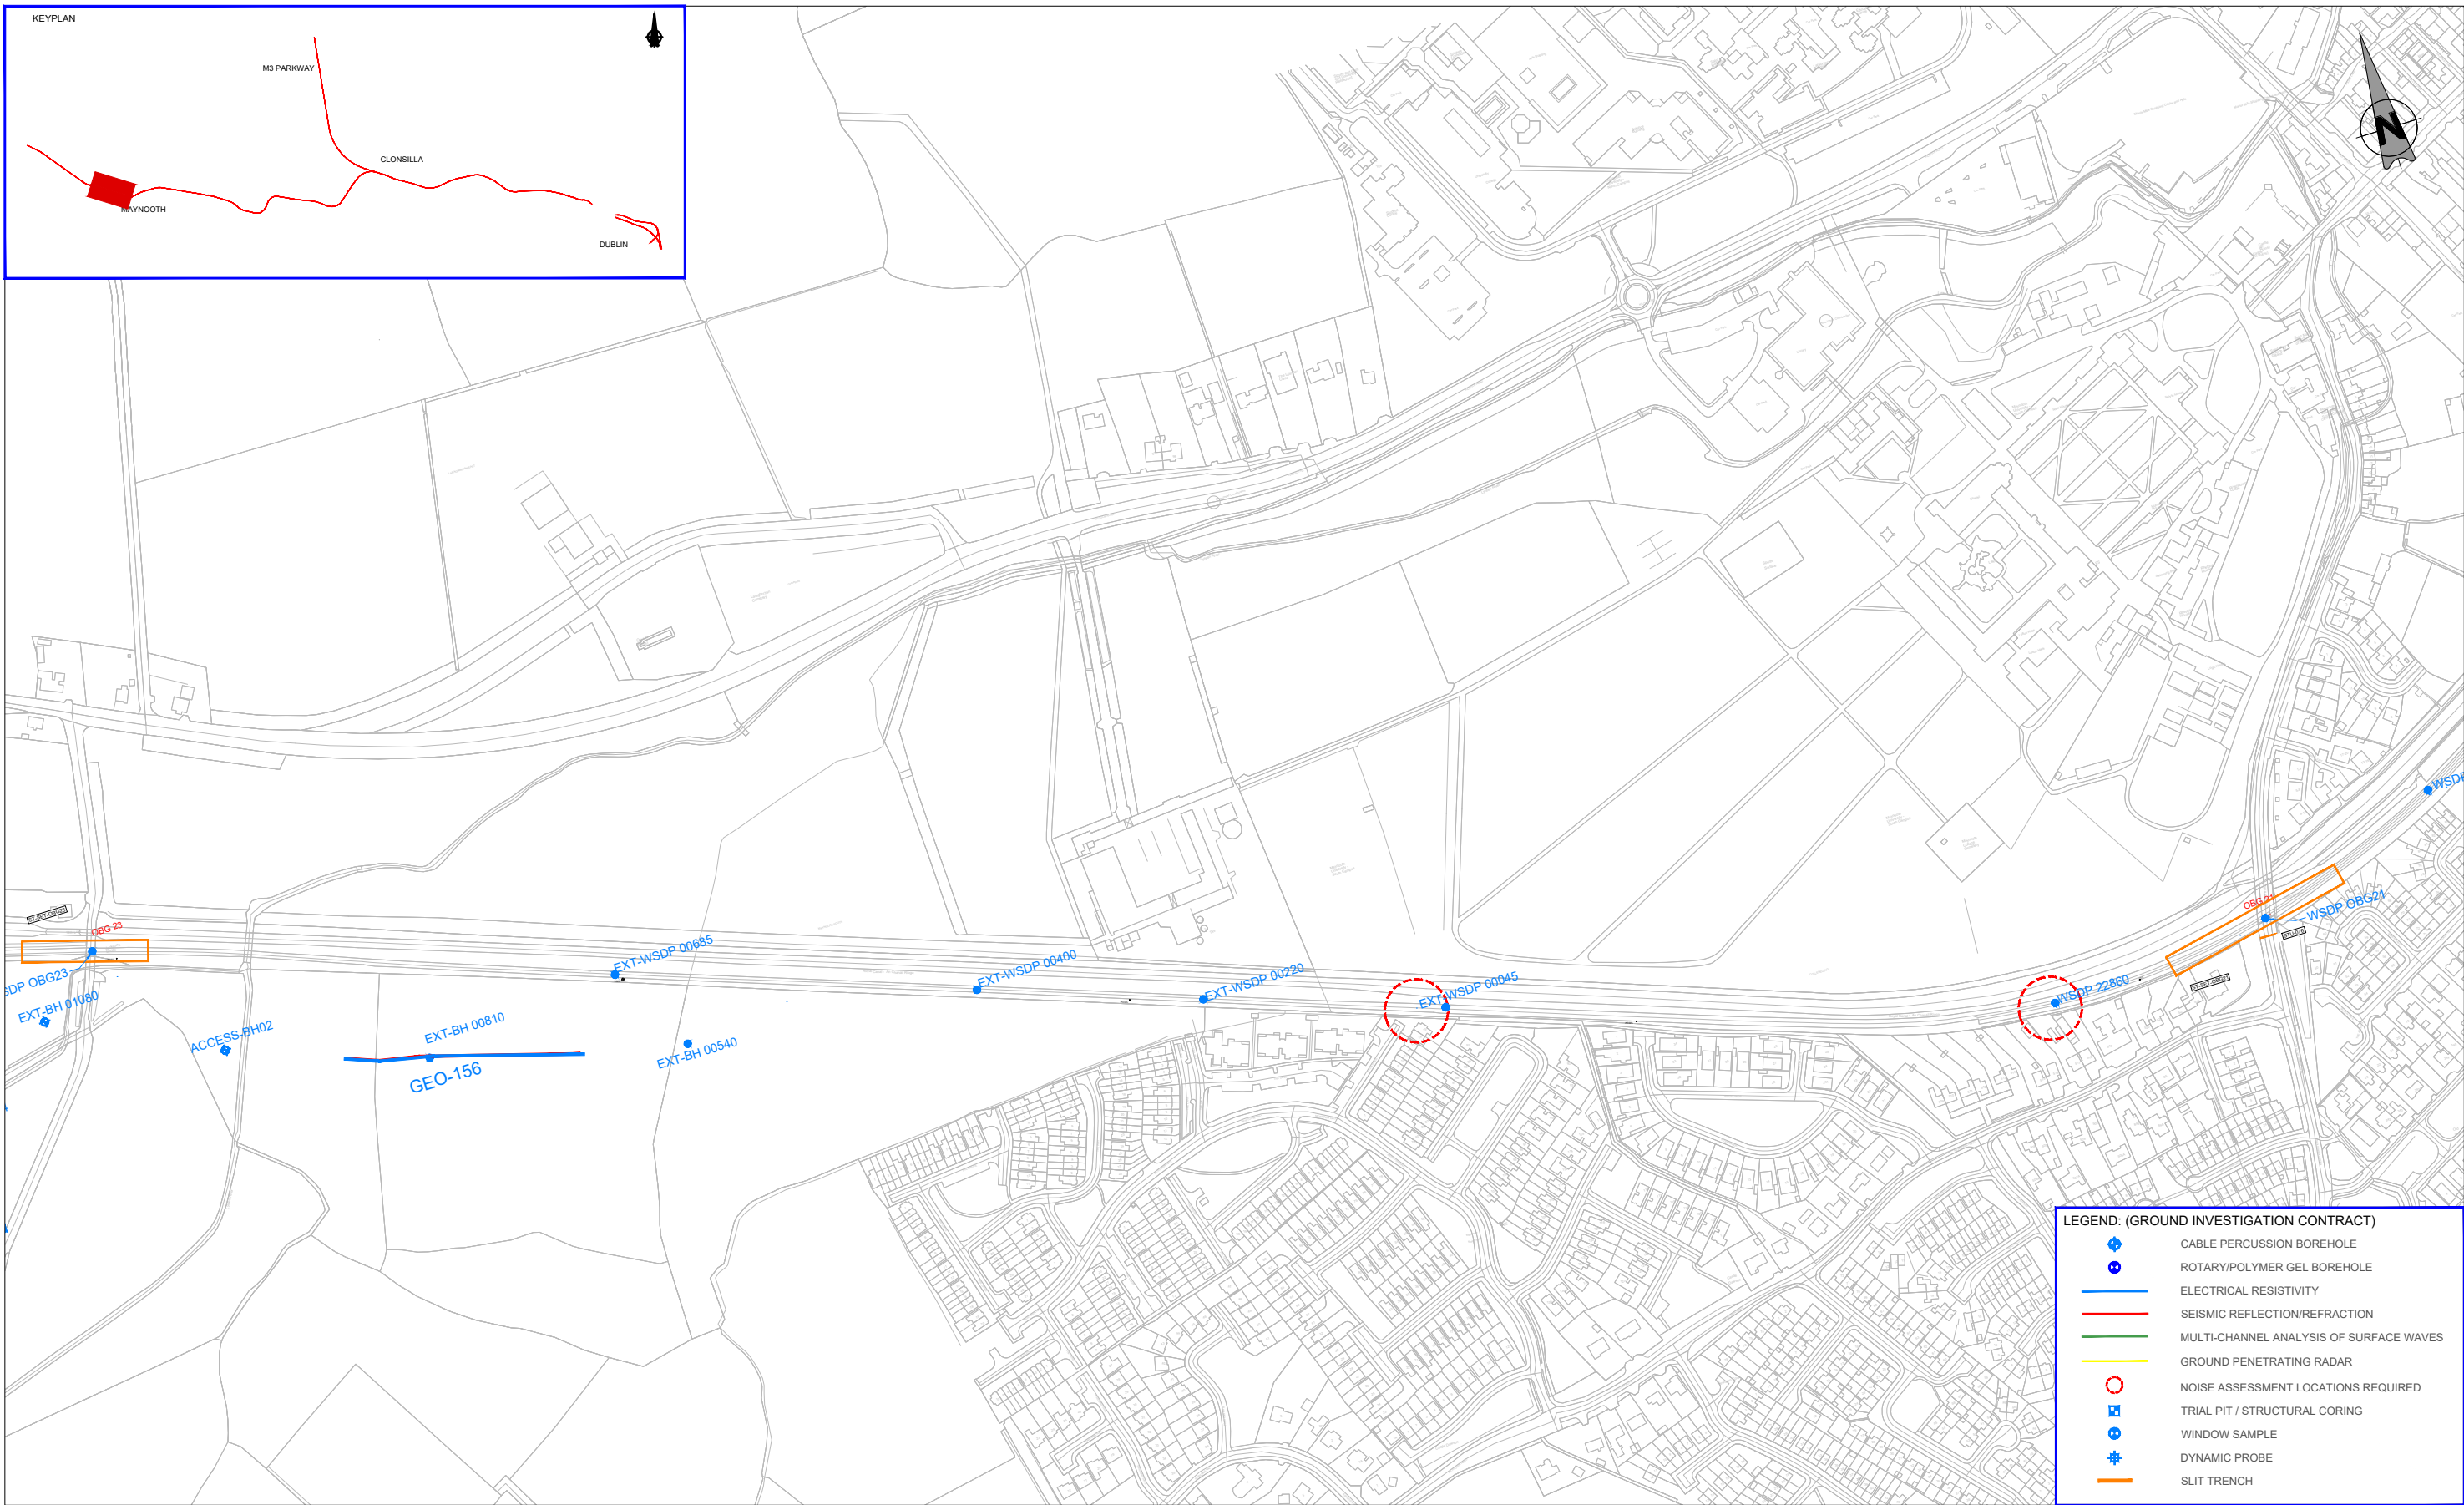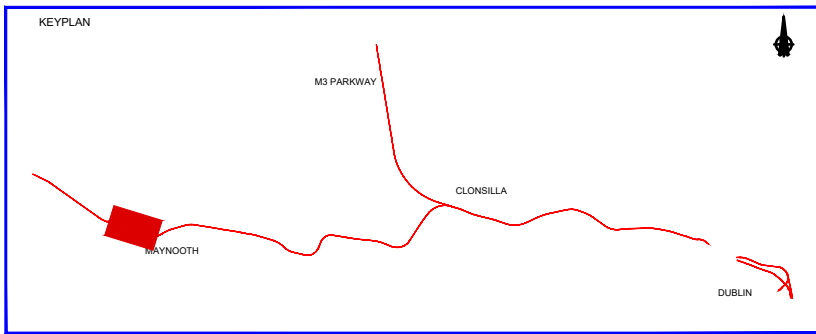

LEGEND: (GROUND INVESTIGATION CONTRACT)

- CABLE PERCUSSION BOREHOLE
- ROTARY/POLYMER GEL BOREHOLE
- ELECTRICAL RESISTIVITY
- SEISMIC REFLECTION/REFRACTION
- MULTI-CHANNEL ANALYSIS OF SURFACE WAVES
- GROUND PENETRATING RADAR
- NOISE ASSESSMENT LOCATIONS REQUIRED
- TRIAL PIT / STRUCTURAL CORING
- WINDOW SAMPLE
- DYNAMIC PROBE
- SLIT TRENCH

REV	DATE	DESCRIPTION	PRODUCED BY	REVIEWED BY	APPROVED BY
V01	May 2022	PLANNING ISSUE	MAH	MAH	MK

© Irish Rail (2021). This drawing is confidential and the copyright in it is owned by Irish Rail. This drawing must not be either loaned, copied or otherwise reproduced in whole or in part or used for any purpose without the prior permission of Irish Rail.
 © Ordnance Survey Ireland and Government of Ireland. All O.S. data used for plans are printed under "Copyright Ordnance Survey Ireland".
 Survey No. 0039721 (OSi Aerial Data or OSi Lidar Data) & Survey No. 2021/OSi_NMA_180 (OSi Vector Data).
 All elevations are in metres and relate to OSi Geoid Model (OSGM02) Malin Head as defined by existing Project Contract.
 All Co-ordinates are in Irish Transverse Mercator Grid (ITM) as defined by OSi active GPS station Tallaght College (TLG0).

Client

Consultant

Project



Drawing Title

GROUND INVESTIGATION AS-BUILT LOCATIONS SHEET 17

Scale: 1:2,500 @ A1 1:5,000 @ A3

Drawing Number | Project | Originator | Discipline | Location | Type | Role | Number | Phase
 MAY MDC GEO ROUT DR G 96017 D

Date: May 2022 | Job No: P/101086 | Status: F1 - Approved & Accepted | Rev: V 01 | Sheet: 17 of 24

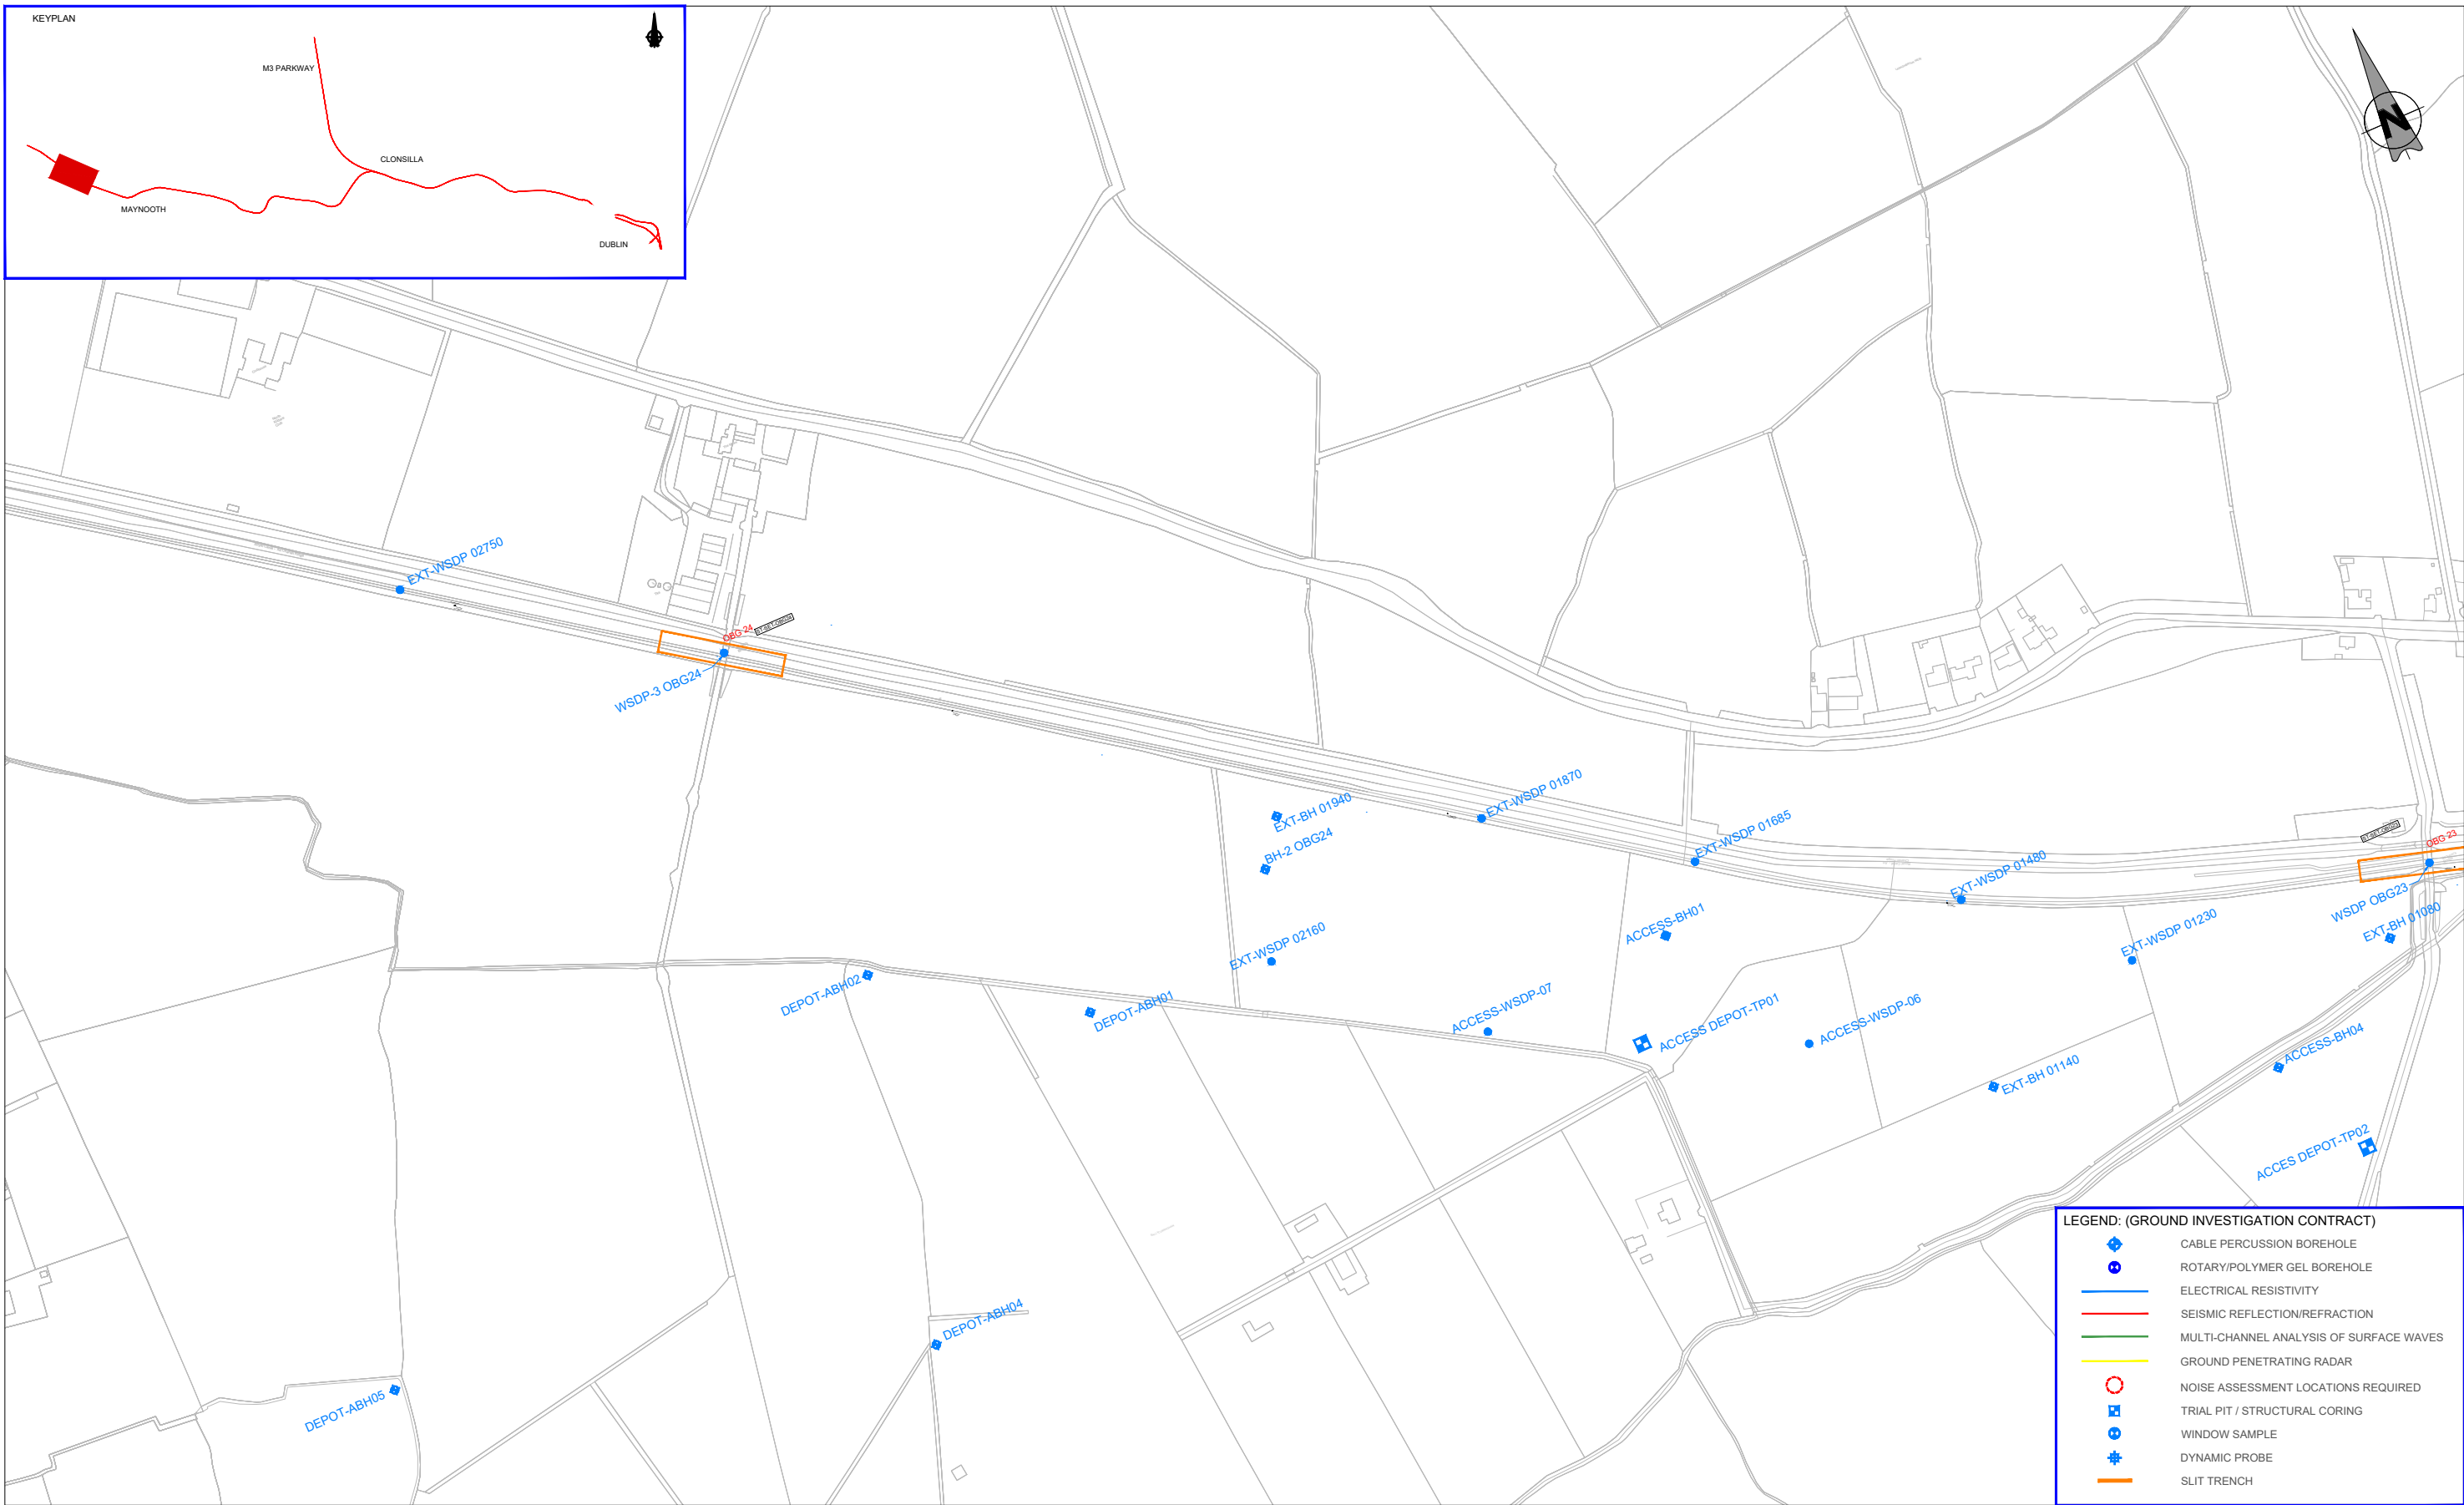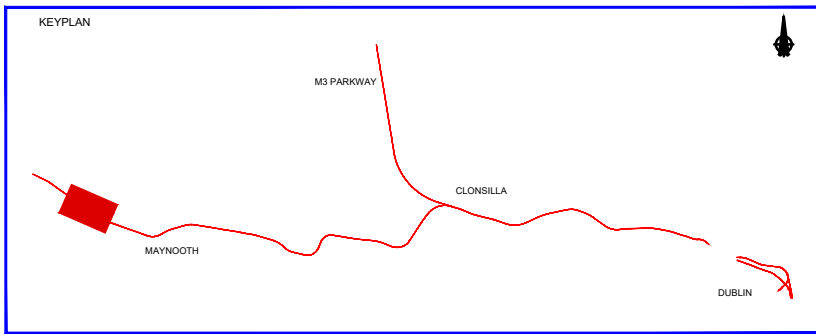

LEGEND: (GROUND INVESTIGATION CONTRACT)

- CABLE PERCUSSION BOREHOLE
- ROTARY/POLYMER GEL BOREHOLE
- ELECTRICAL RESISTIVITY
- SEISMIC REFLECTION/REFRACTION
- MULTI-CHANNEL ANALYSIS OF SURFACE WAVES
- GROUND PENETRATING RADAR
- NOISE ASSESSMENT LOCATIONS REQUIRED
- TRIAL PIT / STRUCTURAL CORING
- WINDOW SAMPLE
- DYNAMIC PROBE
- SLIT TRENCH

REV	DATE	DESCRIPTION	PRODUCED BY	REVIEWED BY	APPROVED BY
V01	May 2022	PLANNING ISSUE	MAH	MAH	MK

© Irish Rail (2021). This drawing is confidential and the copyright in it is owned by Irish Rail. This drawing must not be either loaned, copied or otherwise reproduced in whole or in part or used for any purpose without the prior permission of Irish Rail.
 © Ordnance Survey Ireland and Government of Ireland. All O.S. data used for plans are printed under "Copyright Ordnance Survey Ireland".
 Survey No. 6039721 (OSi Aerial Data or OSi Lidar Data) & Survey No. 2021081_NMA_180 (OSi Vector Data).
 All elevations are in metres and relate to OSi Geoid Model (OSGM02) Malin Head as defined by existing Project Control.
 All Co-ordinates are in Irish Transverse Mercator Grid (ITM) as defined by OSi active GPS station Tallaght College (TLG0).

Client

Consultant

Project




Drawing Title

GROUND INVESTIGATION AS-BUILT LOCATIONS SHEET 18

Scale: 1:2,500 @ A1 1:5,000 @ A3

Drawing Number | Project | Originator | Discipline | Location | Type | Role | Number | Phase
 MAY MDC GEO ROUT DR G 96018 D

Date: May 2022 Job No: P/101086 Status: F1 - Approved & Accepted Rev: V 01 Sheet: 18 of 24

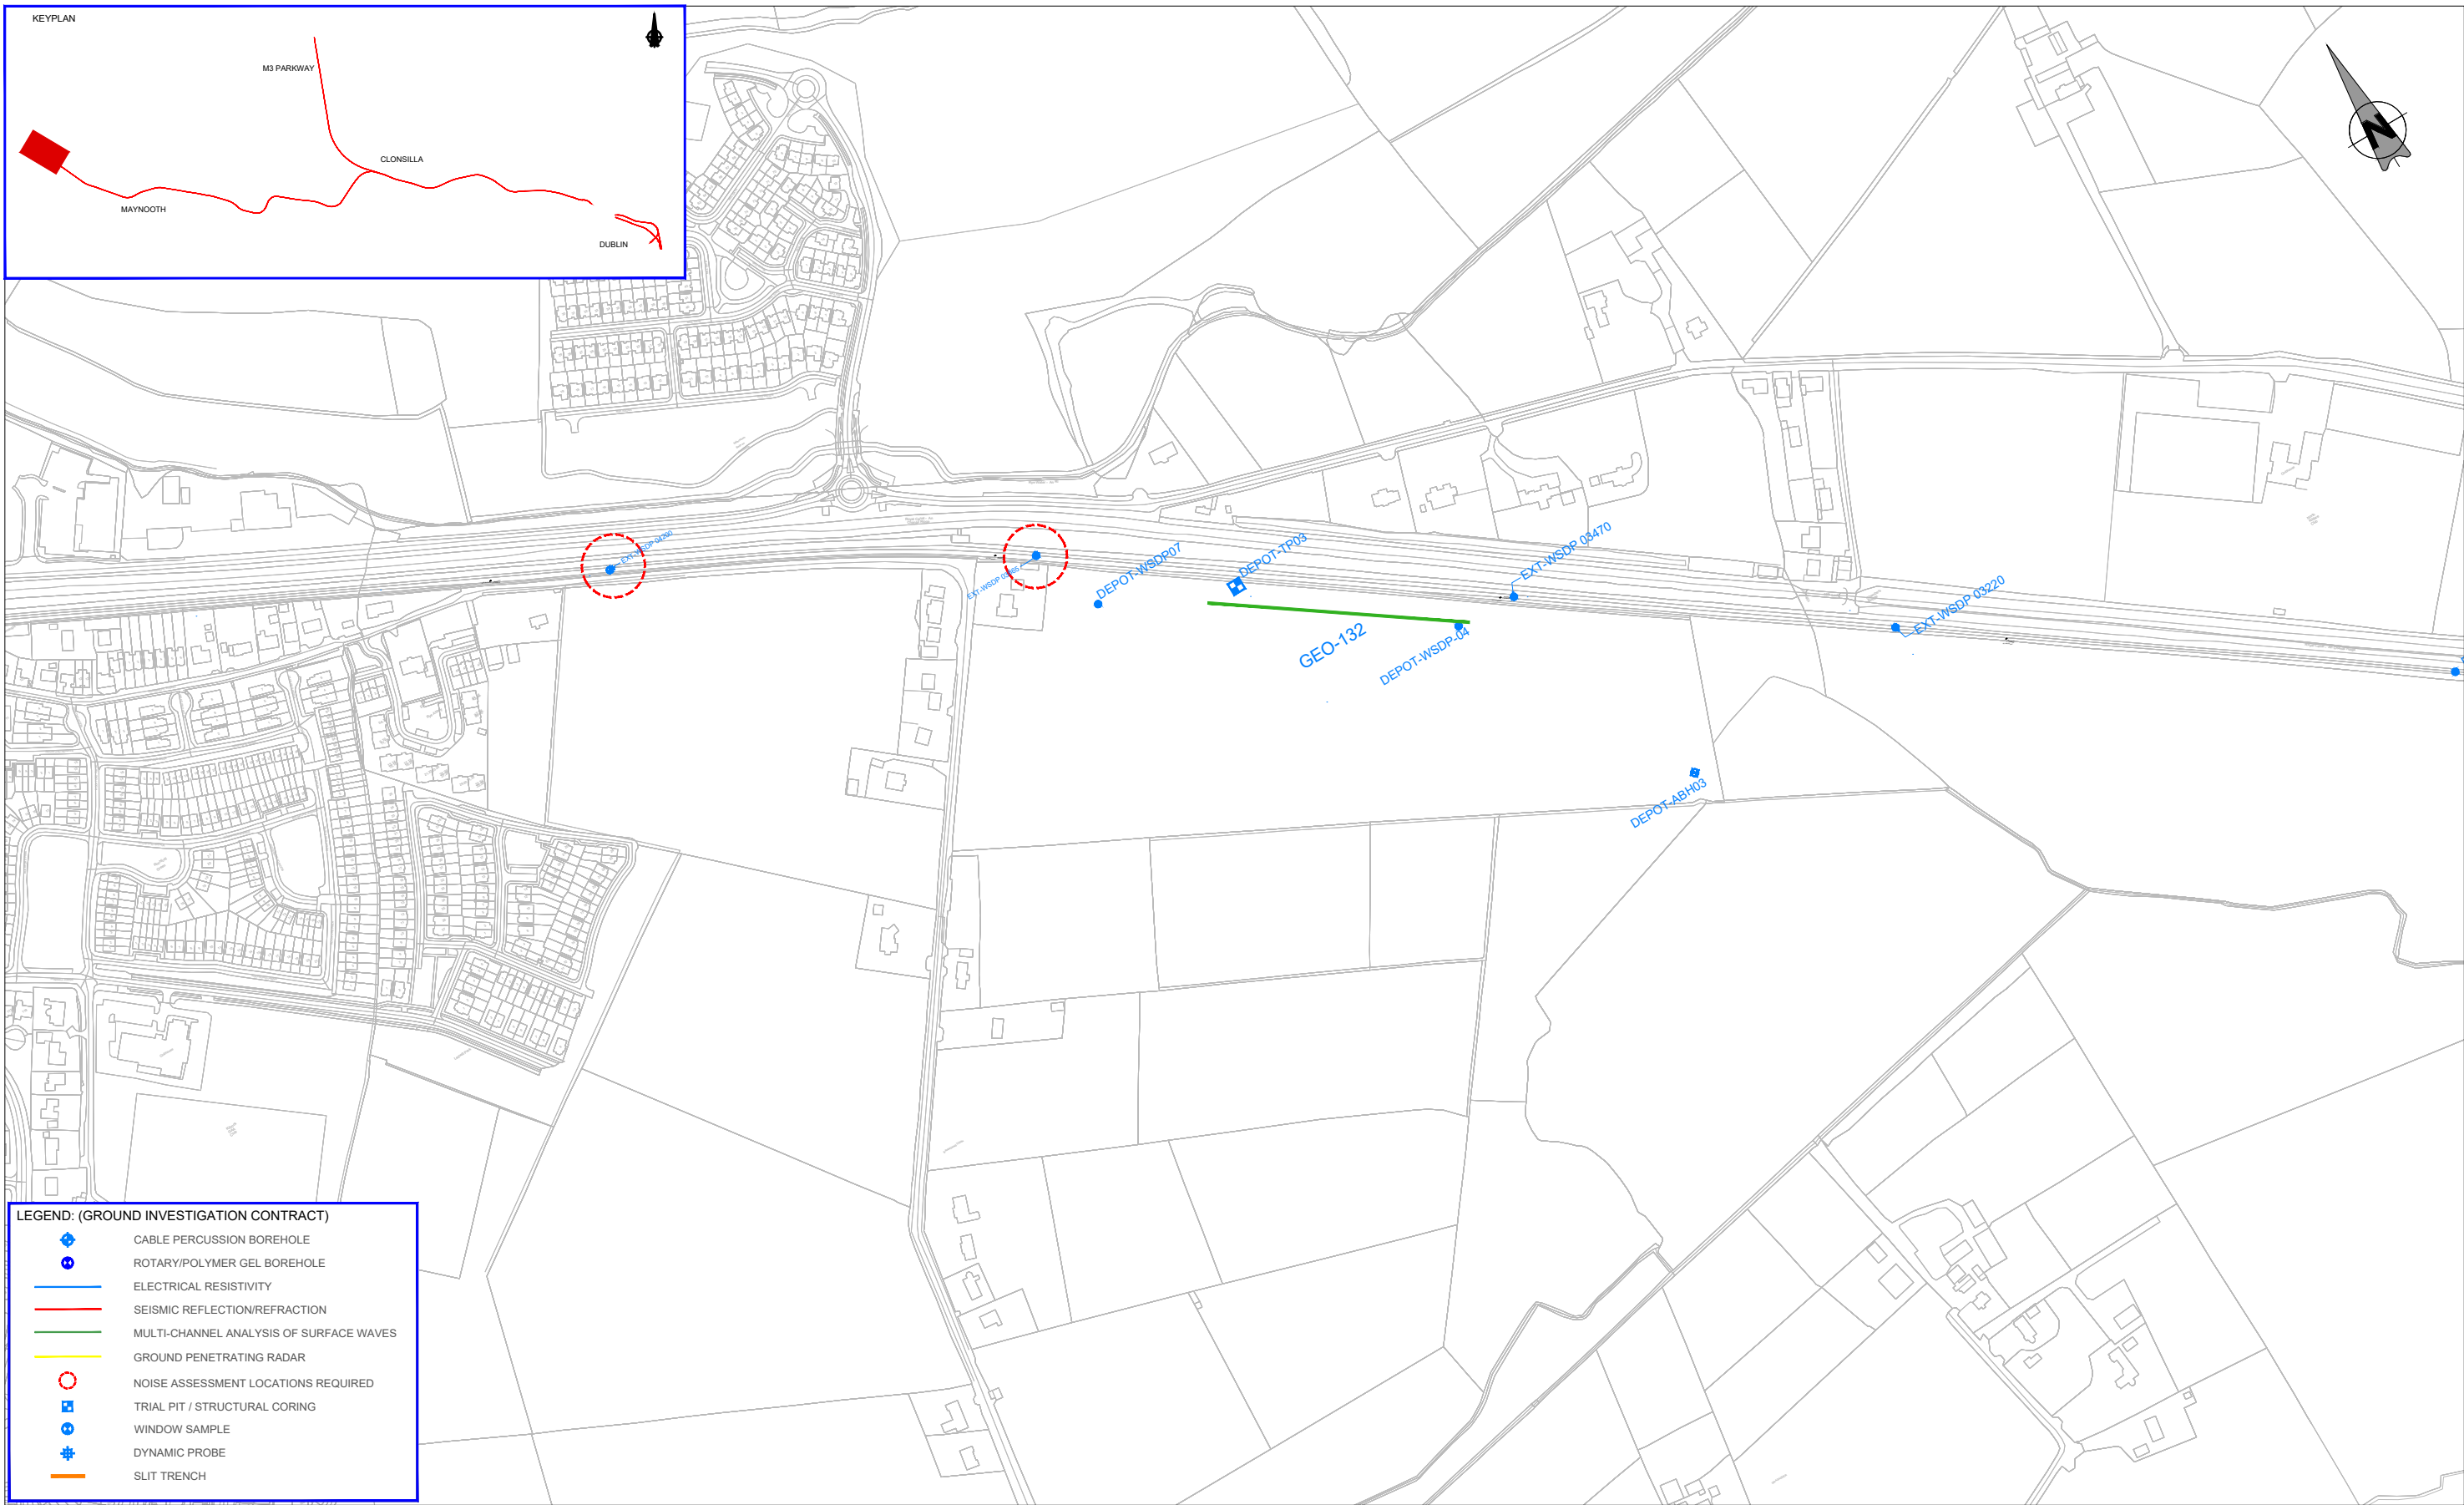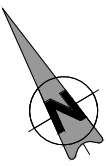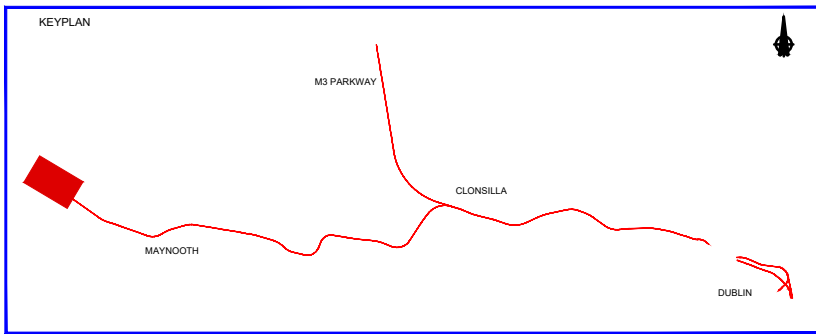

LEGEND: (GROUND INVESTIGATION CONTRACT)

- CABLE PERCUSSION BOREHOLE
- ROTARY/POLYMER GEL BOREHOLE
- ELECTRICAL RESISTIVITY
- SEISMIC REFLECTION/REFRACTION
- MULTI-CHANNEL ANALYSIS OF SURFACE WAVES
- GROUND PENETRATING RADAR
- NOISE ASSESSMENT LOCATIONS REQUIRED
- TRIAL PIT / STRUCTURAL CORING
- WINDOW SAMPLE
- DYNAMIC PROBE
- SLIT TRENCH

REV	DATE	DESCRIPTION	MAH	MAH	MK
V01	May 2022	PLANNING ISSUE			
PRODUCED BY			REVIEWED BY		
APPROVED BY					

© Irish Rail (2021). This drawing is confidential and the copyright in it is owned by Irish Rail. This drawing must not be either loaned, copied or otherwise reproduced in whole or in part or used for any purpose without the prior permission of Irish Rail.
 © Ordnance Survey Ireland and Government of Ireland. All O.S. data used for plans are printed under "Copyright Ordnance Survey Ireland".
 Survey No. 0039721 (OSi Aerial Data or OSi Lidar Data) & Survey No. 2021/OSI_NMA_180 (OSi Vector Data).
 All elevations are in metres and relate to OSi Geoid Model (OSGM02) Malin Head as defined by existing Project Control.
 All Co-ordinates are in Irish Transverse Mercator Grid (ITM) as defined by OSi active GPS station Tallaght College (TLG0).

Client

Consultant

Project



Drawing Title

GROUND INVESTIGATION AS-BUILT LOCATIONS SHEET 19

Scale: 1:2,500 @ A1 1:5,000 @ A3

Drawing Number | Project | Originator | Discipline | Location | Type | Role | Number | Phase
 MAY MDC GEO ROUT DR G 96019 D

Date: May 2022 | Job No: P/101086 | Status: F1 - Approved & Accepted | Rev: V 01 | Sheet: 19 of 24

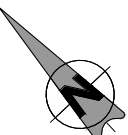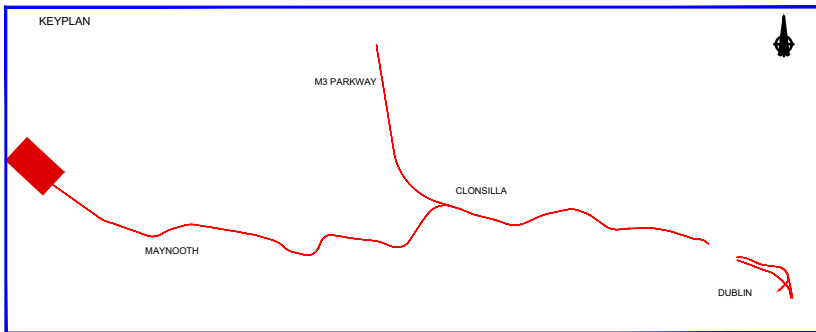

LEGEND: (GROUND INVESTIGATION CONTRACT)

- CABLE PERCUSSION BOREHOLE
- ROTARY/POLYMER GEL BOREHOLE
- ELECTRICAL RESISTIVITY
- SEISMIC REFLECTION/REFRACTION
- MULTI-CHANNEL ANALYSIS OF SURFACE WAVES
- GROUND PENETRATING RADAR
- NOISE ASSESSMENT LOCATIONS REQUIRED
- TRIAL PIT / STRUCTURAL CORING
- WINDOW SAMPLE
- DYNAMIC PROBE
- SLIT TRENCH

REV	DATE	DESCRIPTION	PRODUCED BY	REVIEWED BY	APPROVED BY
V01	May 2022	PLANNING ISSUE	MAH	MAH	MK

© Irish Rail (2021). This drawing is confidential and the copyright in it is owned by Irish Rail. This drawing must not be either loaned, copied or otherwise reproduced in whole or in part or used for any purpose without the prior permission of Irish Rail.
 © Ordnance Survey Ireland and Government of Ireland. All O.S. data used for plans are printed under "Copyright Ordnance Survey Ireland".
 Survey No. 6039721 (OSI Aerial Data or OSi Lidar Data) & Survey No. 2021/081_NMA_180 (OSi Vector Data).
 All elevations are in metres and relate to OSi Geoid Model (OSGM02) Malin Head as defined by existing Project Control.
 All Co-ordinates are in Irish Transverse Mercator Grid (ITM) as defined by OSi active GPS station Tallaght College (TLLO).

Client

Consultant

Project



Drawing Title

GROUND INVESTIGATION AS-BUILT LOCATIONS SHEET 20

Scale: 1:2,500 @ A1 1:5,000 @ A3

Drawing Number | Project | Originator | Discipline | Location | Type | Role | Number | Phase
 MAY MDC GEO ROUT DR G 96020 D

Date: May 2022 | Job No: P/101086 | Status: F1 - Approved & Accepted | Rev: V 01 | Sheet: 20 of 24

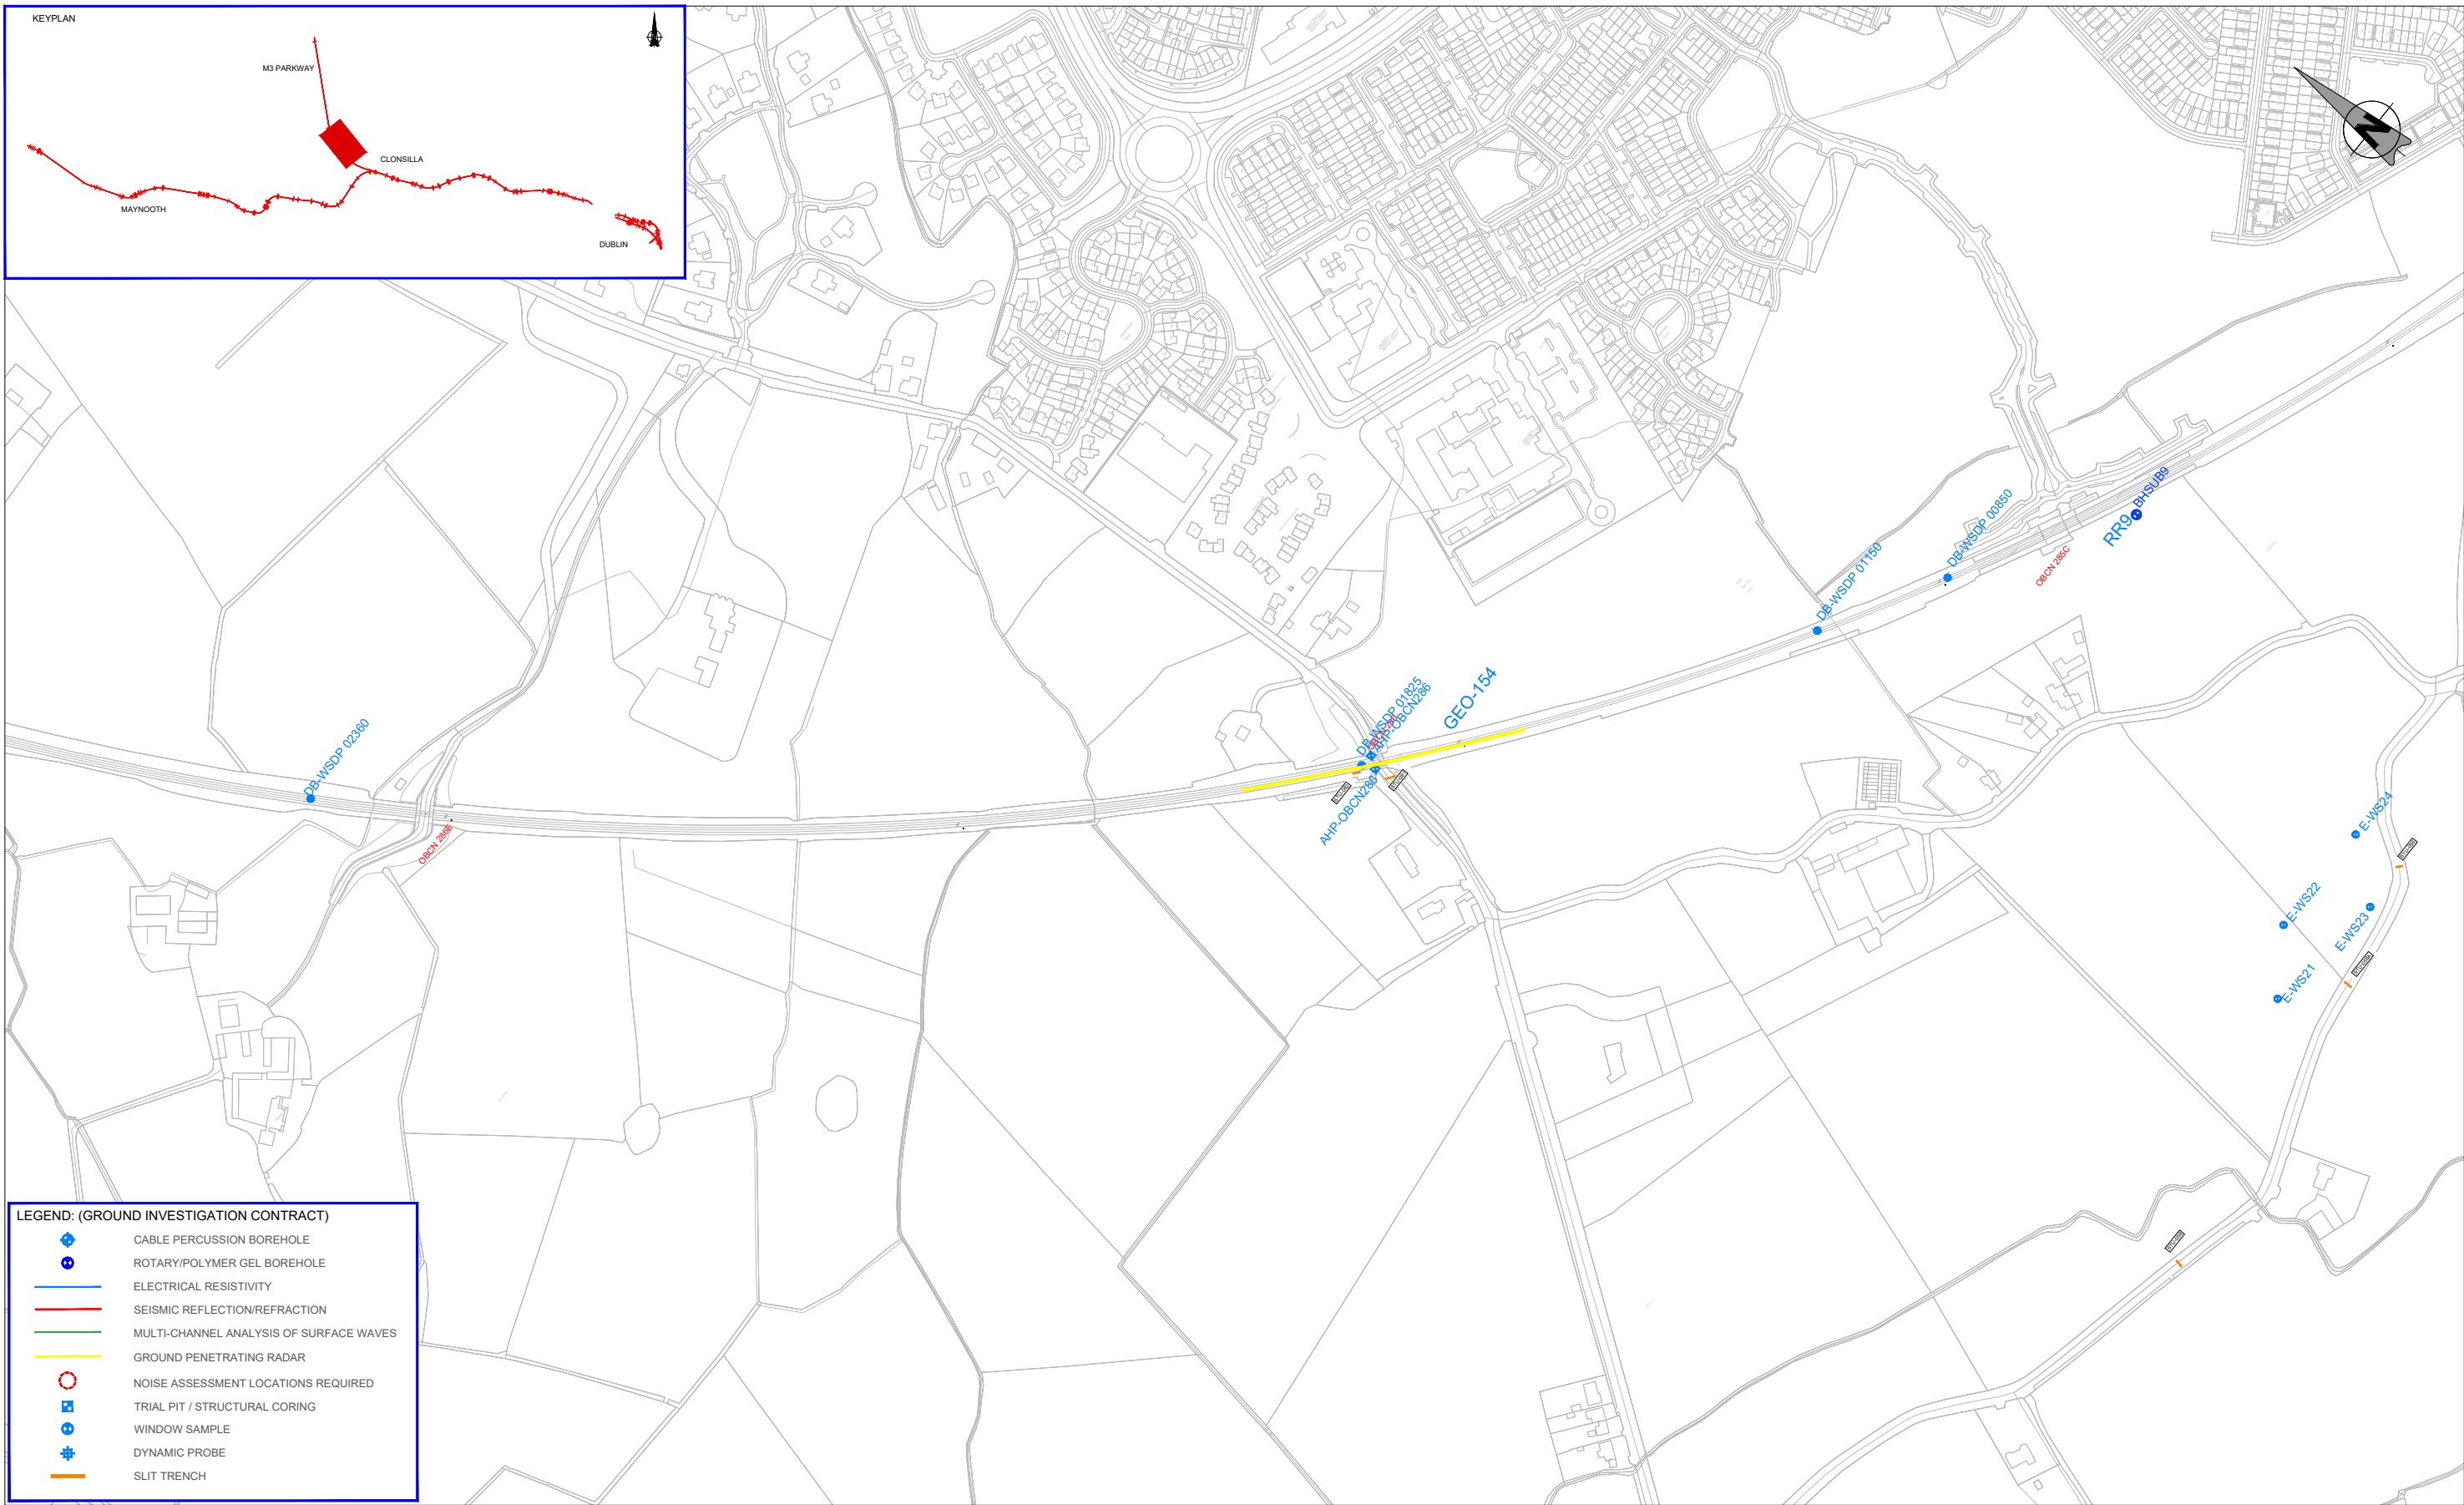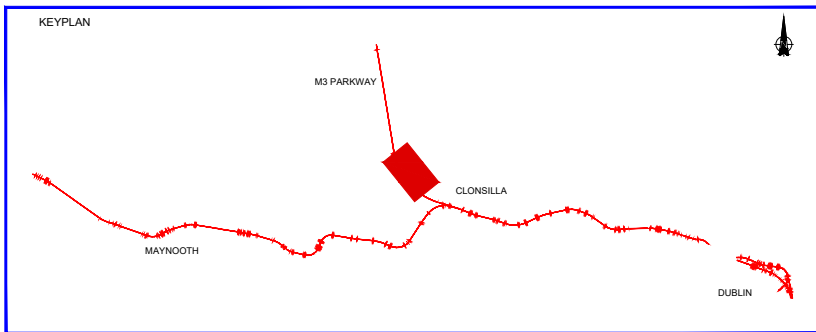

LEGEND: (GROUND INVESTIGATION CONTRACT)

- CABLE PERCUSSION BOREHOLE
- ROTARY/POLYMER GEL BOREHOLE
- ELECTRICAL RESISTIVITY
- SEISMIC REFLECTION/REFRACTION
- MULTI-CHANNEL ANALYSIS OF SURFACE WAVES
- GROUND PENETRATING RADAR
- NOISE ASSESSMENT LOCATIONS REQUIRED
- TRIAL PIT / STRUCTURAL CORING
- WINDOW SAMPLE
- DYNAMIC PROBE
- SLIT TRENCH

REV	DATE	DESCRIPTION	MAH	MAH	MK
V01	May 2022	PLANNING ISSUE			
<small>© Irish Rail (2021). This drawing is confidential and the copyright in it is owned by Irish Rail. This drawing must not be either loaned, copied or otherwise reproduced in whole or in part or used for any purpose without the prior permission of Irish Rail. © Ordnance Survey Ireland and Government of Ireland. All O.S. data used for plans are printed under "Copyright Ordnance Survey Ireland". Survey No. 6039721 (OSi Aerial Data or OSi Lidar Data) & Survey No. 2021/OSi_NMA_180 (OSi Vector Data). All elevations are in metres and relate to OSi Geoid Model (OSGM02) Malin Head as defined by existing Project Contract. All Co-ordinates are in Irish Transverse Mercator Grid (ITM) as defined by OSi active GPS station Tallaght College (TLG0).</small>					

Client

Consultant

Project



Drawing Title

GROUND INVESTIGATION AS-BUILT LOCATIONS SHEET 21







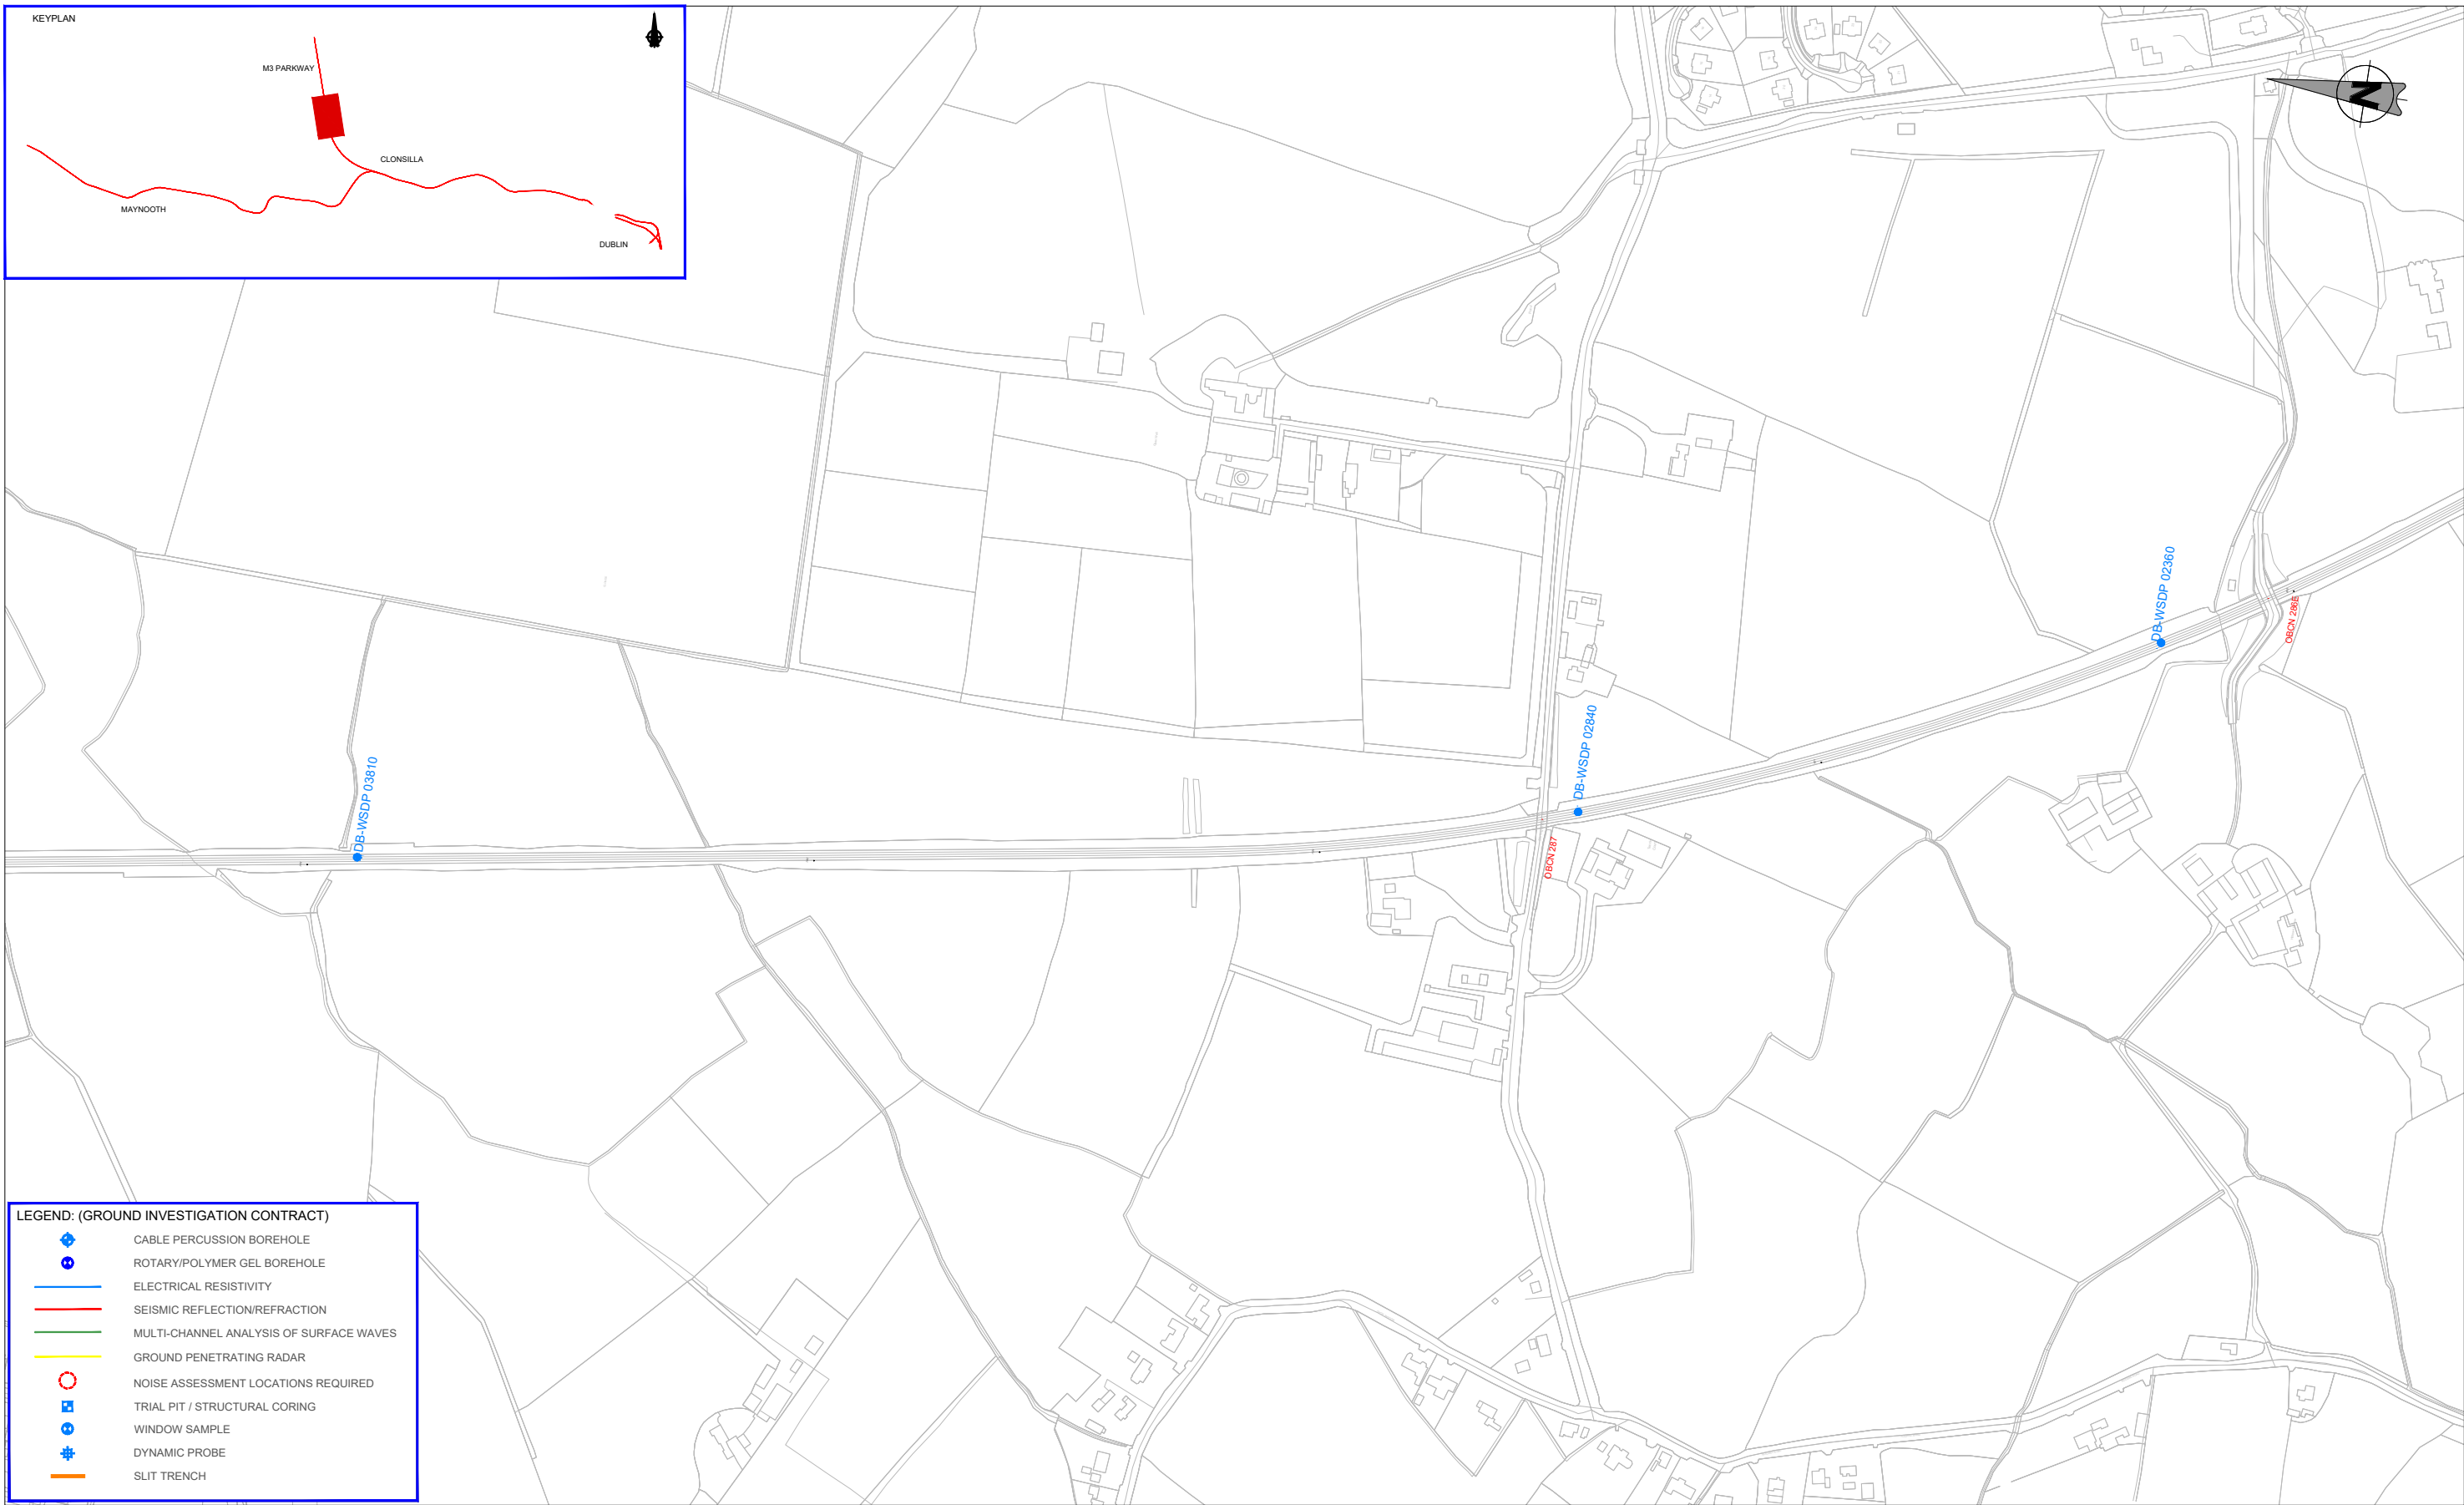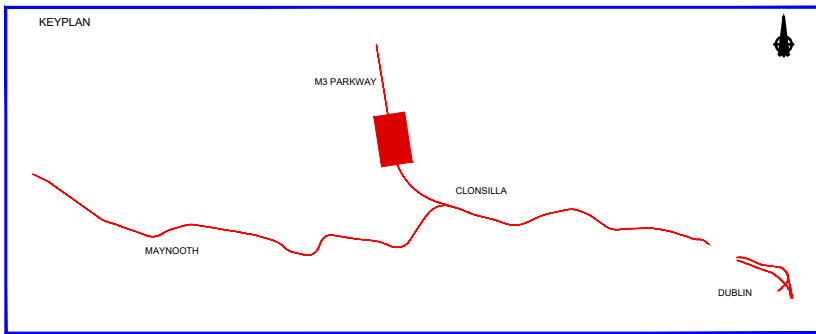




Scale: 1:2,500 @ A1 1:5,000 @ A3

Drawing Number | Project | Originator | Discipline | Location | Type | Role | Number | Phase
 MAY MDC GEO ROUT DR G 96021 D

Date: May 2022 | Job No: P/101086 | Status: F1 - Approved & Accepted | Rev: V 01 | Sheet: 21 of 24



LEGEND: (GROUND INVESTIGATION CONTRACT)

-  CABLE PERCUSSION BOREHOLE
-  ROTARY/POLYMER GEL BOREHOLE
-  ELECTRICAL RESISTIVITY
-  SEISMIC REFLECTION/REFRACTION
-  MULTI-CHANNEL ANALYSIS OF SURFACE WAVES
-  GROUND PENETRATING RADAR
-  NOISE ASSESSMENT LOCATIONS REQUIRED
-  TRIAL PIT / STRUCTURAL CORING
-  WINDOW SAMPLE
-  DYNAMIC PROBE
-  SLIT TRENCH

REV	DATE	DESCRIPTION	PRODUCED BY	REVIEWED BY	APPROVED BY
V01	May 2022	PLANNING ISSUE	MAH	MAH	MK

© Irish Rail (2021). This drawing is confidential and the copyright in it is owned by Irish Rail. This drawing must not be either loaned, copied or otherwise reproduced in whole or in part or used for any purpose without the prior permission of Irish Rail.
 © Ordnance Survey Ireland and Government of Ireland. All O.S. data used for plans are printed under "Copyright Ordnance Survey Ireland".
 Survey No. 6039721 (OSI Aerial Data or OSi Lidar Data) & Survey No. 2021081_NMA_180 (OSi Vector Data).
 All elevations are in metres and relate to OSi Geoid Model (OSGM02) Mean Head as defined by existing Project Control.
 All Co-ordinates are in Irish Transverse Mercator Grid (ITM) as defined by OSi active GPS station Tallaght College (TLG0).

Client



Consultant



Project





Drawing Title

**GROUND INVESTIGATION
AS-BUILT LOCATIONS
SHEET 22**

Scale: 1:2,500 @ A1 1:5,000 @ A3

Drawing Number | Project | Originator | Discipline | Location | Type | Role | Number | Phase
 MAY MDC GEO ROUT DR G 96022 D

Date: May 2022 | Job No: P/101086 | Status: F1 - Approved & Accepted | Rev: V 01 | Sheet: 22 of 24

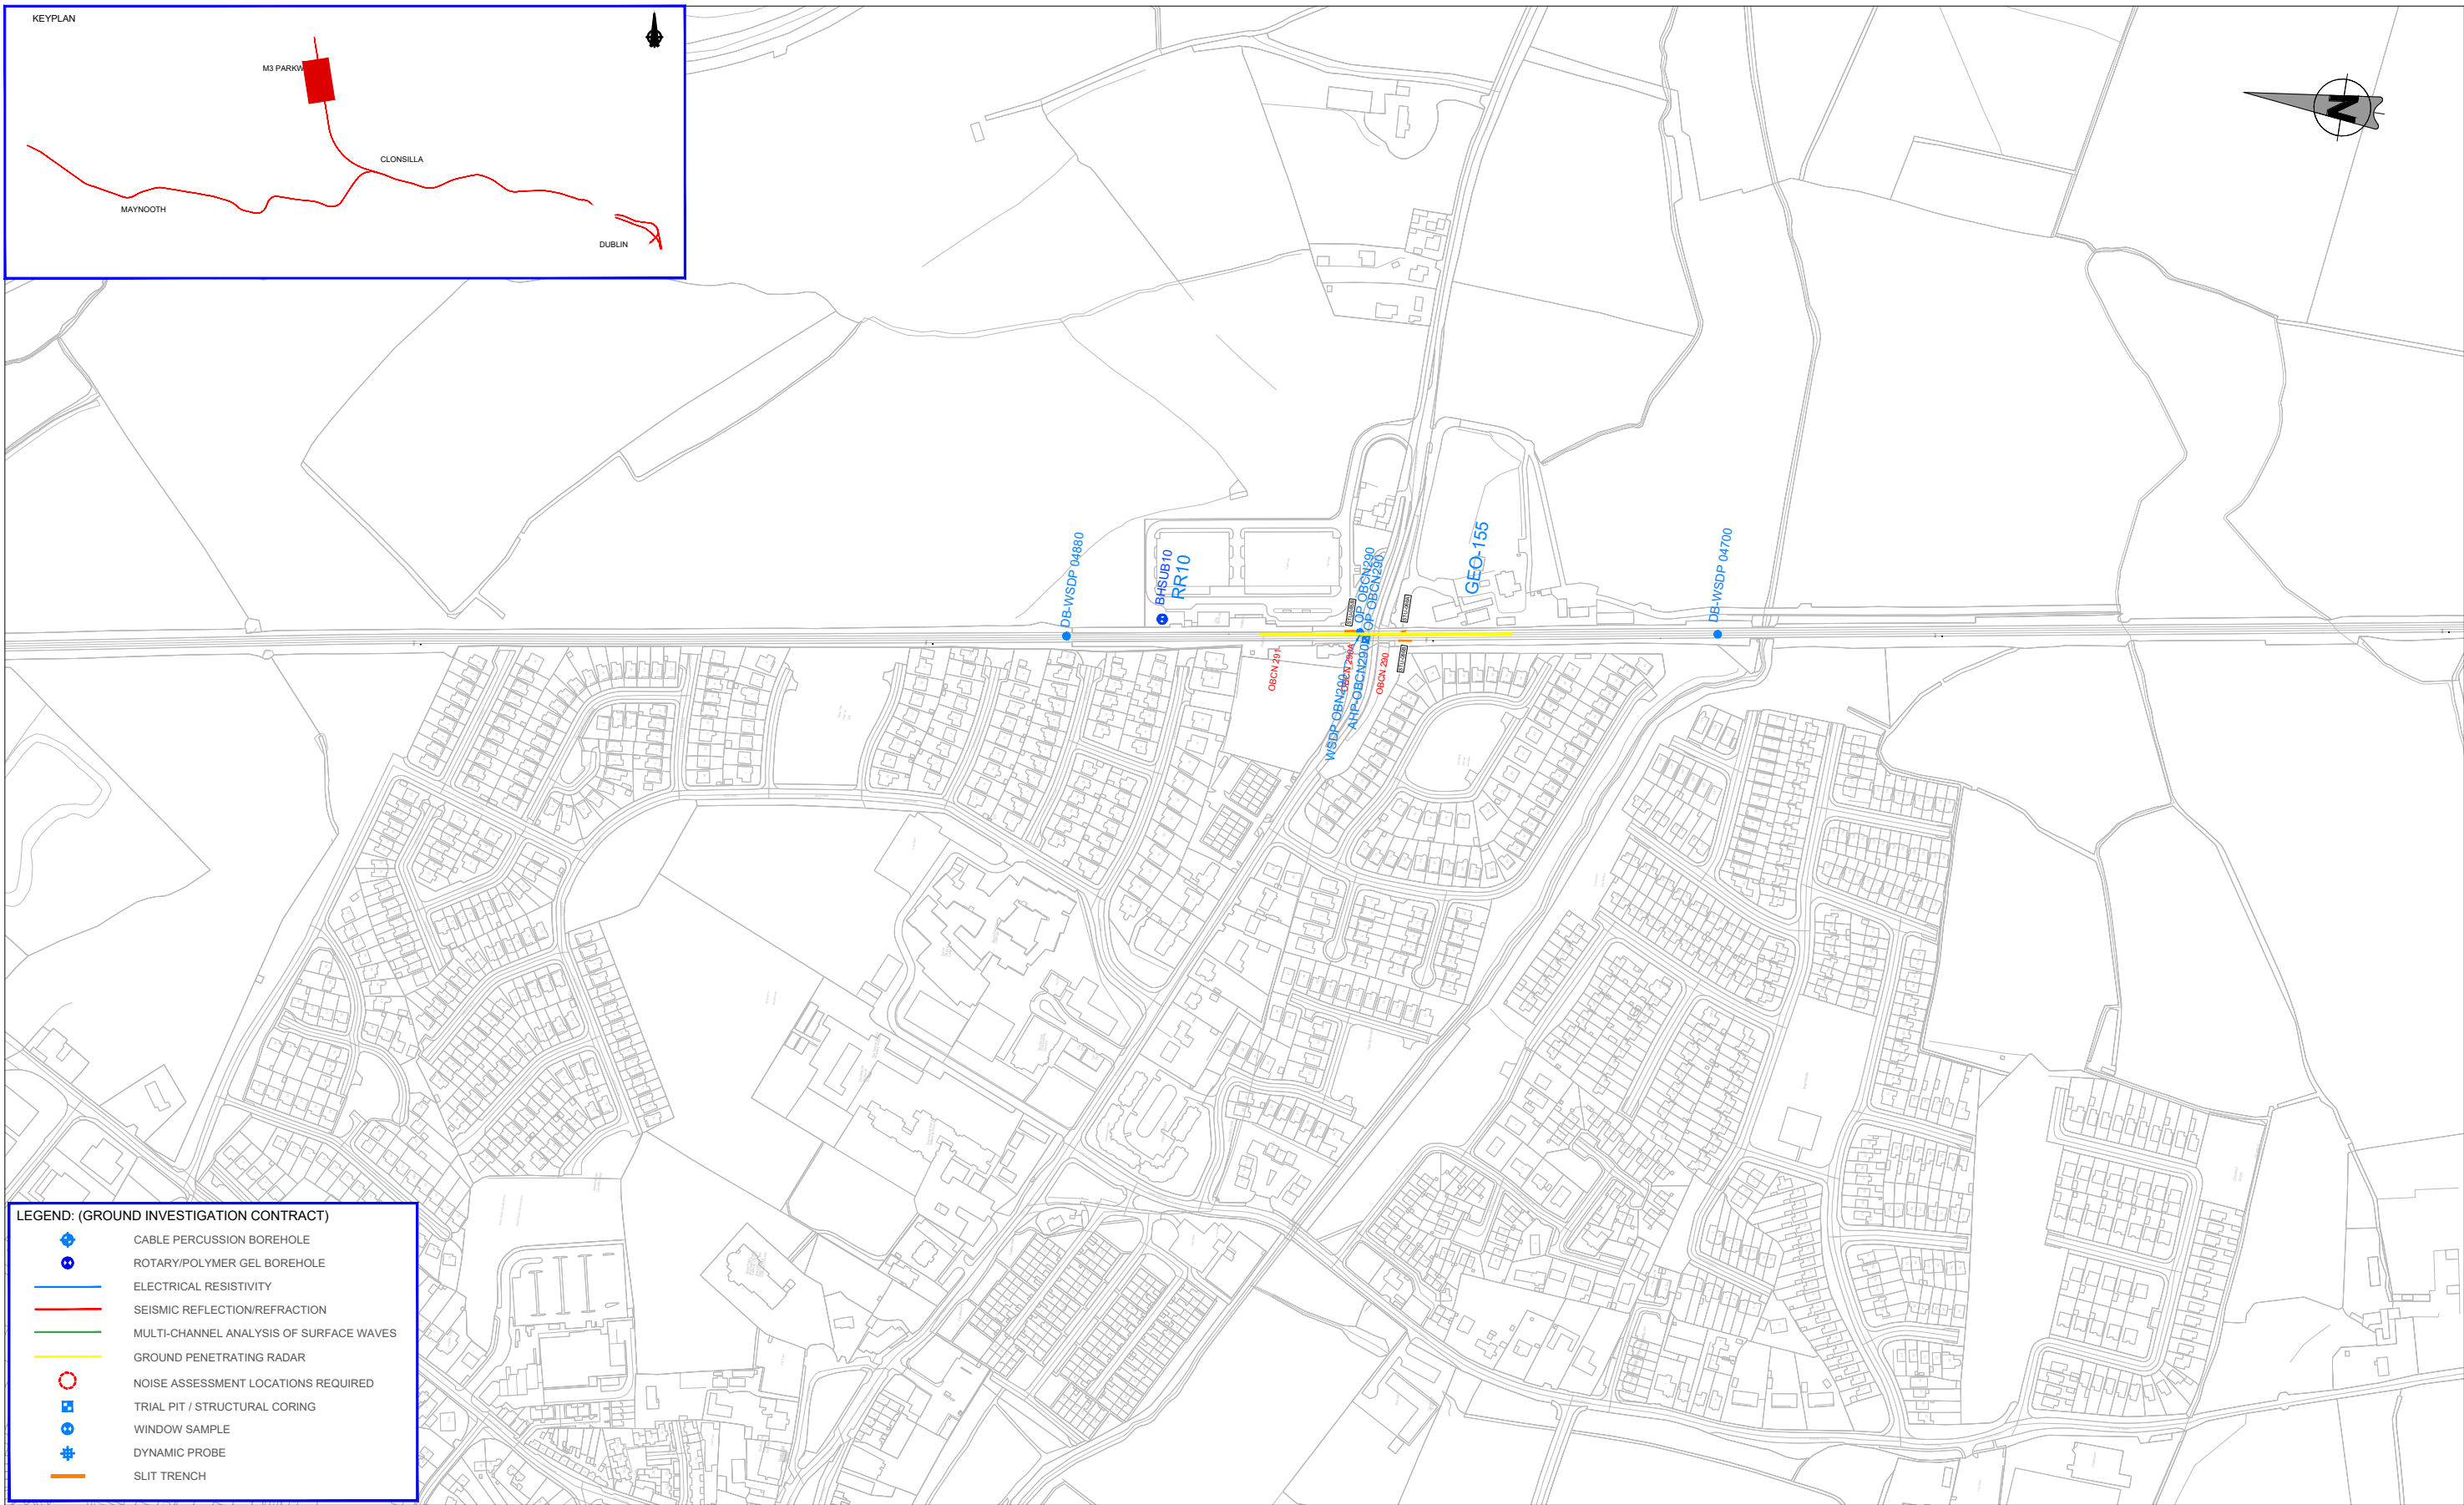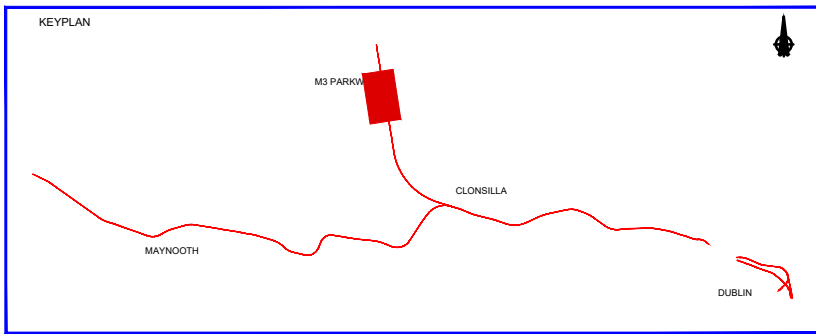

LEGEND: (GROUND INVESTIGATION CONTRACT)

- CABLE PERCUSSION BOREHOLE
- ROTARY/POLYMER GEL BOREHOLE
- ELECTRICAL RESISTIVITY
- SEISMIC REFLECTION/REFRACTION
- MULTI-CHANNEL ANALYSIS OF SURFACE WAVES
- GROUND PENETRATING RADAR
- NOISE ASSESSMENT LOCATIONS REQUIRED
- TRIAL PIT / STRUCTURAL CORING
- WINDOW SAMPLE
- DYNAMIC PROBE
- SLIT TRENCH

REV	DATE	DESCRIPTION	MAH	MAH	MK
V01	May 2022	PLANNING ISSUE			
<small>© Irish Rail (2021). This drawing is confidential and the copyright in it is owned by Irish Rail. This drawing must not be either loaned, copied or otherwise reproduced in whole or in part or used for any purpose without the prior permission of Irish Rail. © Ordnance Survey Ireland and Government of Ireland. All O.S. data used for plans are printed under "Copyright Ordnance Survey Ireland". Survey No. 6039721 (OSi Aerial Data or OSi Lidar Data) & Survey No. 2021/OSi_NMA_180 (OSi Vector Data). All elevations are in metres and relate to OSi Geoid Model (OSGM02) Malin Head as defined by existing Project Control. All Co-ordinates are in Irish Transverse Mercator Grid (ITM) as defined by OSi active GPS station Tallaght College (TLG0).</small>					

Client

Consultant

Project

Drawing Title



GROUND INVESTIGATION AS-BUILT LOCATIONS SHEET 23

Scale: 1:2,500 @ A1 1:5,000 @ A3







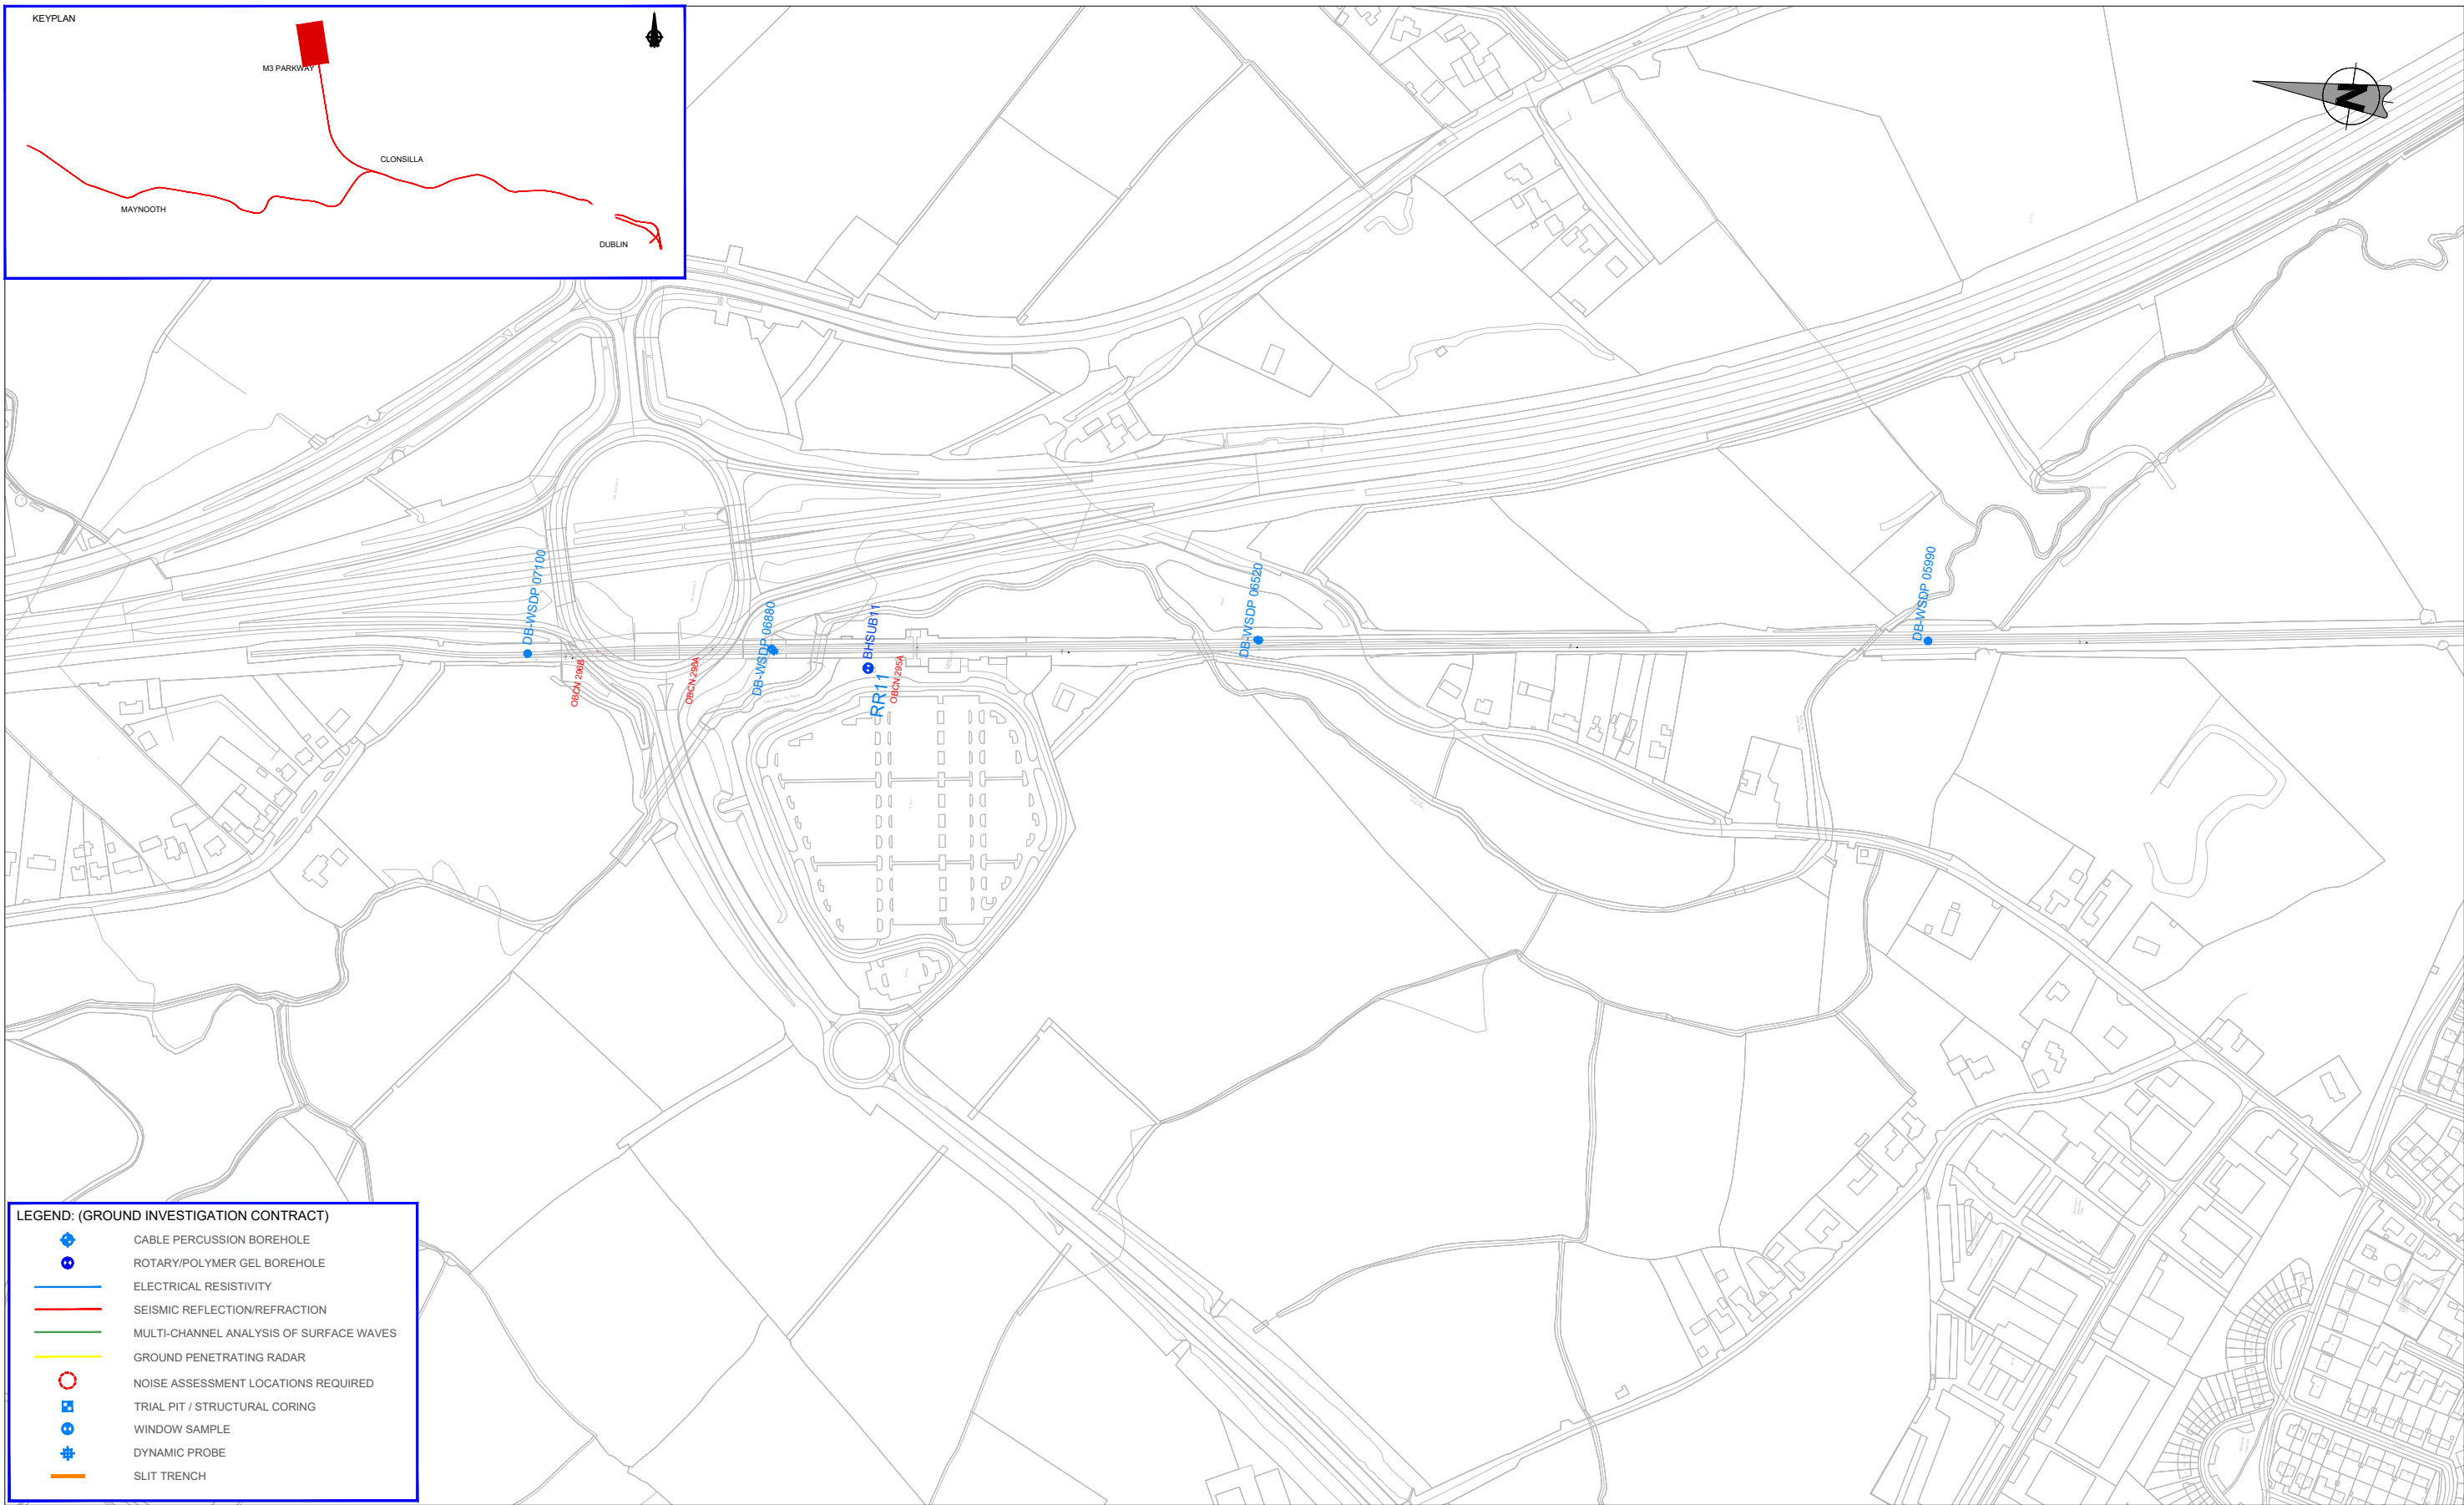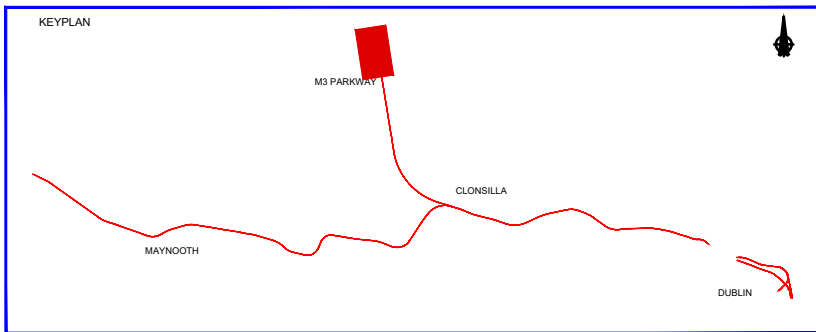




Drawing Number | Project | Originator | Discipline | Location | Type | Role | Number | Phase

MAY MDC GEO ROUT DR G 96023 D

Date: May 2022 | Job No: P/101086 | Status: F1 - Approved & Accepted | Rev: V 01 | Sheet: 23 of 24



LEGEND: (GROUND INVESTIGATION CONTRACT)

-  CABLE PERCUSSION BOREHOLE
-  ROTARY/POLYMER GEL BOREHOLE
-  ELECTRICAL RESISTIVITY
-  SEISMIC REFLECTION/REFRACTION
-  MULTI-CHANNEL ANALYSIS OF SURFACE WAVES
-  GROUND PENETRATING RADAR
-  NOISE ASSESSMENT LOCATIONS REQUIRED
-  TRIAL PIT / STRUCTURAL CORING
-  WINDOW SAMPLE
-  DYNAMIC PROBE
-  SLIT TRENCH

REV	DATE	DESCRIPTION	MAH	MAH	MK
V01	May 2022	PLANNING ISSUE			
PRODUCED BY			REVIEWED BY		
APPROVED BY					

© Irish Rail (2021). This drawing is confidential and the copyright in it is owned by Irish Rail. This drawing must not be either loaned, copied or otherwise reproduced in whole or in part or used for any purpose without the prior permission of Irish Rail.
 © Ordnance Survey Ireland and Government of Ireland. All O.S. data used for plans are printed under "Copyright Ordnance Survey Ireland".
 Survey No. 6039721 (OSi Aerial Data or OSi Lidar Data) & Survey No. 2021/OSi_NMA_180 (OSi Vector Data).
 All elevations are in metres and relate to OSi Geoid Model (OSGM02) Malin Head as defined by existing Project Contract.
 All Co-ordinates are in Irish Transverse Mercator Grid (ITM) as defined by OSi active GPS station Tallaght College (TLG0).

Client





Consultant





Project



Drawing Title

**GROUND INVESTIGATION
AS-BUILT LOCATIONS
SHEET 24**

Scale: 1:2,500 @ A1 1:5,000 @ A3

Drawing Number | Project | Originator | Discipline | Location | Type | Role | Number | Phase

MAY MDC GEO ROUT DR G 96024 D

Date: May 2022 | Job No: P/101086 | Status: F1 - Approved & Accepted | Rev: V 01 | Sheet: 24 of 24