

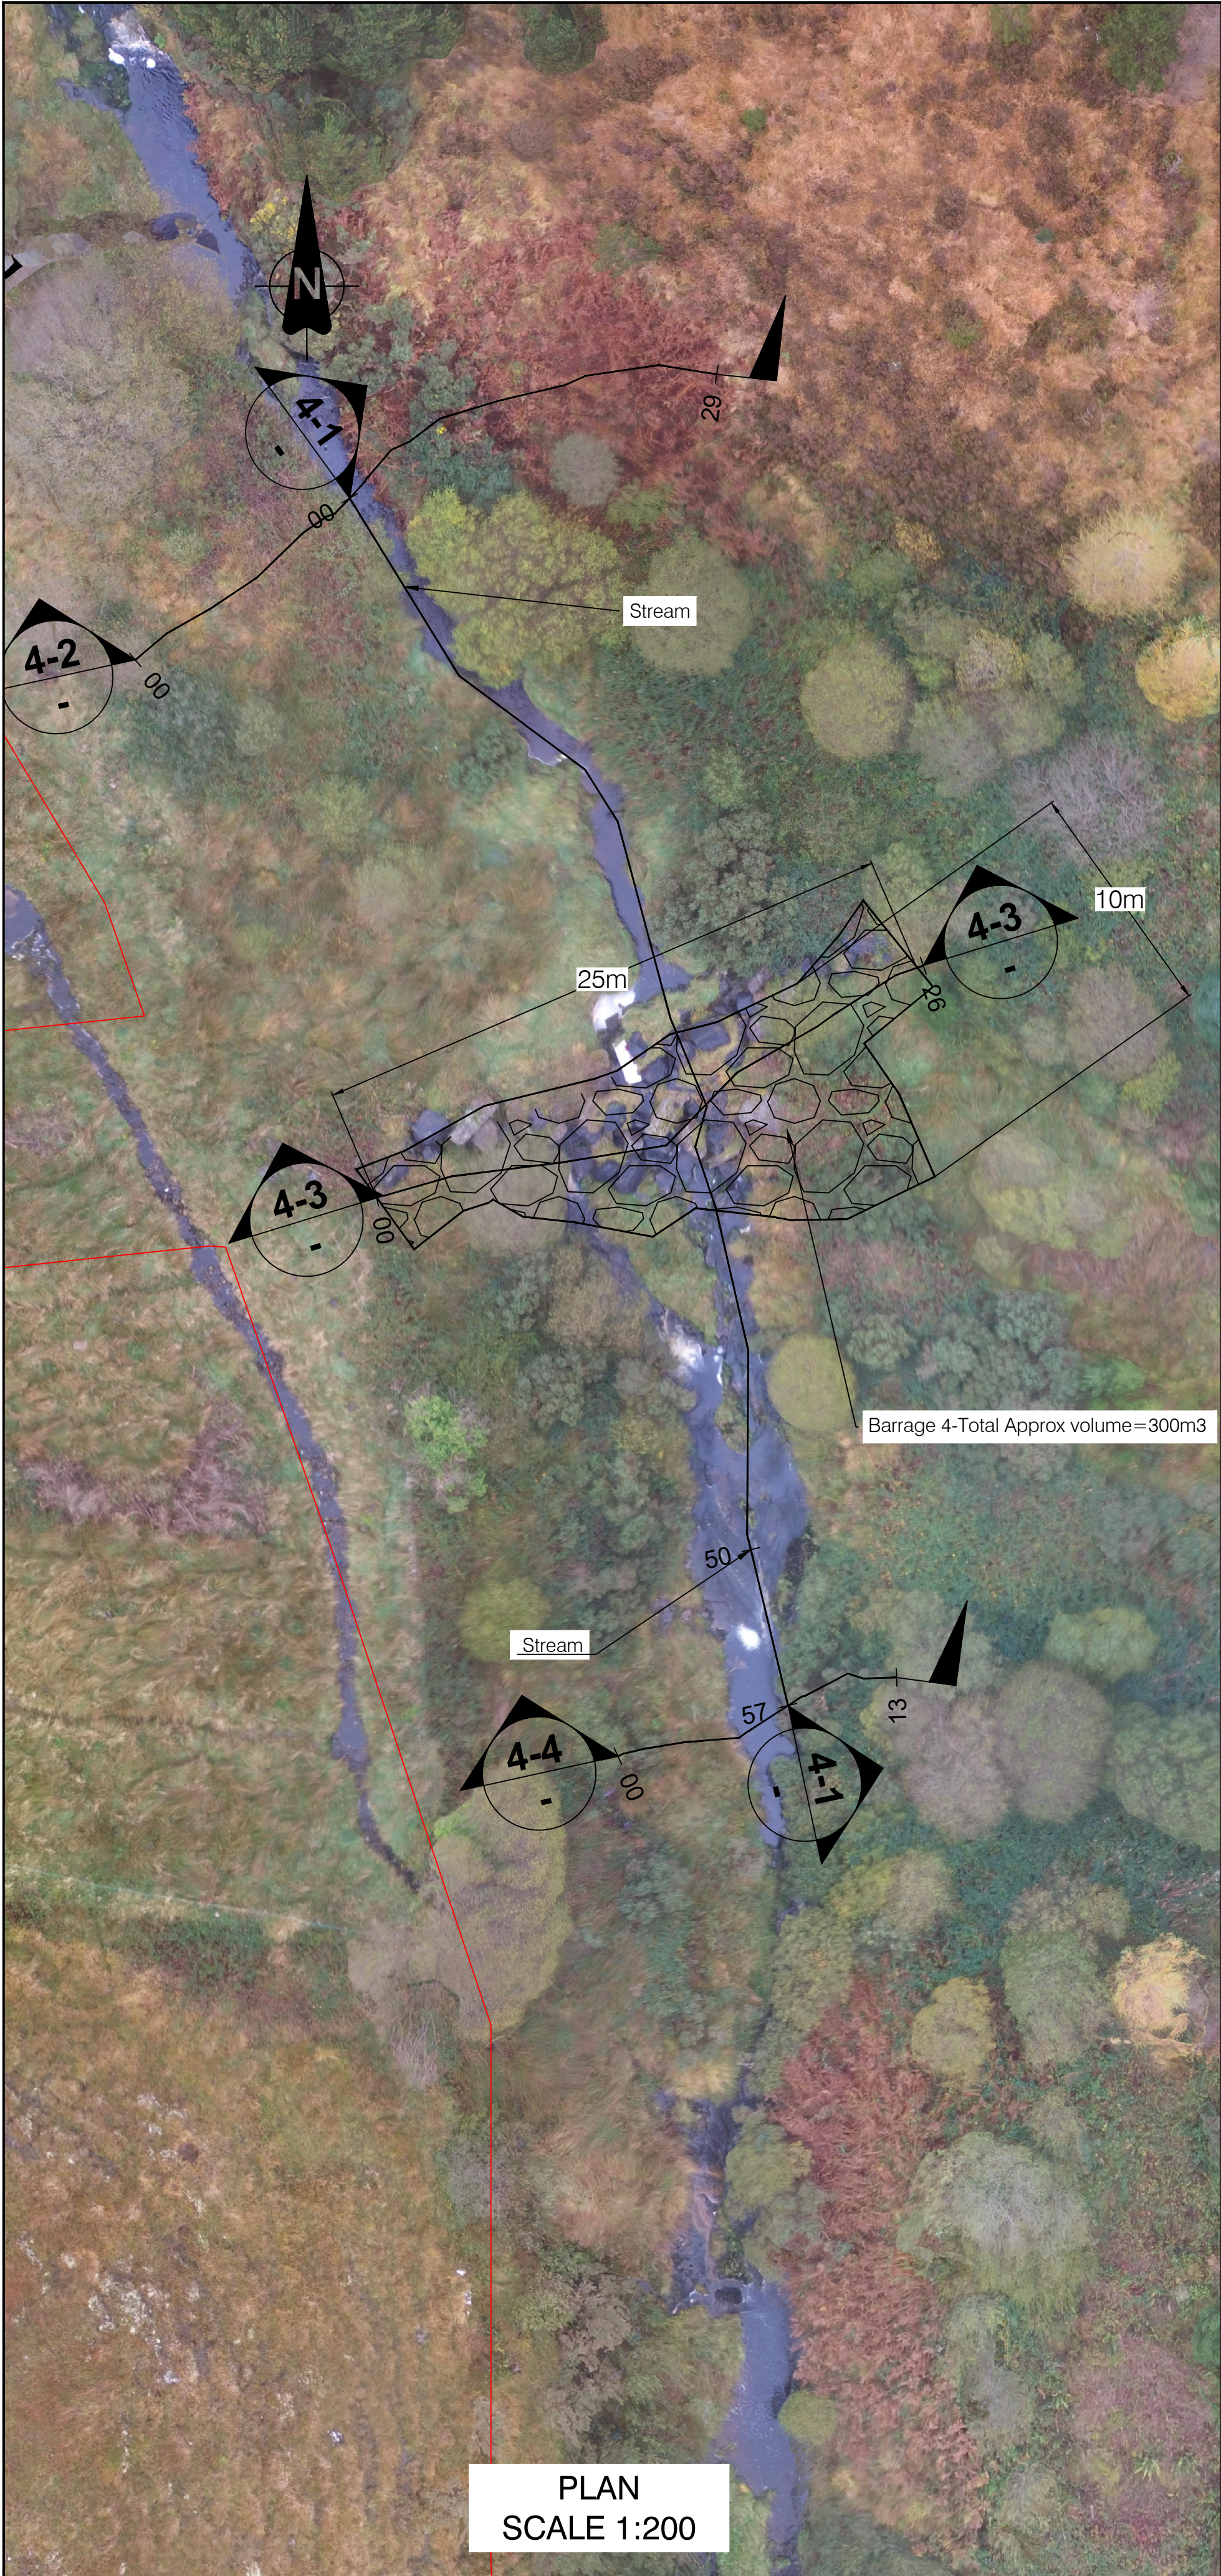
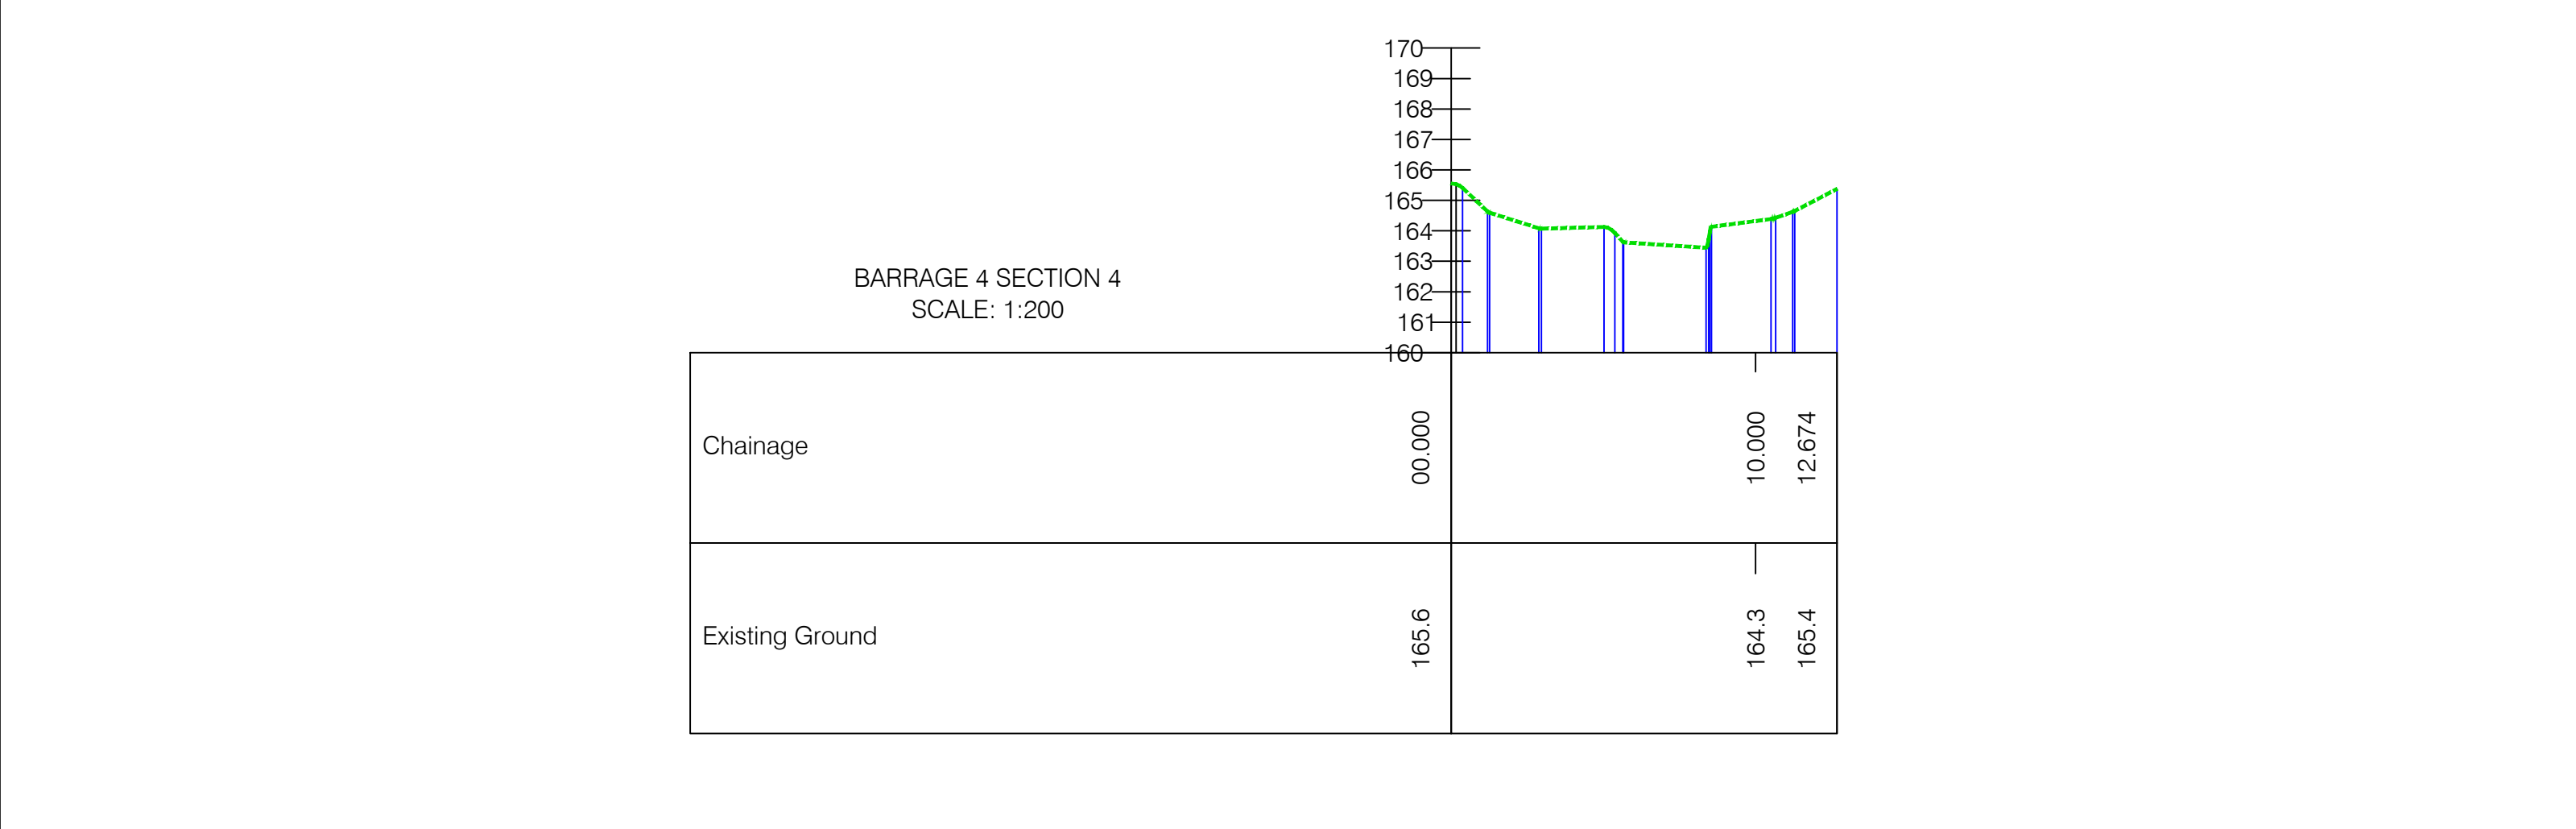
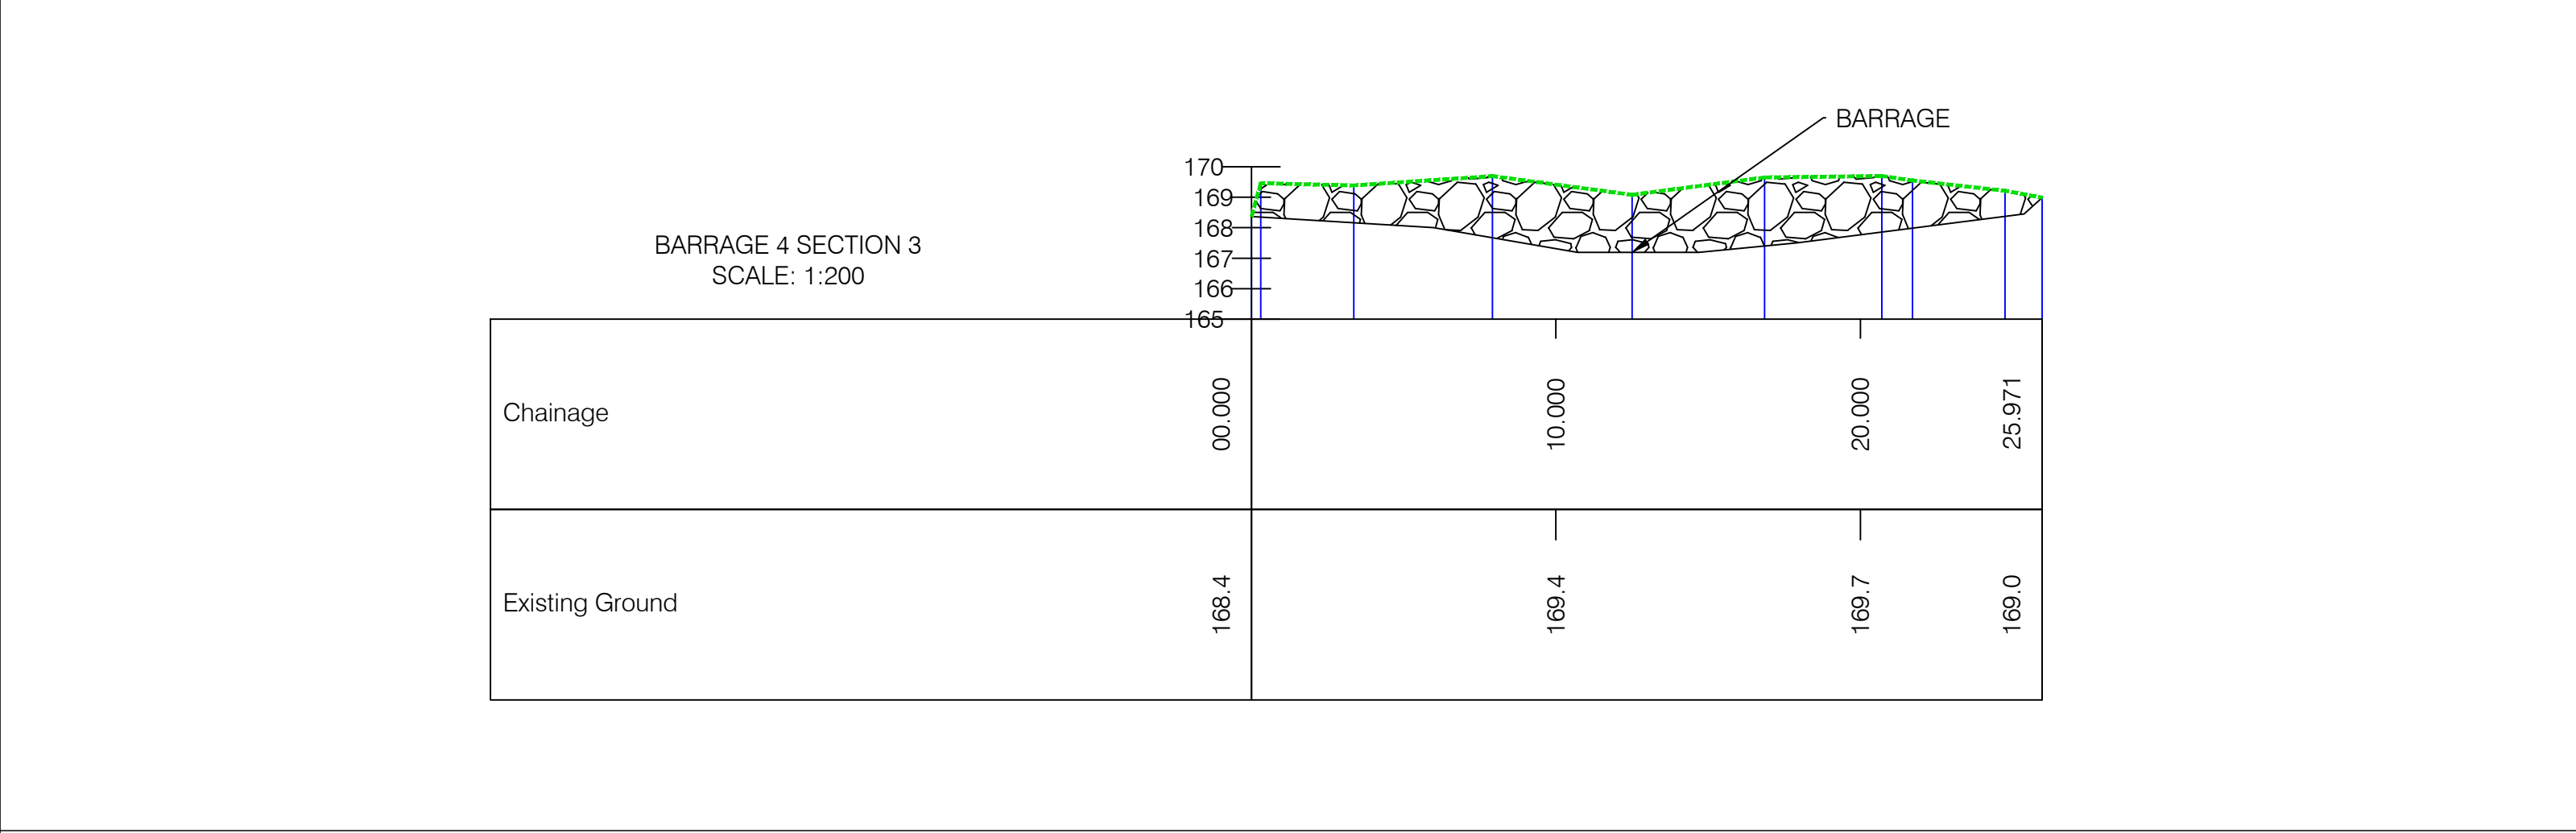


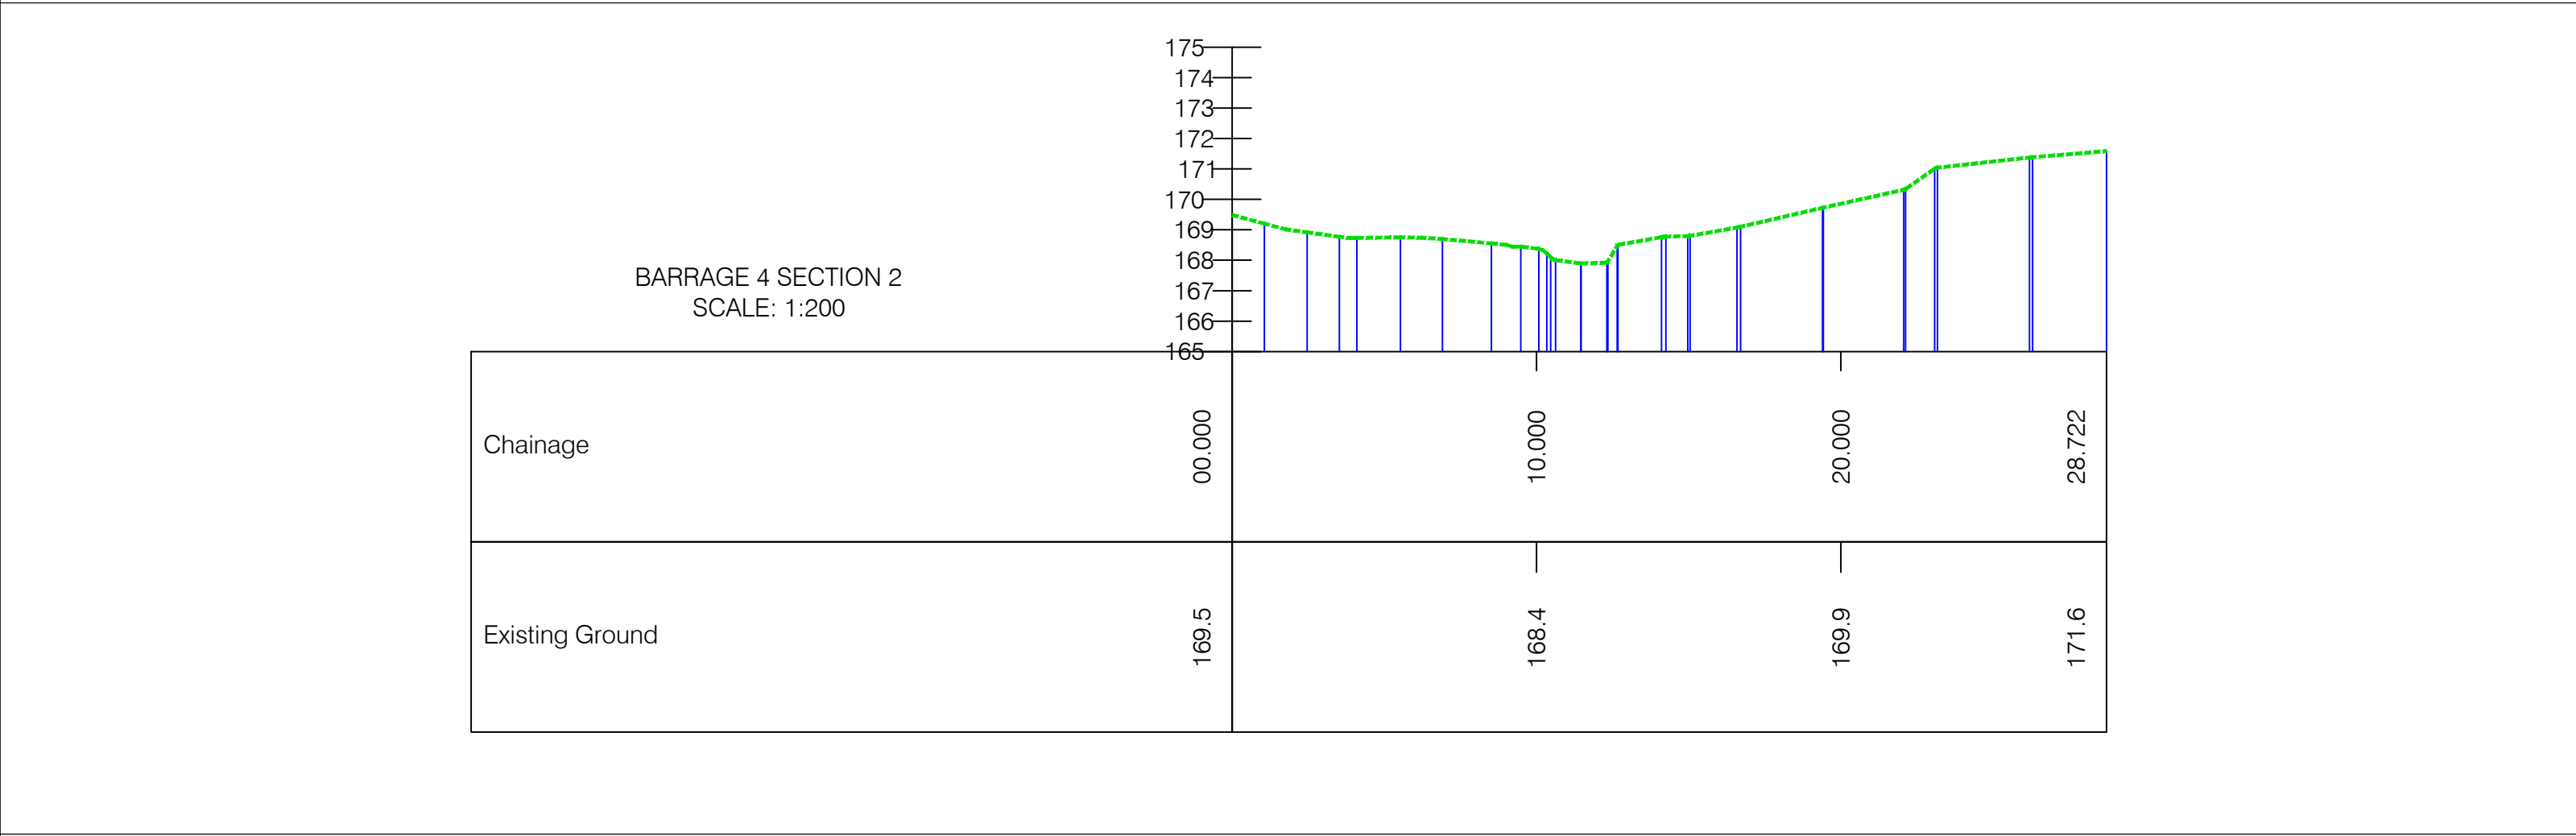

PLAN
SCALE 1:200

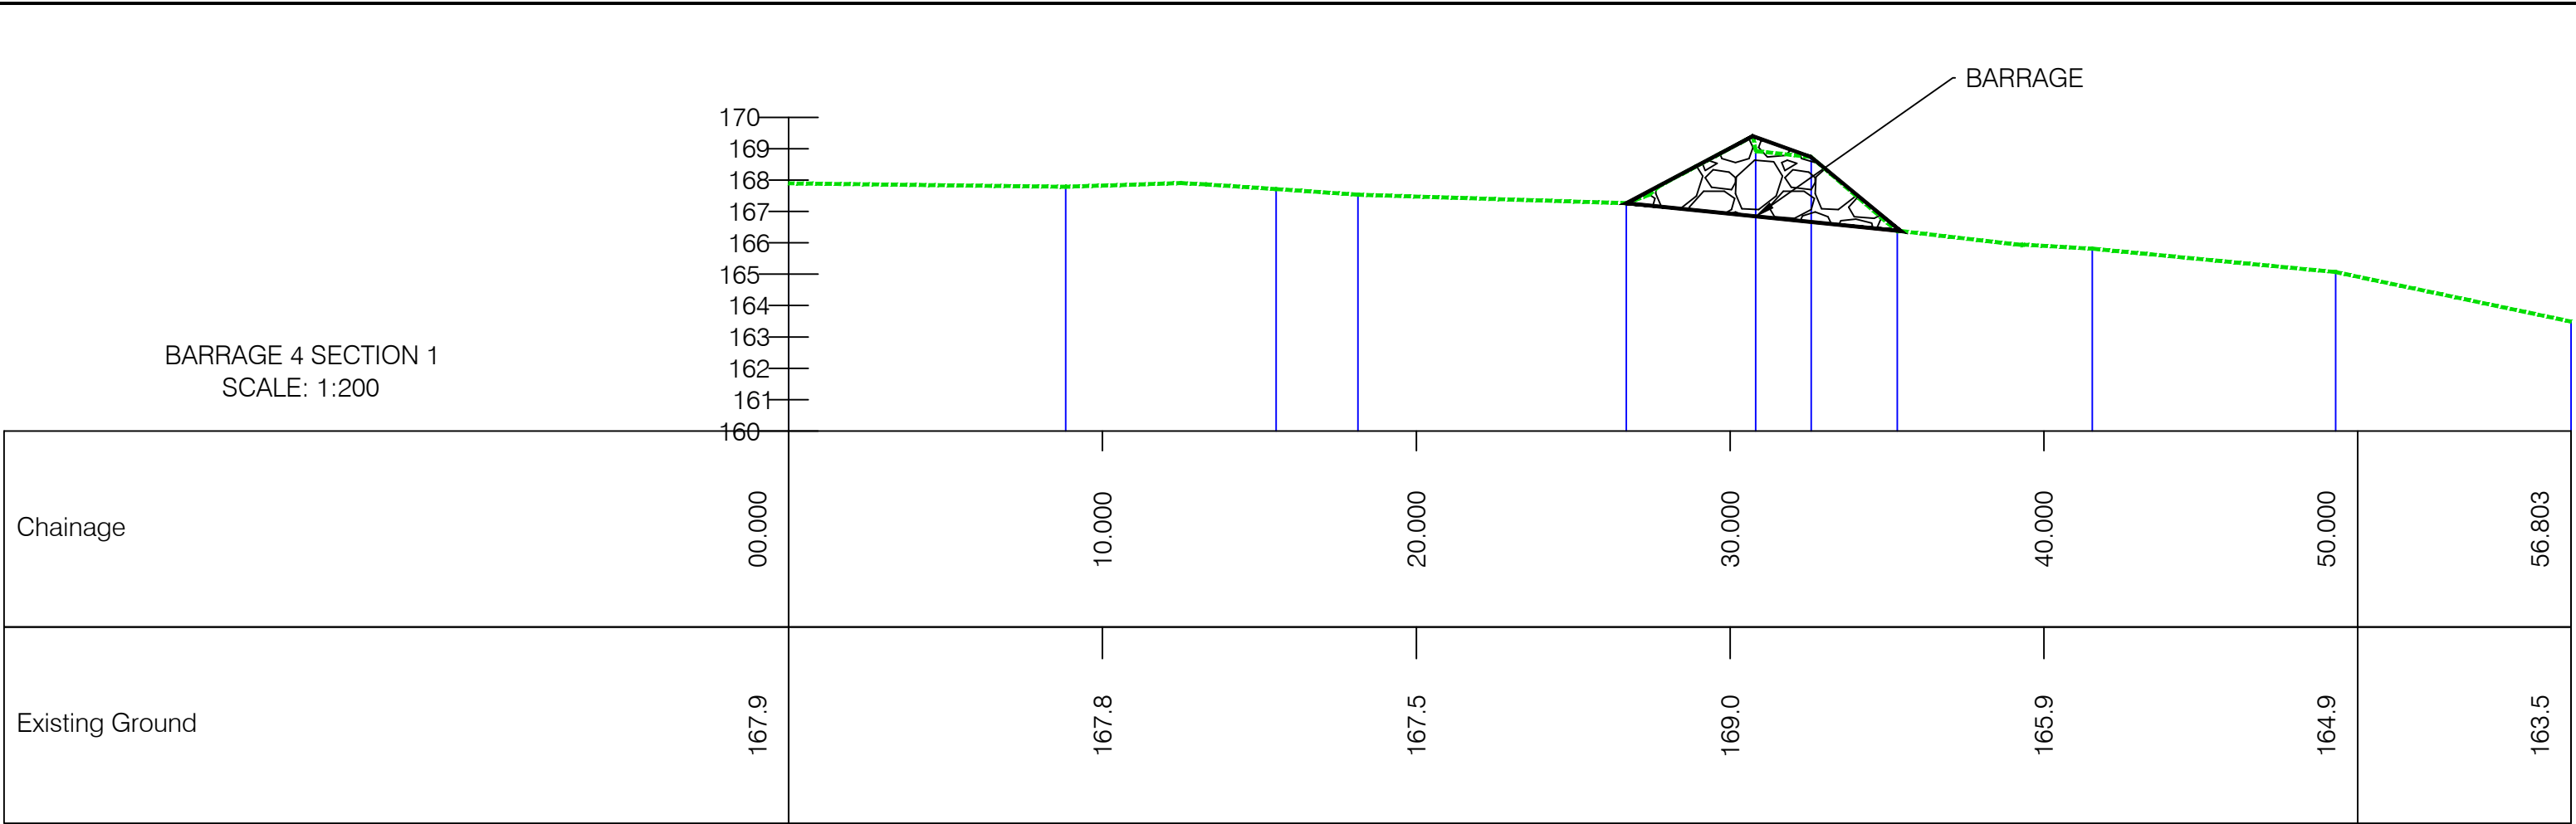

LEGEND

- Substitute Consent Application Boundary
- Existing Ground
- Fence
- Stone Barrage
- Constructed Access Track

LAYOUT

SCALE 1:5,000

KEY PLAN

SCALE 1:50,000

Note:
All levels in meters above ordnance datum Malin Head
Coordinates are given in Irish Transverse Mercator
coordinate system
Topographical survey undertaken on week commencing
16/09/2019
Background imagery taken from ESB EMP Drone

0	09.04.25	ISSUED FOR SUBSTITUTE CONSENT	LMcM	LMcMH	McM	B.A
REV	DATE	REVISION DESCRIPTION	DRN	PROD	VER	APP

PURPOSE OF ISSUE - PRELIMINARY UNLESS INDICATED

CLIENT APPROVAL ☐ PLANNING ☒ TENDER ☐ CONSTRUCTION ☐ AS-BUILT ☐

CLIENT

GORT WINDFARMS LTD

PROJECT

Application for Substitute Consent:Derrybrien Wind Farm Development
Decommissioning Project - Retained Development

CONTRACT

DRAWING TITLE

Barrage 4 Plan and sections.
To remain in situ

PRODUCTION UNIT

Civil Environmental & Renewable Engineering

ESB
Energy for generations

Engineering and Major Projects,
One Dublin Airport Central, Dublin Airport,
Cloughran, Co. Dublin, K67 XF72, Ireland.
Tel: +353 (0)1 703 8000 Web: www.esb.ie
Engineering and Major Projects is a division of ESB.

DRAWN	PRODUCED	VERIFIED	APPROVED	APPROVAL DATE
LMcManus	D. Hogan	H. McMeel	B. Allen	09.04.2025
CLIENT REF		NO. OF SHTS	SIZE	SCALE
		1	A1	1:200

DRAWING NUMBER

QS-000280-01-D460-037-006-000

SHEET REV