


RECEIVED: 02/09/2025



APPENDIX 4-1

Site Layout Drawings

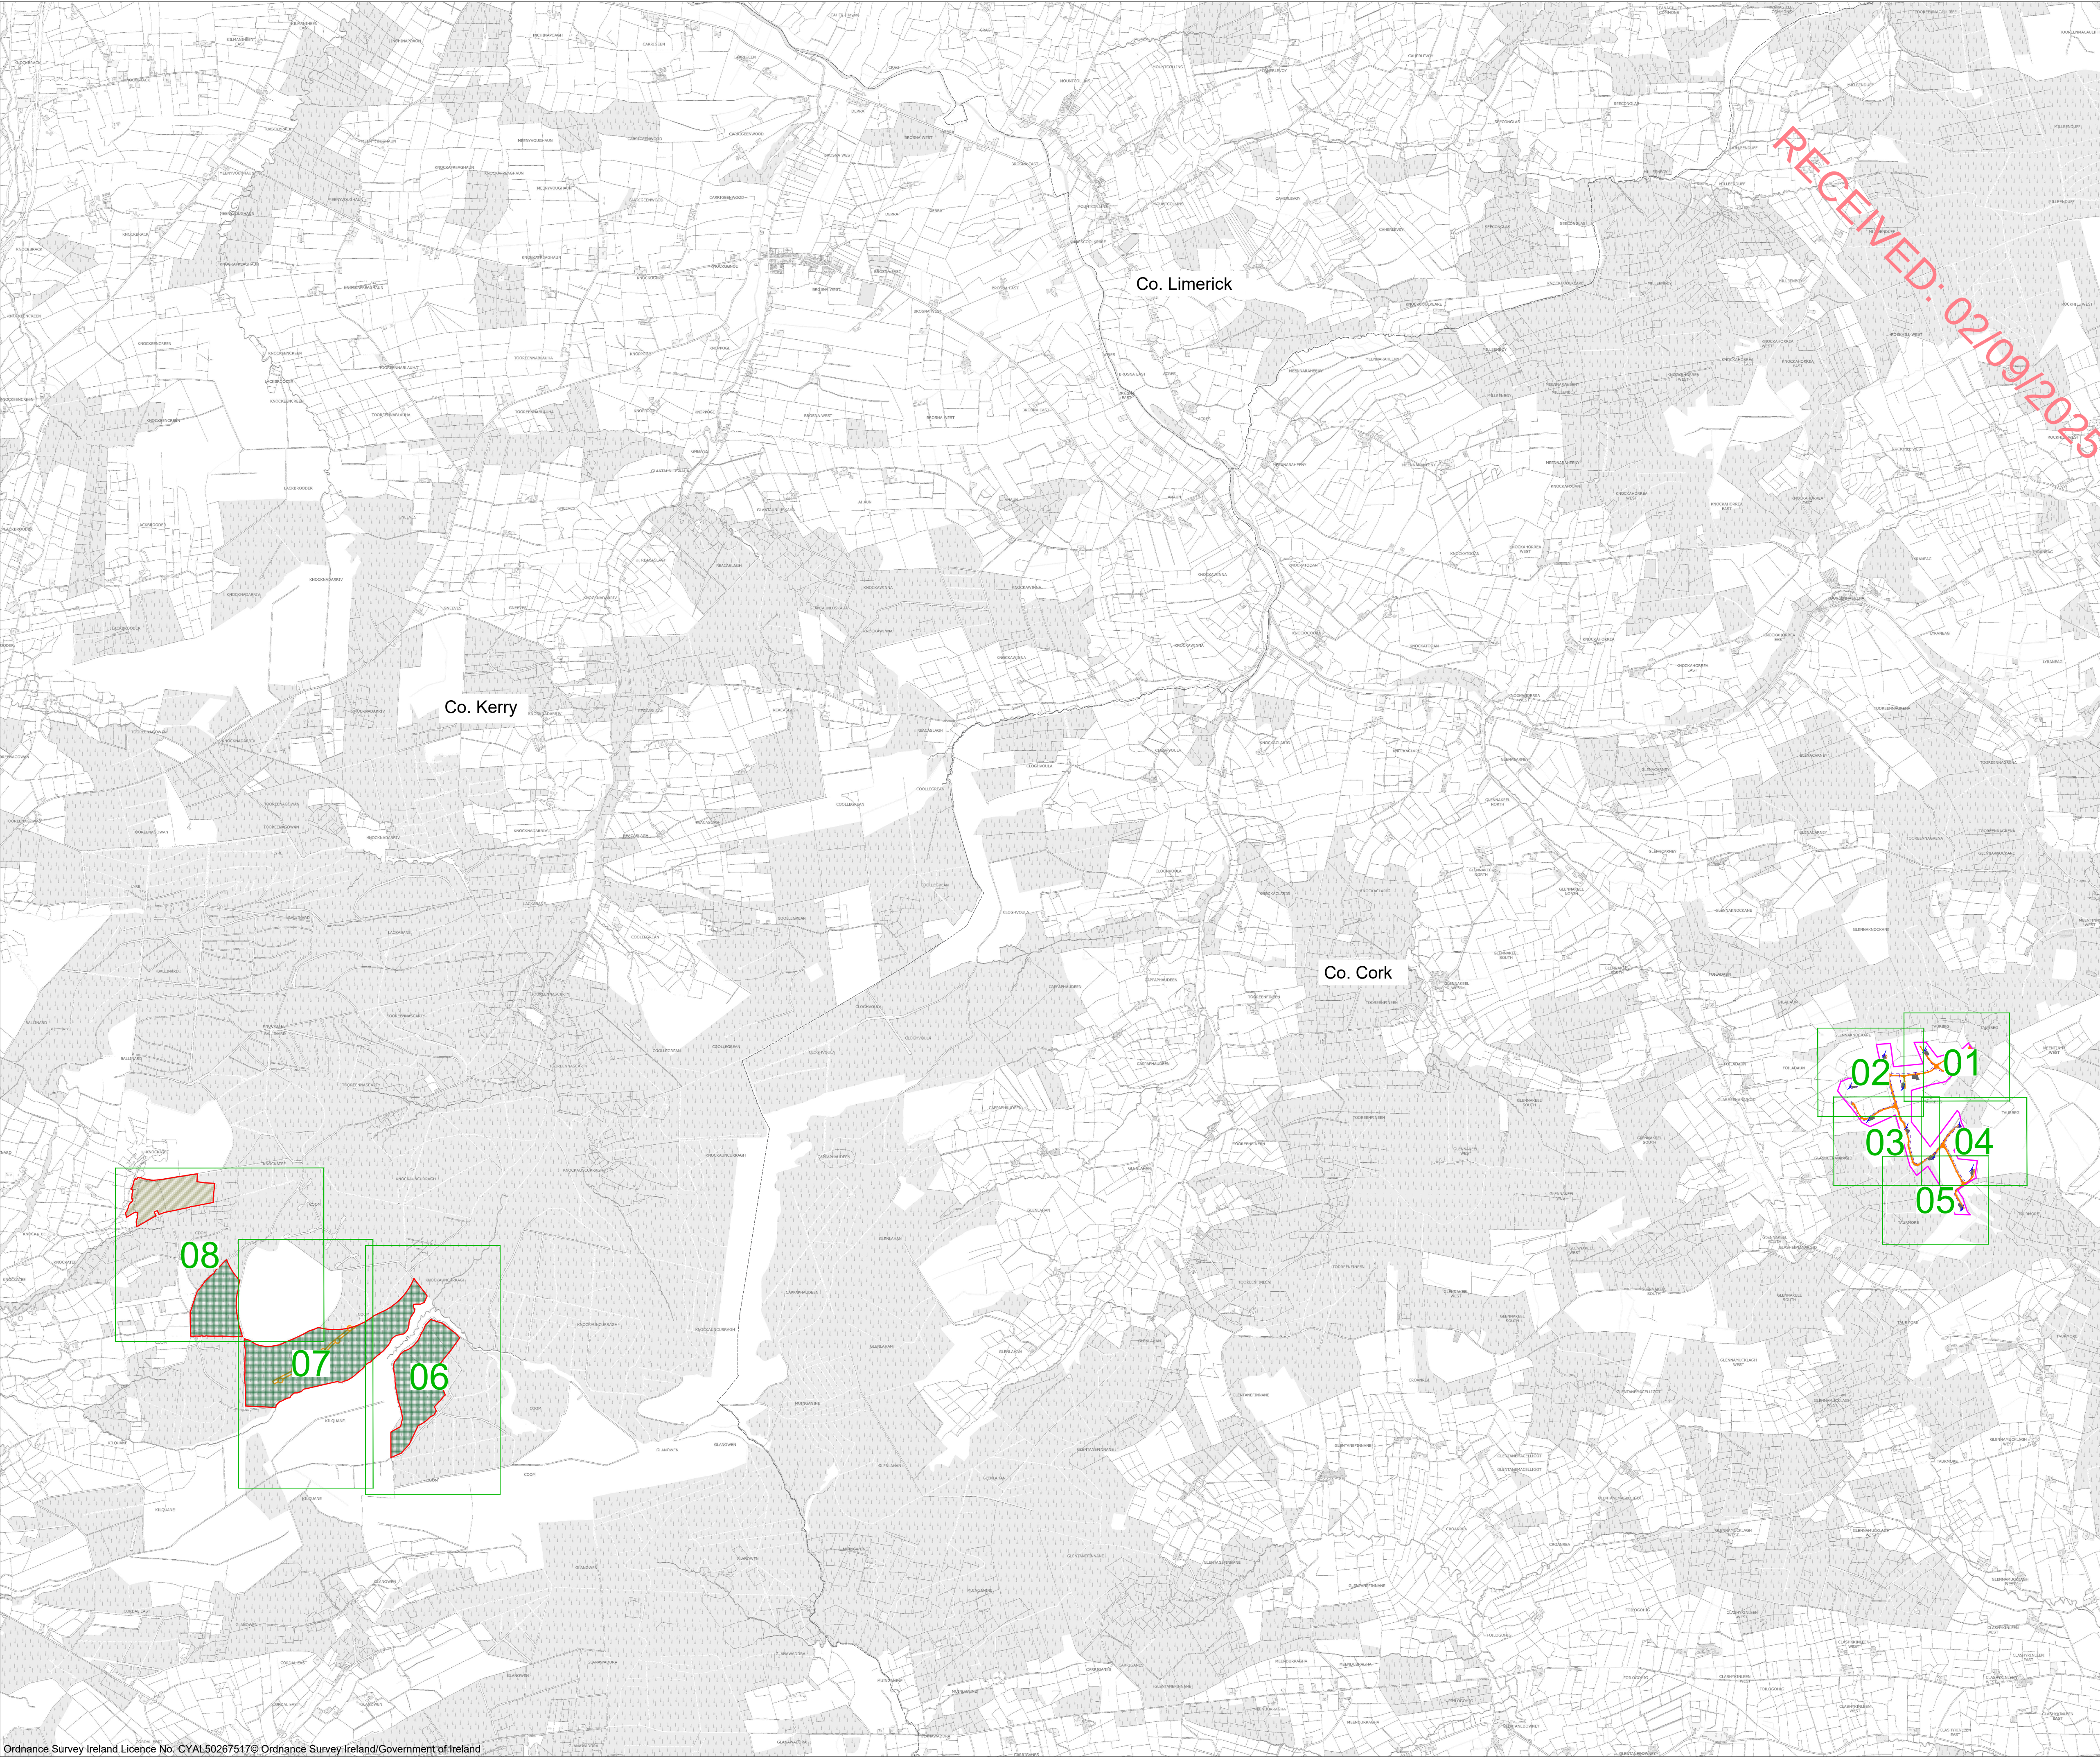

Drawing Legend

Taurbeg Wind Farm Extension of Operational Life

- Planning Application Boundary (Cork County Council)
- As Built Hardstanding Area
- As Built Turbine Foundation
- As Built Turbine
- As Built Met Mast
- County Boundary
- Electrical Cable Trench

Proposed Offsetting Measures elements

- Planning Application Boundary (Kerry County Council)
- Deforestation Areas (Coniferous Forestry Plantation)
- Farmland Restoration Area
- Predator Fence


PROJECT TITLE:
Taurbeg Wind Farm Extension of Operational Life- Proposed Offsetting Measures

DRAWING TITLE:
Site Layout Key Plan

PROJECT No.: 231030	DRAWING No.: 231030 - 03	SCALE: 1:25,000 @ A1
DRAWN BY: GO	CHECKED BY: N/A	DATE: 04.07.2025
OS SHEET No.:		REVISION.: P01

5597, 5598, 5667, 5668

Email: info@mkoireland.ie | Website: www.mkoireland.ie
Email: InfoIreland@statkraft.com | Website: www.statkraft.ie

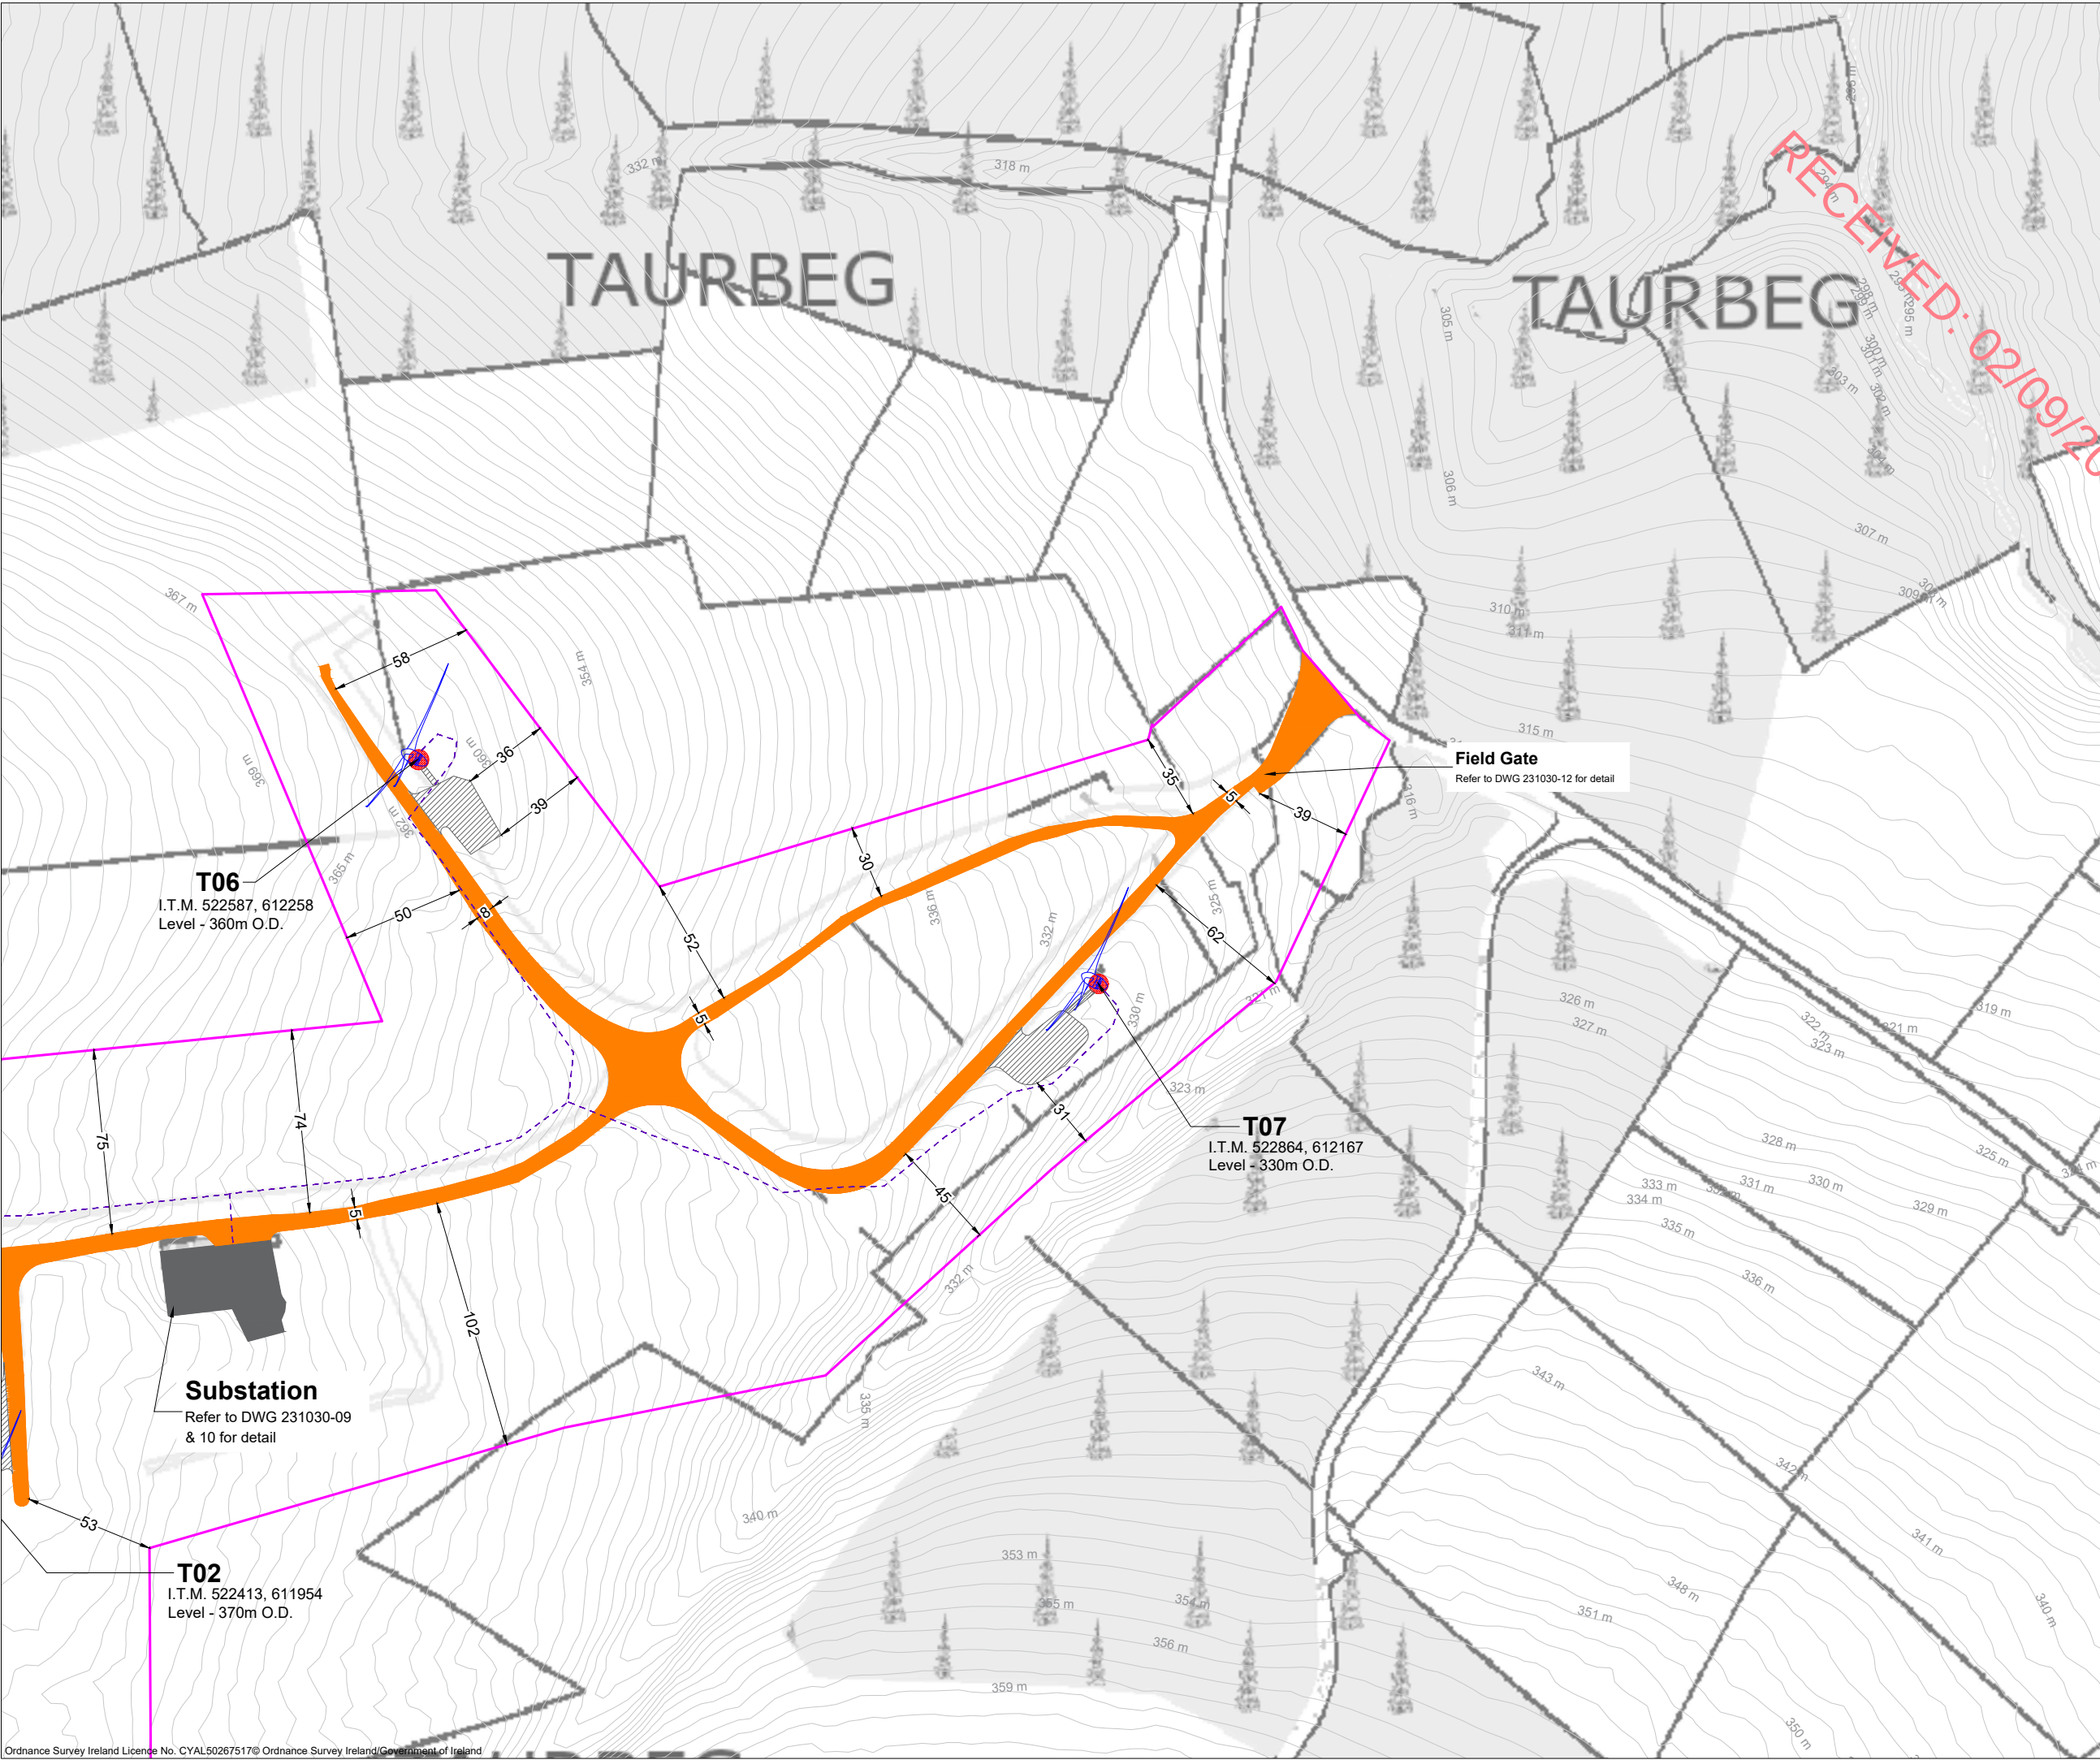

Drawing Legend

- Planning Application Boundary (Cork County Council)
- As Built Site Road
- As Built Substation Compound
- As Built Hardstanding Area
- As Built Turbine
- As Built Turbine Foundation
- Electrical Cable Trench



PROJECT TITLE:
Taurbeg Wind Farm Extension of Operational Life- Proposed Offsetting Measures

DRAWING TITLE:
Site Layout Plan Sheet 01 of 08


PROJECT No.: 231030	DRAWING No.: 231030 - 03A	SCALE: 1:2,500 @ A3
-------------------------------	-------------------------------------	-------------------------------

DRAWN BY: GO	CHECKED BY: N/A	DATE: 04.07.2025	REVISION: P01
------------------------	---------------------------	----------------------------	-------------------------

OS SHEET No.:
5597, 5598, 5667, 5668



Email: info@mkoireland.ie | Website: www.mkoireland.ie
Email: infoireland@statkraft.com | Website: www.statkraft.ie

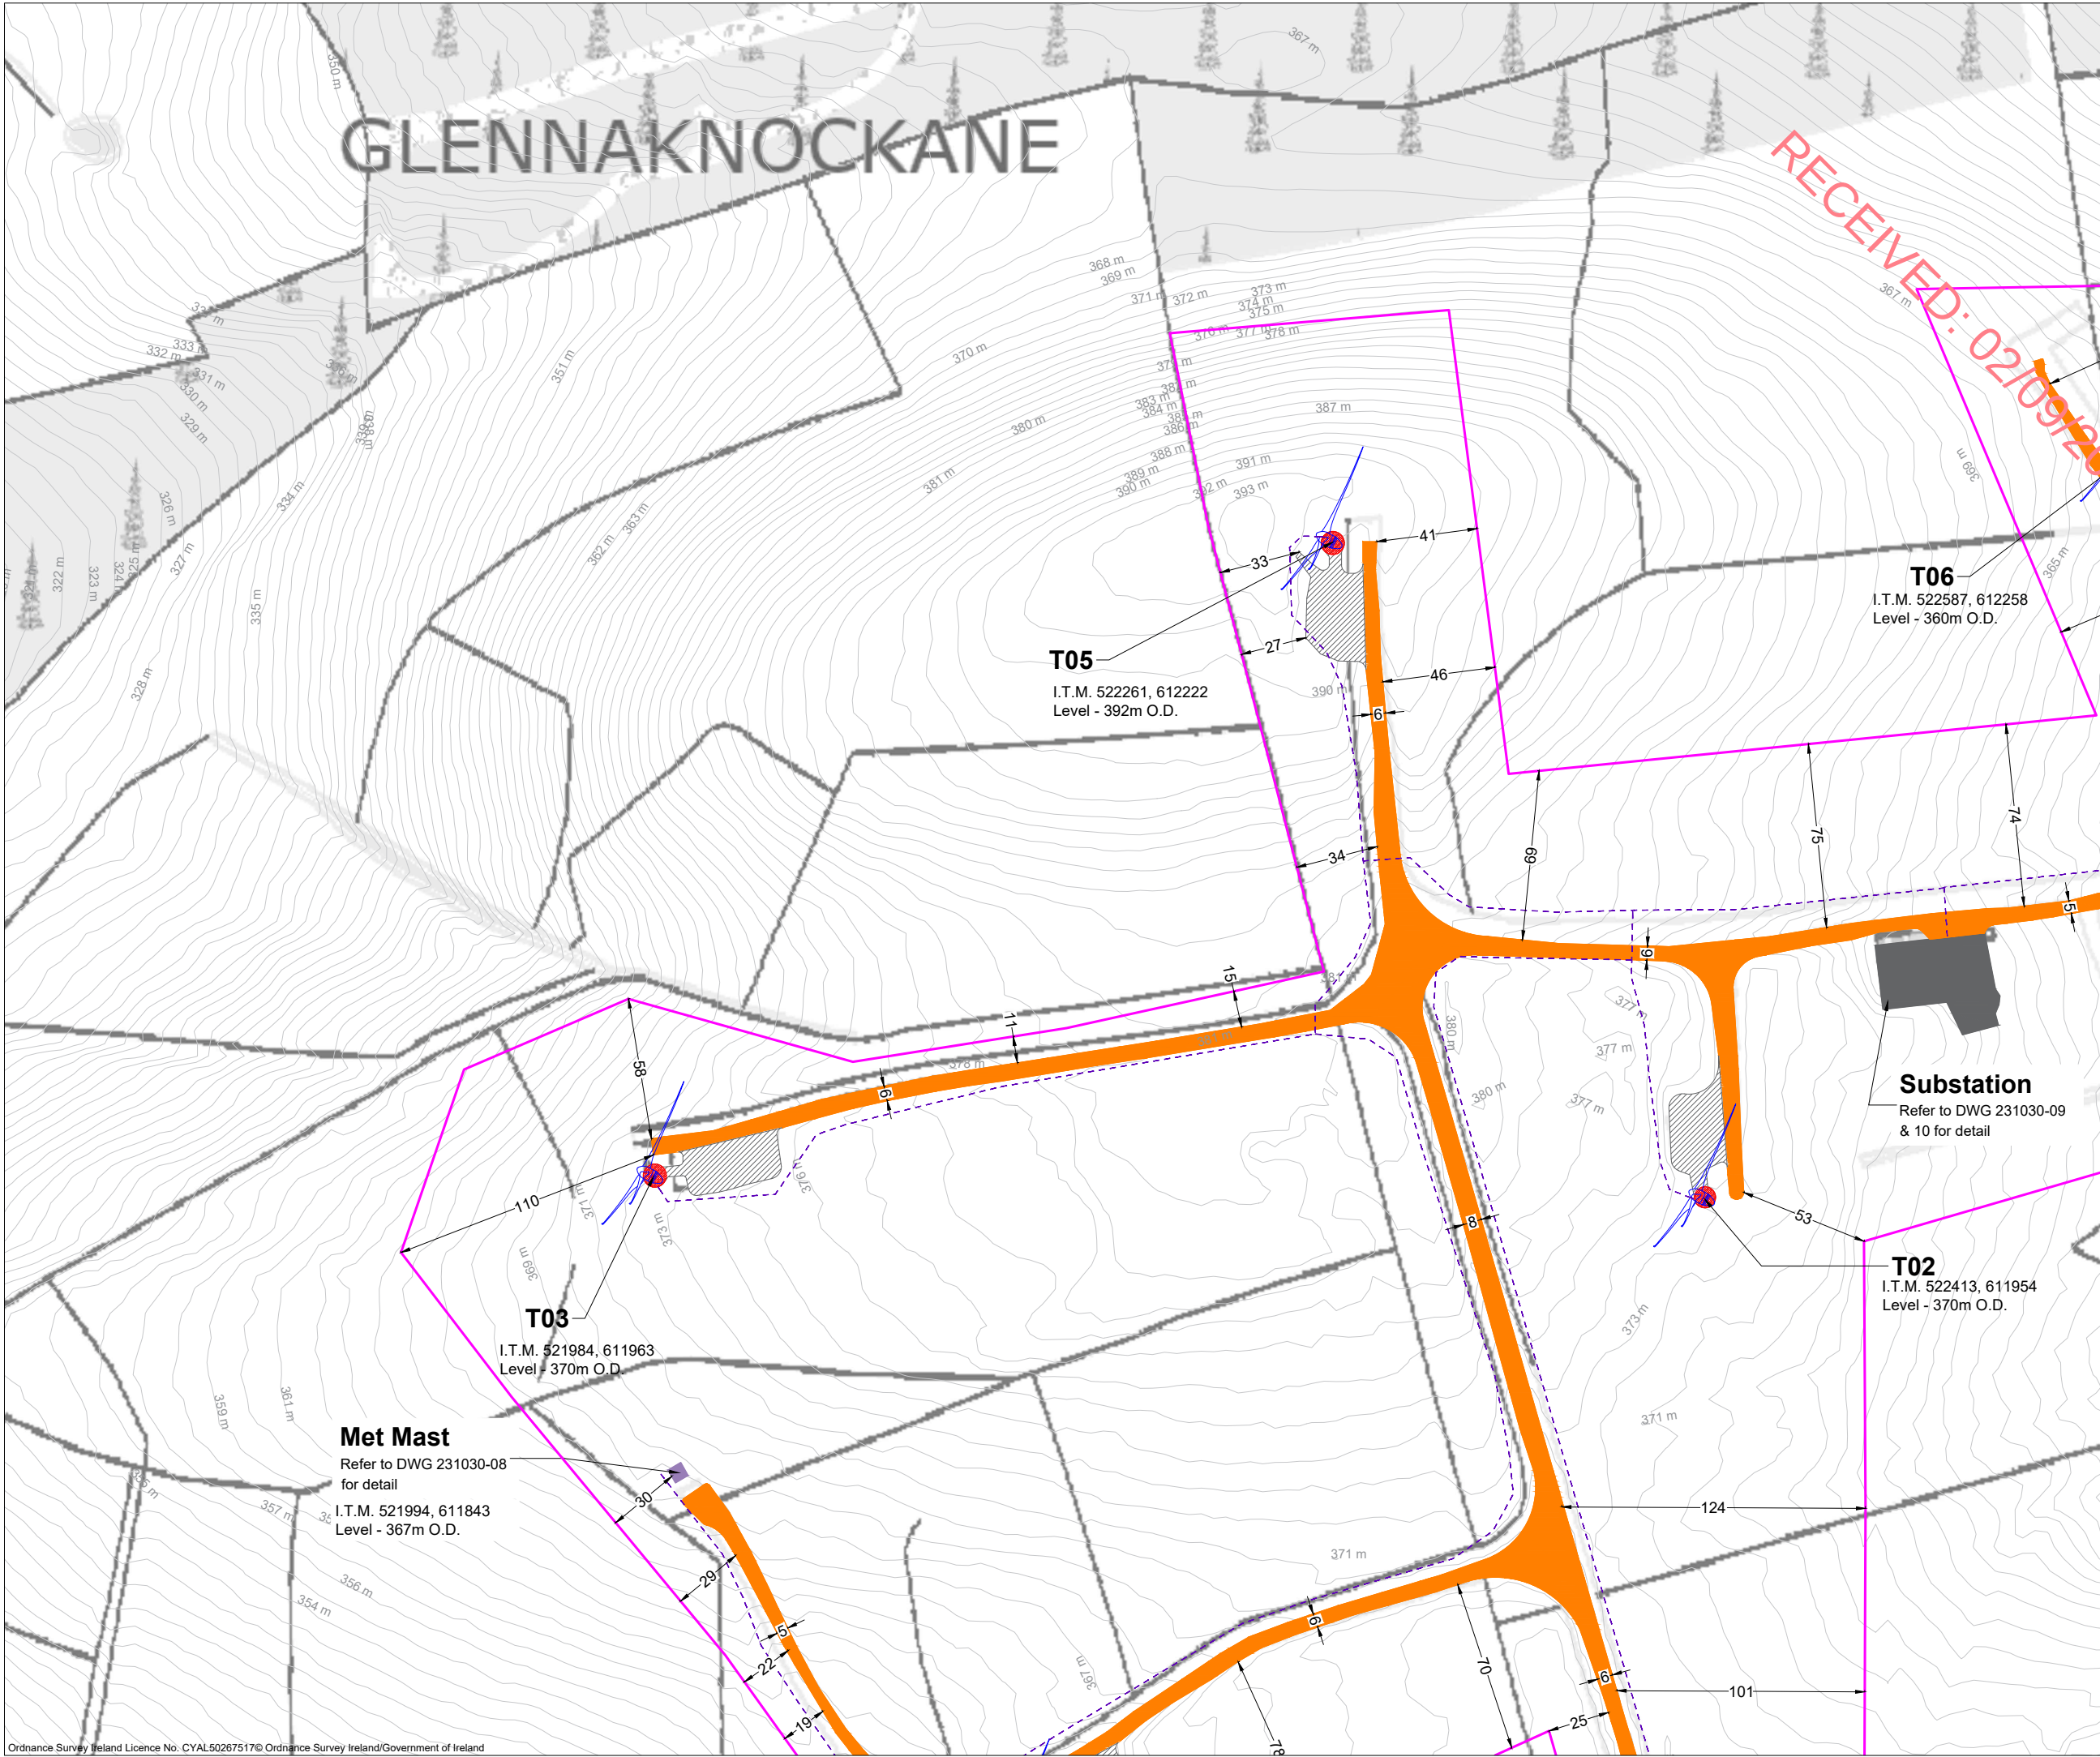


- Drawing Legend**
- Planning Application Boundary (Cork County Council)
 - As Built Site Road
 - As Built Substation Compound
 - As Built Hardstanding Area
 - As Built Turbine
 - As Built Met Mast
 - As Built Turbine Foundation
 - Electrical Cable Trench



PROJECT TITLE: Taubeg Wind Farm Extension of Operational Life- Proposed Offsetting Measures			
DRAWING TITLE: Site Layout Plan Sheet 02 of 08			
PROJECT No.: 231030	DRAWING No.: 231030 - 03B	SCALE: 1:2,500 @ A3	
DRAWN BY: GO	CHECKED BY: N/A	DATE: 04.07.2025	REVISION: P01
OS SHEET No.: 5597, 5598, 5667, 5668			



Email: info@mkoireland.ie | Website: www.mkoireland.ie
Email: info@statkraft.com | Website: www.statkraft.ie

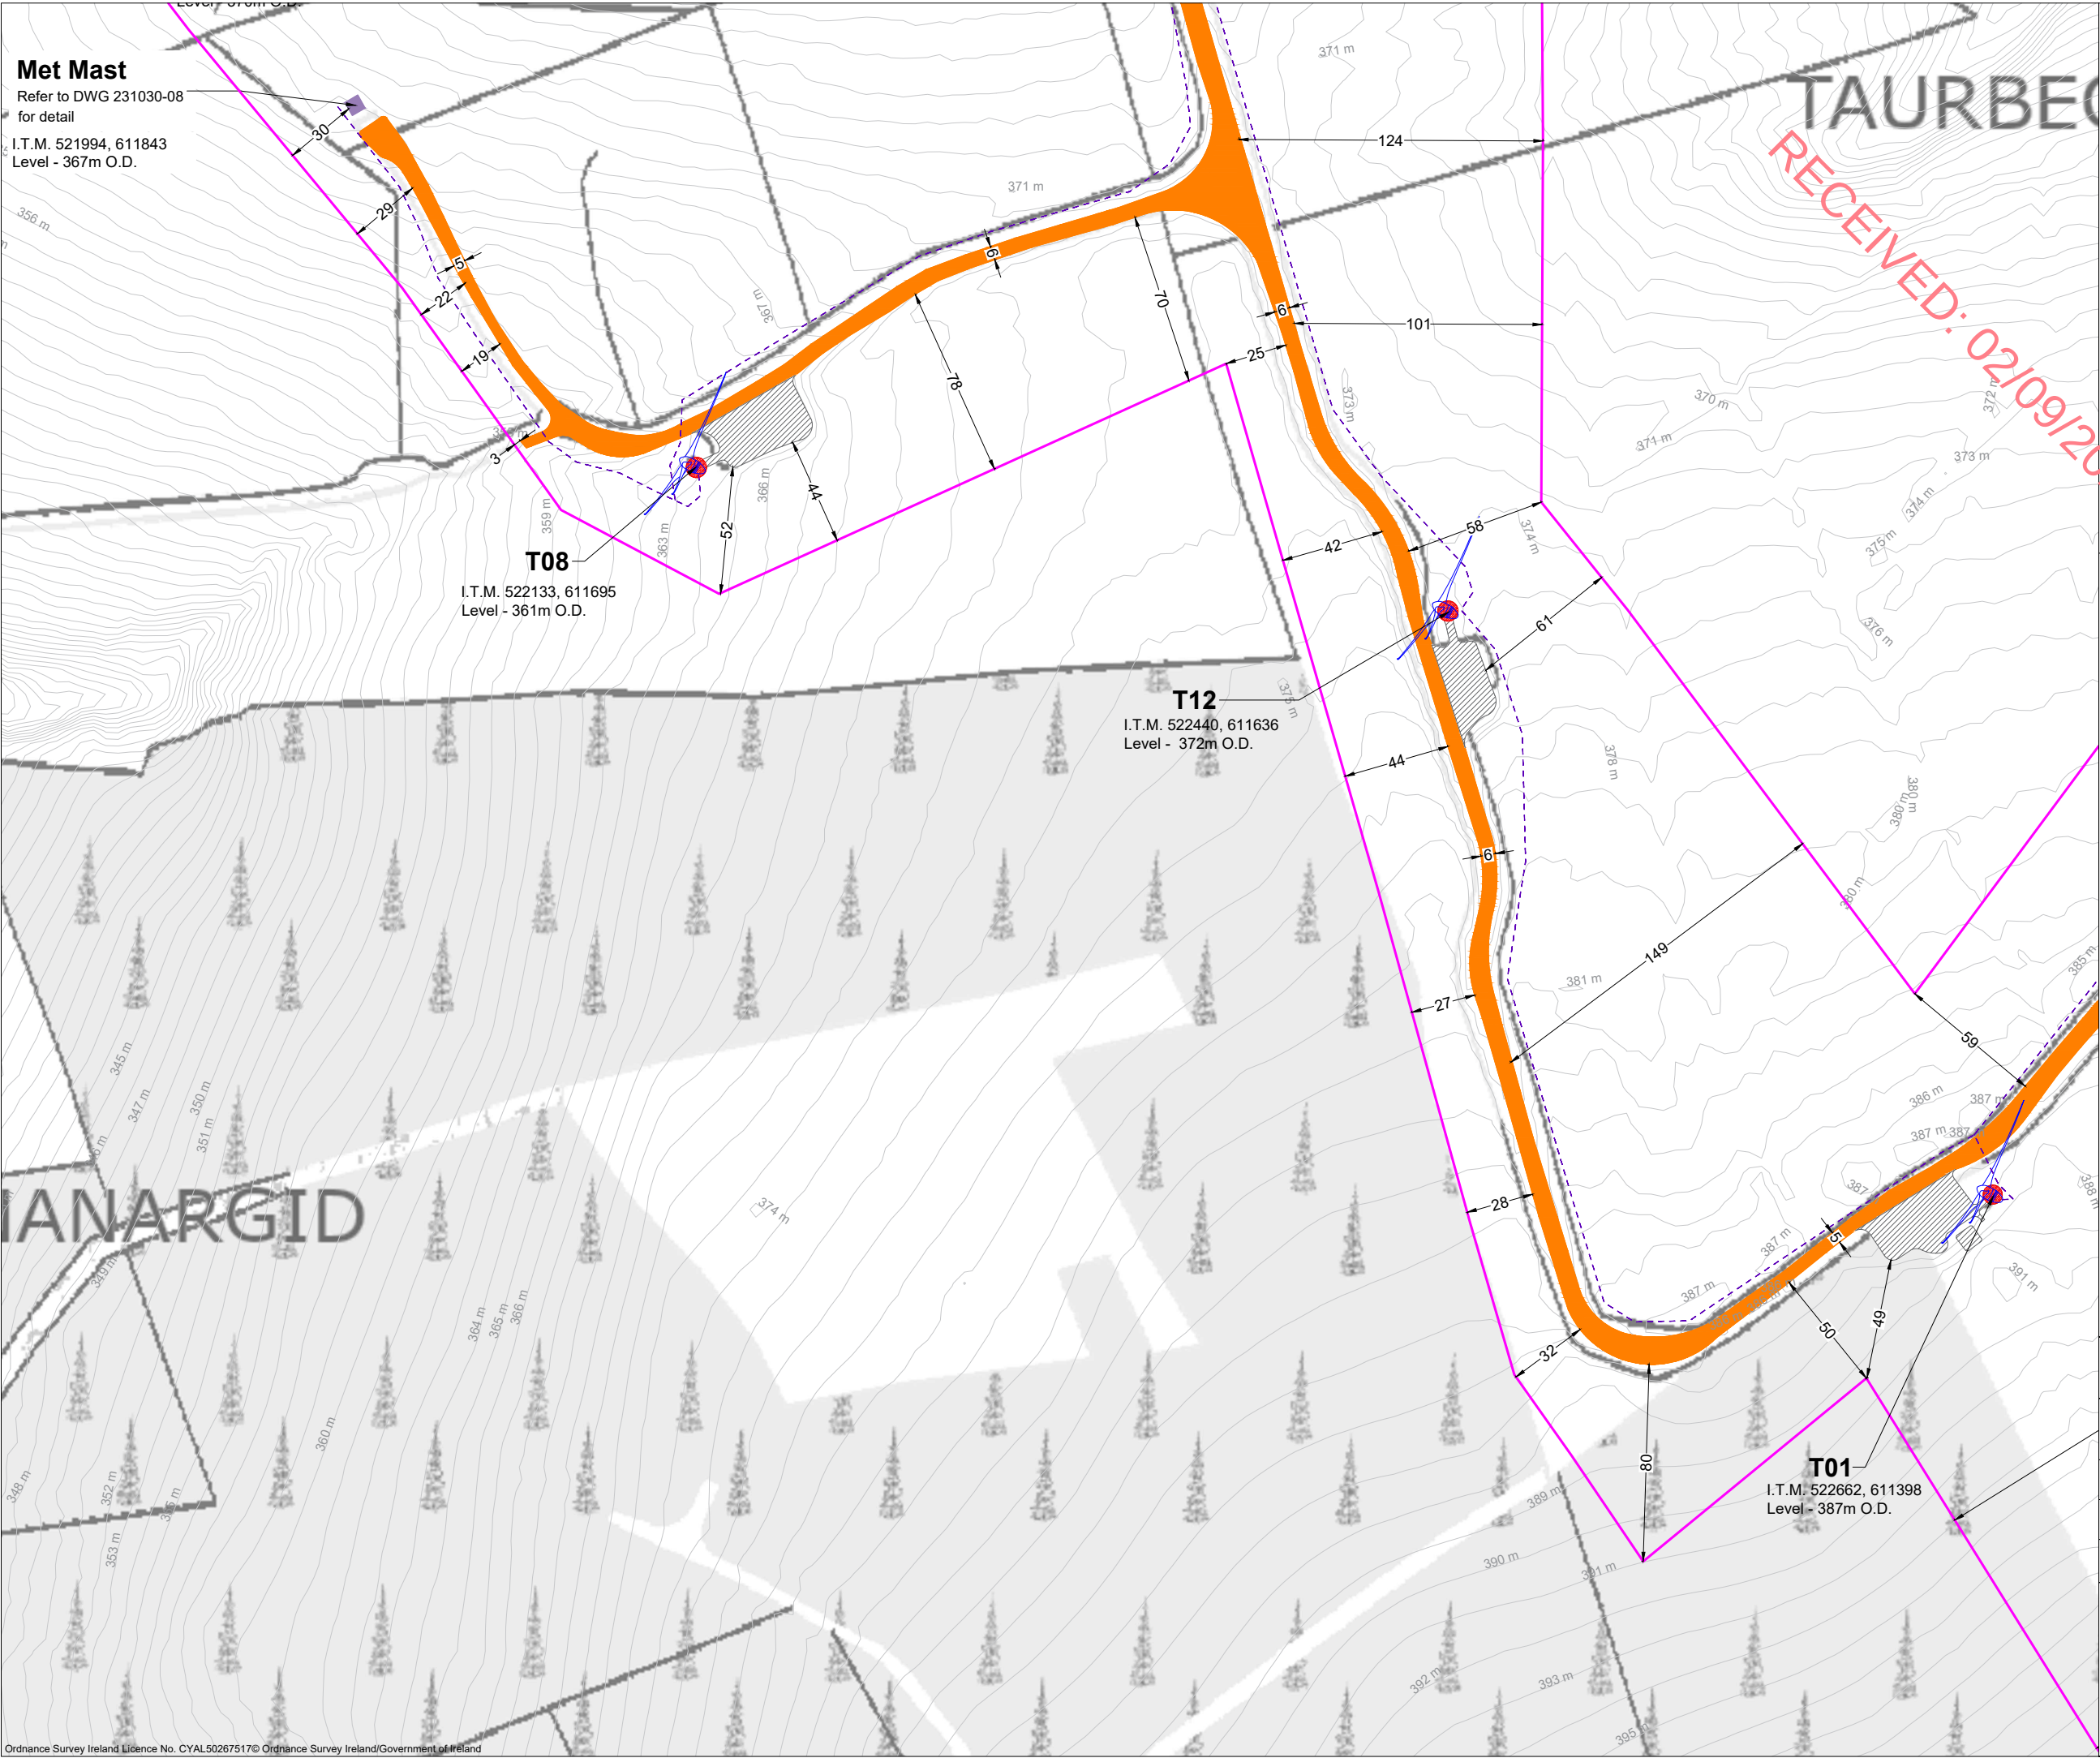

Met Mast
Refer to DWG 231030-08
for detail
I.T.M. 521994, 611843
Level - 367m O.D.

T08
I.T.M. 522133, 611695
Level - 361m O.D.

T12
I.T.M. 522440, 611636
Level - 372m O.D.

T01
I.T.M. 522662, 611398
Level - 387m O.D.


- Drawing Legend**
- Planning Application Boundary (Cork County Council)
 - As Built Site Road
 - As Built Hardstanding Area
 - As Built Turbine
 - As Built Met Mast
 - As Built Turbine Foundation
 - Electrical Cable Trench



PROJECT TITLE: Taurbeg Wind Farm Extension of Operational Life- Proposed Offsetting Measures		
DRAWING TITLE: Site Layout Plan Sheet 03 of 08		
PROJECT No.: 231030	DRAWING No.: 231030 - 03C	SCALE: 1:2,500 @ A3
DRAWN BY: GO	CHECKED BY: N/A	DATE: 04.07.2025
OS SHEET No.:		REVISION.: P01
5597, 5598, 5667, 5668		



Email: info@mkoireland.ie | Website: www.mkoireland.ie
Email: InfoIreland@statkraft.com | Website: www.statkraft.ie

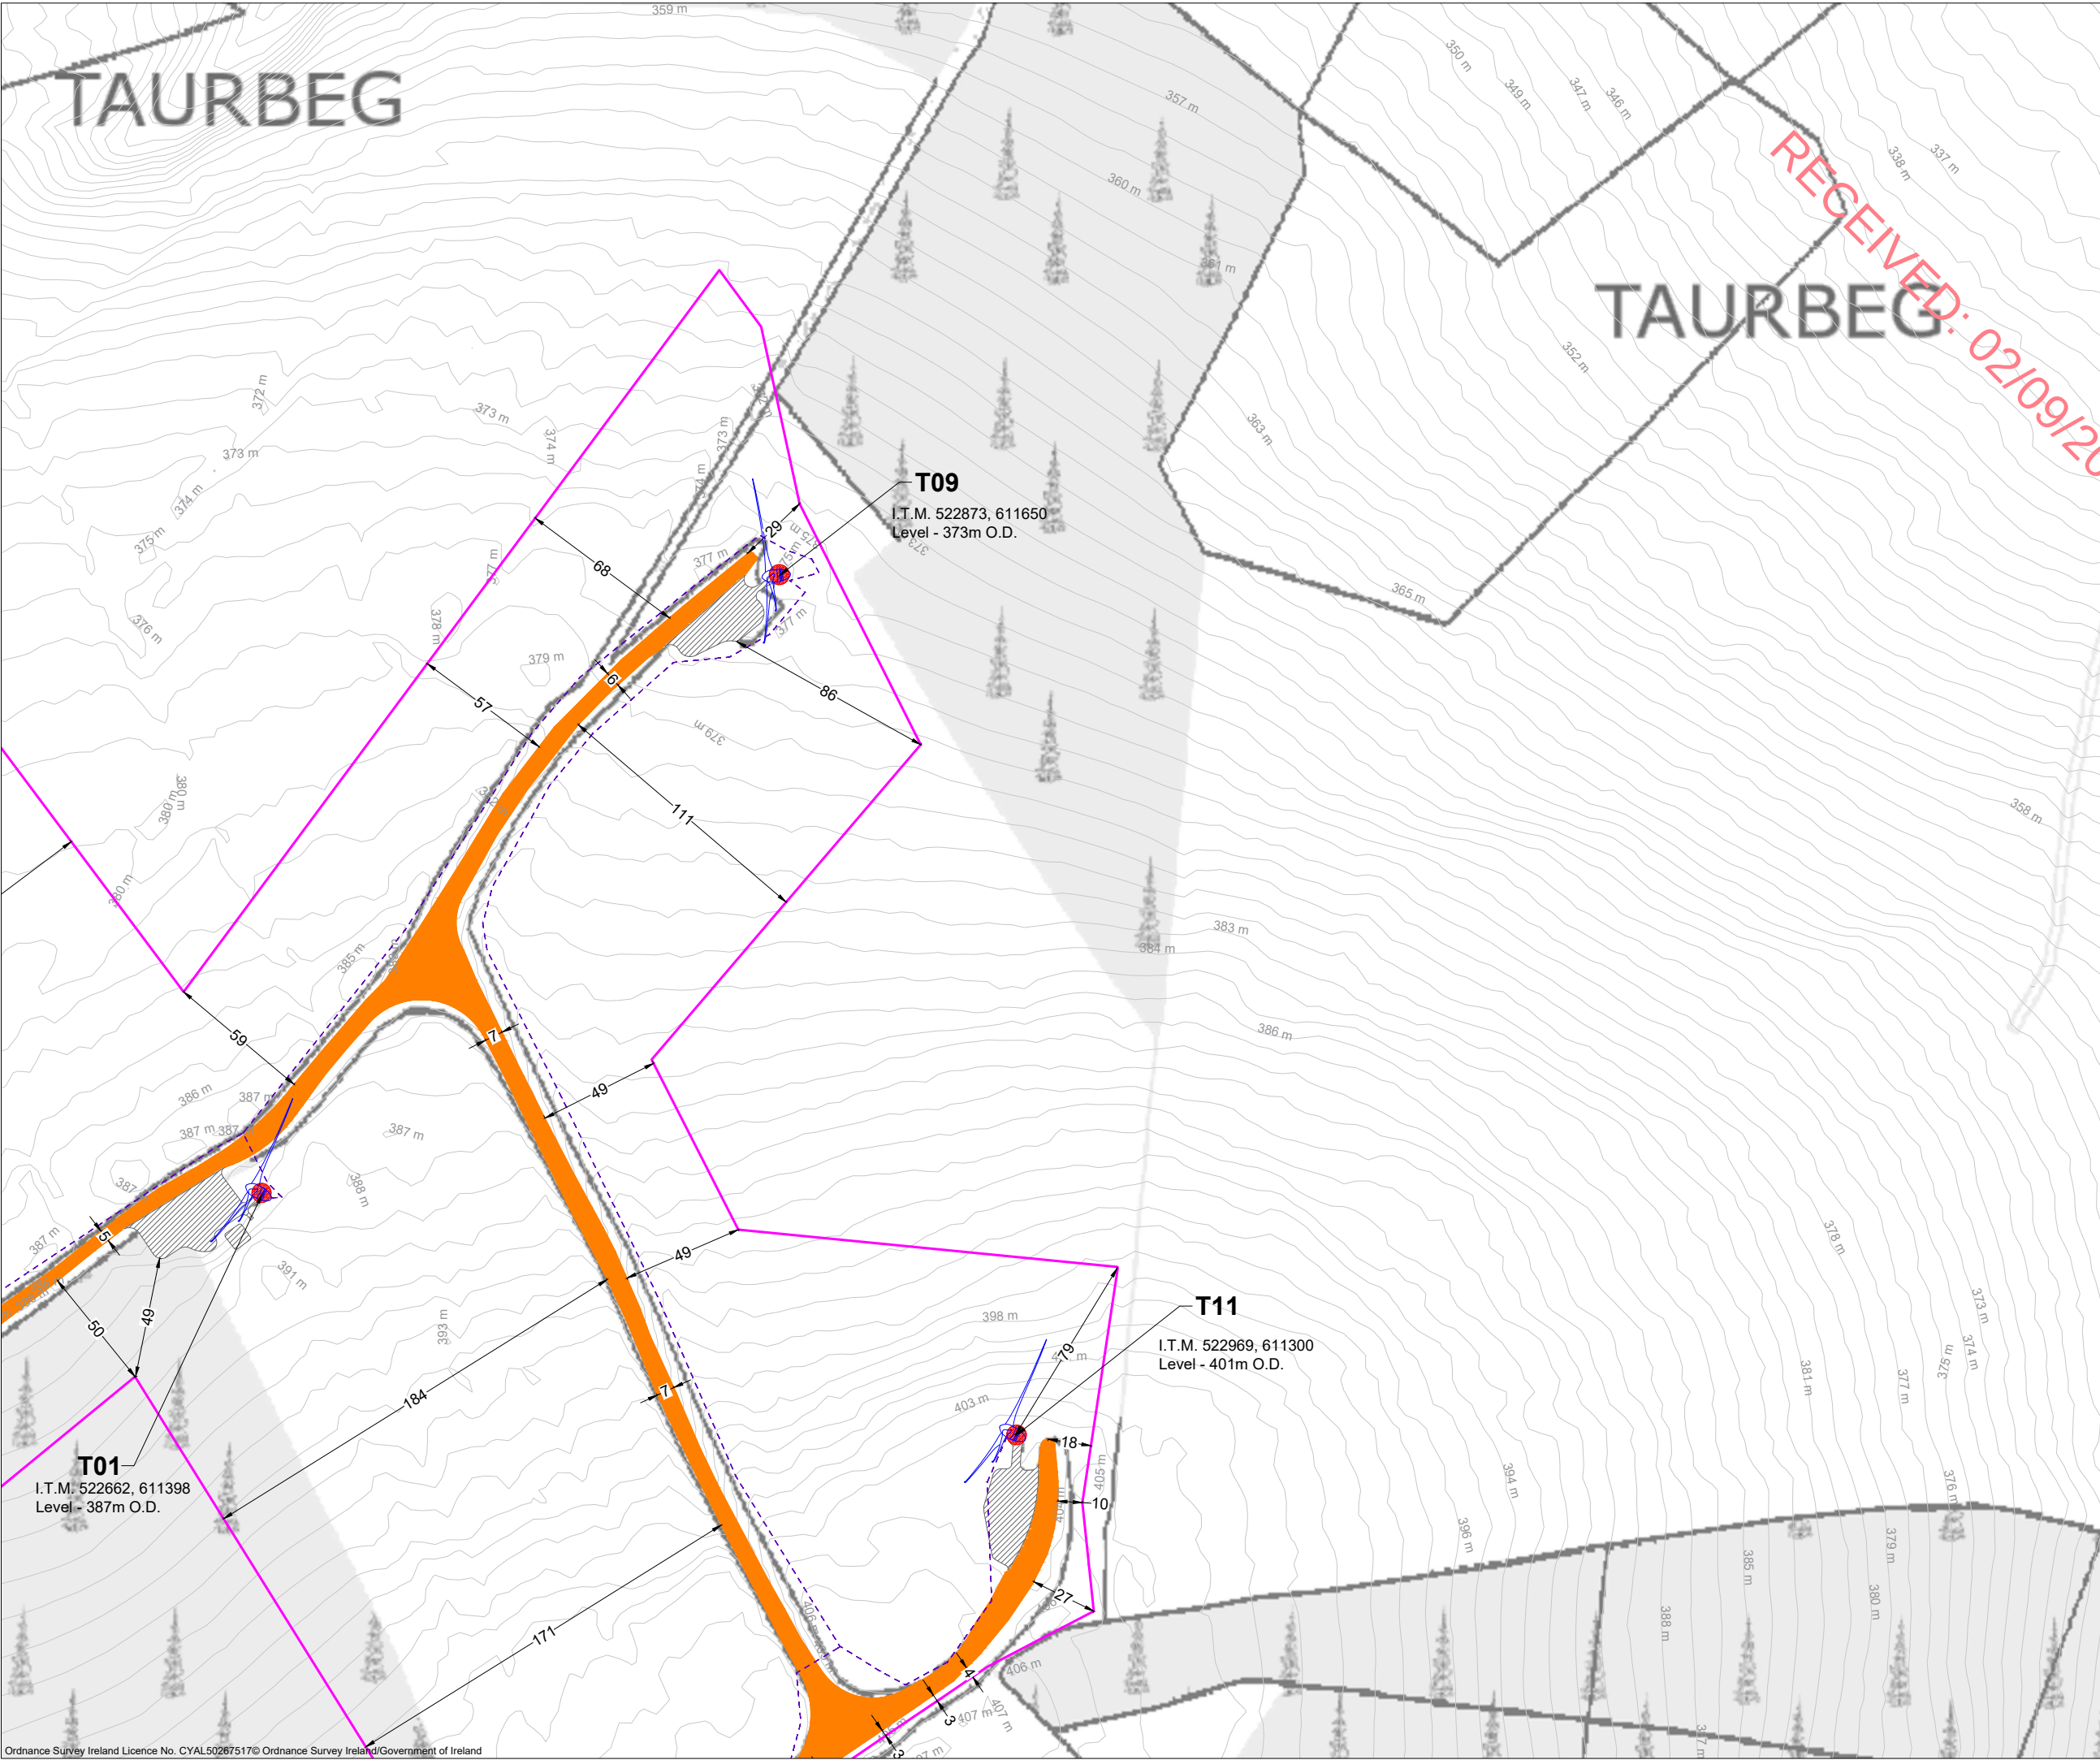

Ordnance Survey Ireland Licence No. CYAL50267517© Ordnance Survey Ireland/Government of Ireland

Drawing Legend

- Planning Application Boundary (Cork County Council)
- As Built Site Road
- As Built Hardstanding Area
- As Built Turbine
- As Built Turbine Foundation
- Electrical Cable Trench



PROJECT TITLE:
Taurbeg Wind Farm Extension of Operational Life- Proposed Offsetting Measures


DRAWING TITLE:
**Site Layout Plan Sheet
04 of 08**

PROJECT No.: 231030	DRAWING No.: 231030 - 03D	SCALE: 1:2,500 @ A3
DRAWN BY: GO	CHECKED BY: N/A	DATE: 04.07.2025
		REVISION.: P01

OS SHEET No.:
5597, 5598, 5667, 5668



Email: info@mkoireland.ie | Website: www.mkoireland.ie
Email: Infoireland@statkraft.com | Website: www.statkraft.ie

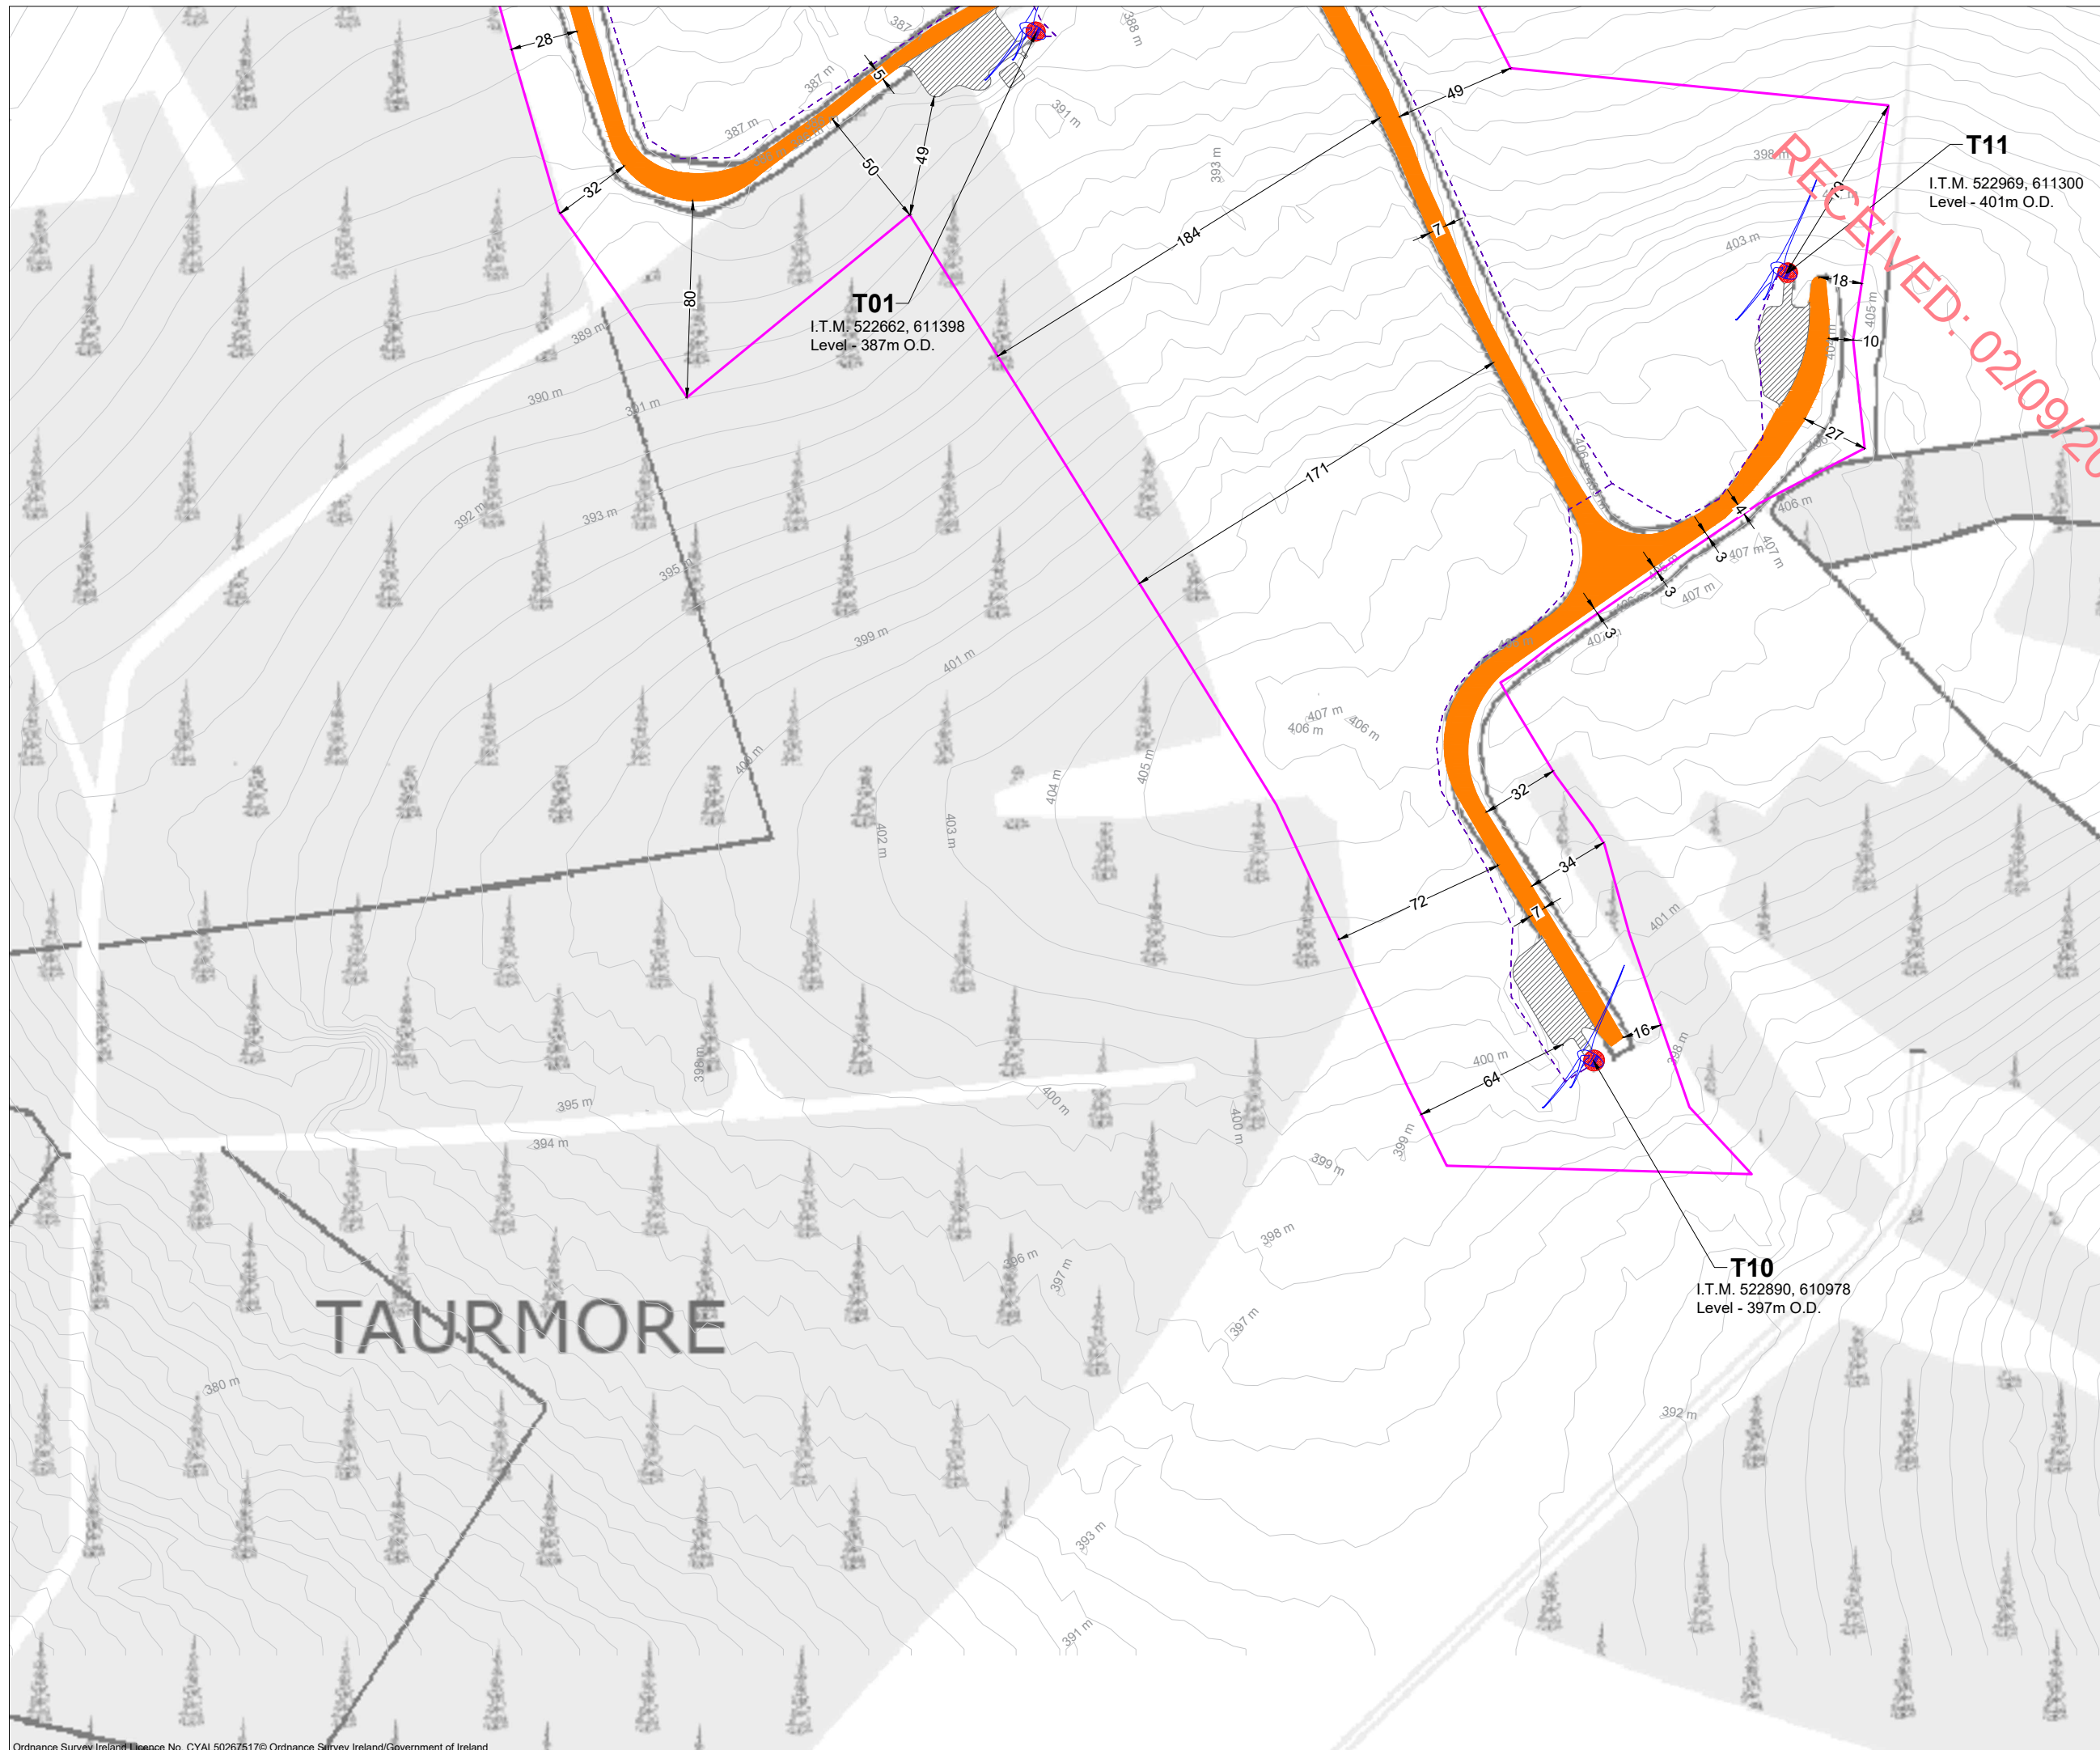

Drawing Legend

- | | |
|---|---|
|  | Planning Application Boundary (Cork County Council) |
|  | As Built Site Road |
|  | As Built Hardstanding Area |
|  | As Built Turbine |
|  | As Built Turbine Foundation |
|  | Electrical Cable Trench |



PROJECT TITLE:
**Taurbeg Wind Farm Extension of Operational
Life- Proposed Offsetting Measures**

DRAWING TITLE:

Site Layout Plan Sheet

05 of 08


05 of 08

PROJECT No.: 231030		DRAWING No.: 231030 - 03E	SCALE: 1:2,500 @ A3
DRAWN BY: GO	CHECKED BY: N/A	DATE: 04.07.2025	REVISION:. P01

OS SHEET No.: 5597, 5598, 5667, 5668




Email: info@mkoireland.ie | Website: www.mkoireland.ie
Email: Infoland@statkraft.com | Website: www.statkraft.ie

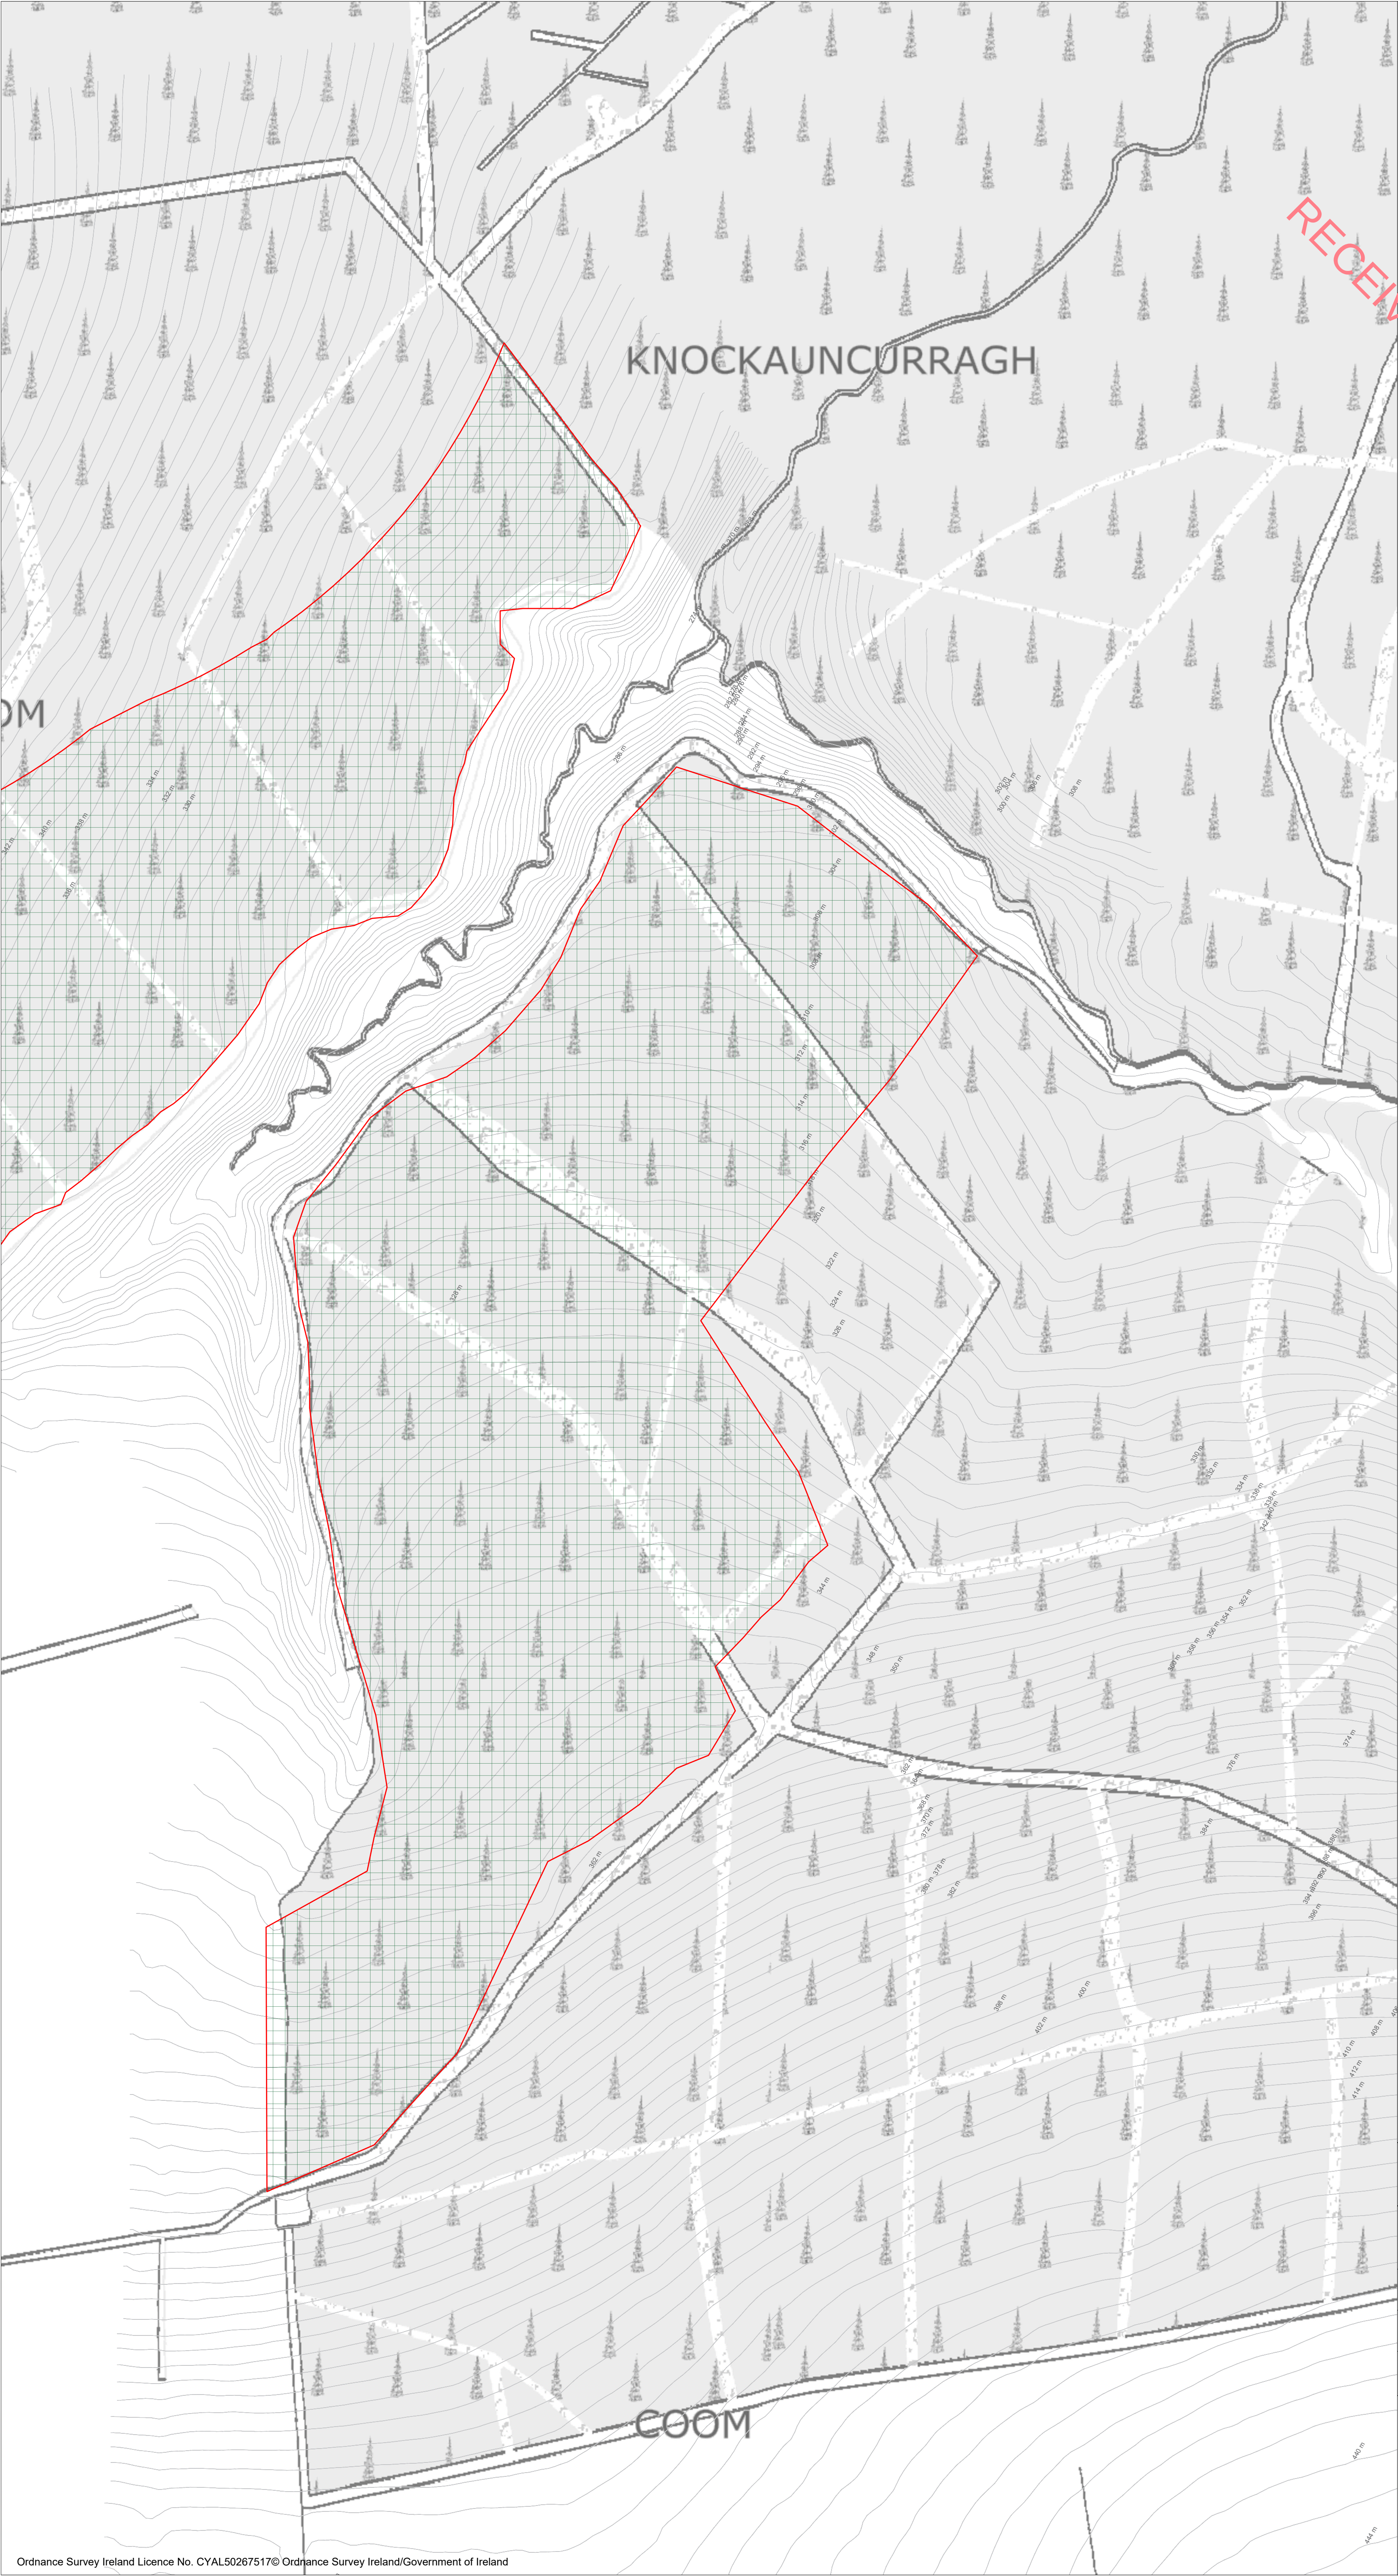

Drawing Legend

Planning Application Boundary (Kerry County Council)

Deforestation Areas (Coniferous Forestry Plantation)

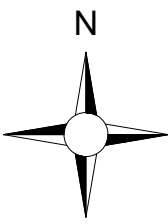


PROJECT TITLE: Taubeg Wind Farm Extension of Operational Life- Proposed Offsetting Measures		
DRAWING TITLE: Site Layout Plan Sheet 06 of 08		
PROJECT No.: 231030	DRAWING No.: 231030 - 03F	SCALE: 1:2,500 @ A1
DRAWN BY: GO	CHECKED BY: N/A	DATE: 04.07.2025
OS SHEET No.:		REVISION.: P01
5597, 5598, 5667, 5668		

MKO

Statkraft

Email: info@mkoireland.ie | Website: www.mkoireland.ie
Email: InfoIreland@statkraft.com | Website: www.statkraft.ie

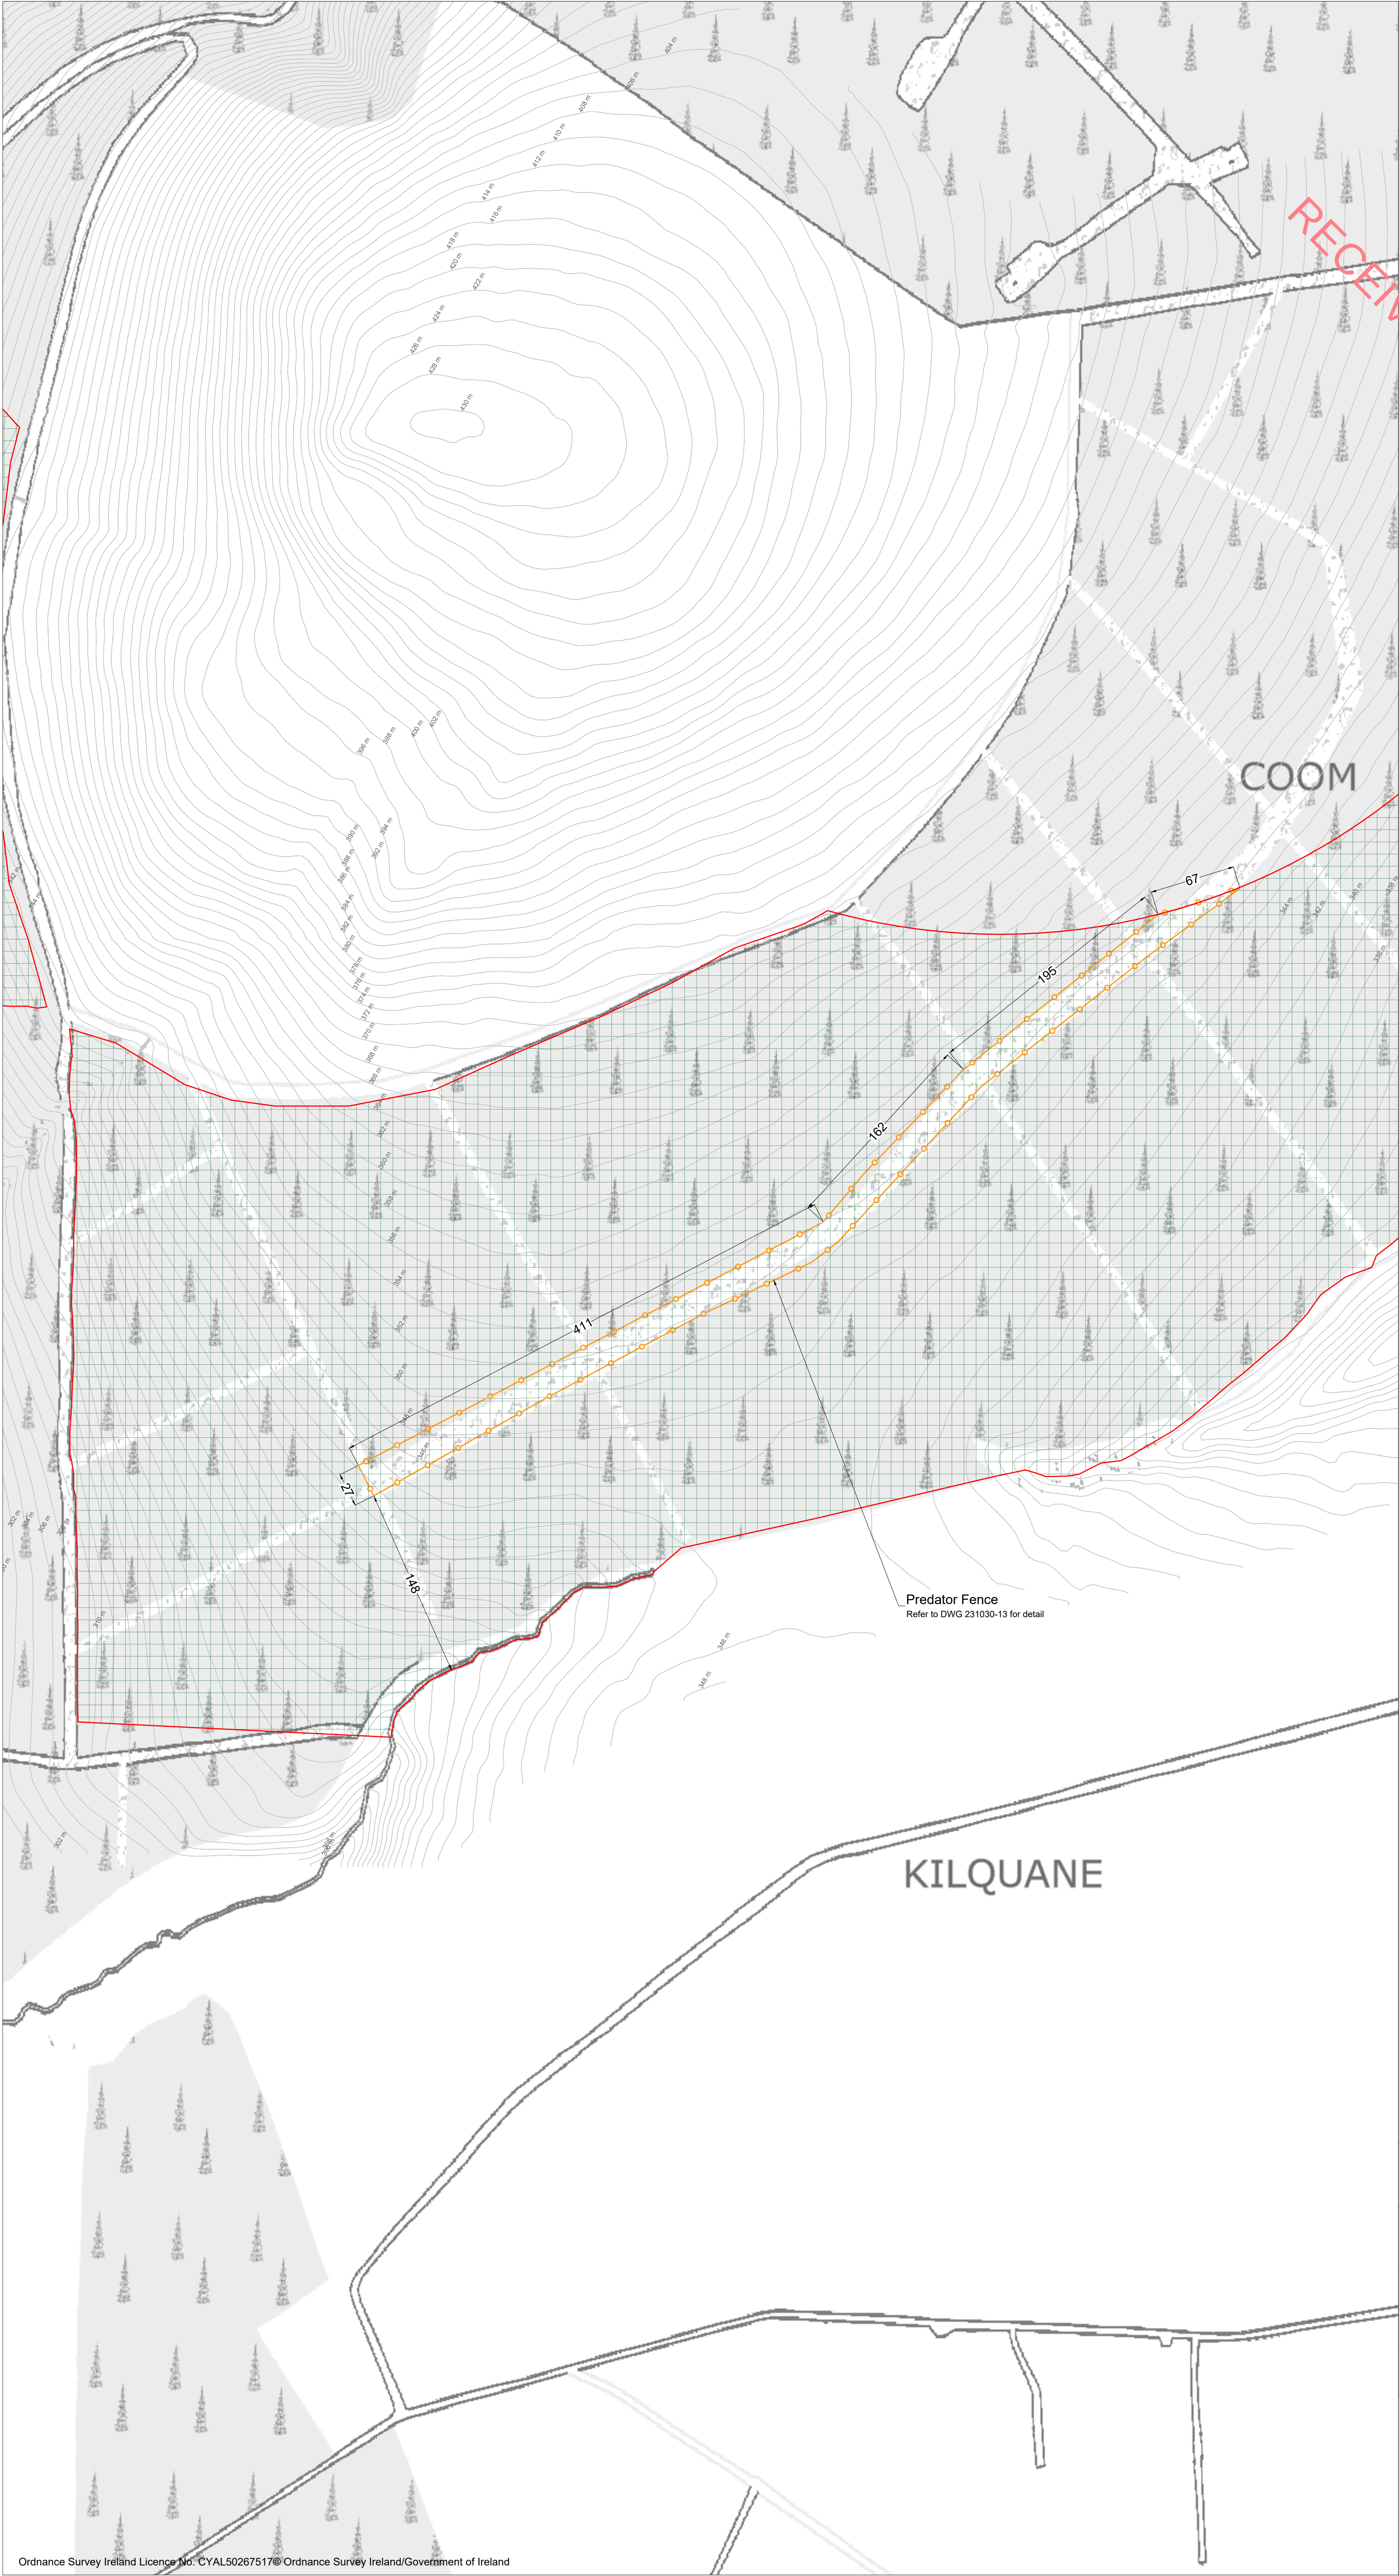

Drawing Legend

- Planning Application Boundary (Kerry County Council)
- Deforestation Areas (Coniferous Forestry Plantation)
- Predator Fence


PROJECT TITLE:
Taubeg Wind Farm Extension of Operational Life- Proposed Offsetting Measures

DRAWING TITLE:
Site Layout Plan Sheet 07 of 08

PROJECT No.: 231030	DRAWING No.: 231030 - 03G	SCALE: 1:2,500 @ A1
DRAWN BY: GO	CHECKED BY: N/A	DATE: 04.07.2025
		REVISION: P01

OS SHEET No.:
5597, 5598, 5667, 5668

Email: info@mkoireland.ie | Website: www.mkoireland.ie
Email: InfoIreland@statkraft.com | Website: www.statkraft.ie

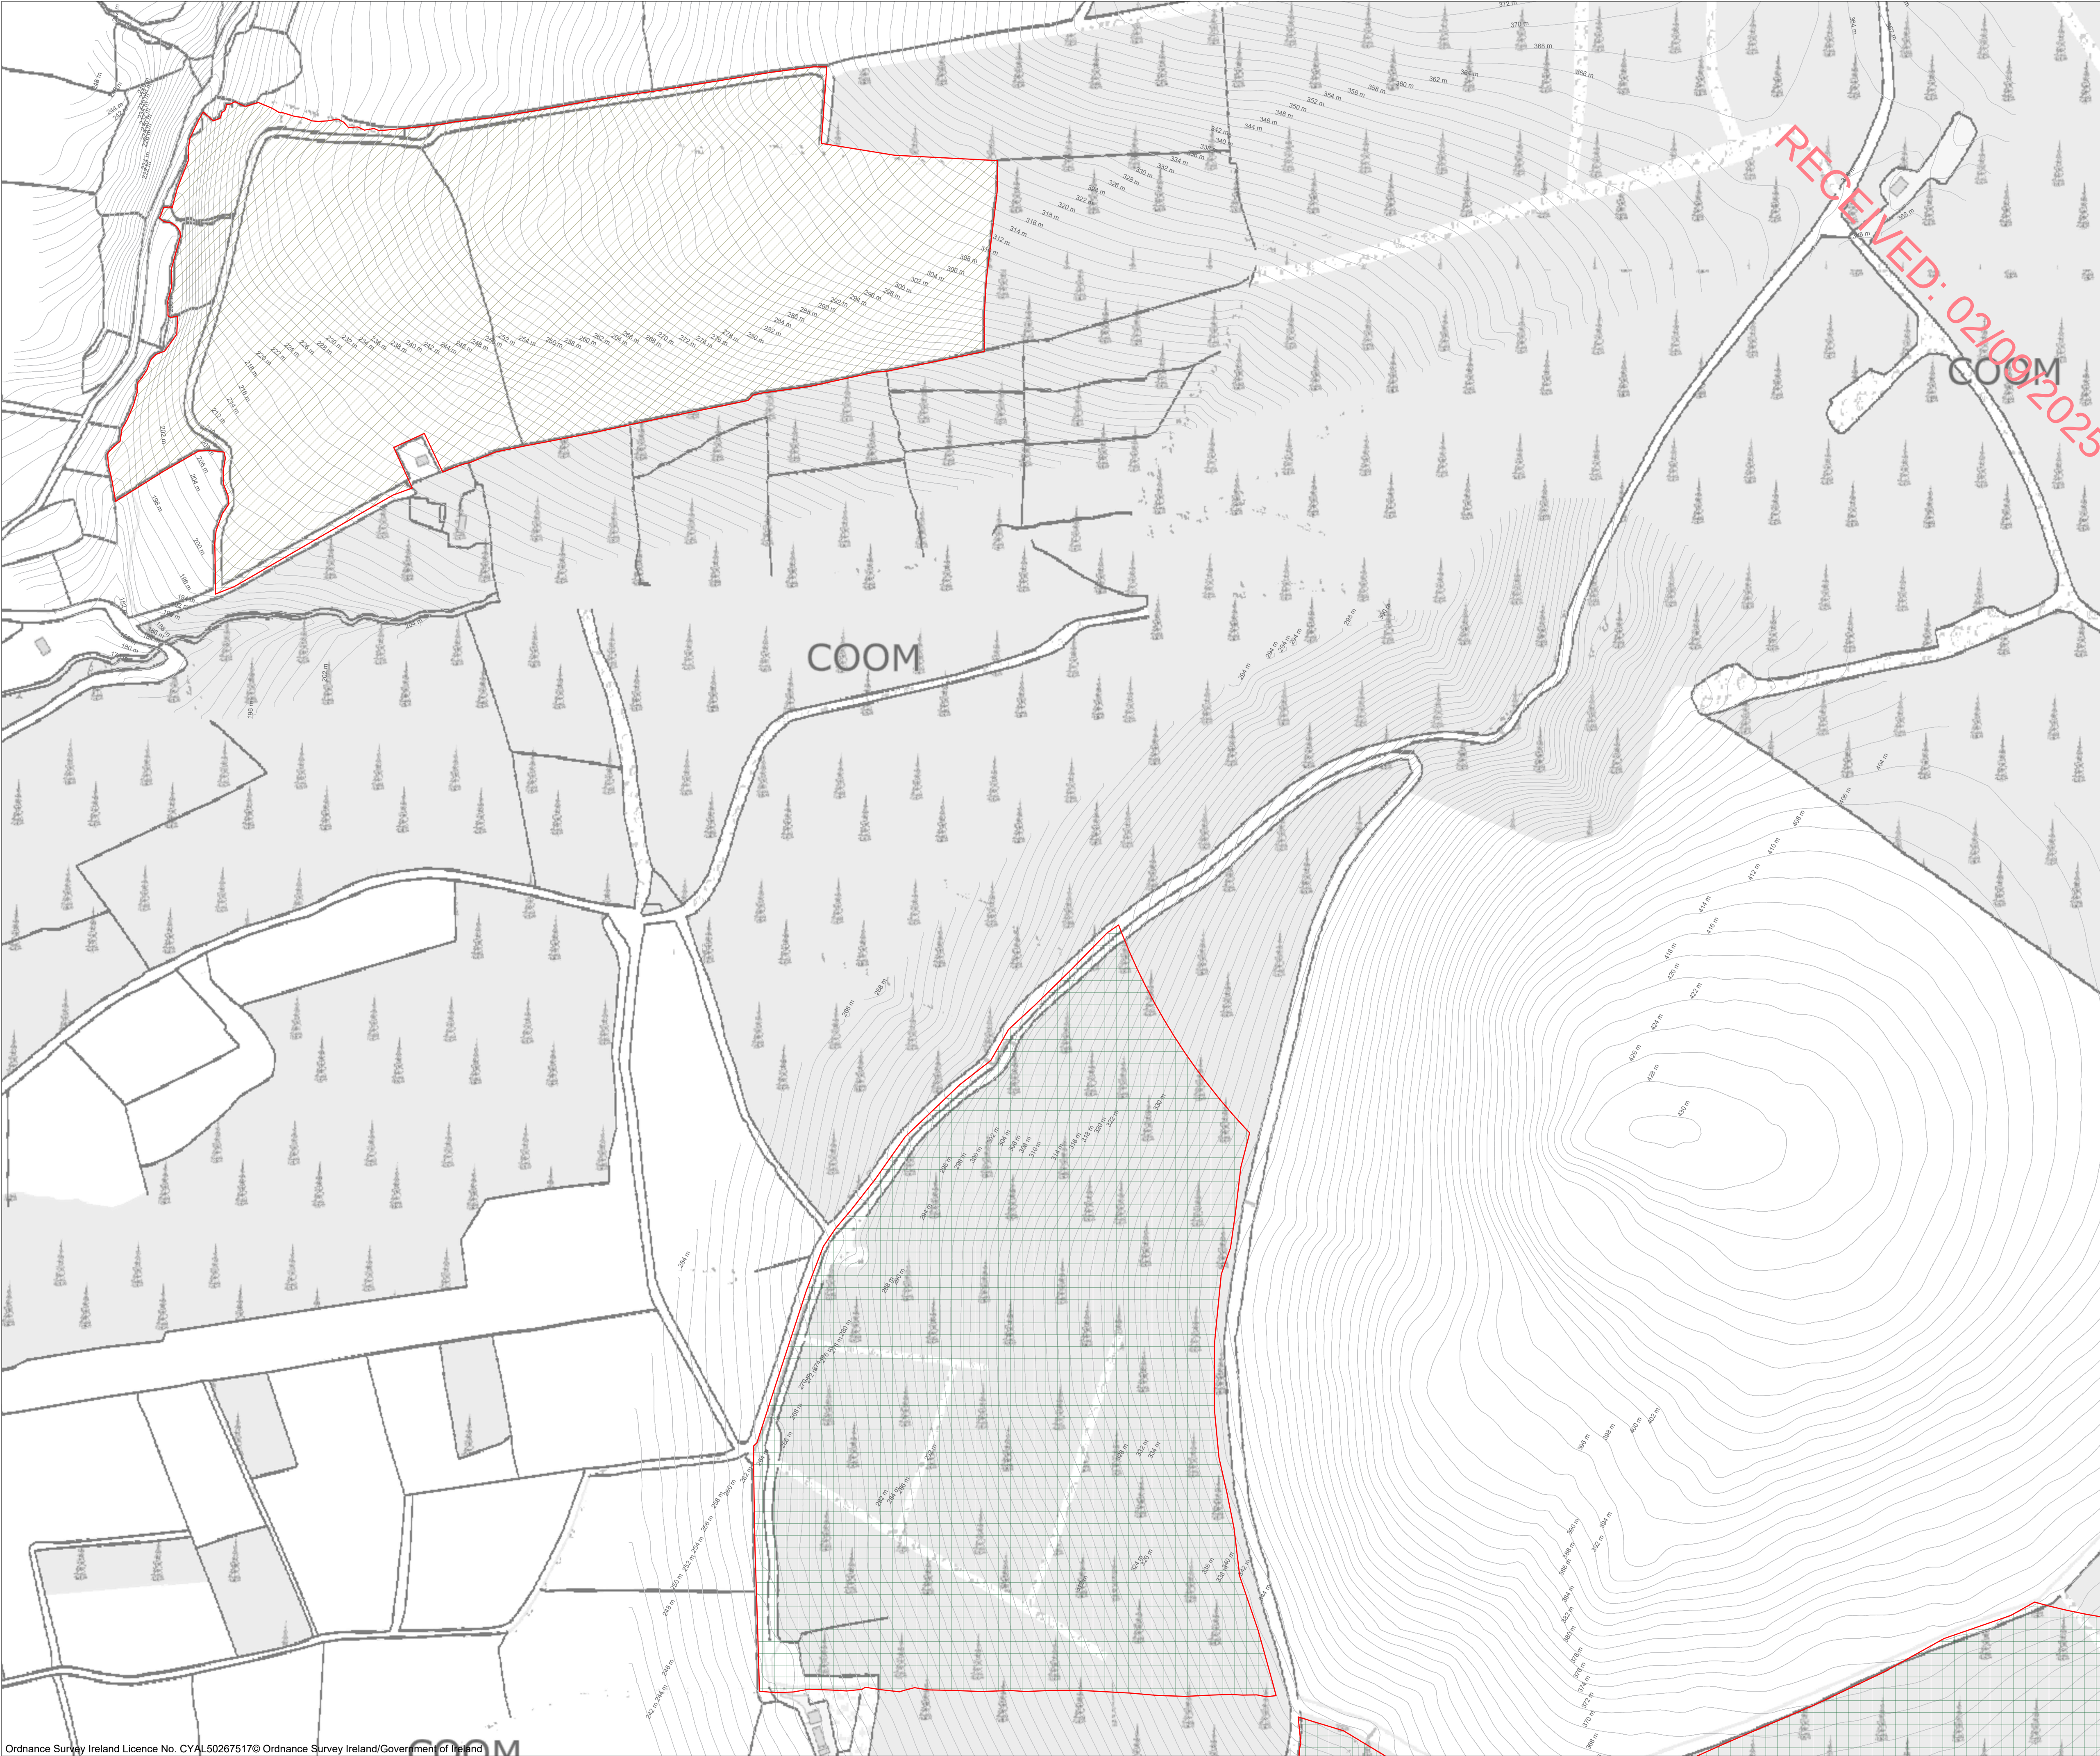


Drawing Legend

- Planning Application Boundary (Kerry County Council)
- Deforestation Areas (Coniferous Forestry Plantation)
- Farmland Restoration Area

Farmland Restoration Measures:

- Planting and restoring of hedgerow
- Rotational grazing scheme
- Linear wildlife crop sowing
- Cease on fertilizer application

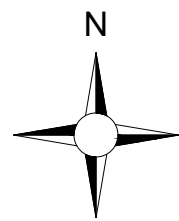

PROJECT TITLE: Taurbeg Wind Farm Extension of Operational Life- Proposed Offsetting Measures			
DRAWING TITLE: Site Layout Plan Sheet 08 of 08			
PROJECT No.: 231030	DRAWING No.: 231030 - 03H	SCALE: 1:2,500 @ A1	
DRAWN BY: GO	CHECKED BY: N/A	DATE: 04.07.2025	REVISION: P01
OS SHEET No.: 5597, 5598, 5667, 5668			



Email: info@mkoireland.ie | Website: www.mkoireland.ie
Email: InfoIreland@statkraft.com | Website: www.statkraft.ie