




APPENDIX 3-3

Drainage Drawings




Schedule of Drawings

Drawing No.	Drawing Title	Scale
D801	As Built Drainage Layout Sheet 1 of 6	1:2,500 @A1
D802	As Built Drainage Layout Sheet 2 of 6	1:2,500 @A1
D803	As Built Drainage Layout Sheet 3 of 6	1:2,500 @A1
D804	As Built Drainage Layout Sheet 4 of 6	1:2,500 @A1
D805	As Built Drainage Layout Sheet 5 of 6	1:2,500 @A1
D806	As Built Drainage Layout Sheet 6 of 6	1:2,500 @A1

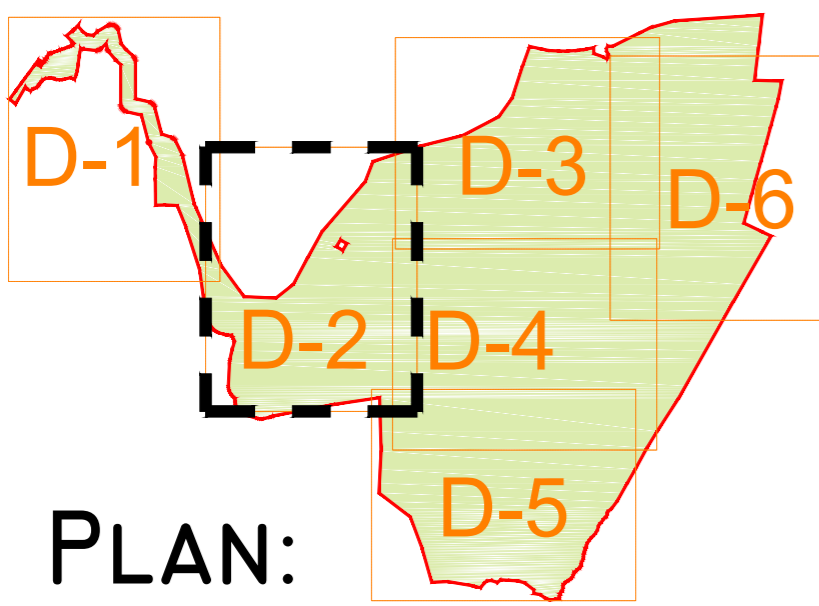

KEY PLAN:

(UNDERLAY IS STUDY AREA
NOT THE APPLICATION BOUNDARY)

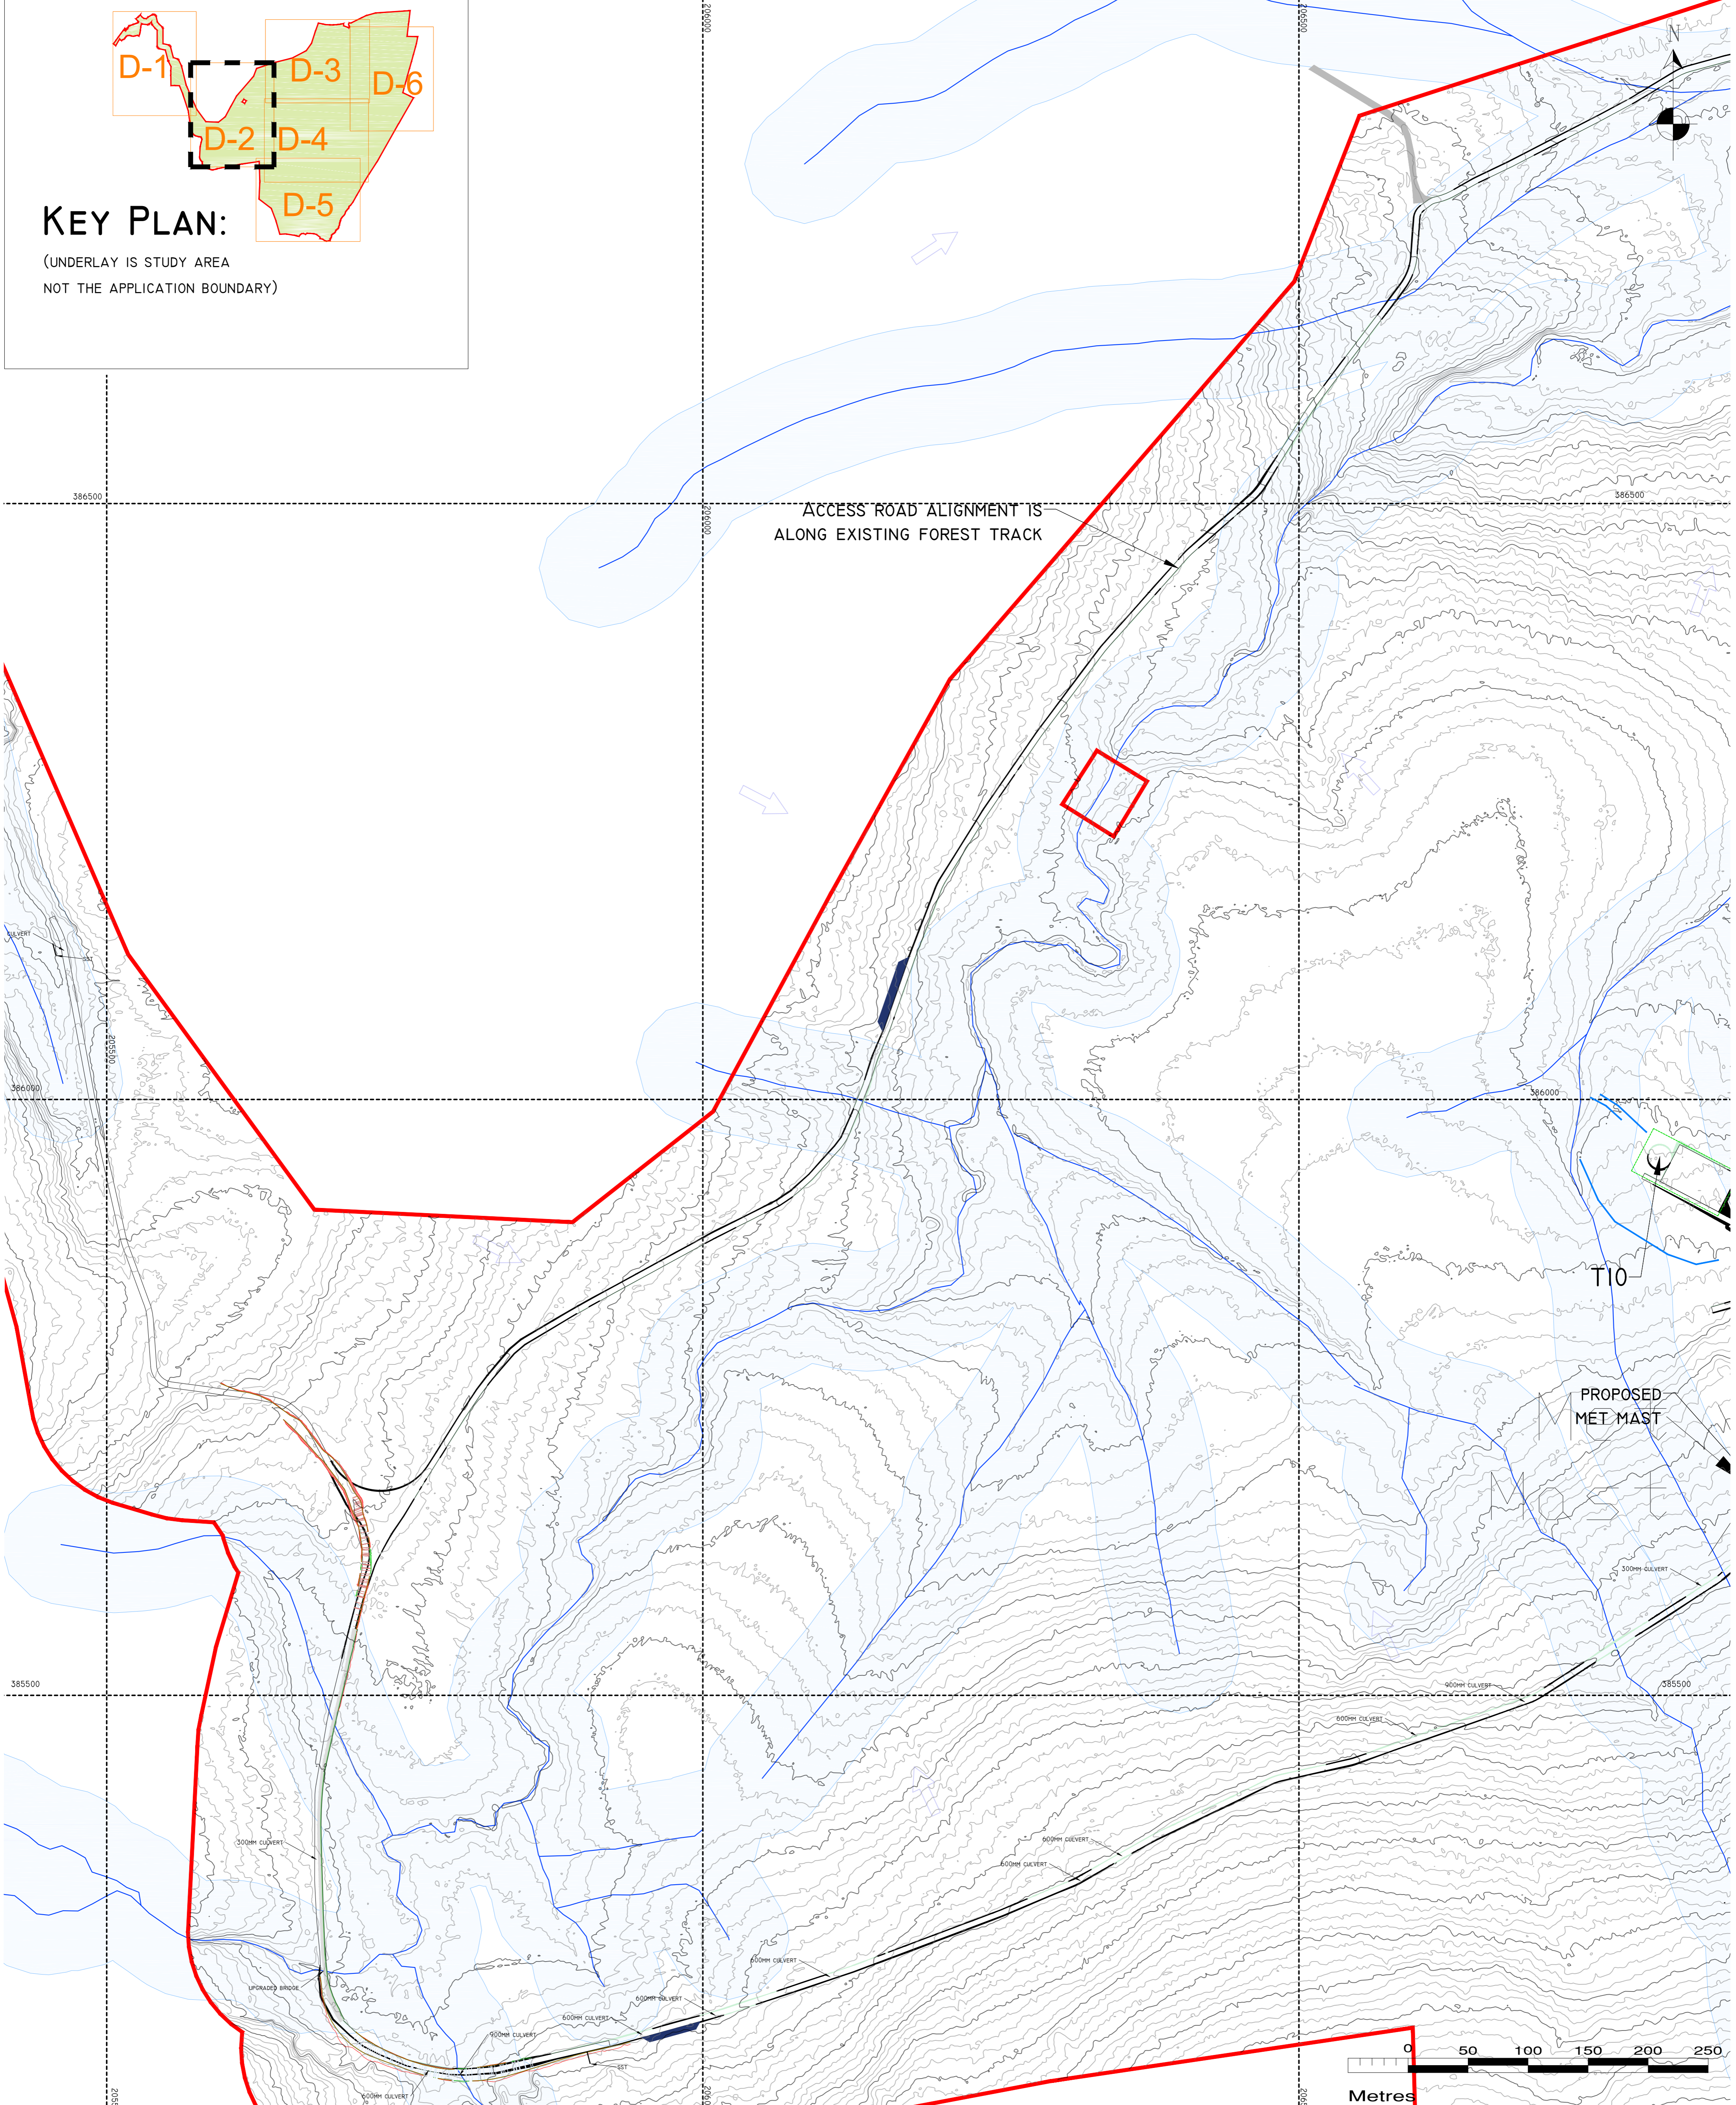

ACCESS ROAD ALIGNMENT IS
ALONG EXISTING FOREST TRACK

PROPOSED
MET MAST



DRAWING LEGEND :

ST	SINGLE SILT TRAP
DST	DOUBLE SILT TRAP
TST	TRIPLE SILT TRAP
MST	MULTI SILT TRAP (NUMBERS)
DSP	DOUBLE SETTLEMENT POND
CULVERT	300/600/900MM CULVERT
	INTERCEPTOR DRAIN (AS BUILT)
	FLOW DIRECTION
	APPLICATION SITE BOUNDARY
	RIVERS

DRAWING NOTES

1. AS-BUILT DRAWINGS BASED ON SITE AUDITS COMPLETED ON 24/12/2020 AND 25/11/2020. NOTE: ADDITIONAL DRAINAGE MITIGATION MAY HAVE BEEN INSTALLED SINCE THOSE DATES.
2. COPYRIGHT, ALL RIGHTS RESERVED. NO PART HERE WITH MAY BE COPIED OR REPRODUCED PARTIALLY OR WHOLLY IN ANY FORM WHATSOEVER WITHOUT THE PRIOR NOTICE OF THE COPYRIGHT OWNER HYDRO-ENVIRONMENTAL SERVICES.
3. DO NOT SCALE OFF THIS DRAWING. FIGURED METRIC DIMENSIONS ONLY SHOULD BE TAKEN OFF THIS DRAWING.
4. ALL DIMENSIONS ARE IN METRES.

Ordnance Survey Ireland Licence No. EN 0044720
© Ordnance Survey Ireland/Government of Ireland


Date	Description	Chkd	Signed
Revisions			

HYDRO ENVIRONMENTAL SERVICES

22 Lower Main St
Dungarvan
Co. Waterford
Ireland

tel: +353 (0) 58-44122
tel: +353 (0) 58-44244
email: info@hydroenvironmental.ie
web: www.hydroenvironmental.ie

Client:	MID CORK ELECTRICAL
Job:	MEENBOG WIND FARM, Co. DONEGAL
Title:	AS BUILT DRAINAGE LAYOUT SHEET 2 OF 6
Figure No:	D802
Drawing No:	P1249-5-1220-A1-D802-00A
Sheet Size:	A1
Scale:	1:2,500 (A1)
Date:	16/12/2020
Project No.:	P1249-5
Drawn By:	MG/GD
Checked By:	MG

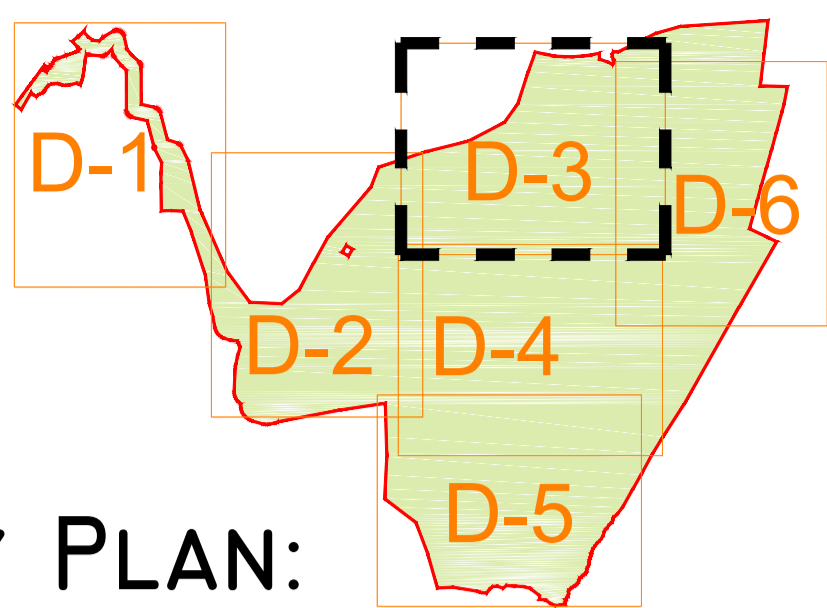

KEY PLAN:

(UNDERLAY IS STUDY AREA
NOT THE APPLICATION BOUNDARY)

- DRAWING LEGEND :**
- ST SINGLE SILT TRAP
 - DST DOUBLE SILT TRAP
 - TST TRIPLE SILT TRAP
 - MST MULTI SILT TRAP (NUMBERS)
 - DSP DOUBLE SETTLEMENT POND
 - CULVERT 300/600/900MM CULVERT
 - INTERCEPTOR DRAIN (AS BUILT)
 - FLOW DIRECTION
 - APPLICATION SITE BOUNDARY
 - RIVERS

- DRAWING NOTES**
1. AS-BUILT DRAWINGS BASED ON SITE AUDITS COMPLETED ON 24/12/2020 AND 25/11/2020. NOTE: ADDITIONAL DRAINAGE MITIGATION MAY HAVE BEEN INSTALLED SINCE THOSE DATES.
 2. COPYRIGHT, ALL RIGHTS RESERVED. NO PART HERE WITH MAY BE COPIED OR REPRODUCED PARTIALLY OR WHOLLY IN ANY FORM WHATSOEVER WITHOUT THE PRIOR NOTICE OF THE COPYRIGHT OWNER HYDRO-ENVIRONMENTAL SERVICES.
 3. DO NOT SCALE OFF THIS DRAWING. FIGURED METRIC DIMENSIONS ONLY SHOULD BE TAKEN OFF THIS DRAWING.
 4. ALL DIMENSIONS ARE IN METRES.

Ordnance Survey Ireland Licence No. EN 0044720
© Ordnance Survey Ireland/Government of Ireland

Date	Description	Chkd	Signed
Revisions			

HYDRO ENVIRONMENTAL SERVICES

22 Lower Main St
Dungarvan
Co. Waterford
Ireland

tel: +353 (0) 58-44122
tel: +353 (0) 58-44244
email: info@hydroenvironmental.ie
web: www.hydroenvironmental.ie

Client: MID CORK ELECTRICAL

Job: MEENBOG WIND FARM, Co. DONEGAL



Title: AS BUILT DRAINAGE LAYOUT SHEET 3 OF 6


Figure No: D803

Drawing No: P1249-S-1220-A1-D803-00A

Sheet Size: A1 Project No.: P1249-5

Scale: 1:2,500 (A1) Drawn By: MG/GD
Date: 16/12/2020 Checked By: MG

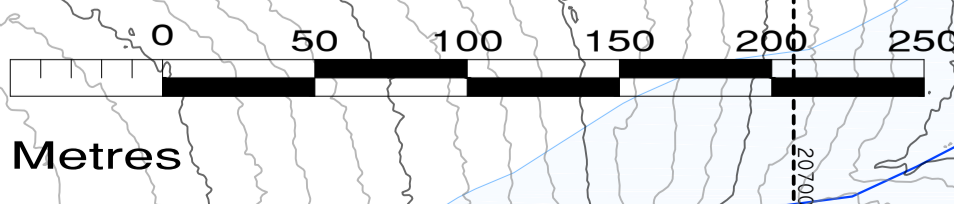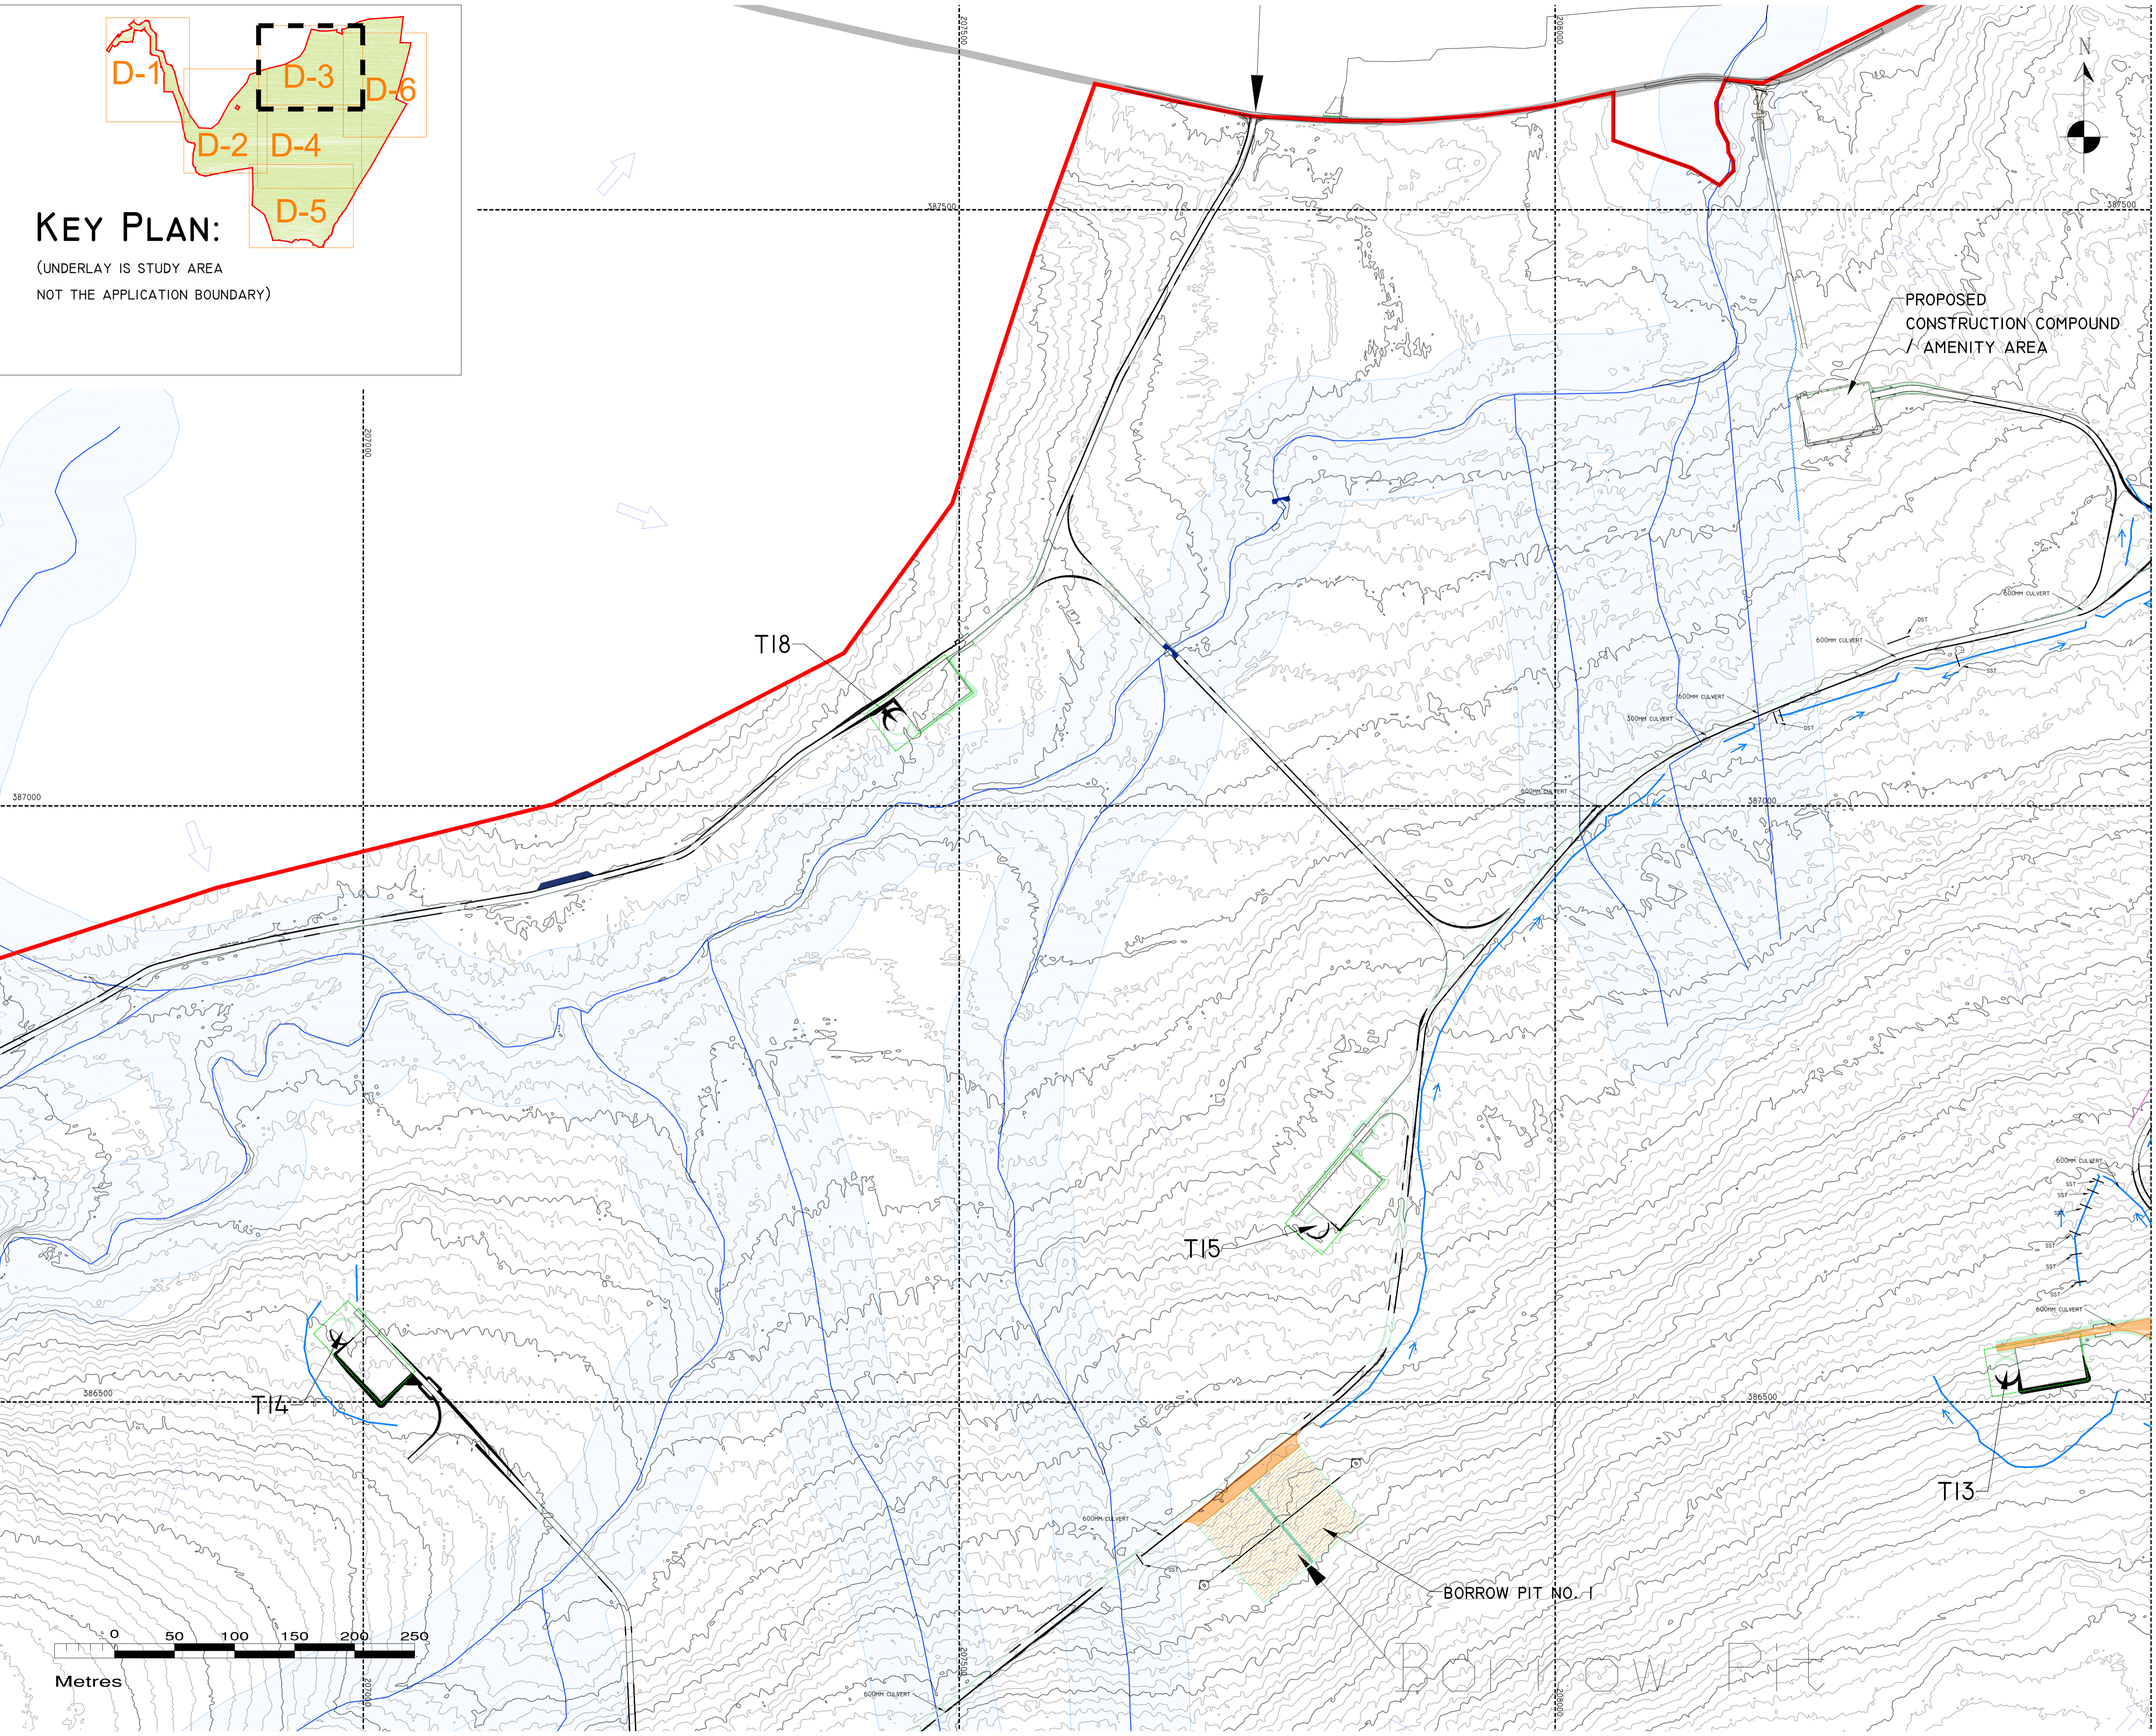

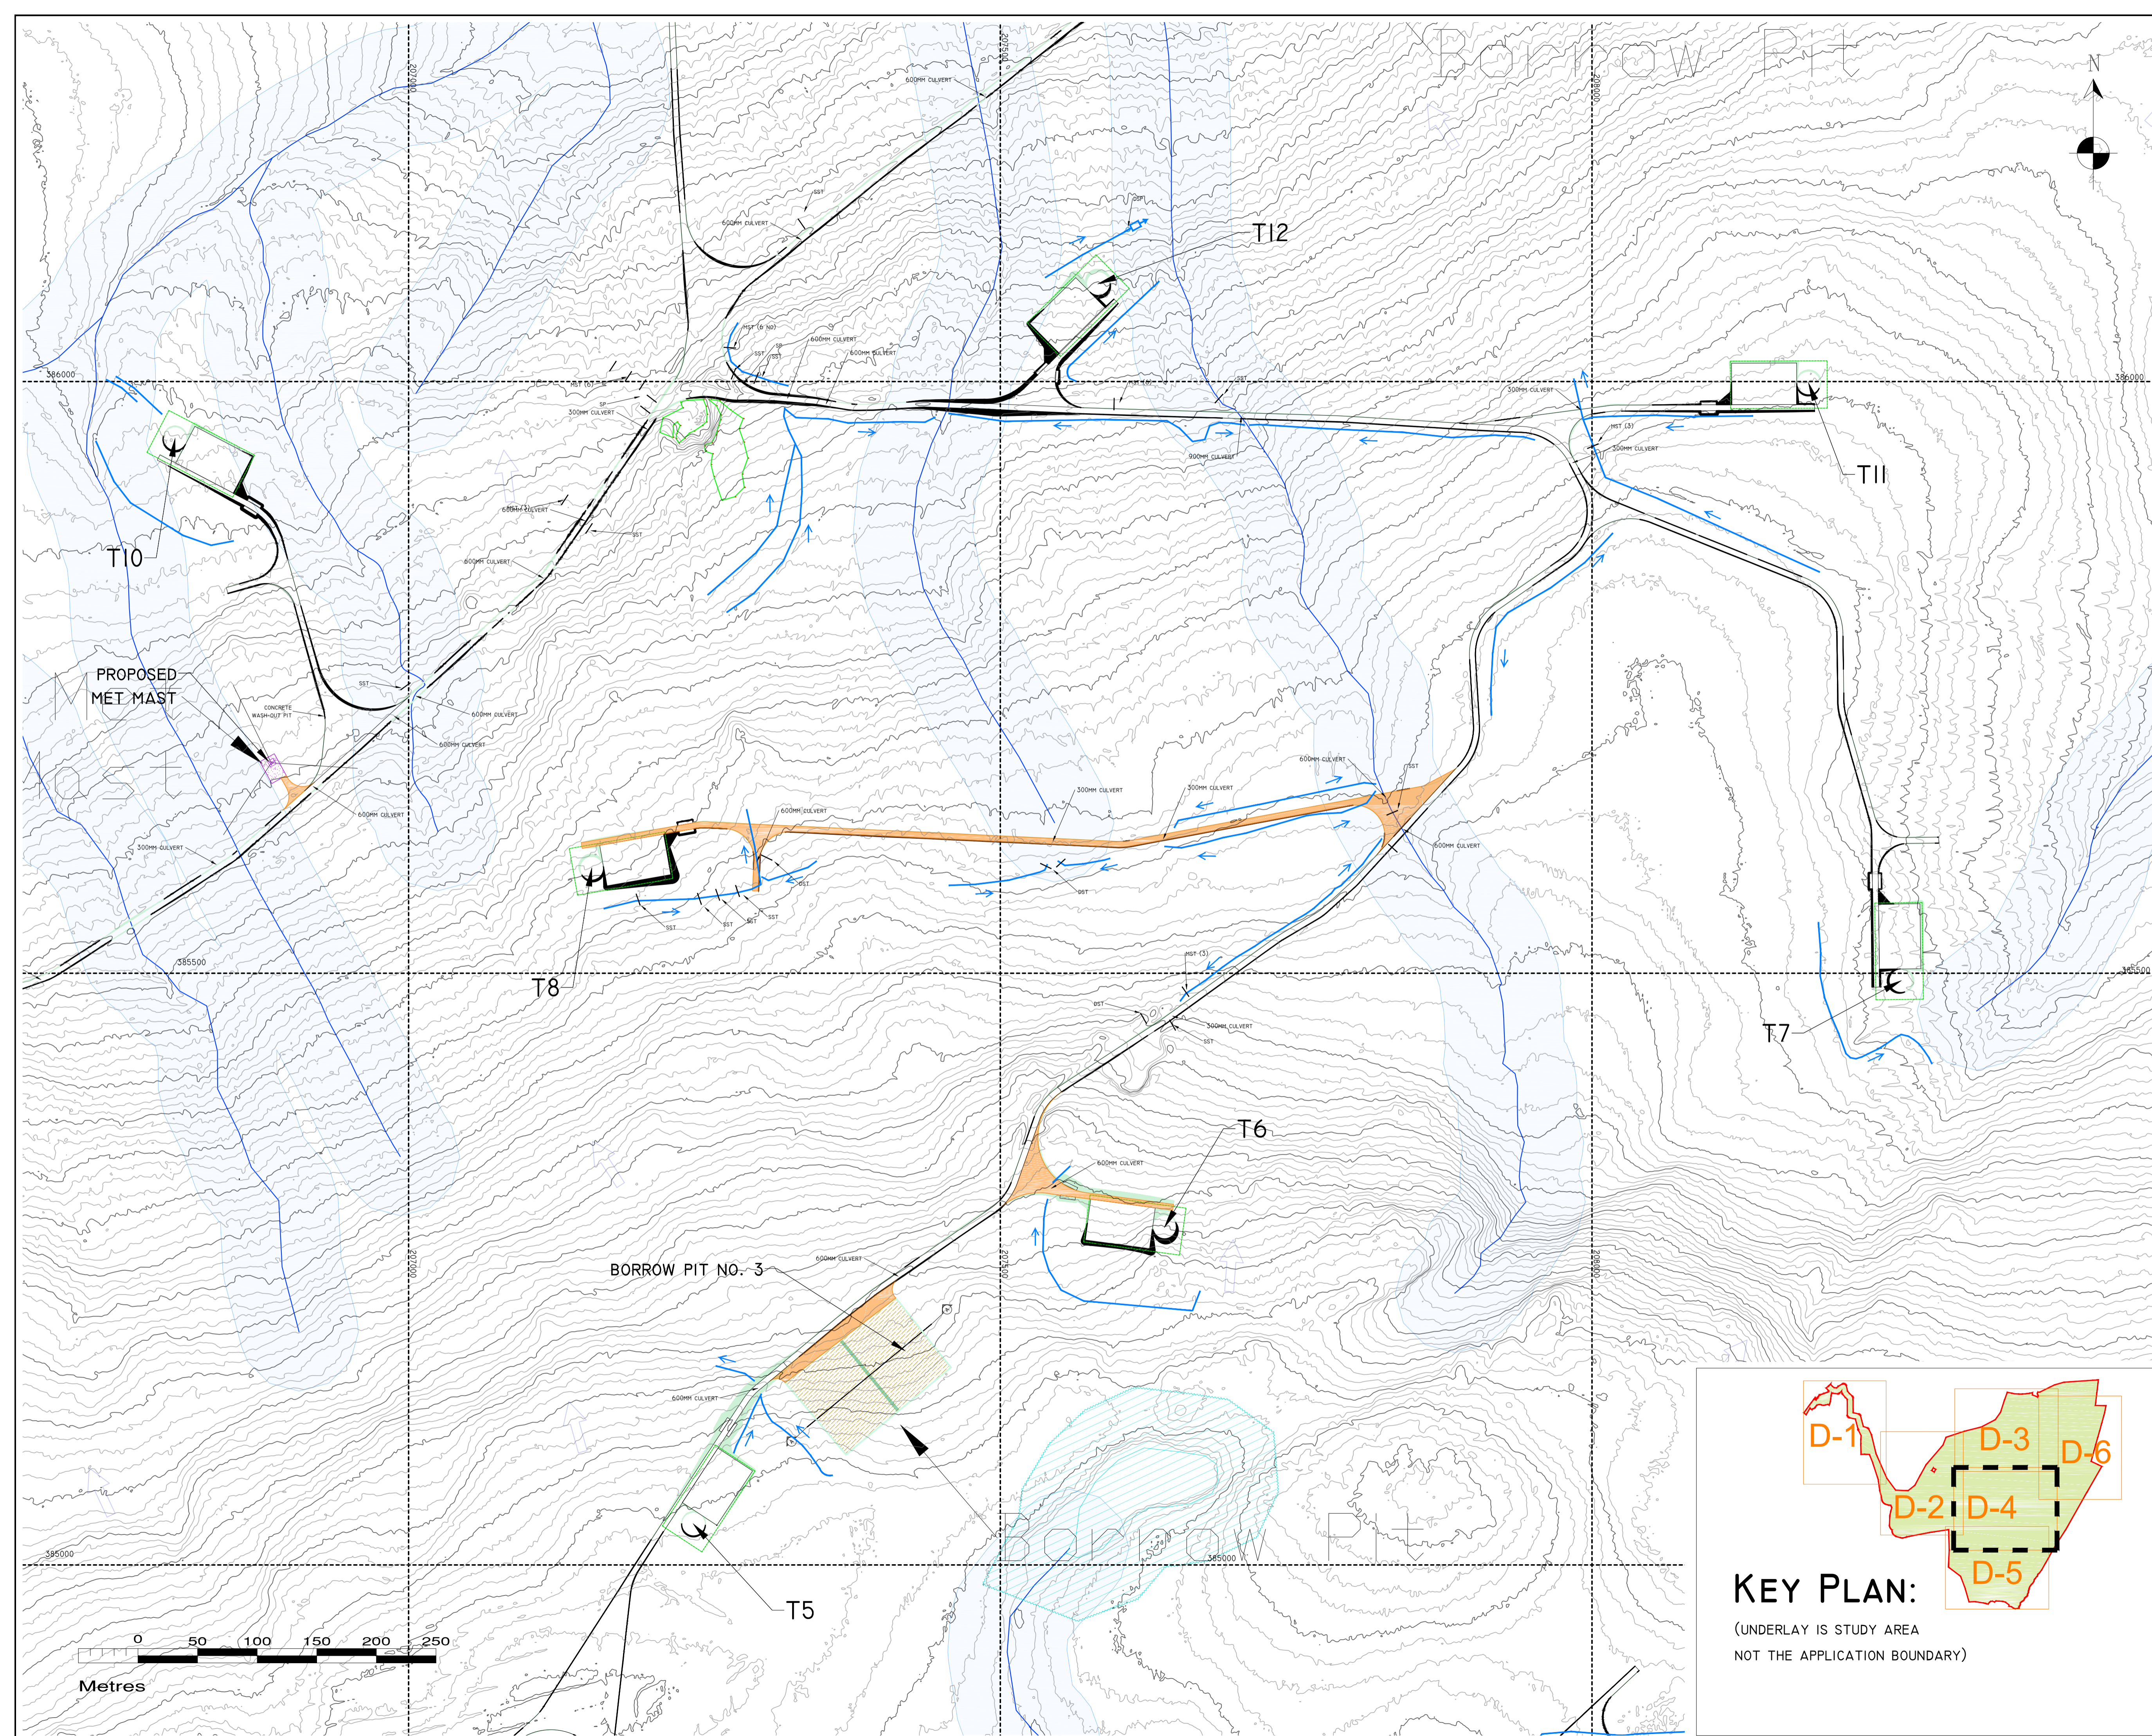

DRAWING LEGEND :

ST	SINGLE SILT TRAP
DST	DOUBLE SILT TRAP
TST	TRIPLE SILT TRAP
MST	MULTI SILT TRAP (NUMBERS)
DSP	DOUBLE SETTLEMENT POND
CULVERT	300/600/900MM CULVERT
	INTERCEPTOR DRAIN (AS BUILT)
	FLOW DIRECTION
	APPLICATION SITE BOUNDARY
	RIVERS

DRAWING NOTES

1. AS-BUILT DRAWINGS BASED ON SITE AUDITS COMPLETED ON 24/12/2020 AND 25/11/2020. NOTE: ADDITIONAL DRAINAGE MITIGATION MAY HAVE BEEN INSTALLED SINCE THOSE DATES.
2. COPYRIGHT, ALL RIGHTS RESERVED. NO PART HERE WITH MAY BE COPIED OR REPRODUCED PARTIALLY OR WHOLLY IN ANY FORM WHATSOEVER WITHOUT THE PRIOR NOTICE OF THE COPYRIGHT OWNER HYDRO-ENVIRONMENTAL SERVICES.
3. DO NOT SCALE OFF THIS DRAWING. FIGURED METRIC DIMENSIONS ONLY SHOULD BE TAKEN OFF THIS DRAWING.
4. ALL DIMENSIONS ARE IN METRES.

Ordnance Survey Ireland Licence No. EN 0044720
© Ordnance Survey Ireland/Government of Ireland

Date	Description	Chkd	Signed
Revisions			

HYDRO ENVIRONMENTAL SERVICES
22 Lower Main St
Dungarvan
Co. Waterford
Ireland

tel: +353 (0) 58-44122
tel: +353 (0) 58-44244
email: info@hydroenvironmental.ie
web: www.hydroenvironmental.ie

Client: MID CORK ELECTRICAL

Job: MEENBOG WIND FARM, Co. DONEGAL


Title: AS BUILT DRAINAGE LAYOUT
SHEET 4 OF 6

Figure No: D804

Drawing No: P1249-S-1220-A1-D804-00A

Sheet Size: A1 Project No.: P1249-5

Scale: 1:2,500 (A1) Drawn By: MG/GD
Date: 16/12/2020 Checked By: MG

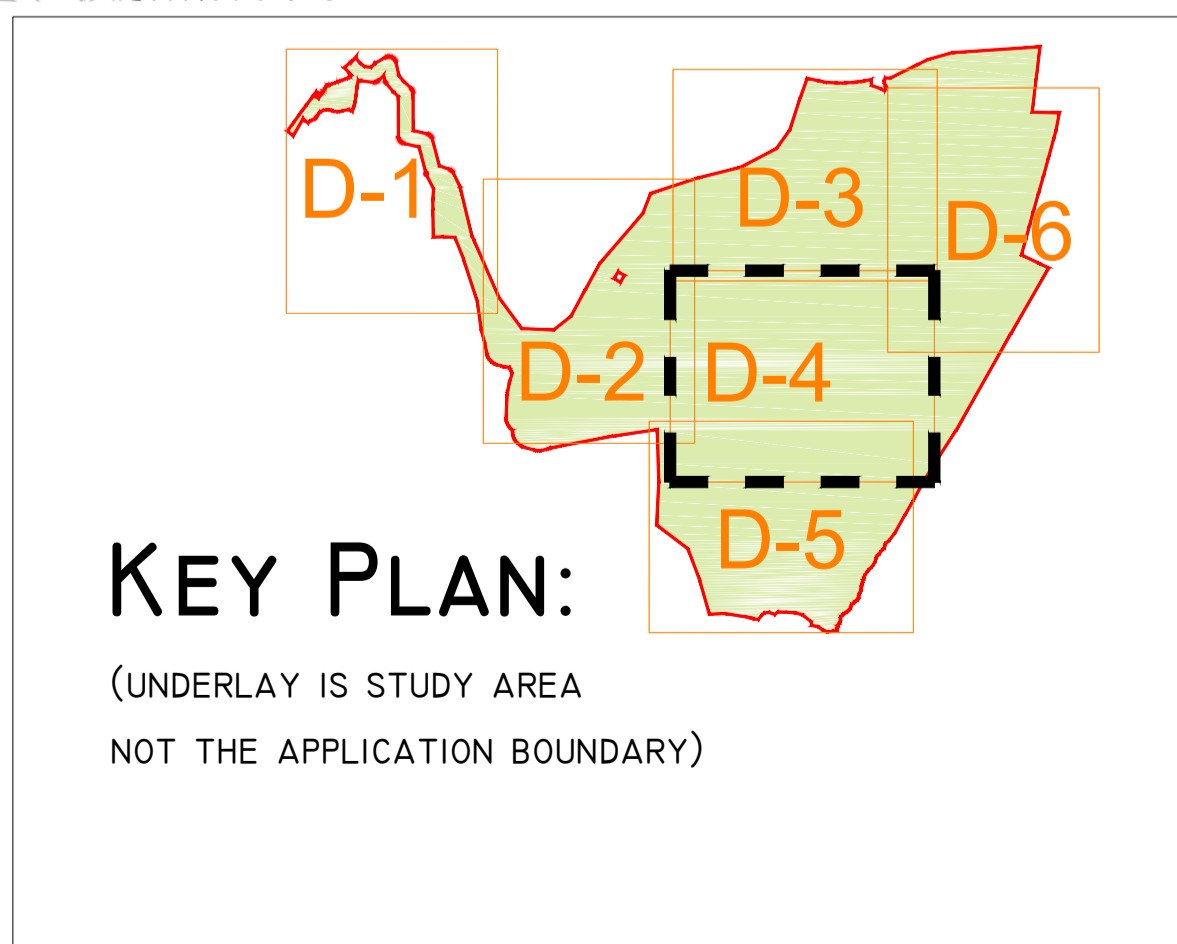

DRAWING LEGEND :

ST	SINGLE SILT TRAP
DST	DOUBLE SILT TRAP
TST	TRIPLE SILT TRAP
MST	MULTI SILT TRAP (NUMBERS)
DSP	DOUBLE SETTLEMENT POND
CULVERT	300/600/900MM CULVERT
	INTERCEPTOR DRAIN (AS BUILT)
	FLOW DIRECTION
	APPLICATION SITE BOUNDARY
	RIVERS

DRAWING NOTES

- AS-BUILT DRAWINGS BASED ON SITE AUDITS COMPLETED ON 24/12/2020 AND 25/11/2020. NOTE: ADDITIONAL DRAINAGE MITIGATION MAY HAVE BEEN INSTALLED SINCE THOSE DATES.
- COPYRIGHT, ALL RIGHTS RESERVED. NO PART HERE WITH MAY BE COPIED OR REPRODUCED PARTIALLY OR WHOLLY IN ANY FORM WHATSOEVER WITHOUT THE PRIOR NOTICE OF THE COPYRIGHT OWNER HYDRO-ENVIRONMENTAL SERVICES.
- DO NOT SCALE OFF THIS DRAWING. FIGURED METRIC DIMENSIONS ONLY SHOULD BE TAKEN OFF THIS DRAWING.
- ALL DIMENSIONS ARE IN METRES.

Ordnance Survey Ireland Licence No. EN 0044720
© Ordnance Survey Ireland/Government of Ireland

Date	Description	Chkd	Signed
Revisions			



22 Lower Main St
Dungarvan
Co. Waterford
Ireland

tel: +353 (0) 58-44122
tel: +353 (0) 58-44244
email: info@hydroenvironmental.ie
web: www.hydroenvironmental.ie

Client: MID CORK ELECTRICAL

Job: MEENBOG WIND FARM, Co. DONEGAL



Title: AS BUILT DRAINAGE LAYOUT
SHEET 5 OF 6

Figure No: D805





Drawing No: P1249-5-1220-A1-D805-00A

Sheet Size: A1 Project No.: P1249-5

Scale: 1:2,500 (A1) Drawn By: MG/GD
Date: 16/12/2020 Checked By: MG

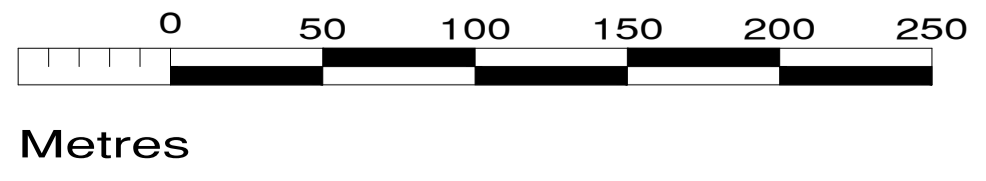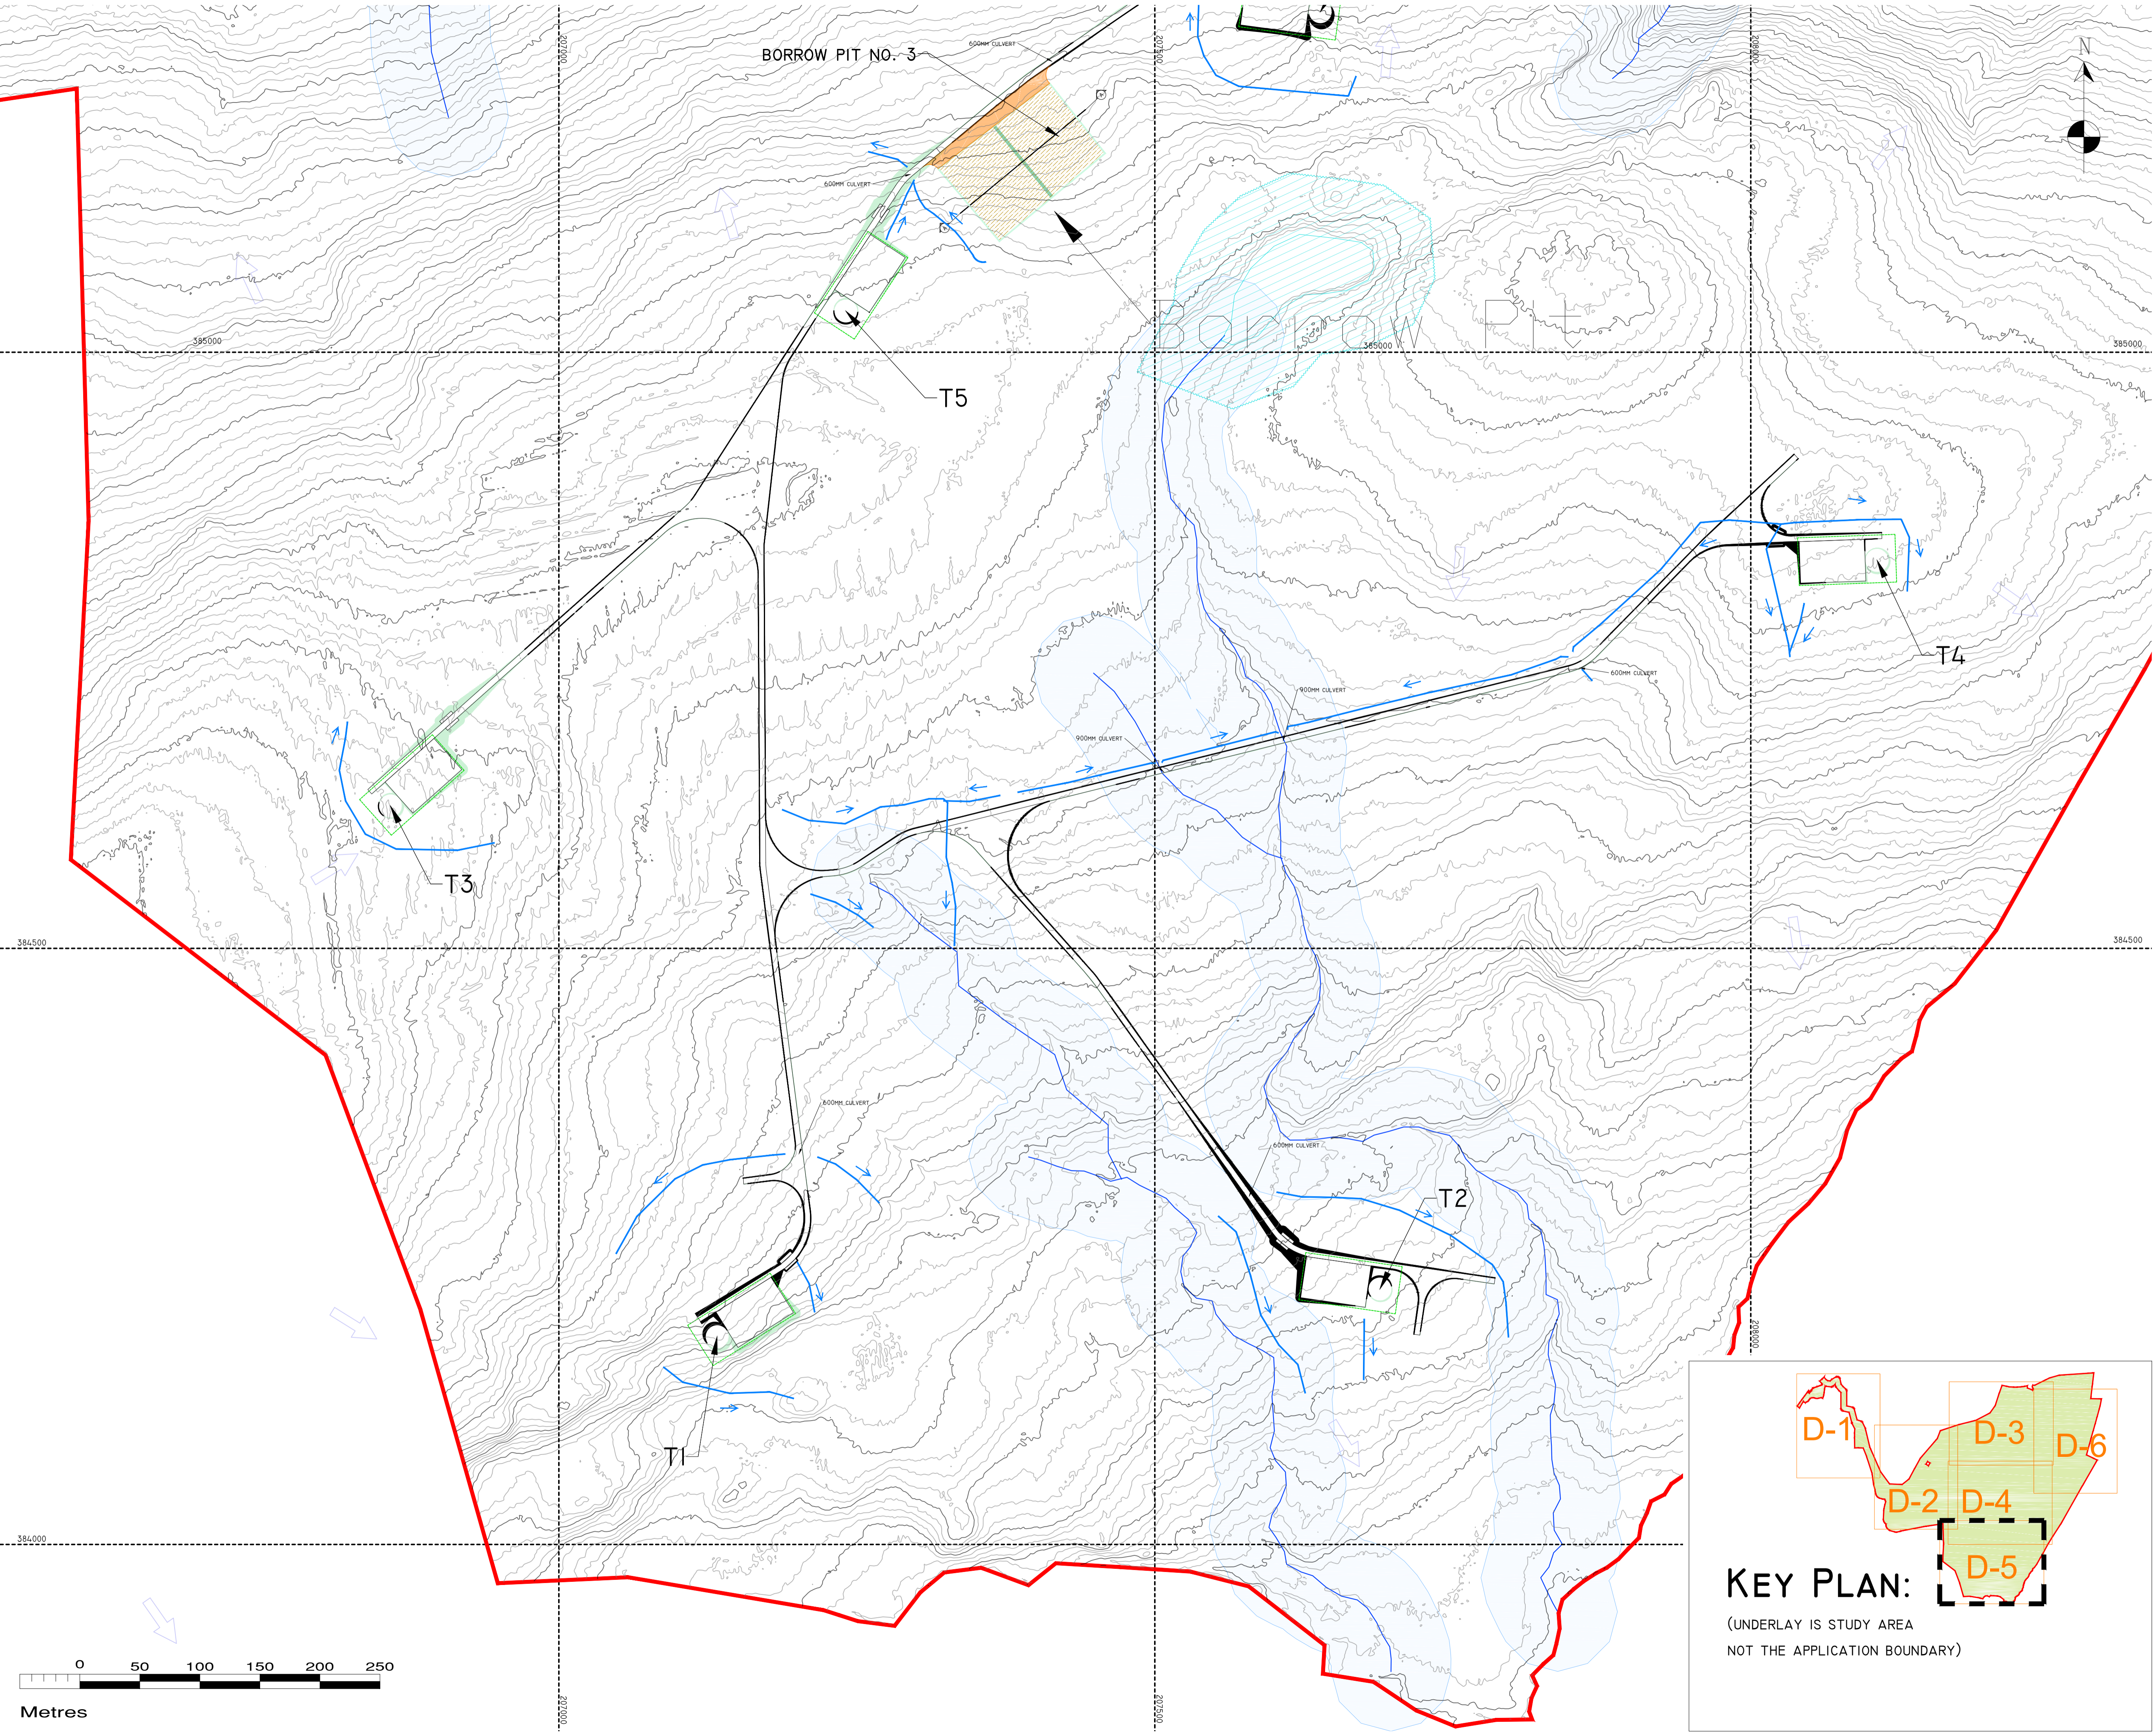

KEY PLAN:
(UNDERLAY IS STUDY AREA
NOT THE APPLICATION BOUNDARY)

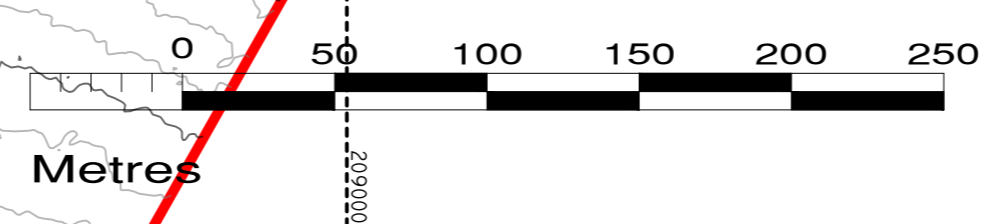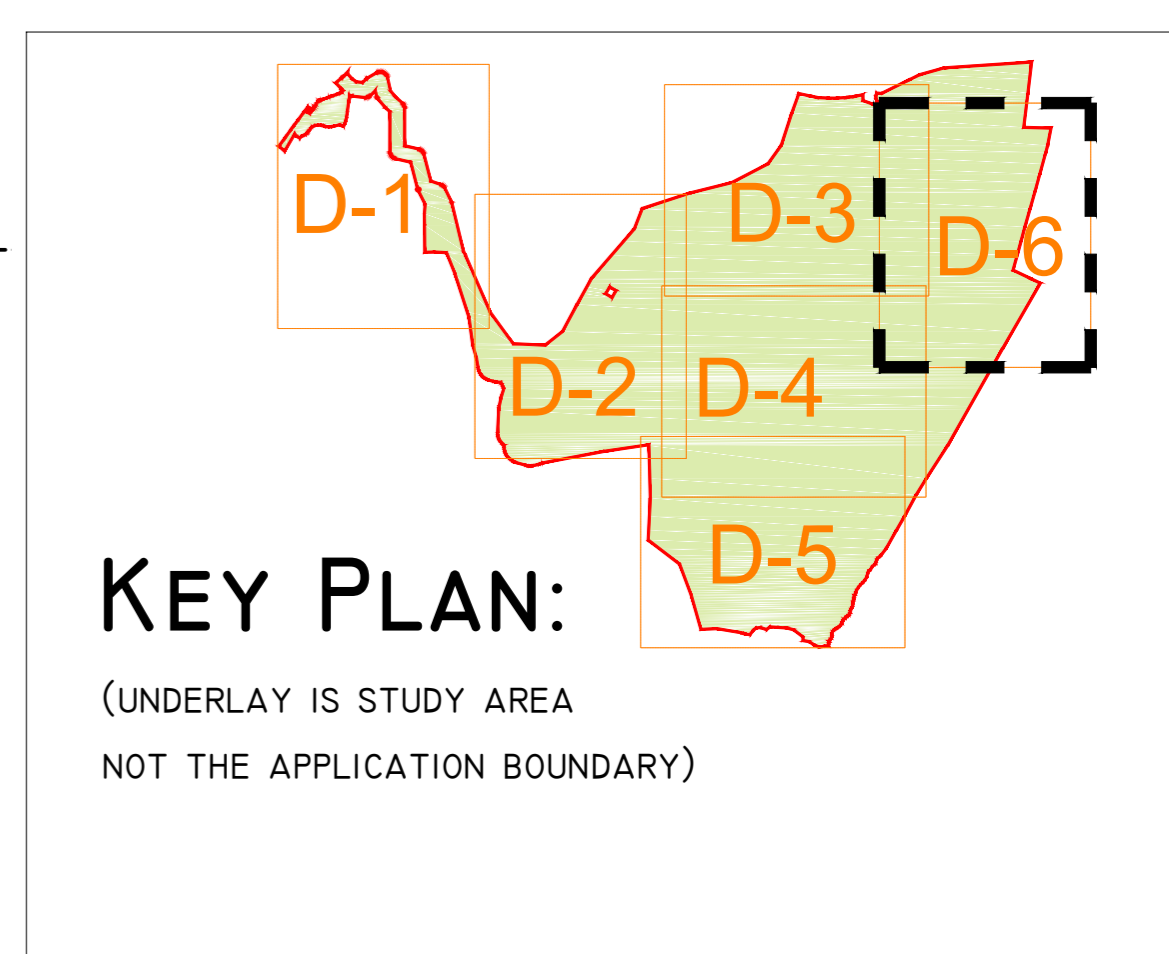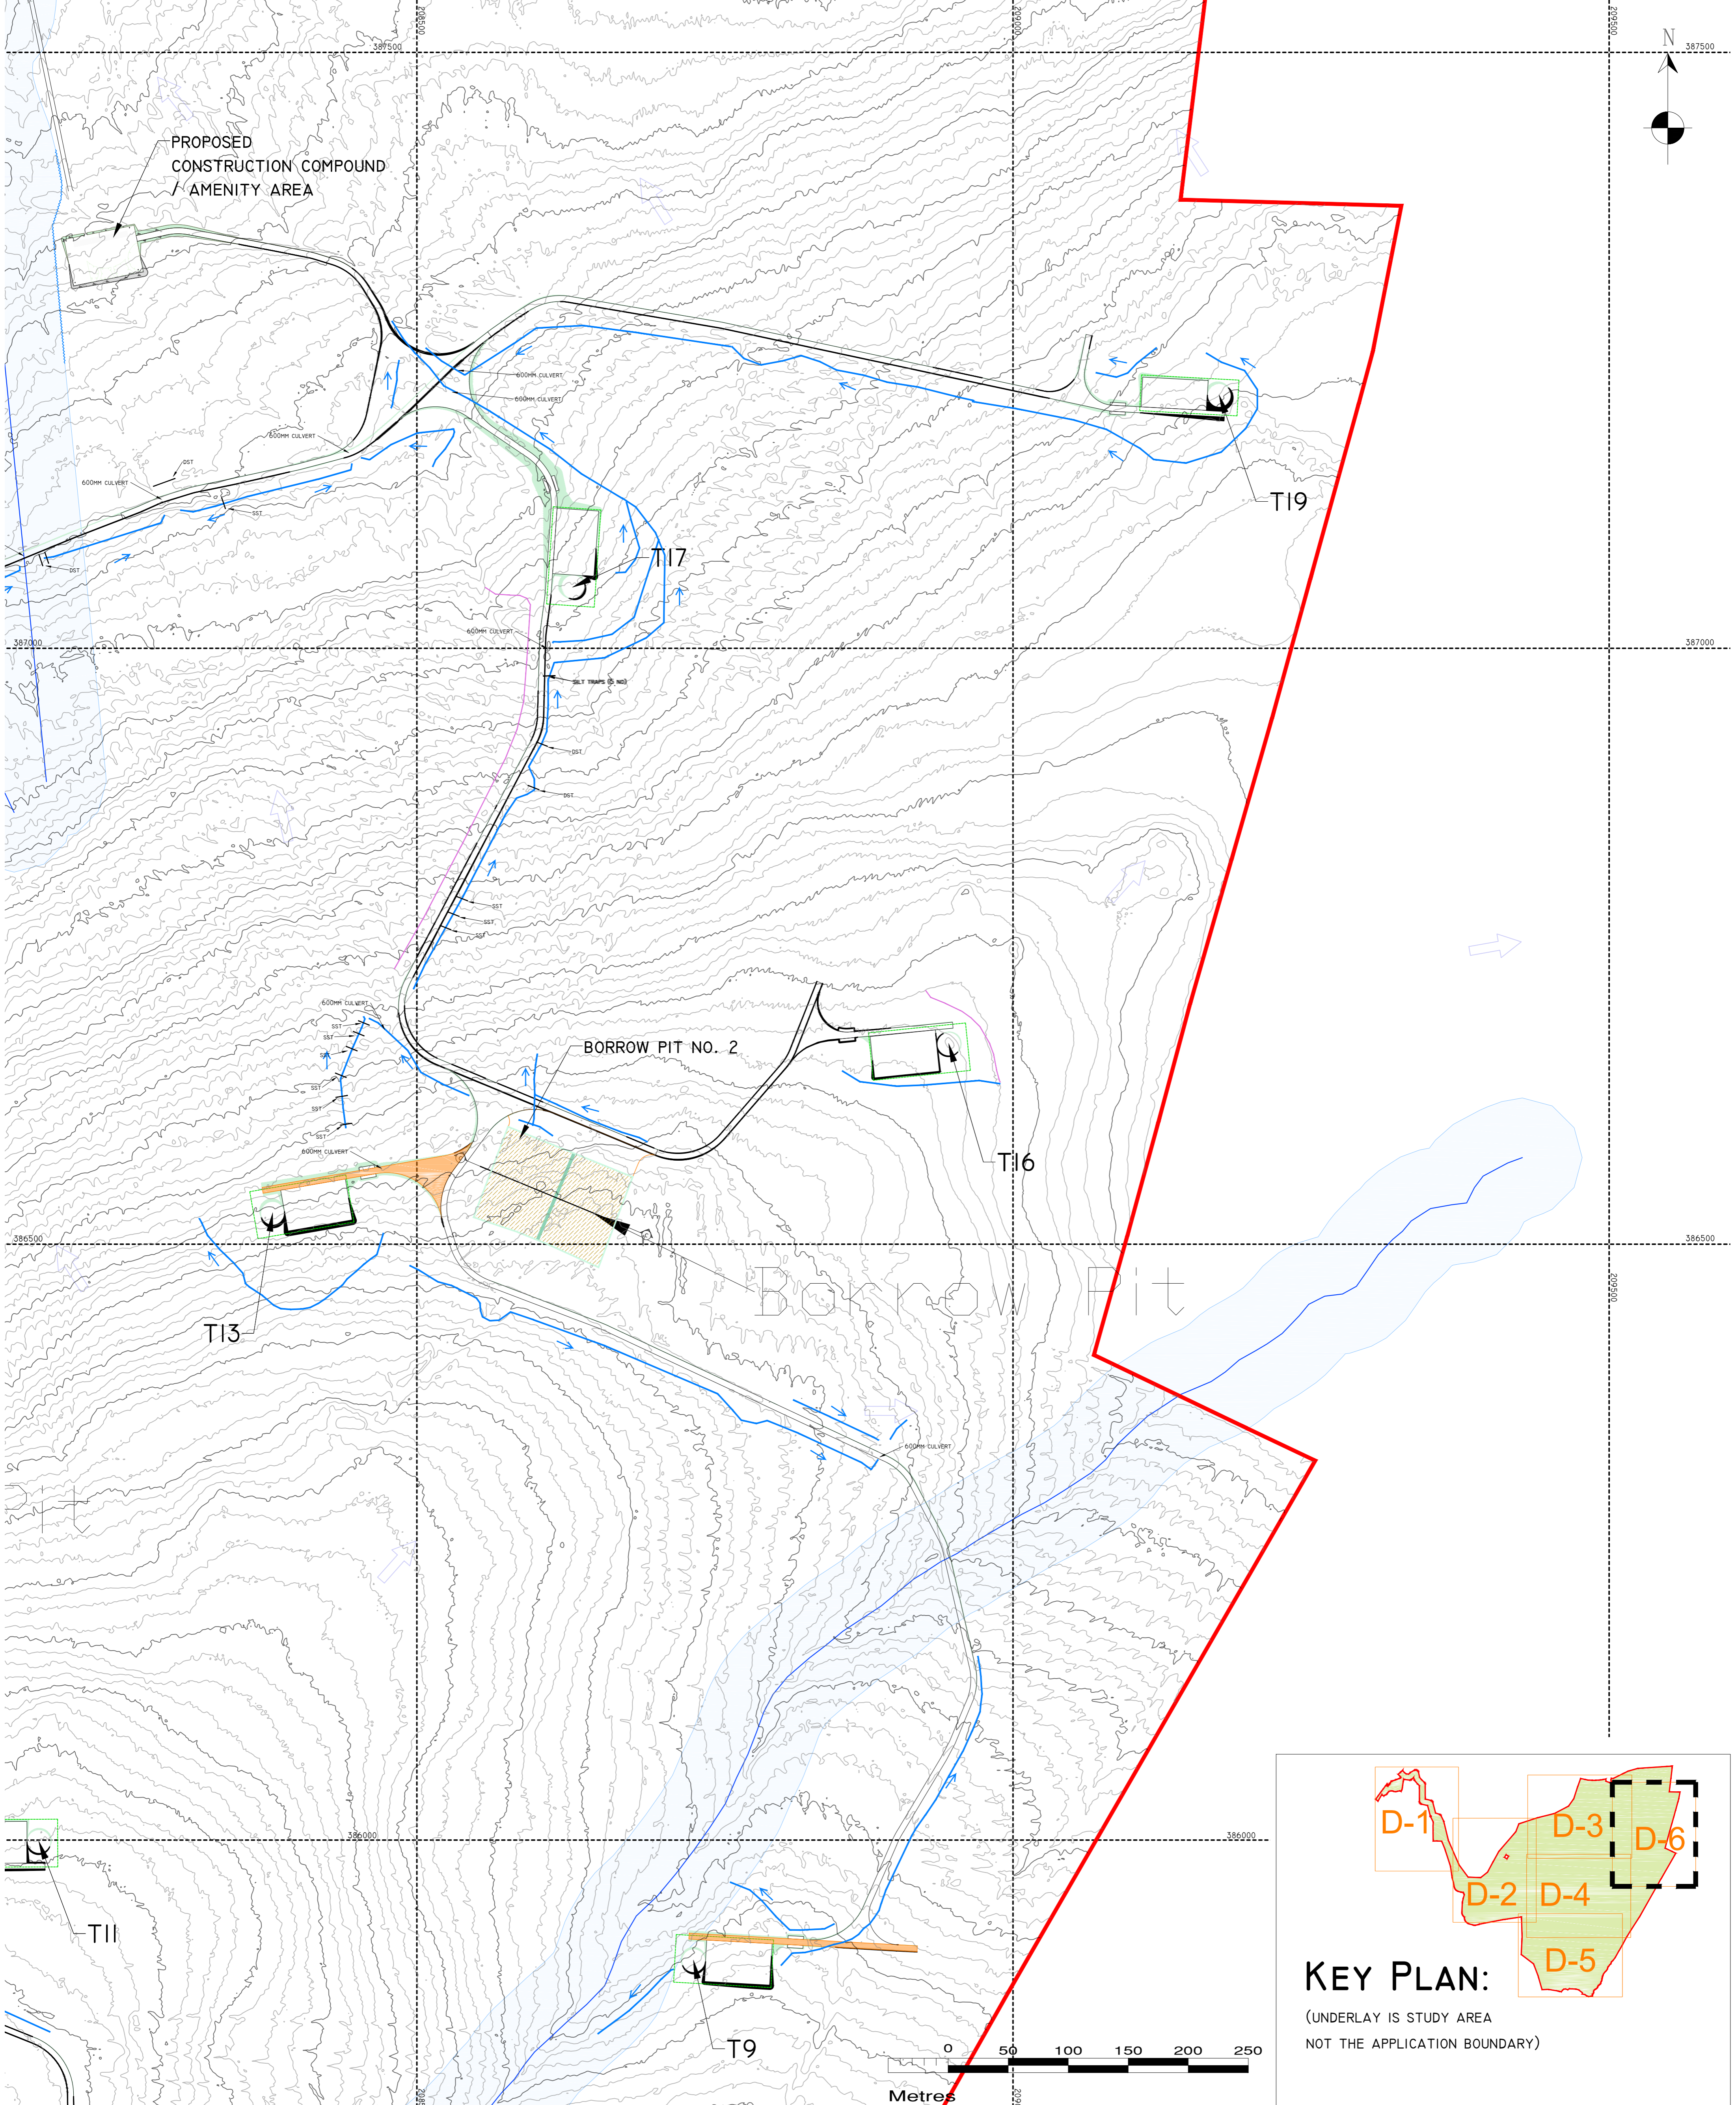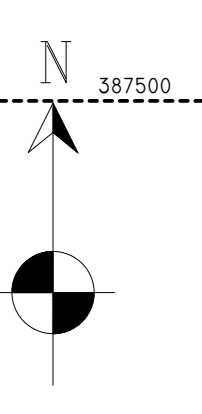

DRAWING LEGEND :

ST	SINGLE SILT TRAP
DST	DOUBLE SILT TRAP
TST	TRIPLE SILT TRAP
MST	MULTI SILT TRAP (NUMBERS)
DSP	DOUBLE SETTLEMENT POND
CULVERT	300/600/900MM CULVERT
	INTERCEPTOR DRAIN (AS BUILT)
	FLOW DIRECTION
	APPLICATION SITE BOUNDARY
	RIVERS

DRAWING NOTES

- AS-BUILT DRAWINGS BASED ON SITE AUDITS COMPLETED ON 24/12/2020 AND 25/11/2020. NOTE: ADDITIONAL DRAINAGE MITIGATION MAY HAVE BEEN INSTALLED SINCE THOSE DATES.
- COPYRIGHT, ALL RIGHTS RESERVED. NO PART HERE WITH MAY BE COPIED OR REPRODUCED PARTIALLY OR WHOLLY IN ANY FORM WHATSOEVER WITHOUT THE PRIOR NOTICE OF THE COPYRIGHT OWNER HYDRO-ENVIRONMENTAL SERVICES.
- DO NOT SCALE OFF THIS DRAWING. FIGURED METRIC DIMENSIONS ONLY SHOULD BE TAKEN OFF THIS DRAWING.
- ALL DIMENSIONS ARE IN METRES.

Ordnance Survey Ireland Licence No. EN 0044720
© Ordnance Survey Ireland/Government of Ireland

Date	Description	Chkd	Signed
Revisions			

HYDRO ENVIRONMENTAL SERVICES

22 Lower Main St
Dungarvan
Co. Waterford
Ireland

tel: +353 (0) 58-44122
tel: +353 (0) 58-44244
email: info@hydroenvironmental.ie
web: www.hydroenvironmental.ie

Client:	MID CORK ELECTRICAL
Job:	MEENBOG WIND FARM, Co. DONEGAL
Title:	AS BUILT DRAINAGE LAYOUT SHEET 6 OF 6
Figure No:	D806
Drawing No:	P1249-5-1220-A1-D806-00A
Sheet Size:	A1
Scale:	1:2,500 (A1)
Date:	16/12/2020
Project No.:	P1249-5
Drawn By:	MG/GD
Checked By:	MG