


- LEGEND
- APPLICATION BOUNDARY
 - LANDOWNER PROPERTY BOUNDARY
 - EXISTING WAYLEAVE
 - PROPOSED 220 kV ONSHORE CABLE ROUTE
 - PROPOSED FIBRE CABLE ROUTE
 - AMENDED 220 kV ONSHORE CABLE ROUTE
 - AMENDED FIBRE CABLE ROUTE
 - PROPOSED TEMPORARY CONSTRUCTION COMPOUND
 - PROPOSED TEMPORARY ACCESS TRACK
 - PROPOSED TEMPORARY CABLE PULLING HARDSTAND
 - SITE NOTICE LOCATION
 - AMENDED JOINT BAY
 - AMENDED C2 CHAMBER
 - AMENDED LINK BOX CHAMBER
 - PROPOSED JOINT BAY
 - PROPOSED C2 CHAMBER
 - PROPOSED LINK BOX CHAMBER
 - EXISTING HV MAST
 - PROPOSED NEW LINE CABLE INTERFACE MAST (LCIM)

- NOTES :
- FOR PLANNING PURPOSES ONLY, NOT FOR CONSTRUCTION
 - ALL DIMENSIONS IN METERS, UNLESS OTHERWISE NOTED
 - THE CABLE SHALL BE INSTALLED WITHIN THE SITE BOUNDARY. THE FINAL ALIGNMENT WITHIN THE SITE BOUNDARY SHALL BE DETERMINED FOLLOWING DETAILED DESIGN, WHICH WOULD PROCEED POST-PLANNING.
 - THE SITE BOUNDARY IS THE EXTENT OF THE PROPOSED PROJECT SITE. IT SHOULD BE ASSUMED TO EXTEND TO THE EDGE OF THE CARRIAGEWAY ALONG PUBLIC ROADS, EXCEPT WHERE OTHERWISE INDICATED.
 - 220 kV CABLES TO BE INSTALLED AS PER DRAWING PE605-D027-083-001 (LATEST REVISION), WHICH IS A TYPICAL TRENCH LAYOUT. THE OVERALL DEPTH, WIDTH AND FORMATION OF THE TRENCH MAY CHANGE, DEPENDING ON GROUND CONDITIONS AND DETAILED DESIGN.

NOTE: REVISION CLOUDS HIGHLIGHT THE DESIGN CHANGES AS PART OF THE RESPONSE TO RFI

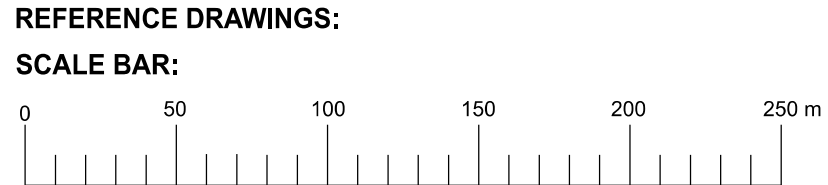

005	ADDED REVISION CLOUDS & ANNOTATION				
004	03/12/25	UPDATED CHAINAGE	NB	NB	RD MH
003	10/11/25	UPDATED CABLE ROUTE ON N33 SECTION	NB	NB	RD MH
002	20/02/24	UPDATED APPLICATION BOUNDARY	NB	NB	RD MH
001	20/02/24	UPDATED AS PER RPS COMMENTS	NB	NB	RD MH
000	26/01/24	FIRST ISSUE	NB	NB	RD MH
REV.	DATE	REVISION DESCRIPTION	DRN	PROD	VER APP

PURPOSE OF ISSUE - PRELIMINARY UNLESS INDICATED

CLIENT APPROVAL ☐ PLANNING ☒ TENDER ☐ CONSTRUCTION ☐ AS-BUILT ☐

Client

ORIEL WINDFARM LTD

Project

ORIEL WIND FARM PROJECT

Contract

Drawing Title

ONSHORE CABLE ROUTE
SITE LOCATION MAP
SHEET 2 OF 13

Production Unit

Civil, Environmental and Renewable Engineering



DRAWN	PRODUCED	VERIFIED	APPROVED	APPROVAL DATE
Bell_Neil	Bell_Neil	R.Doyle	M.Hogon	17/12/2025
CLIENT REF	No. OF SHTS	SIDE	SCALE	
TC228403	2/13	A1	1:2500	

DRAWING NUMBER

PE605-D027-104-002-005