


KEY PLAN

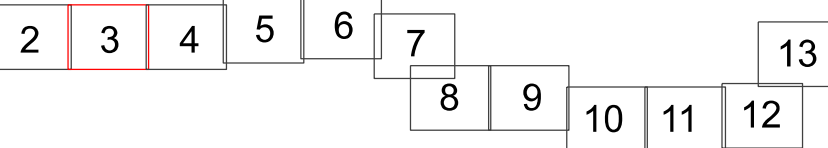

LEGEND


- APPLICATION BOUNDARY
- LANDOWNER PROPERTY BOUNDARY
- EXISTING WAYLEAVE
- PROPOSED 220 kV ONSHORE CABLE ROUTE
- PROPOSED FIBRE CABLE ROUTE
- AMENDED 220 kV ONSHORE CABLE ROUTE
- AMENDED FIBRE CABLE ROUTE
- PROPOSED TEMPORARY CONSTRUCTION COMPOUND
- PROPOSED TEMPORARY ACCESS TRACK
- PROPOSED TEMPORARY CABLE PULLING HARDSTAND
- SITE NOTICE LOCATION
- AMENDED JOINT BAY
- AMENDED C2 CHAMBER
- AMENDED LINK BOX CHAMBER
- PROPOSED JOINT BAY
- PROPOSED C2 CHAMBER
- PROPOSED LINK BOX CHAMBER
- EXISTING HV MAST
- PROPOSED NEW LINE CABLE INTERFACE MAST (LCIM)

NOTES :

- FOR PLANNING PURPOSES ONLY, NOT FOR CONSTRUCTION
- ALL DIMENSIONS IN METERS, UNLESS OTHERWISE NOTED
- THE CABLE SHALL BE INSTALLED WITHIN THE SITE BOUNDARY. THE FINAL ALIGNMENT WITHIN THE SITE BOUNDARY SHALL BE DETERMINED FOLLOWING DETAILED DESIGN, WHICH WOULD PROCEED POST-PLANNING.
- THE SITE BOUNDARY IS THE EXTENT OF THE PROPOSED PROJECT SITE. IT SHOULD BE ASSUMED TO EXTEND TO THE EDGE OF THE CARRIAGEWAY ALONG PUBLIC ROADS, EXCEPT WHERE OTHERWISE INDICATED.
- 220 kV CABLES TO BE INSTALLED AS PER DRAWING PE605-D027-083-001 (LATEST REVISION), WHICH IS A TYPICAL TRENCH LAYOUT. THE OVERALL DEPTH, WIDTH AND FORMATION OF THE TRENCH MAY CHANGE, DEPENDING ON GROUND CONDITIONS AND DETAILED DESIGN.

NOTE: REVISION CLOUDS HIGHLIGHT THE DESIGN CHANGES AS PART OF THE RESPONSE TO RFI

REFERENCE DRAWINGS:

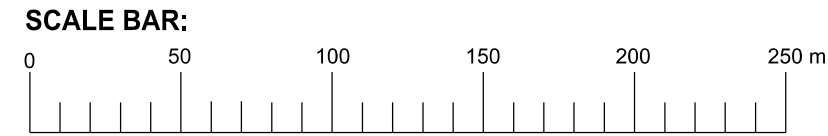

| | | | | | |
|-----|------------------------------------|------------------------------------|----|----|-------|
| 004 | ADDED REVISION CLOUDS & ANNOTATION | | | | |
| 003 | 03/12/25 | UPDATED CHAINAGE | NB | NB | RD MH |
| 002 | 10/11/25 | UPDATED CABLE ROUTE ON N33 SECTION | NB | NB | RD MH |
| 001 | 26/01/24 | UPDATED AS PER RPS COMMENTS | NB | NB | RD MH |
| 000 | 26/01/24 | FIRST ISSUE | NB | NB | RD MH |

| REV. | DATE | REVISION DESCRIPTION | DRN | PROD | VER | APP |
|---|------|----------------------|-----|------|-----|-----|
| PURPOSE OF ISSUE - PRELIMINARY UNLESS INDICATED | | | | | | |
| CLIENT APPROVAL <input type="checkbox"/> PLANNING <input checked="" type="checkbox"/> TENDER <input type="checkbox"/> CONSTRUCTION <input type="checkbox"/> AS-BUILT <input type="checkbox"/> | | | | | | |

Client: ORIEL WINDFARM LTD

Project: ORIEL WIND FARM PROJECT

Contract:

Drawing Title: ONSHORE CABLE ROUTE
SITE LOCATION MAP
SHEET 3 OF 13

Production Unit: Civil, Environmental and Renewable Engineering



Engineering and Major Projects,
One Dublin Airport Central, Dublin Airport,
Cloghran, Co. Dublin, K67 XF72, Ireland.
Tel: +353 (0)1 703 8000 Web: www.esb.ie
Engineering and Major Projects is a division of ESB.

| | | | | |
|------------------------|-----------------------|---------------------|---------------------|-----------------------------|
| DRAWN Bell_Neil | PRODUCED Bell_Neil | VERIFIED R.Doyle | APPROVED M.Hogan | APPROVAL DATE 17/12/2025 |
| CLIENT REF TC228403 | No. OF SHTS 3/13 | SIDE A1 | SCALE 1:2500 | |

DRAWING NUMBER: PE605-D027-104-003-004