


- LEGEND
- APPLICATION BOUNDARY
 - LANDOWNER PROPERTY BOUNDARY
 - EXISTING WAYLEAVE
 - PROPOSED 220 kV ONSHORE CABLE ROUTE
 - PROPOSED FIBRE CABLE ROUTE
 - PROPOSED TEMPORARY CONSTRUCTION COMPOUND
 - PROPOSED TEMPORARY ACCESS TRACK
 - AMENDED TEMPORARY ACCESS TRACK
 - PROPOSED TEMPORARY CABLE PULLING HARDSTAND
 - SITE NOTICE LOCATION
 - PROPOSED JOINT BAY
 - PROPOSED C2 CHAMBER
 - PROPOSED LINK BOX CHAMBER
 - EXISTING HV MAST
 - PROPOSED NEW LINE CABLE INTERFACE MAST (LCIM)

- NOTES :
- FOR PLANNING PURPOSES ONLY, NOT FOR CONSTRUCTION
 - ALL DIMENSIONS IN METERS, UNLESS OTHERWISE NOTED
 - THE CABLE SHALL BE INSTALLED WITHIN THE APPLICATION SITE BOUNDARY. THE FINAL ALIGNMENT WITHIN THE APPLICATION SITE BOUNDARY SHALL BE DETERMINED FOLLOWING DETAILED DESIGN, WHICH WOULD PROCEED POST-PLANNING.
 - THE APPLICATION SITE BOUNDARY IS THE EXTENT OF THE PROPOSED PROJECT SITE. IT SHOULD BE ASSUMED TO EXTEND TO THE EDGE OF THE CARRIAGEWAY ALONG PUBLIC ROADS, EXCEPT WHERE OTHERWISE INDICATED.
 - 220 kV CABLES TO BE INSTALLED AS PER DRAWING PE605-D027-083-001 (LATEST REVISION), WHICH IS A TYPICAL TRENCH LAYOUT. THE OVERALL DEPTH, WIDTH AND FORMATION OF THE TRENCH MAY CHANGE DEPENDING ON GROUND CONDITIONS AND DETAILED DESIGN.

NOTE: REVISION CLOUDS HIGHLIGHT THE DESIGN CHANGES AS PART OF THE RESPONSE TO RFI

REFERENCE DRAWINGS:
PE605-D027-017-001 (LATEST REVISION)
RIVER DEE HDD CROSSING ALIGNMENT AND PROFILE AT N33 BRIDGE

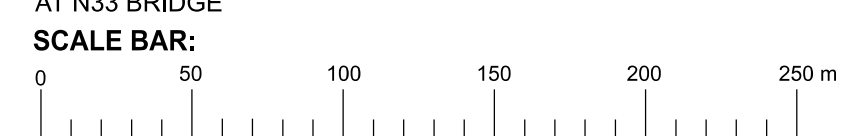

REV.	DATE	REVISION DESCRIPTION	DRN	PROD	VER	APP
005		ADDED REVISION CLOUDS & ANNOTATION				
004	03/12/25	UPDATED CHAINAGE	NB	NB	RD	MH
003	11/11/25	UPDATED CABLE ROUTE ON N33 SECTION	NB	NB	RD	MH
002	27/02/24	UPDATED ACCESS TRACKS AS PER SPA	NB	NB	RD	MH
001	27/02/24	UPDATED AS PER COMMENTS FROM RPS	NB	NB	RD	MH
000	26/01/24	FIRST ISSUE	NB	NB	RD	MH

PURPOSE OF ISSUE - PRELIMINARY UNLESS INDICATED

CLIENT APPROVAL ☐ PLANNING ☒ TENDER ☐ CONSTRUCTION ☐ AS-BUILT ☐

Client: ORIEL WINDFARM LTD

Project: ORIEL WIND FARM PROJECT

Contract:

Drawing Title: ONSHORE CABLE ROUTE
SITE LOCATION MAP
SHEET 4 OF 13

Production Unit: Civil, Environmental and Renewable Engineering

Engineering and Major Projects,
One Dublin Airport Central, Dublin Airport,
Cloughran, Co. Dublin, K67 XF72, Ireland.
Tel: +353 (0)1 703 8000 Web: www.esb.ie
Engineering and Major Projects is a division of ESB

DRAWN Bell_Neil	PRODUCED Bell_Neil	VERIFIED R.Doyle	APPROVED M.Hogan	APPROVAL DATE 17/12/2025
CLIENT REF TC228403	No. OF SHTS 4/13	SIDE A1	SCALE 1:2500	

DRAWING NUMBER: PE605-D027-104-004-005