


KEY PLAN

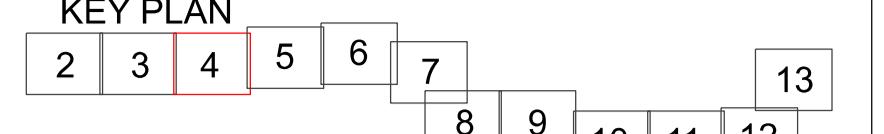

LEGEND

- APPLICATION BOUNDARY
- PROPOSED 220 KV ONSHORE CABLE ROUTE
- PROPOSED FIBRE CABLE ROUTE
- PROPOSED TEMPORARY ACCESS TRACK
- AMENDED TEMPORARY ACCESS TRACK
- EXISTING HIGH VOLTAGE OVERHEAD LINE
- EXISTING MEDIUM VOLTAGE OVERHEAD LINE
- EXISTING LOW VOLTAGE OVERHEAD LINE
- EXISTING MEDIUM VOLTAGE UNDERGROUND CABLE
- EXISTING LOW VOLTAGE UNDERGROUND CABLE
- EXISTING WATER MAIN
- EXISTING GRAVITY SEWER
- EXISTING STORM WATER DRAIN
- EXISTING HIGH PRESSURE TRANSMISSION GAS MAIN
- EXISTING TELECOMS OVERHEAD LINE
- EXISTING TELECOMS UNDERGROUND CABLE
- PROPOSED JOINT BAY
- PROPOSED C2 CHAMBER
- PROPOSED LINK BOX CHAMBER

NOTES :

1. FOR PLANNING PURPOSES ONLY, NOT FOR CONSTRUCTION
2. ALL DIMENSIONS IN METERS, UNLESS OTHERWISE NOTED
3. THE CABLE SHALL BE INSTALLED WITHIN THE SITE BOUNDARY. THE FINAL ALIGNMENT WITHIN THE SITE BOUNDARY SHALL BE DETERMINED FOLLOWING DETAILED DESIGN, WHICH WOULD PROCEED POST-PLANNING.
4. THE SITE BOUNDARY IS THE EXTENT OF THE PROPOSED PROJECT SITE. IT SHOULD BE ASSUMED TO EXTEND TO THE EDGE OF THE CARRIAGeway ALONG PUBLIC ROADS, EXCEPT WHERE OTHERWISE INDICATED.
5. 220 KV CABLES TO BE INSTALLED AS PER DRAWING PE605-D027-017-001. THE TYPICAL TRENCH OUTLINE, THE OVERALL TRENCH WIDTH AND FORMATION OF THE TRENCH MAY CHANGE, DEPENDING ON GROUND CONDITIONS AND DETAILED DESIGN.
6. THE UTILITIES RECORDS SHOWN ARE THE RECORDS ONLY IN THE IMMEDIATE VICINITY OF THE SITE BOUNDARY.

NOTE: REVISION CLOUDS HIGHLIGHT THE DESIGN CHANGES AS PART OF THE RESPONSE TO RFI

REFERENCE DRAWINGS:
PE605-D027-017-001 RIVER DEE HDD CROSSING N33 BRIDGE

SCALE BAR:

REV.	DATE	REVISION DESCRIPTION	DRN	PROD	VER	APP
PURPOSE OF ISSUE - PRELIMINARY UNLESS INDICATED						
005		ADDED REVISION CLOUDS & ANNOTATION				
004	08/12/25	UPDATED CHANGE	NB	NB	RD	MH
003	11/11/25	UPDATED CABLE ROUTE ON N33	NB	NB	RD	MH
002	16/10/25	UPDATED ACCESS TRACKS AS PER SPA	NB	NB	RD	MH
001	27/02/24	UPDATED AS PER COMMENTS FROM RPS	NB	NB	RD	MH
000	31/01/24	FIRST ISSUE	NB	NB	RD	MH

REV.	DATE	REVISION DESCRIPTION	DRN	PROD	VER	APP
PURPOSE OF ISSUE - PRELIMINARY UNLESS INDICATED						

CLIENT APPROVAL	PLANNING	TENDER	CONSTRUCTION	AS-BUILT
	<input checked="" type="checkbox"/>			

Client ORIEL WINDFARM LIMITED

Project ORIEL WIND FARM PROJECT

Contract

Drawing Title EXISTING UTILITIES AND PROPOSED DEVELOPMENT SHEET 4 OF 13

Production CIVIL, Environmental and Renewable Engineering

 Energy for generations
Engineering and Major Projects, One Dublin Airport Central, Dublin Airport, Cloghane, Co. Dublin, K67 XF72, Ireland.
Tel: +353 (01) 703 0000 Web: www.esb.ie
Engineering and Major Projects is a division of ESB

DRAWN Begley_G PRODUCED Bell_Neil VERIFIED R.Doyle APPROVED M.Hogan APPROVAL DATE 17/12/2025

CLIENT REF TC228657 NO. OF SHTS 4/13 SIZE A1 SCALE 1:2500

DRAWING NUMBER CYAL50441214 SHEET REV PE605-D027-105-004-005