


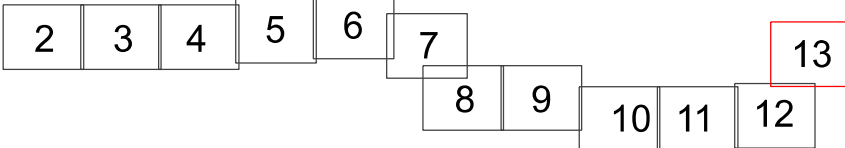

KEY PLAN




LEGEND

- APPLICATION BOUNDARY
- LANDOWNER PROPERTY BOUNDARY
- EXISTING WAYLEAVE
- PROPOSED 220 kV ONSHORE ROUTE
- PROPOSED 220 kV OFFSHORE ROUTE
- AMENDED 220 kV ONSHORE ROUTE
- AMENDED 220 kV OFFSHORE ROUTE
- AMENDED PERMANENT SITE ACCESS TRACK
- PROPOSED TEMPORARY SITE ACCESS TRACK
- PROPOSED TEMPORARY PASSING BAY
- PROPOSED TEMPORARY CONSTRUCTION COMPOUND
- SITE NOTICE LOCATION
- PROPOSED JOINT BAY
- PROPOSED UNDERGROUND TRANSITION JOINT BAY
- AMENDED UNDERGROUND TRANSITION JOINT BAY
- PROPOSED C2 CHAMBER
- PROPOSED LINK BOX CHAMBER
- AMENDED C2 CHAMBER
- AMENDED LINK BOX CHAMBER

NOTES :

- FOR PLANNING PURPOSES ONLY. NOT FOR CONSTRUCTION
- ALL DIMENSIONS IN METERS, UNLESS OTHERWISE NOTED
- THE CABLE SHALL BE INSTALLED WITHIN THE SITE BOUNDARY. THE FINAL ALIGNMENT WITHIN THE SITE BOUNDARY SHALL BE DETERMINED FOLLOWING DETAILED DESIGN, WHICH WOULD PROCEED POST-PLANNING.
- THE SITE BOUNDARY IS THE EXTENT OF THE PROPOSED PROJECT SITE. IT SHOULD BE ASSUMED TO EXTEND TO THE EDGE OF THE CARRIAGEWAY ALONG PUBLIC ROADS, EXCEPT WHERE OTHERWISE INDICATED.
- 220 kV ONSHORE CABLE TO BE INSTALLED AS PER DRAWING PE605-D027-063-001 & 220 kV OFFSHORE CABLE AS PER DRAWING PE605-D027-128-001 (LATEST REVISIONS), WHICH ARE TYPICAL TRENCH LAYOUTS, THE OVERALL DEPTH, WIDTH AND FORMATION OF THE TRENCH MAY CHANGE DEPENDING ON GROUND CONDITIONS AND DETAILED DESIGN.
- ALL WORKS, INCLUDING THE INSTALLATION OF THE ONSHORE AND OFFSHORE CABLES, IN CLOSE PROXIMITY TO THE BOUNDARY WALL OF DUNANY DEMENSE WILL BE SUBJECT TO SUPERVISION BY A LICENSED ARCHAEOLOGIST.
- MORE DETAIL ON AMENDMENTS REFER TO DWGS PE605-D027-119-001 AND 119-002

NOTE: REVISION CLOUDS HIGHLIGHT THE DESIGN CHANGES AS PART OF THE RESPONSE TO RFI

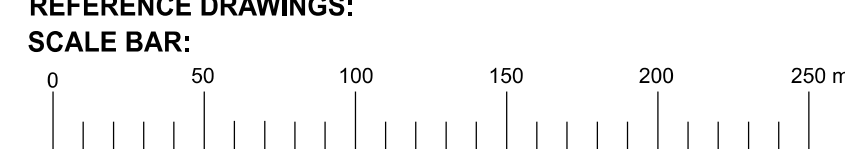

REV.	DATE	REVISION DESCRIPTION	DRN	PROD	VER	APP
004	09/12/25	ADDED REVISION CLOUDS & ANNOTATION				
004	09/12/25	UPDATED CHAINAGE	NB	NB	RD	MH
003	11/11/25	REVISED TJB LOCATIONS	NB	NB	RD	MH
002	05/09/25	UPDATED PLANNING BOUNDARY & ACCESS TRACK AS PER SPA	NB	NB	RD	MH
001	23/11/23	ADJUSTED TJB LOCATIONS	NB	NB	RD	MH
000	14/11/23	FIRST ISSUE	NB	NB	RD	MH

PURPOSE OF ISSUE - PRELIMINARY UNLESS INDICATED

CLIENT APPROVAL ☐ PLANNING ☒ TENDER ☐ CONSTRUCTION ☐ AS-BUILT ☐

Client: ORIEL WINDFARM LIMITED

Project: ORIEL WIND FARM PROJECT

Contract:

Drawing Title: EXISTING UTILITIES AND PROPOSED DEVELOPMENT SHEET 13 OF 13

Production Unit: Civil, Environmental and Renewable Engineering

Engineering and Major Projects,
One Dublin Airport Central, Dublin Airport,
Cloghran, Co. Dublin, K67 XF72, Ireland.
Tel: +353 (0)1 703 8000 Web: www.esb.ie
Engineering and Major Projects is a division of ESB

DRAWN Begley_G	PRODUCED Bell_Neil	VERIFIED R.Doyle	APPROVED M.Hogan	APPROVAL DATE 17/12/2025
CLIENT REF TC228657	No. OF SHTS 13/13	SIZE A1	SCALE 1:2500	

DRAWING NUMBER: PE605-D027-105-013-005