



Note: For full outline of total landholding of applicants, refer drawing 01.

Note: For aerial photographs and overall lengths of fencing refer appendix B.

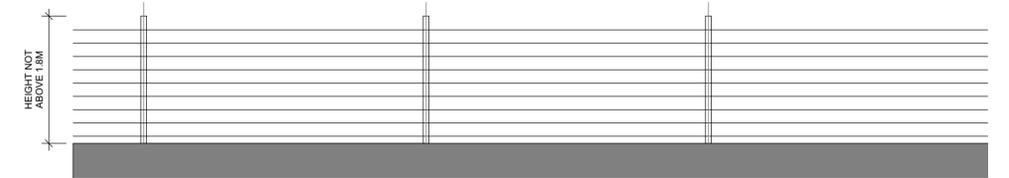

Fencing Type "C" - Steel Posts (80mm diameter), spacing approx. 4m - 5m, 9 No. wires fixed between posts with no electric charge. Posts either set in concrete or driven into ground. Posts no more than 1.8m above ground.

Site Layout drawing, Location 3, 1:1,000.

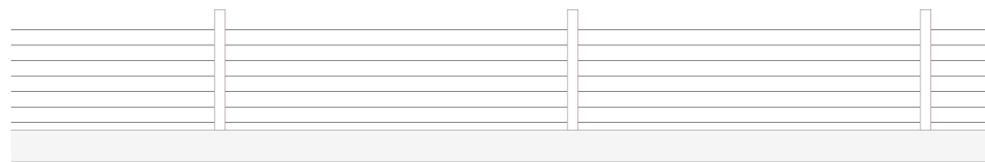

Fencing type D . General timber posts 100mm to 150 mm diameter, spacing at circa 4m to 5m centres. 6 No or 7 No wires fixed between posts with electric charge as cattle proofing. Posts either set in concrete or driven into ground. Posts vary in height, between 1.4m and 1.6 m over surrounding ground level. 1:50.




Fencing type E . Timber posts 100mm to 150 mm diameter, spacing at circa 4m to 5m centres. 9 No wires fixed between posts with no electric charge. Posts either set in concrete or driven into ground. Posts no more than 1.8 m height above surrounding ground level. 1:50.

Letters indicated as end locations of fencing as per drawings included with enforcement notices sent to applicants by Kerry County Council.


Location of fencing for which leave to apply for Substitute Consent is sought indicated by red line thus:



FENCING AT POINT "T"

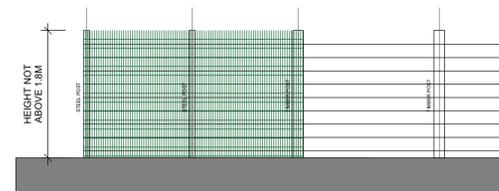

Fencing at Point "T" - 2 No. Steel Posts (80mm diameter) & 2 No. Timber posts (100 - 150mm diameter), spacing approx. 2m - 3m, 9 No. wires fixed between posts with no electric charge, forest green steel mesh on steel post section. Posts either set in concrete or driven into ground. Posts no more than 1.8m above ground.

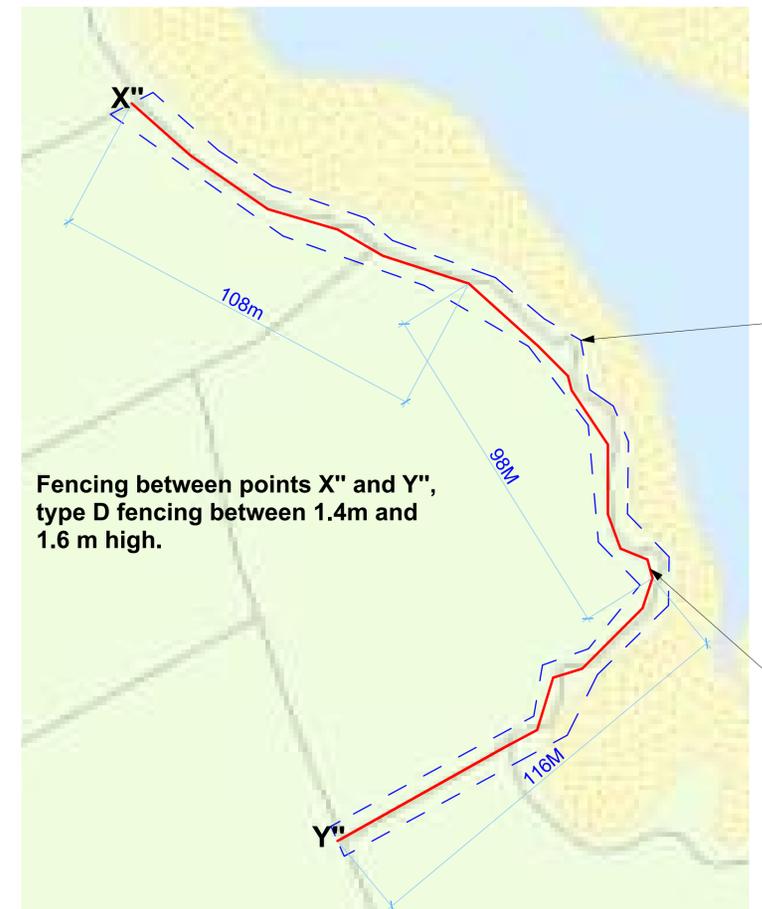

Site Layout drawing, Location 4, 1:1,000.

REVISIONS				Purpose of Issue	status	Scales @ A1 1:1000, 1:50	Project No.	Originator Leahy Planning Ltd. Mill Road House, Mill Road, Ennis, Co. Clare, Ireland. michael@leahyplanning.com	Project Application for leave to apply for Substitute Consent for fencing. Fenit Wilthin, Fenit, Co. Kerry.	Client Seamus T. O'Sullivan, John P. Murphy and Kit and Liam McCarthy	Layout Title Site layout locations 3 and 4. Details of Fencing.	Drawing Number project originator volume level type note number rev #Proj- ML - - - OSS 22 03 03
RevID	Transmittal Set Name	Issue Date	Transmitter	Status	Approved by							