

LEGEND

-  FENCING PART OF SUBSTITUTE CONSENT APPLICATION
-  SPECIAL AREA FOR CONSERVATION
-  KY 17067 & KY 17069


MEASUREMENTS

RED LINE

T - End	= 5m
S - End	= 12m
U - V	= 112m
W' - X'	= 258m
Y' - Z'	= 260m
TOTAL	= 647m



SCALE: 1:2,500 @ A3

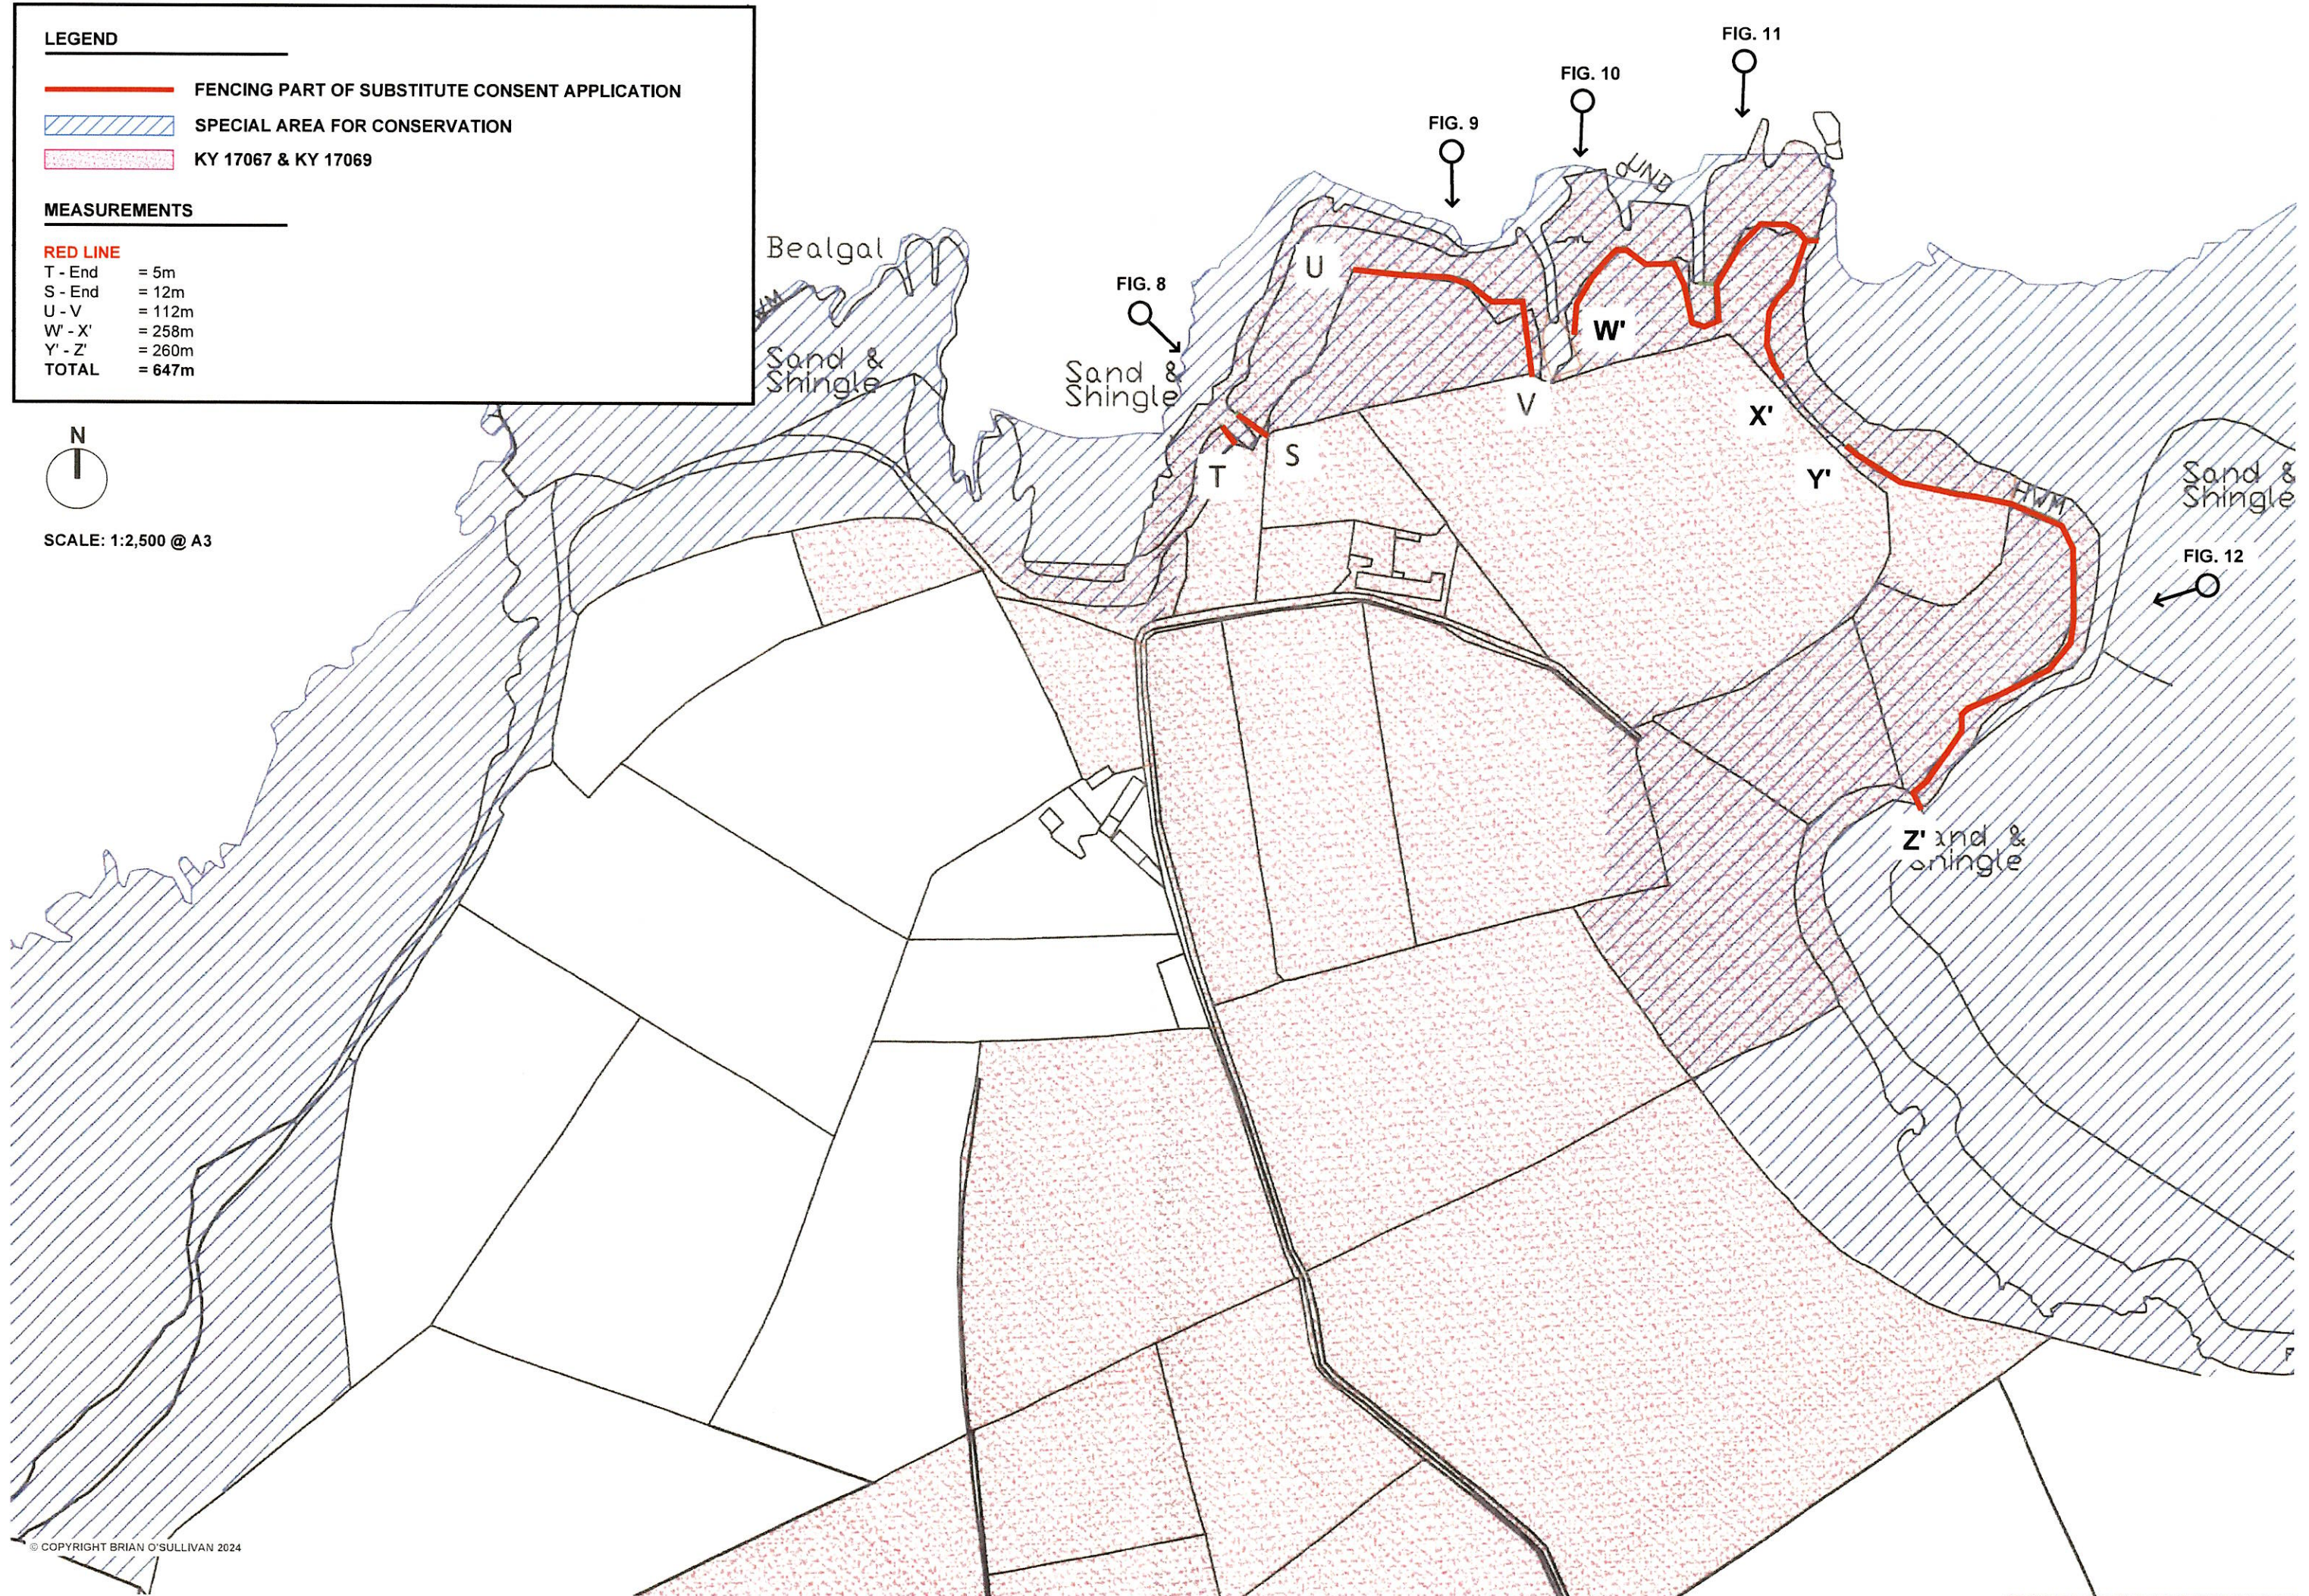



START OF ENFORCEMENT
LINE ON MAP

Z'

Y'

LEGEND

FENCING PART OF SUBSTANTIVE CONSENT
APPLICATION

MEASUREMENTS

Y' - Z' = 260m

FENCE TYPE A

FIG. 12

KERRY COUNTY COUNCIL -V- SEAMAS O'SULLIVAN

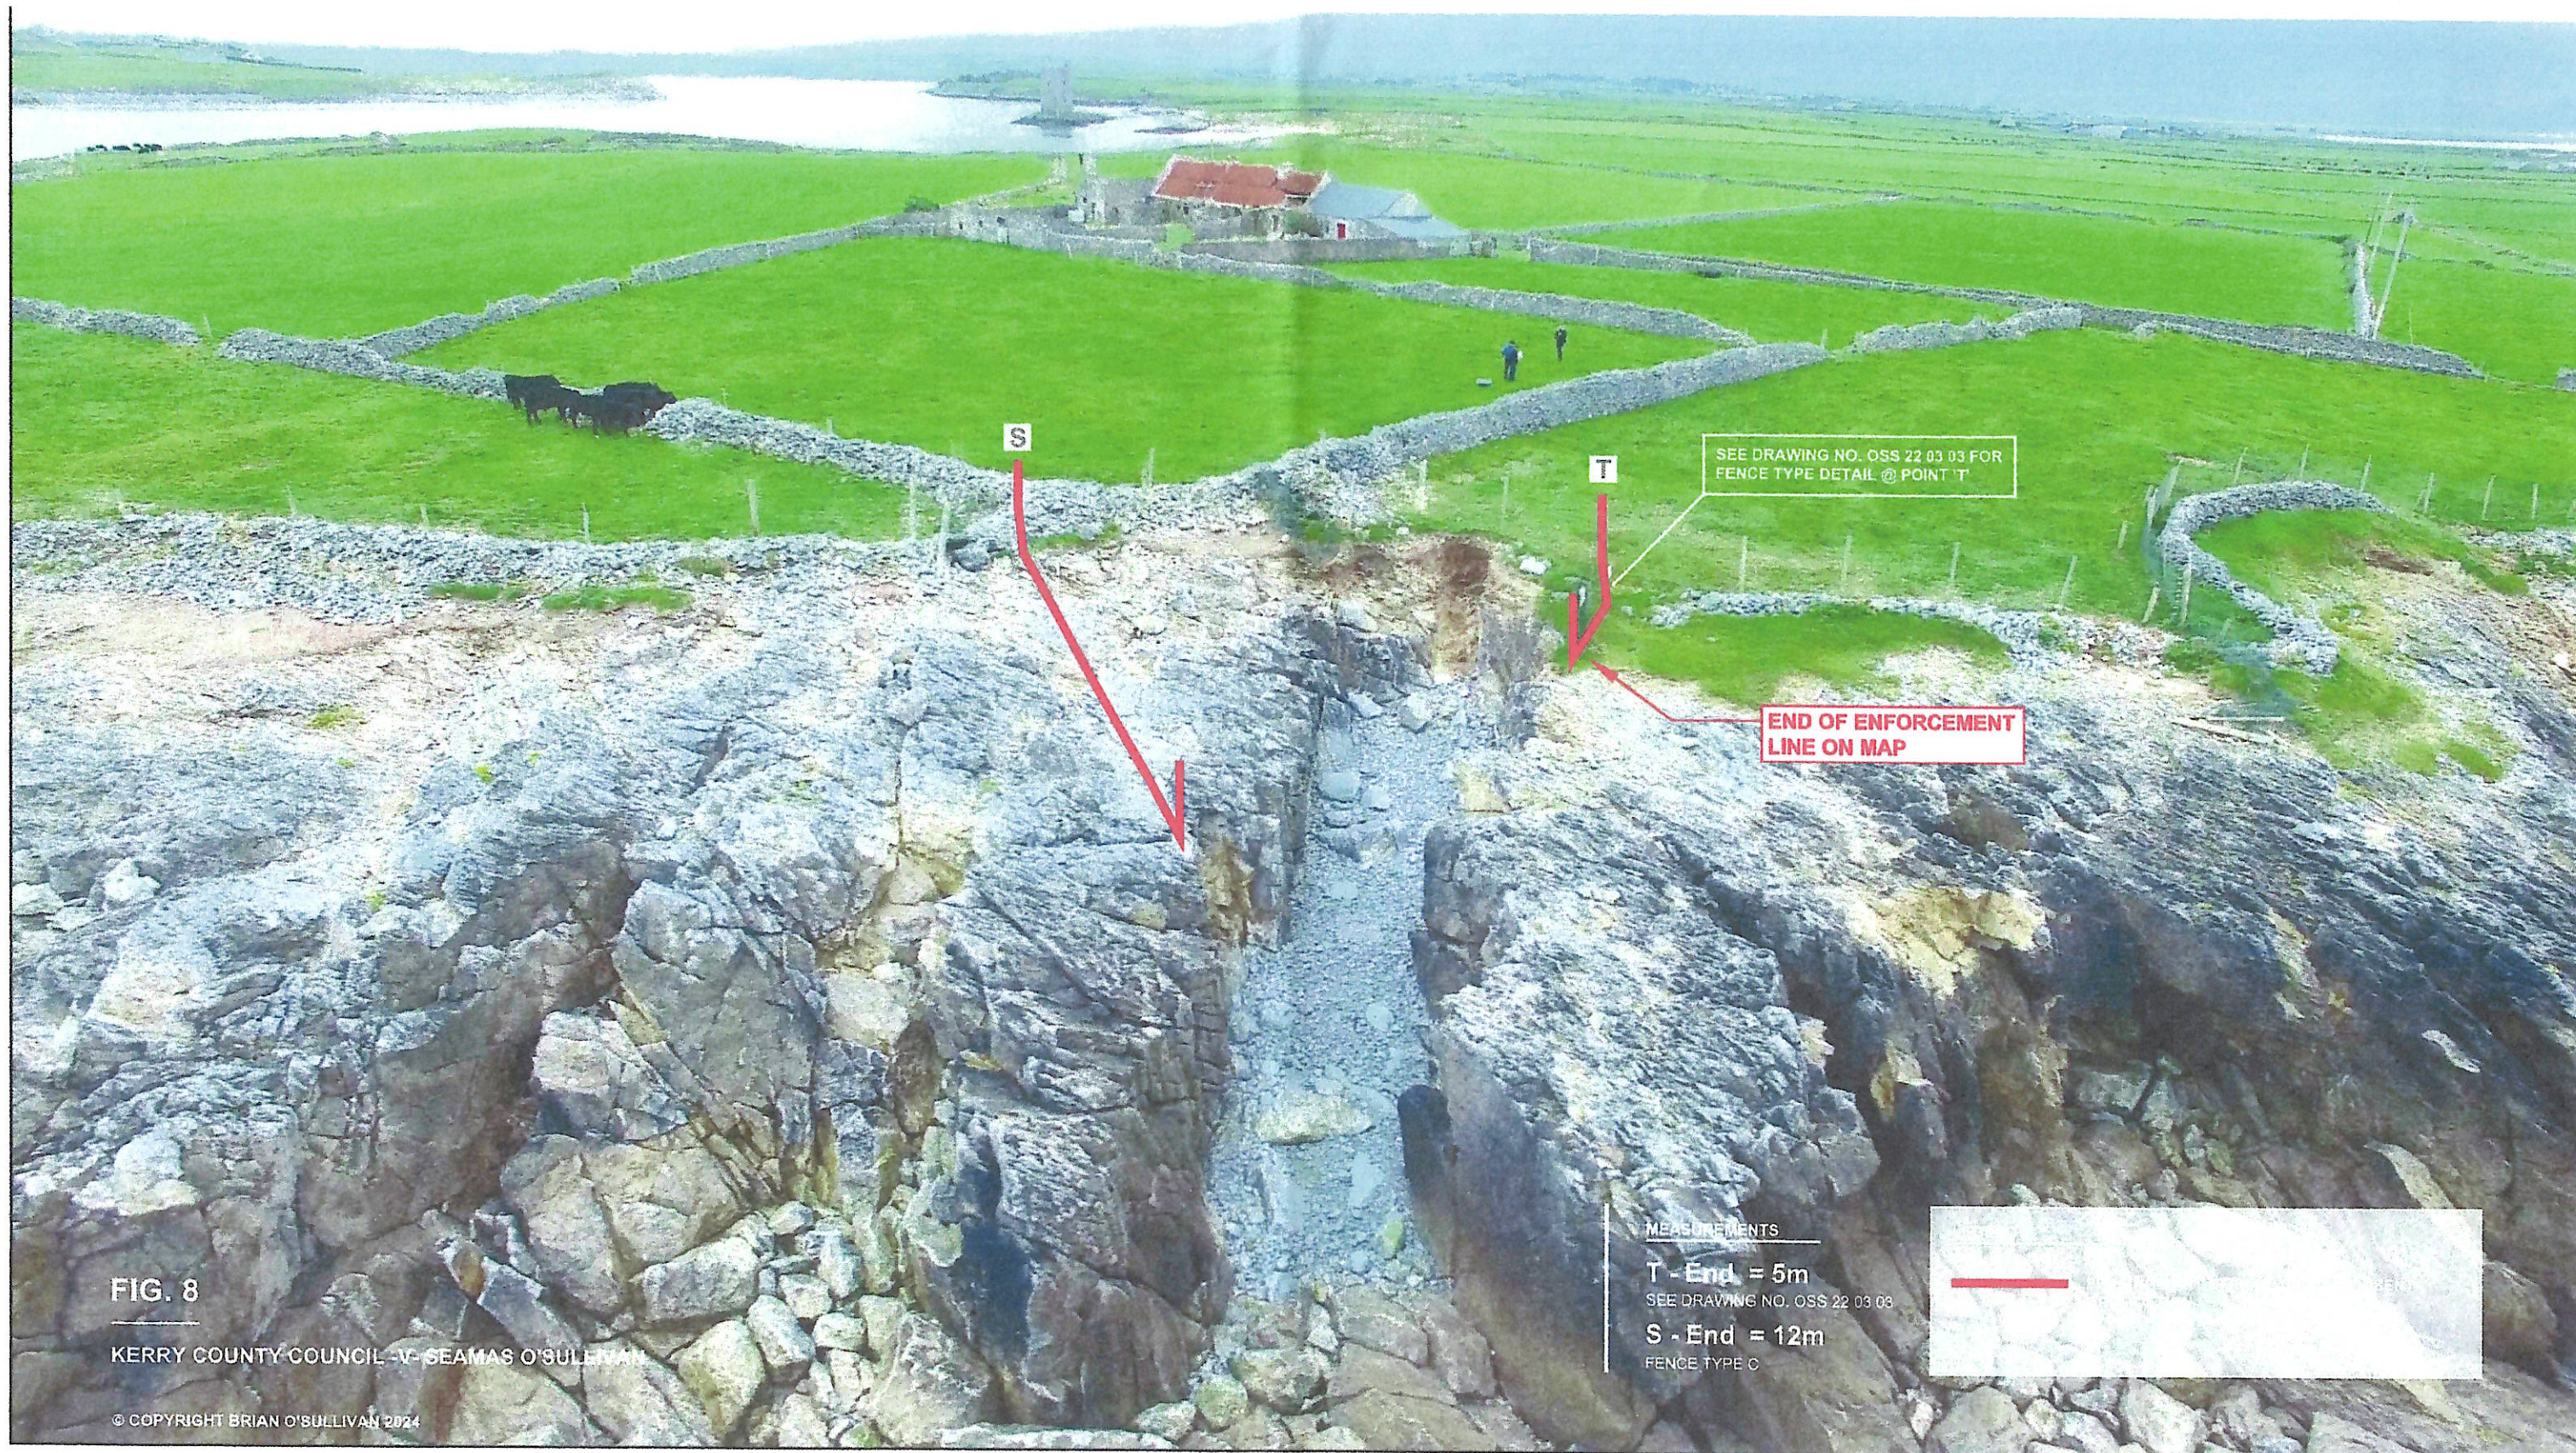


FIG. 8

KERRY COUNTY COUNCIL -V- SEAMAS O'SULLIVAN

© COPYRIGHT BRIAN O'SULLIVAN 2024

MEASUREMENTS


T - End = 5m

SEE DRAWING NO. OSS 22 03 03

S - End = 12m

FENCE TYPE C



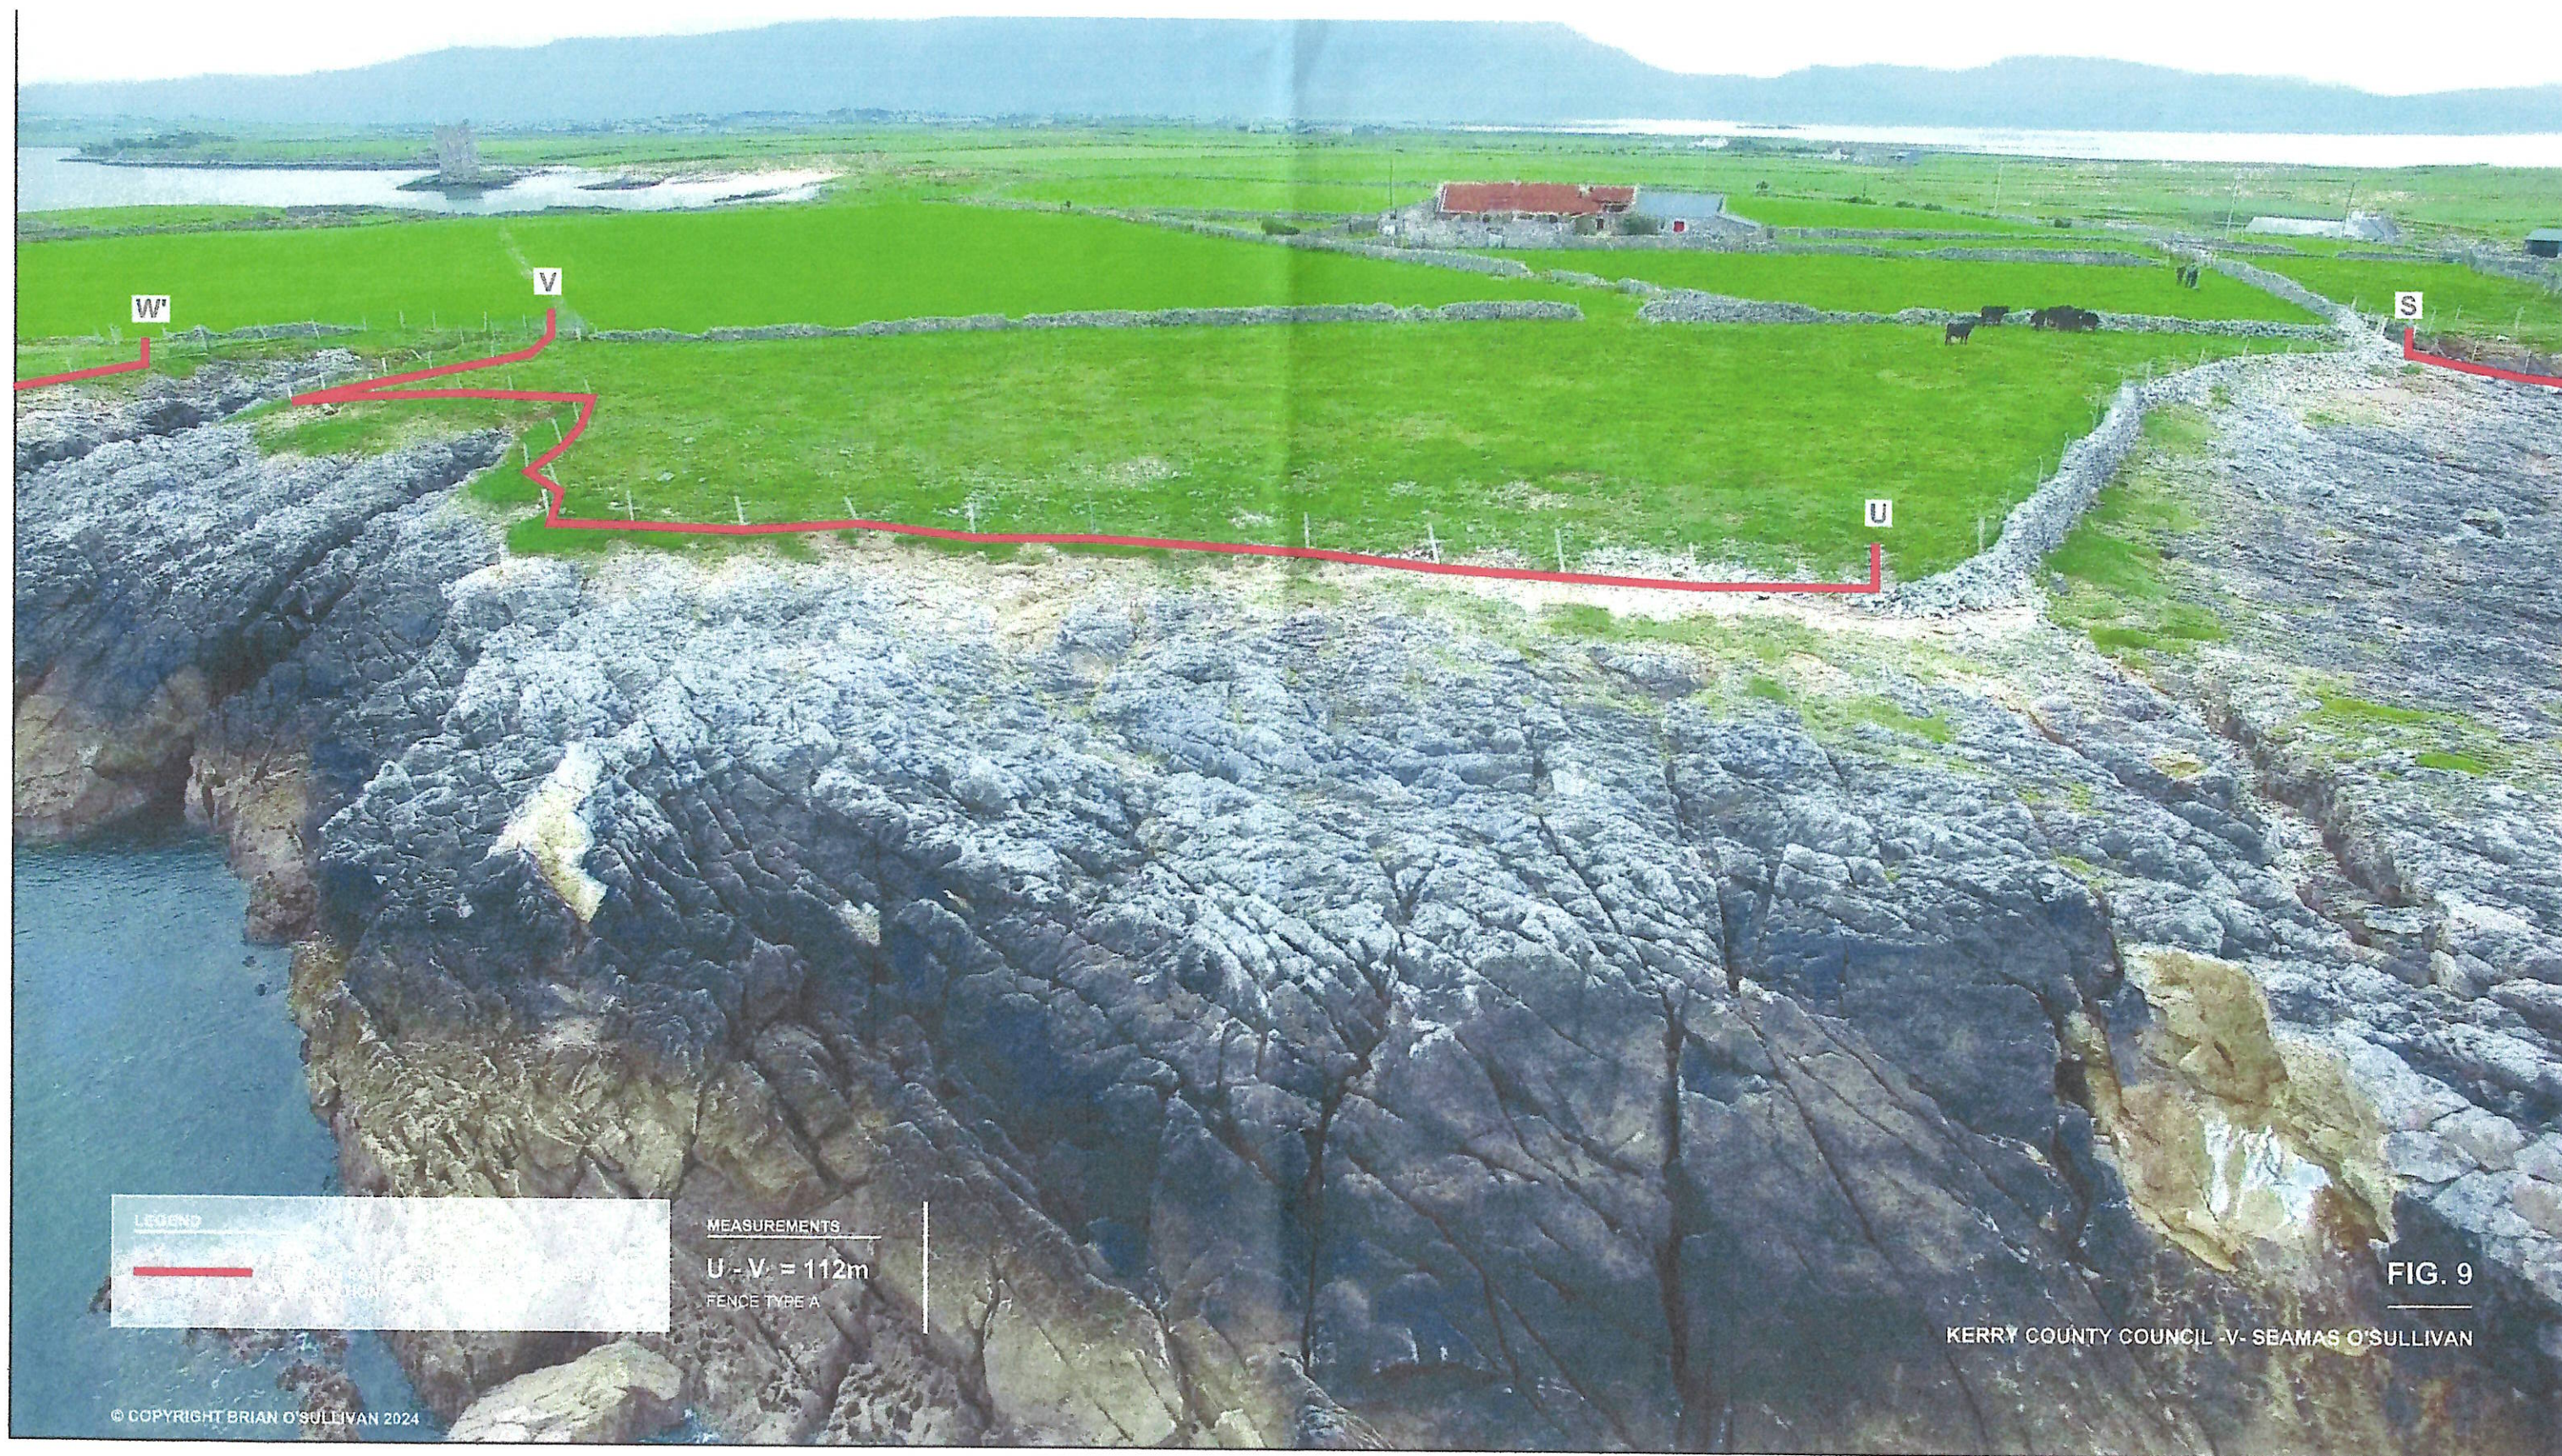

LEGEND



FENCE LINE
FENCE TYPE A


MEASUREMENTS

U - V = 112m

FENCE TYPE A

FIG. 9

KERRY COUNTY COUNCIL -V- SEAMAS O'SULLIVAN

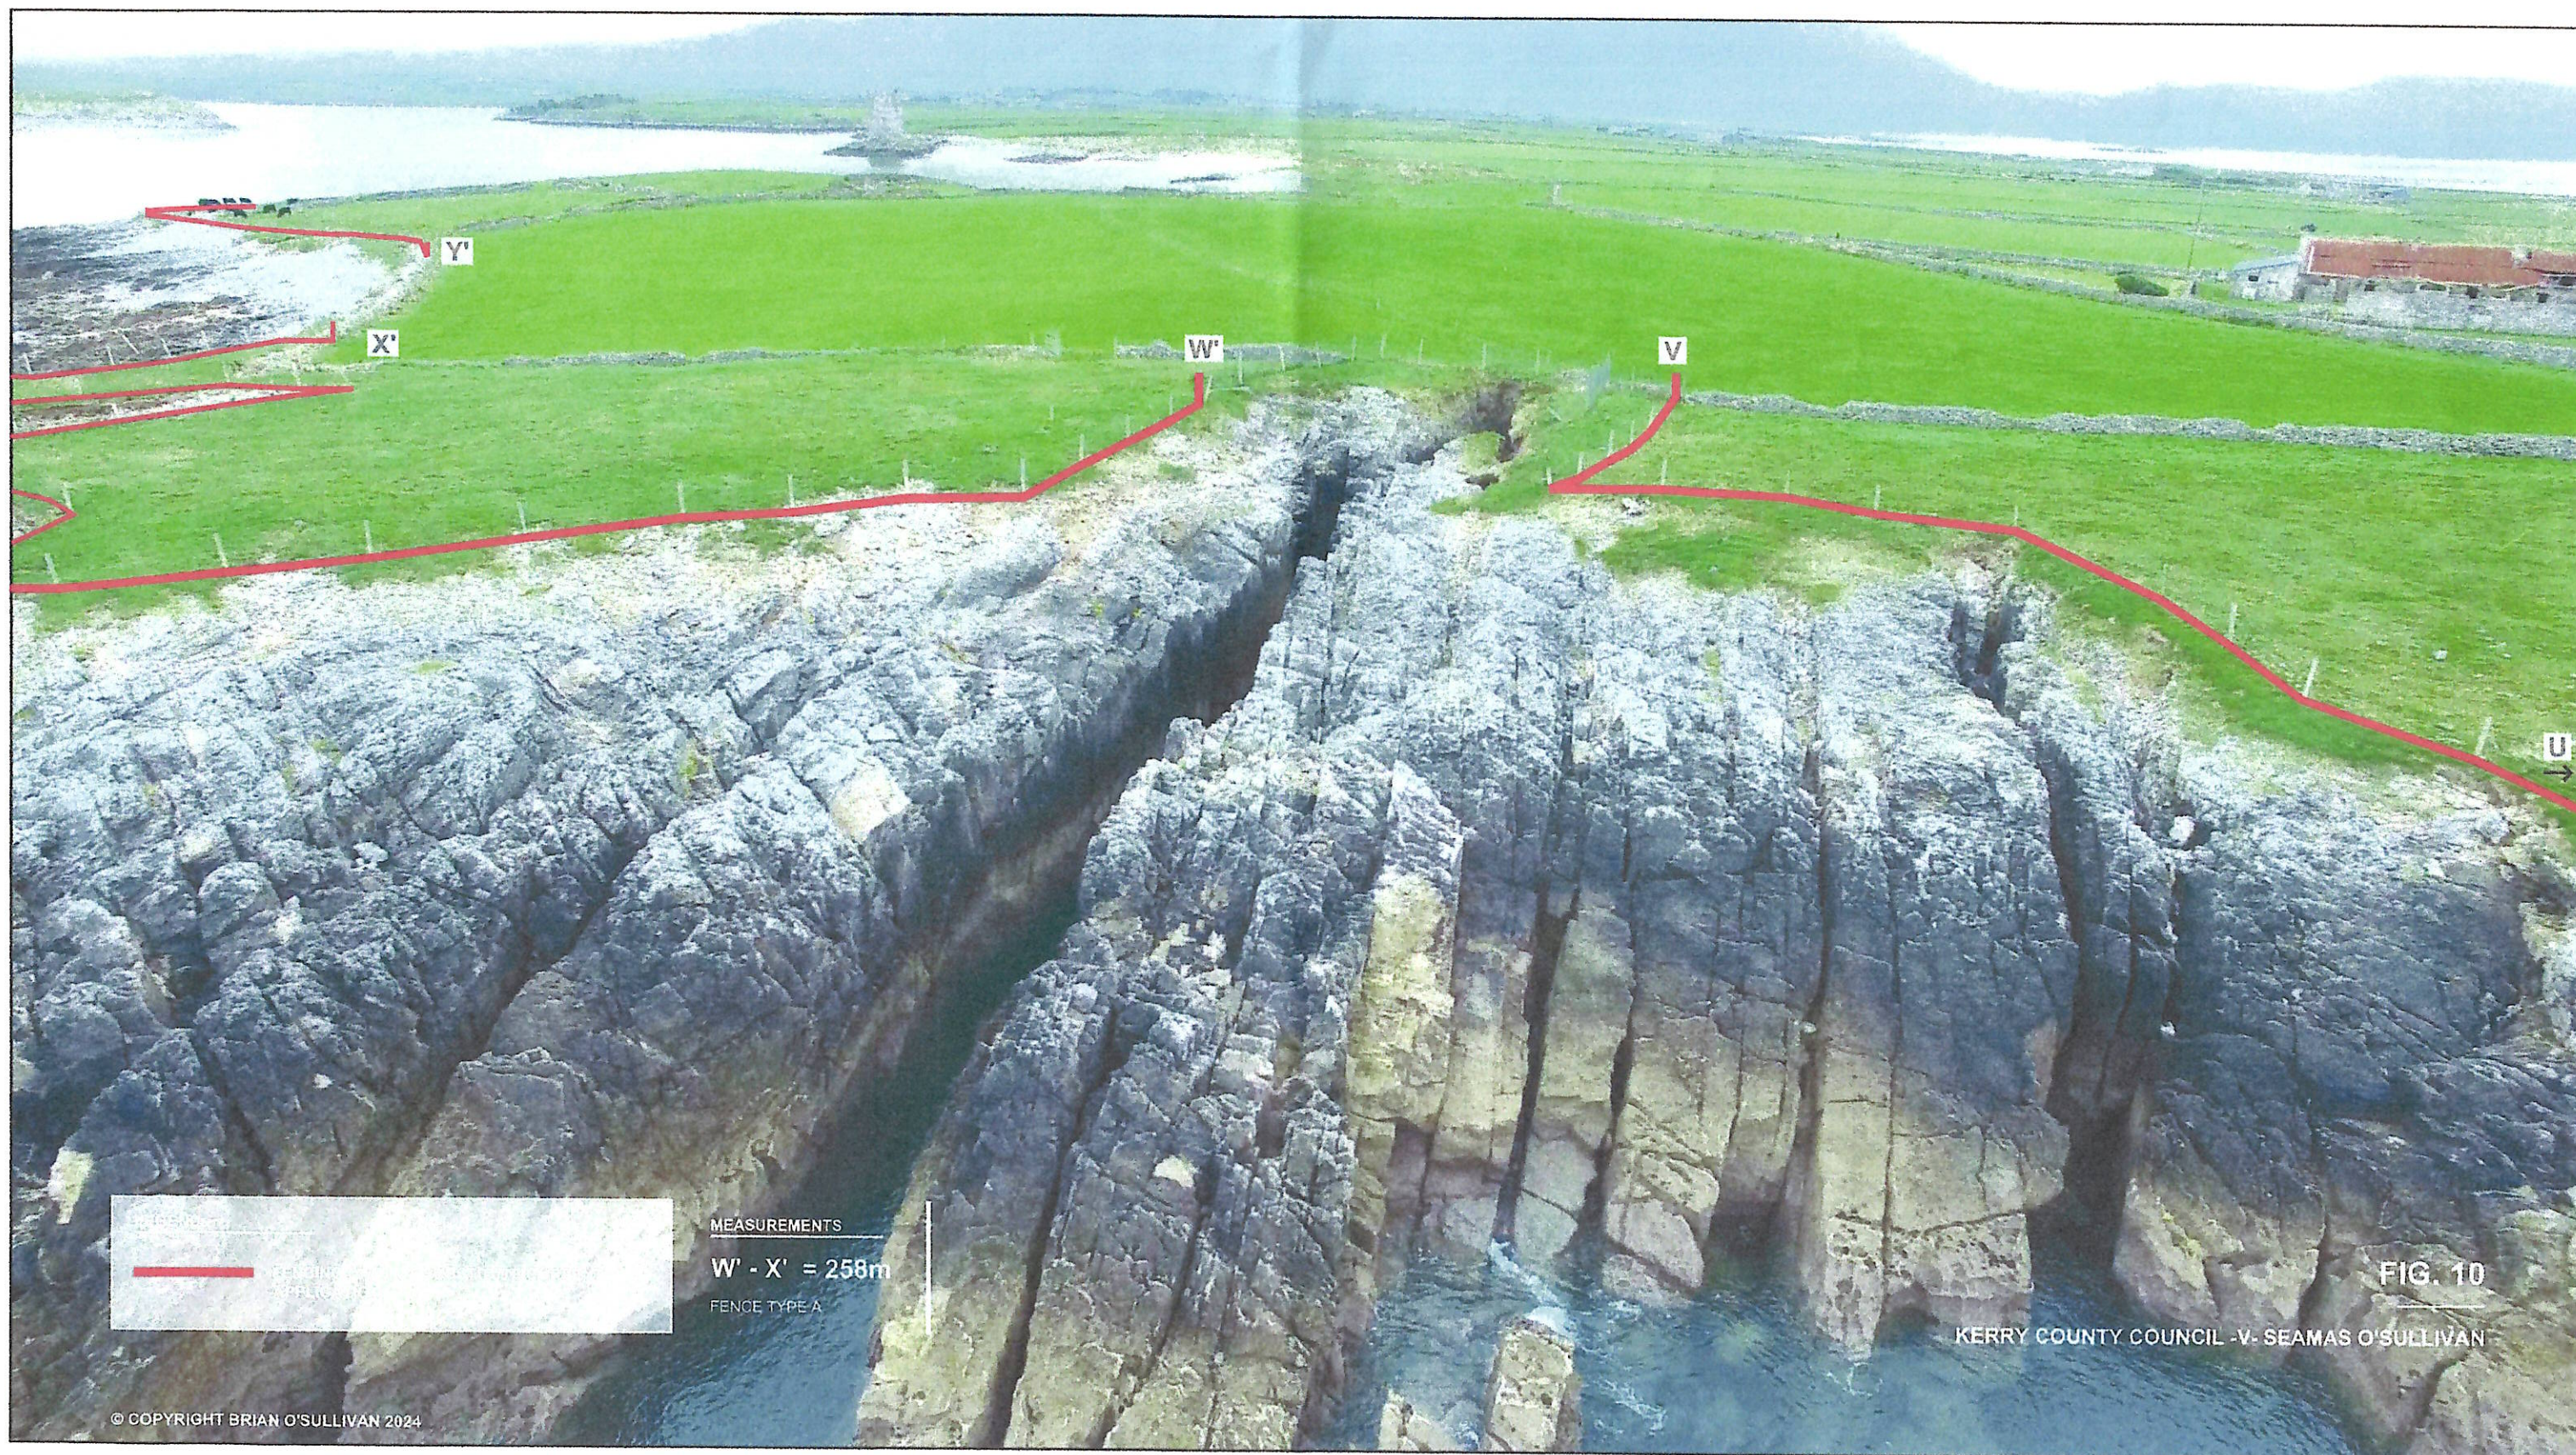

MEASUREMENTS
W' - X' = 258m
FENCE TYPE A

FIG. 10

KERRY COUNTY COUNCIL -V- SEAMAS O'SULLIVAN

