

LEGEND

- FENCING PART OF SUBSTITUTE CONSENT APPLICATION
- SPECIAL AREA FOR CONSERVATION
- KY 17072

MEASUREMENTS

RED LINE TOTAL = 336m



SCALE: 1:2,500 @ A3

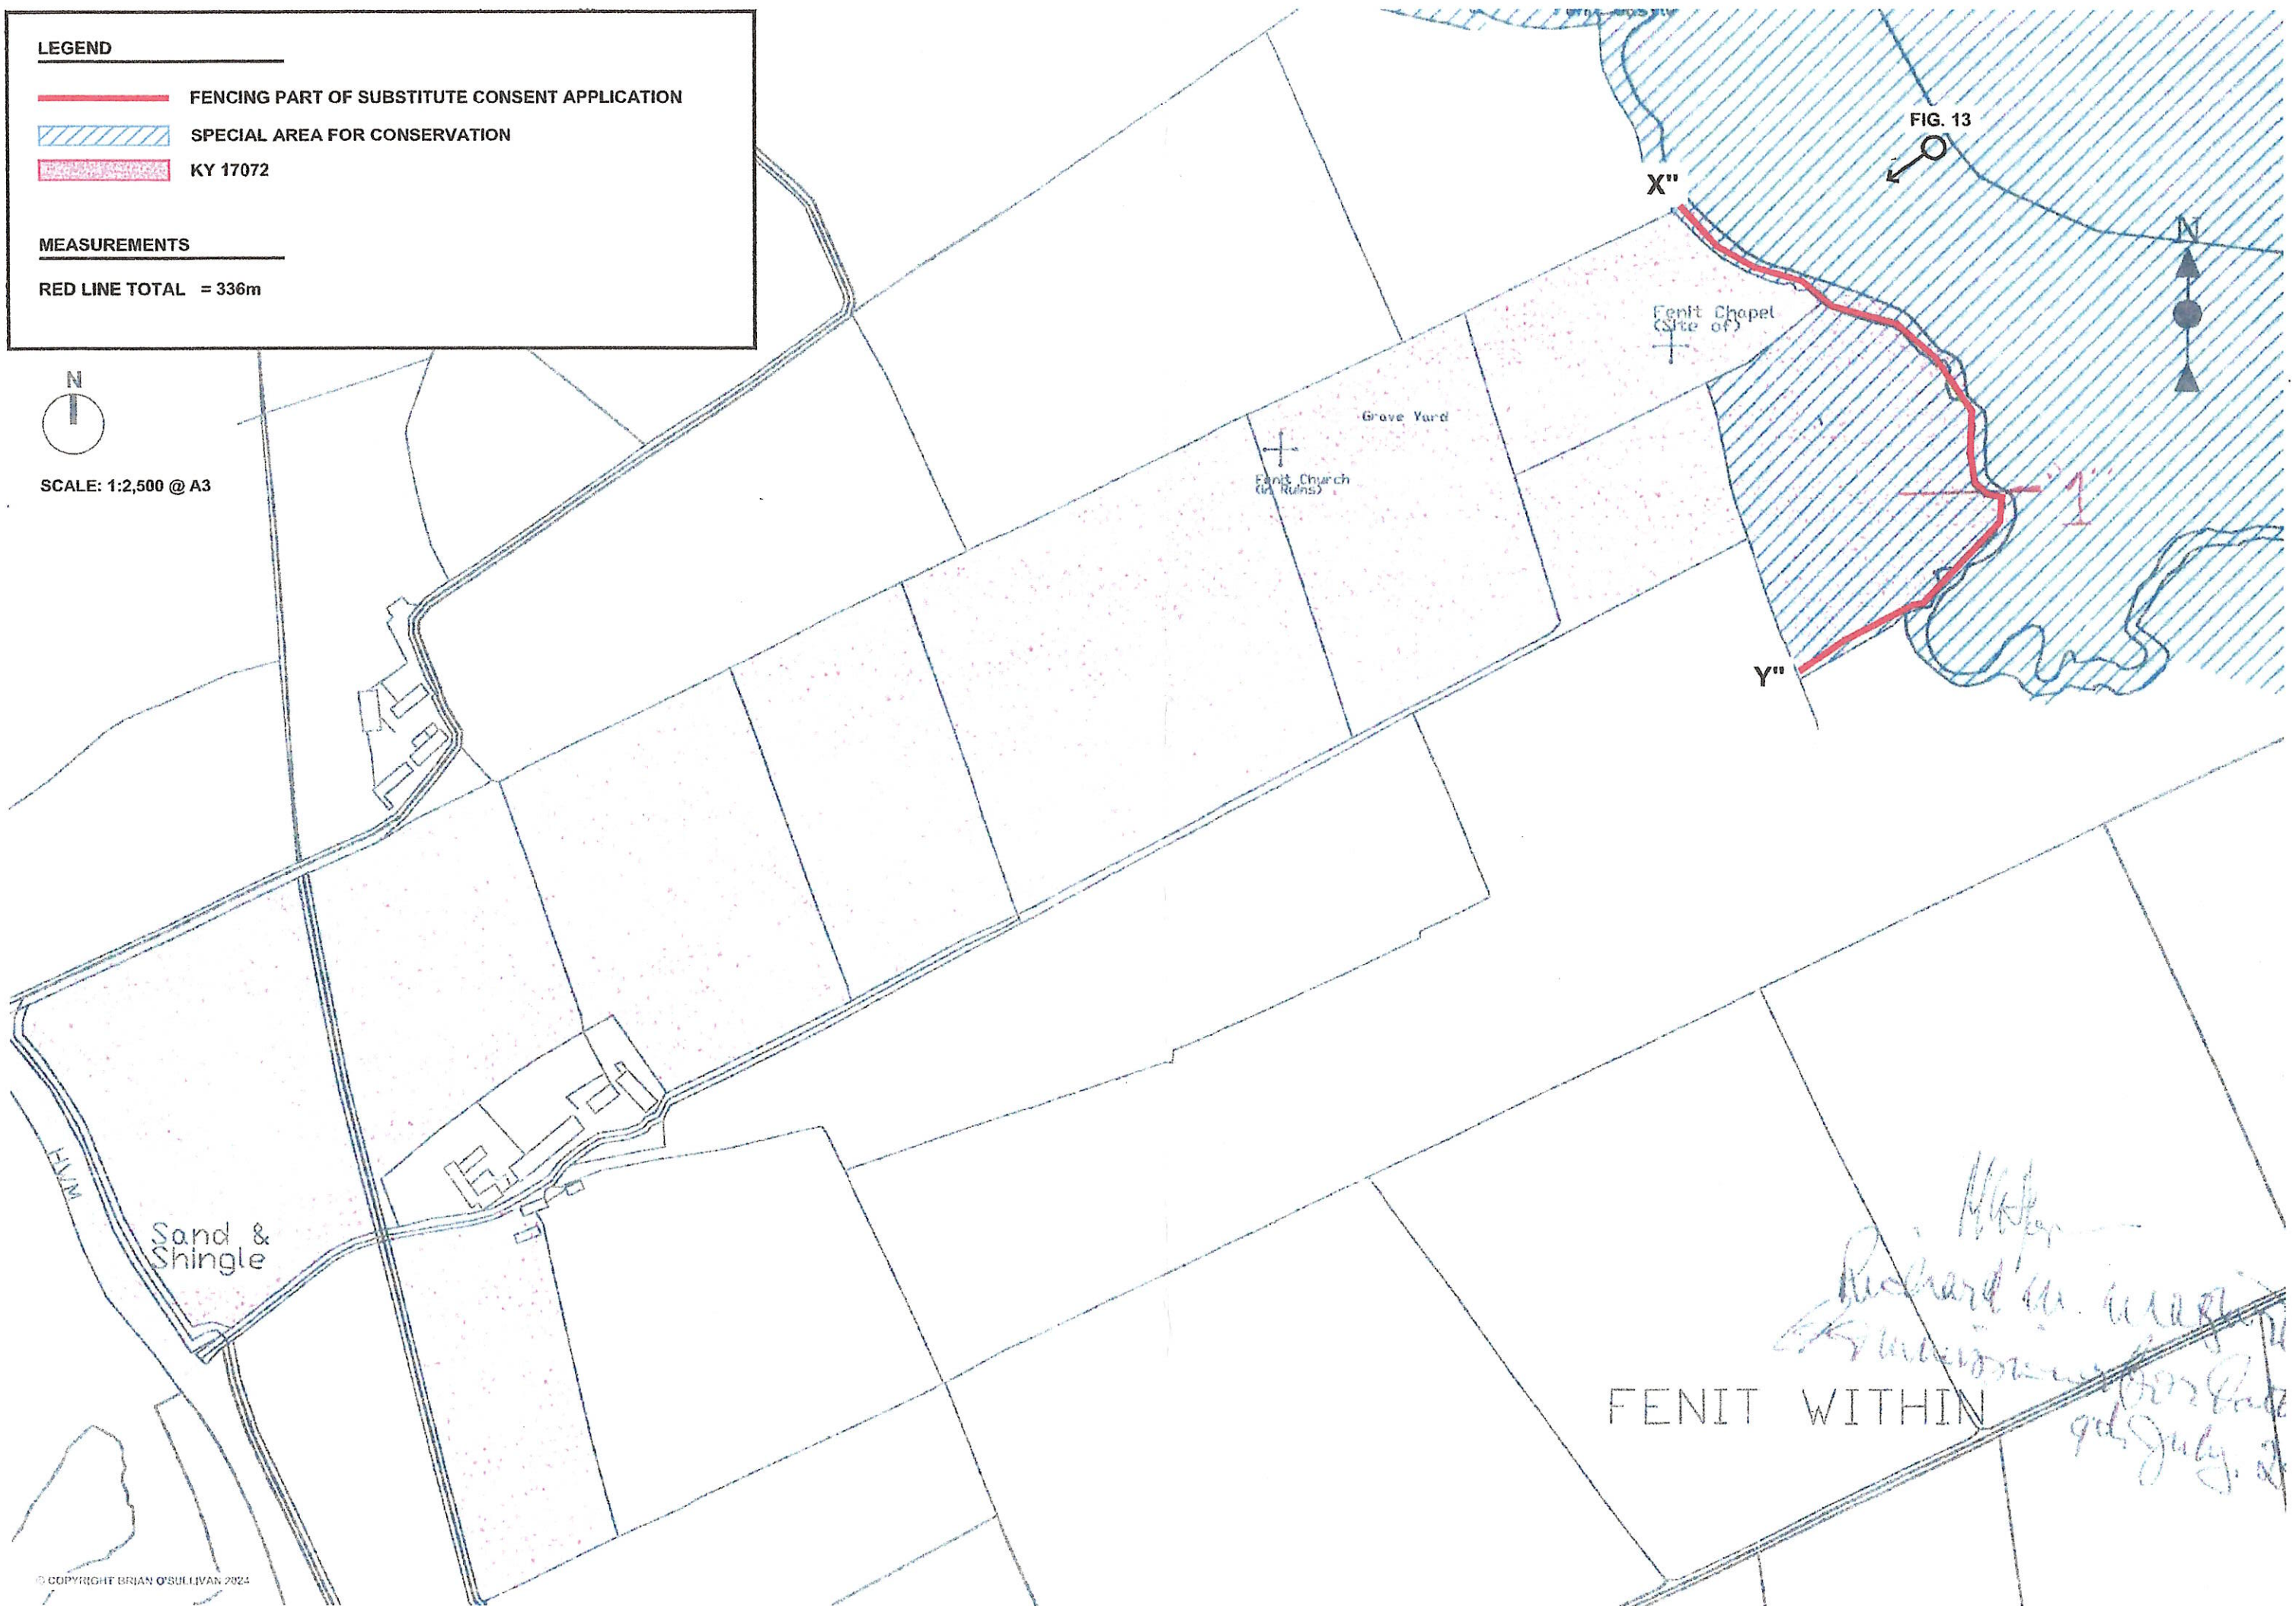


FIG. 13

X''

Fenit Chapel
(Site of)

Fenit Church
(Ruins)

Grove Yard

Y''

Sand & Shingle

R.M.

FENIT WITHIN

Richard W. Maguire
9th July 2024

