


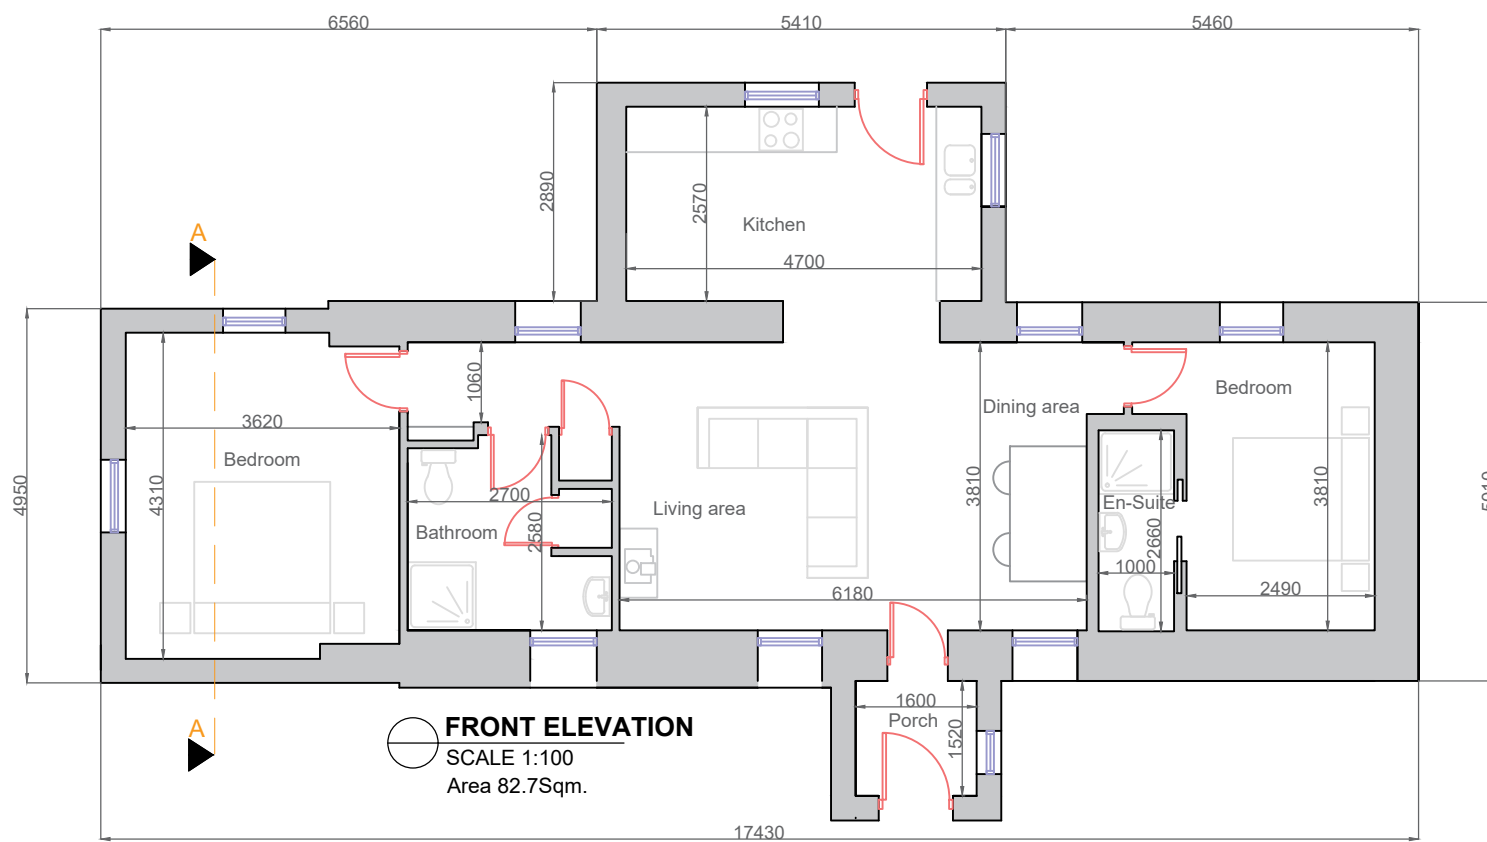


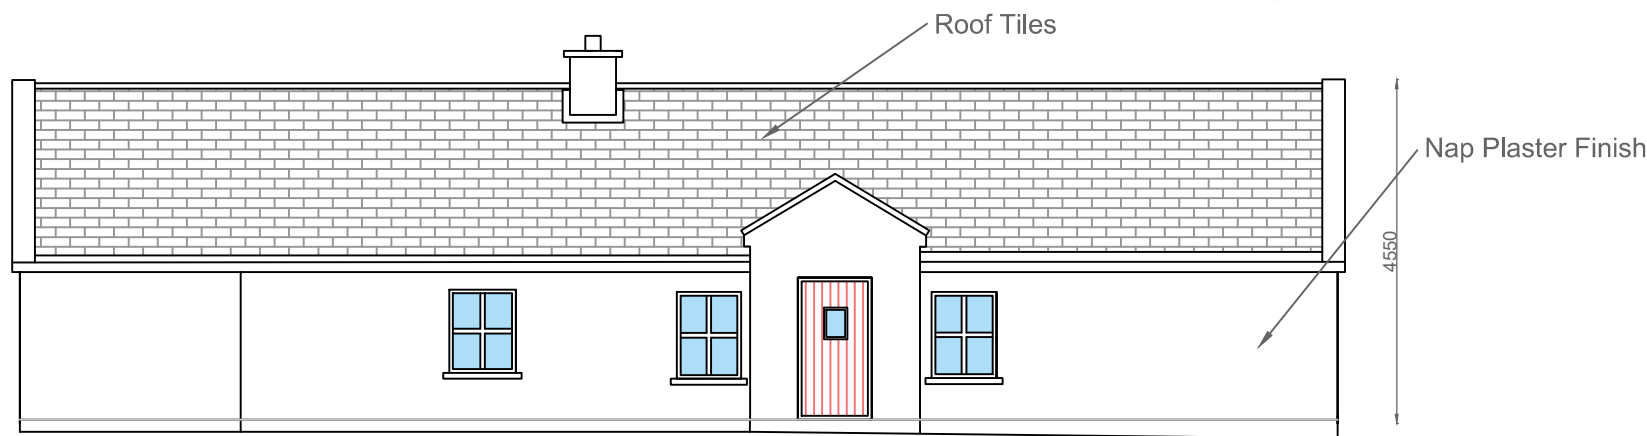


FRONT ELEVATION
SCALE 1:100
Area 82.7Sqm.

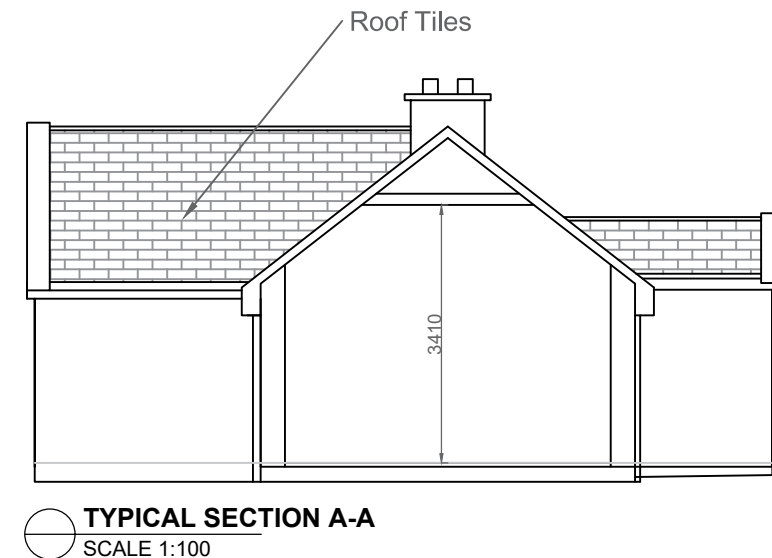


FRONT ELEVATION
SCALE 1:100

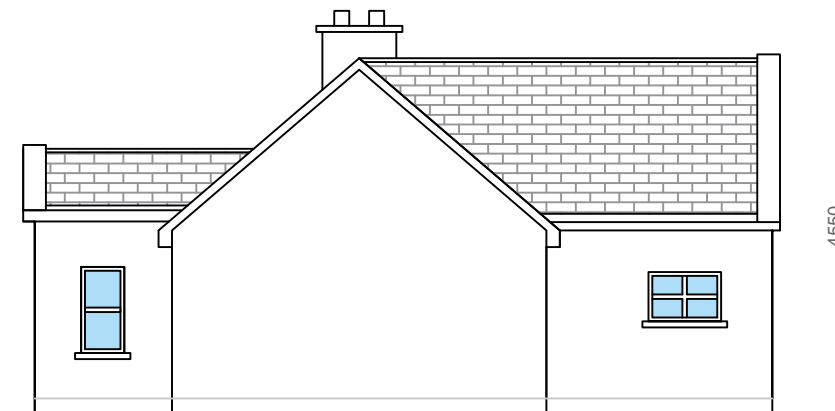


SIDE ELEVATION
SCALE 1:100

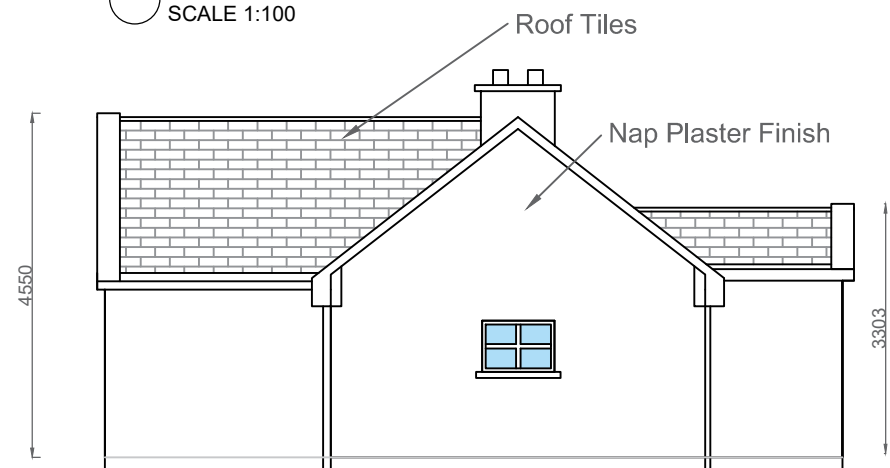

SIDE ELEVATION
SCALE 1:100

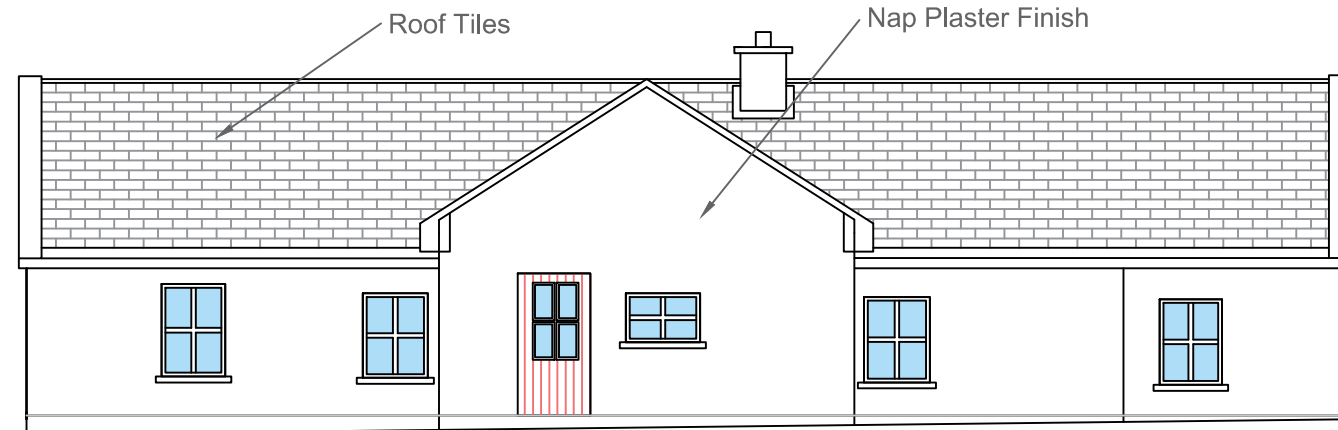

REAR ELEVATION
SCALE 1:100

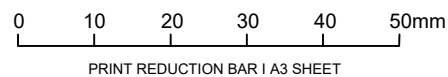


NOTES:
THIS DRAWING AND ANY DESIGN HEREON IS COPYRIGHT AND
MUST NOT BE REPRODUCED WITHOUT WRITTEN CONSENT.
DO NOT SCALE FROM DRAWING. USE FIGURED DIMENSIONS
ONLY.
ALL DIMENSIONS TO BE CHECKED ON SITE AND ANY
DISCREPANCIES REPORTED IMMEDIATELY TO THE ENGINEER
BEFORE WORK PROCEEDS. ALL DIMENSIONS IN MM UNLESS
STATED.
DRAWINGS ARE FOR PLANNING PURPOSES ONLY AND ARE
NOT INTENDED FOR CONSTRUCTION

OMC
Multidisciplinary Building
Consultants
Dublin | Galway | Clifden
Telephone: +353 (0) 91 394 185
omcgroup.ie

REV.	AMENDMENT DESCRIPTION	DATE


PROJECT TITLE: Retention Application at Ballinaboy, Clifden, Co. Galway
DRAWING TITLE: Existing Plans & Elevations.

CLIENT: Mr. George Melville	DRAWING NO: PP-01
DATE: October 2025	DRAWN BY: JB
PROJECT NO.: 1425	CHECKED BY:
SCALE @ A3: 1:100	REVISION: 0

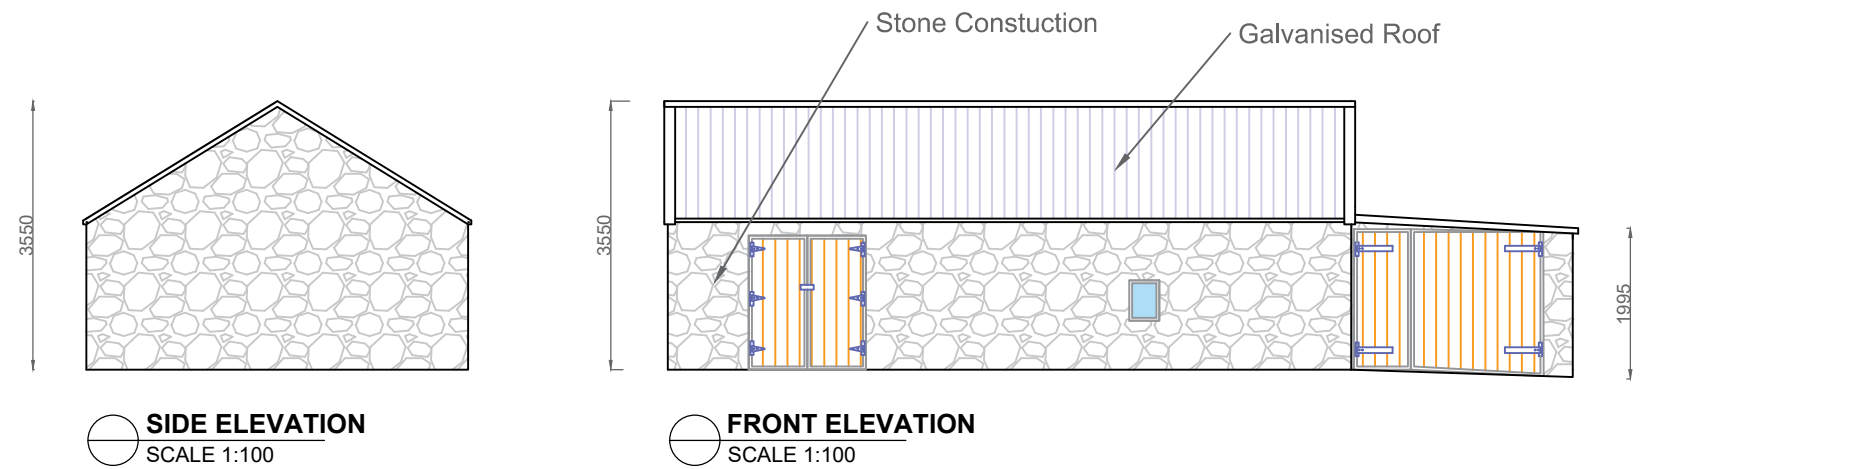


SIDE ELEVATION
SCALE 1:100

FRONT ELEVATION
SCALE 1:100

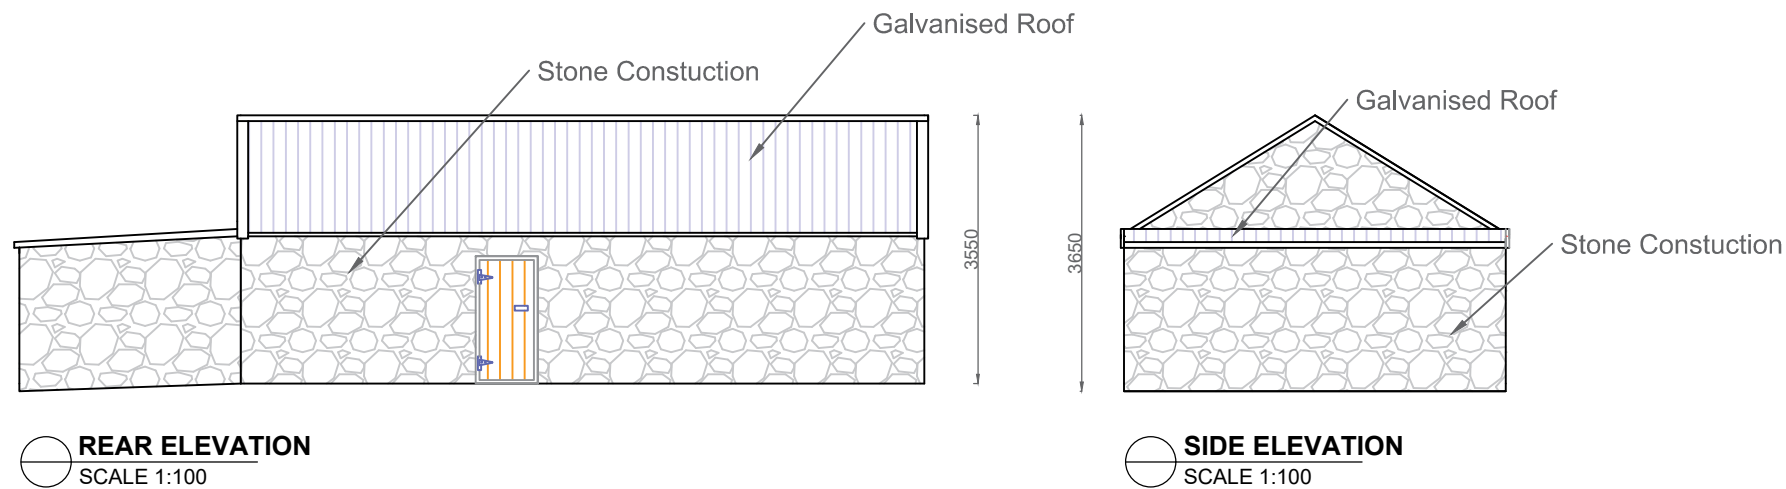


REAR ELEVATION
SCALE 1:100

SIDE ELEVATION
SCALE 1:100

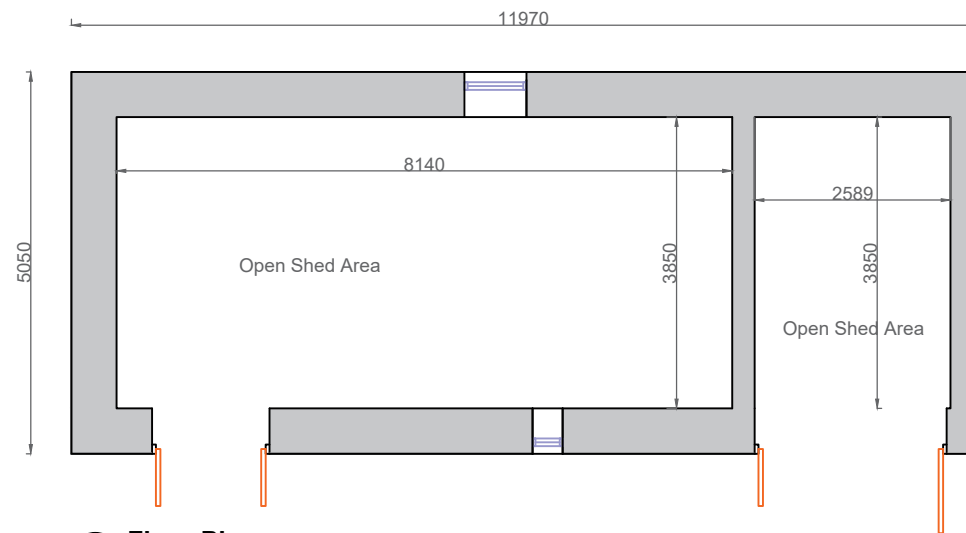

Floor Plans
AREA 45.4 Sqm
SCALE 1:100

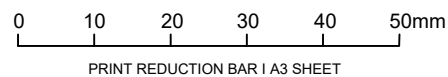

NOTES:
THIS DRAWING AND ANY DESIGN HEREON IS COPYRIGHT AND MUST NOT BE REPRODUCED WITHOUT WRITTEN CONSENT.
DO NOT SCALE FROM DRAWING. USE FIGURED DIMENSIONS ONLY.
ALL DIMENSIONS TO BE CHECKED ON SITE AND ANY DISCREPANCIES REPORTED IMMEDIATELY TO THE ENGINEER BEFORE WORK PROCEEDS. ALL DIMENSIONS IN MM UNLESS STATED.
DRAWINGS ARE FOR PLANNING PURPOSES ONLY AND ARE NOT INTENDED FOR CONSTRUCTION

OMC
Multidisciplinary Building Consultants
Dublin | Galway | Clifden
Telephone: +353 (0) 91 394 185
omcgroup.ie

REV.	AMENDMENT DESCRIPTION	DATE

PROJECT TYTLE: Retention Application at Ballinaboy, Clifden, Co. Galway	DRAWING TITLE: Existing Plans & Elevations as built (Shed)
---	--

CLIENT: Mr. George Melville	DRAWING NO: PP-01.01
DATE: October 2025	DRAWN BY: JB
PROJECT NO.: 1425	CHECKED BY:
SCALE @ A3: 1:100	REVISION: 0