




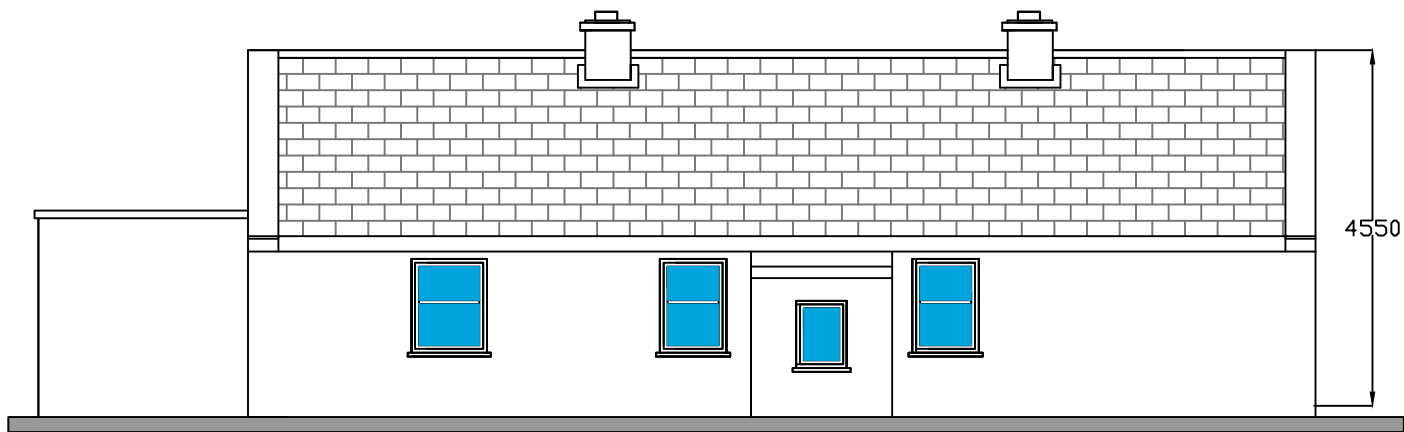

EXISTING FRONT ELEVATION.
Scale 1:100

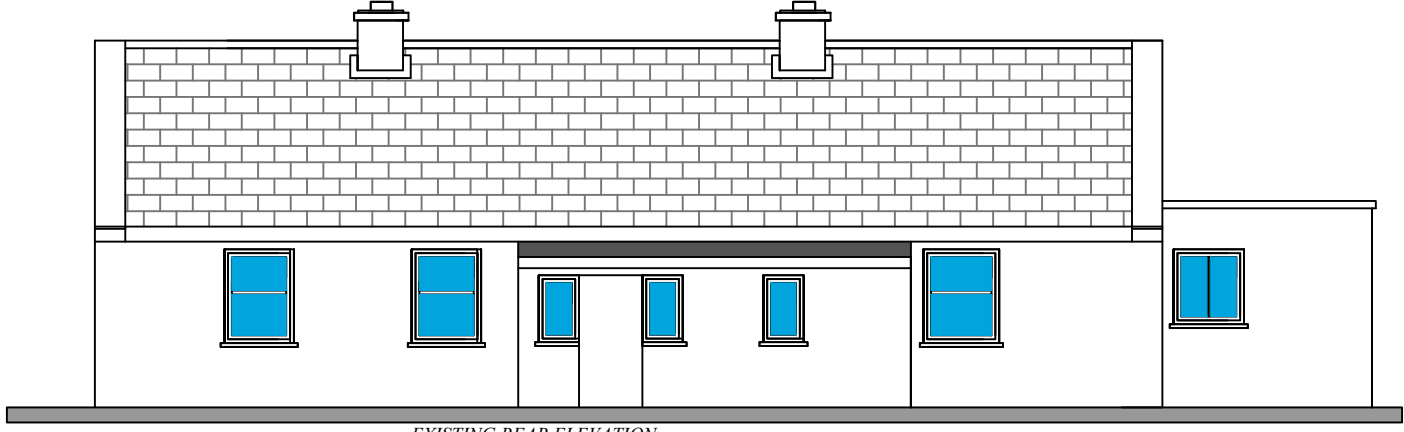


EXISTING REAR ELEVATION.
Scale 1:100

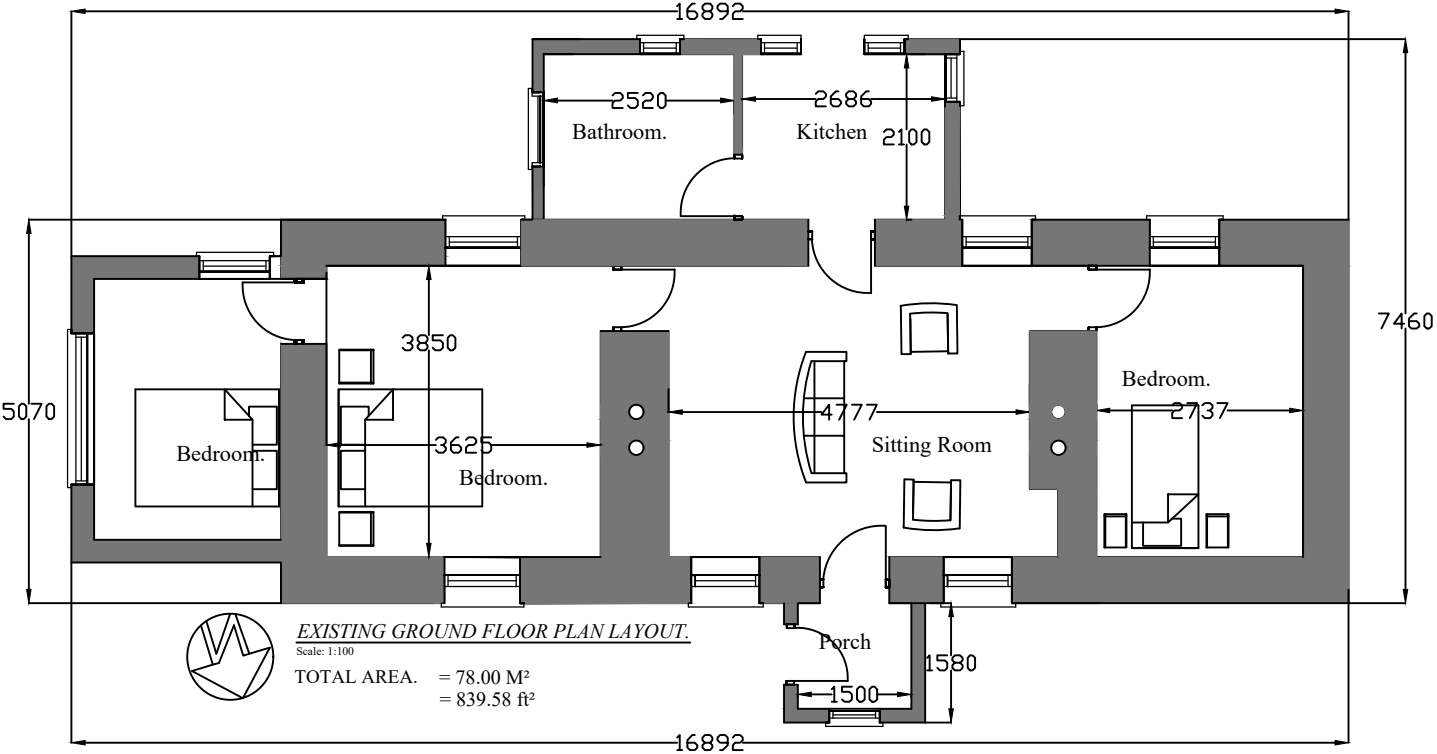


EXISTING GROUND FLOOR PLAN LAYOUT.
Scale: 1:100
TOTAL AREA. = 78.00 M²
= 839.58 ft²

EXISTING

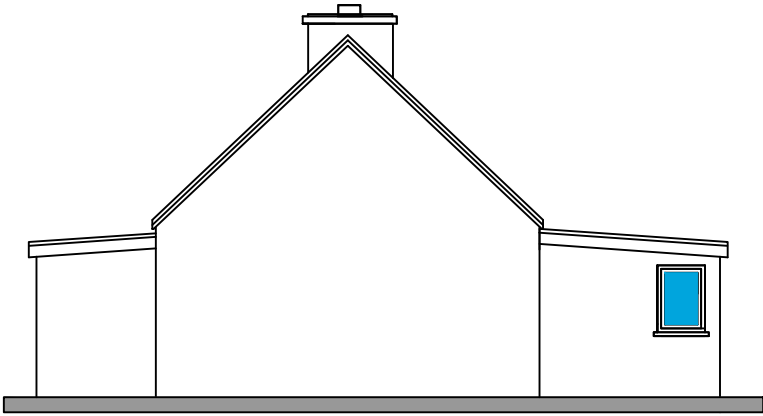

EXISTING SIDE ELEVATION.
Scale 1:100

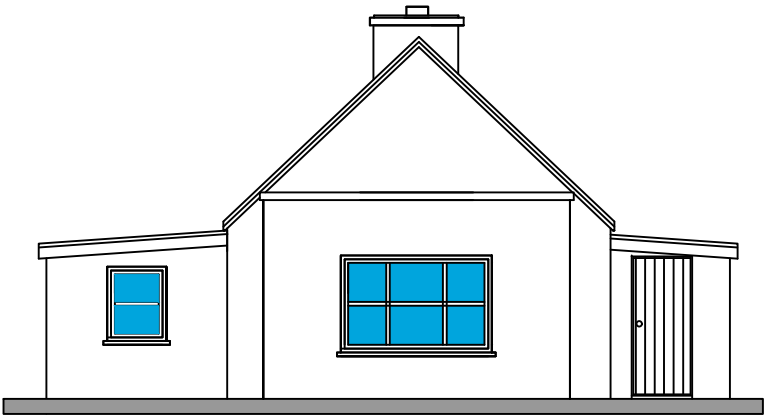

EXISTING SIDE ELEVATION.
Scale 1:100

NOTE: DRAWINGS ARE FOR PLANNING PURPOSES ONLY AND ARE NOT INTENDED FOR CONSTRUCTION.


Notes:
This drawing and any design hereon is copyright and must not be reproduced without written consent.
DO NOT SCALE from drawing use figured dimensions only
All dimensions to be checked on site and any discrepancies reported immediately to the engineer before work proceeds.
All Dimensions in mm unless stated.

O'MCE
Enda O'Malley B.Eng C.Eng MIEI
Bunowen
Ballyconneely
Co. Galway
Fax: 095 23544
Mob: 086 3567851
Email: endaomalley@gmail.com

Revisions		
Date	Discription	NO.


PROJECT TITLE:
Proposed Alterations to Existing Dwelling House and Associated Site Works at Ballinaboy, Clifden, Co. Galway.
DRAWING TITLE:
Existing Floor Plan Layouts and Elevations.

CLIENT:		
Mr. George Melville		
DATE:	20th August 2019	DRAWN BY: EOM
CHECKED BY:	EOM	EOM
SCALE:	1:100 @ A3.	
PROJECT NO:	1425	DRAWING NO: PP-03
REVISION NO:	R4.	

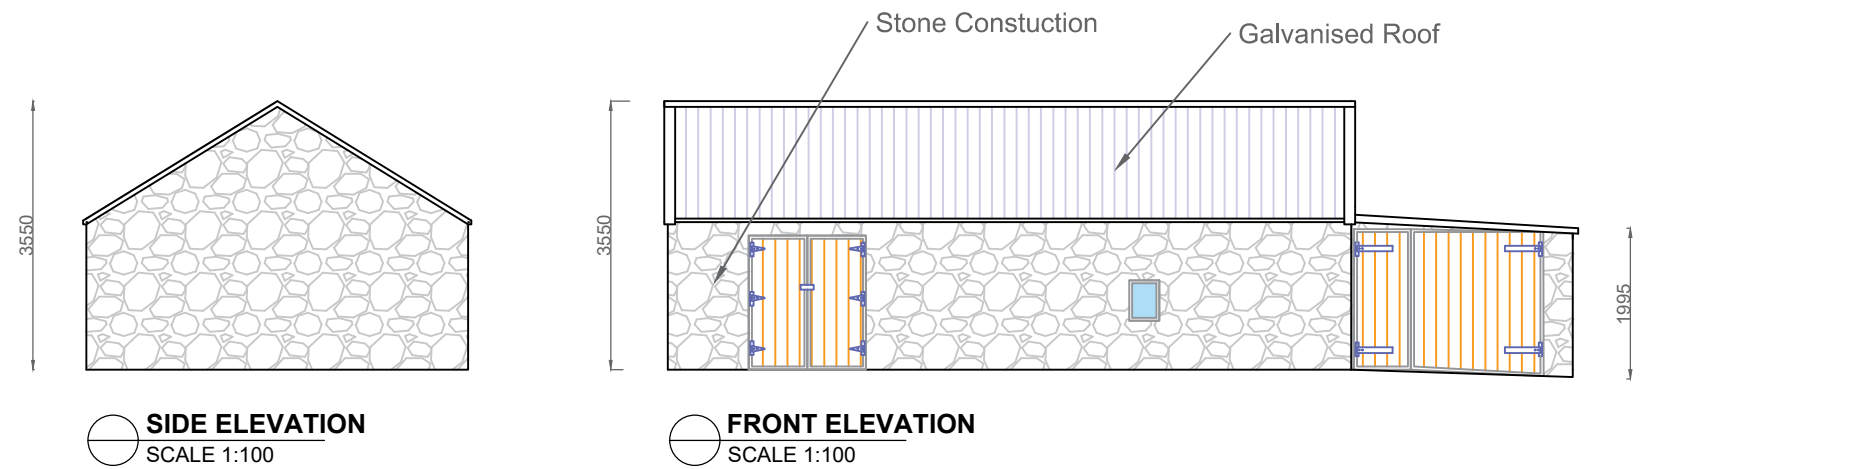


SIDE ELEVATION
SCALE 1:100

FRONT ELEVATION
SCALE 1:100

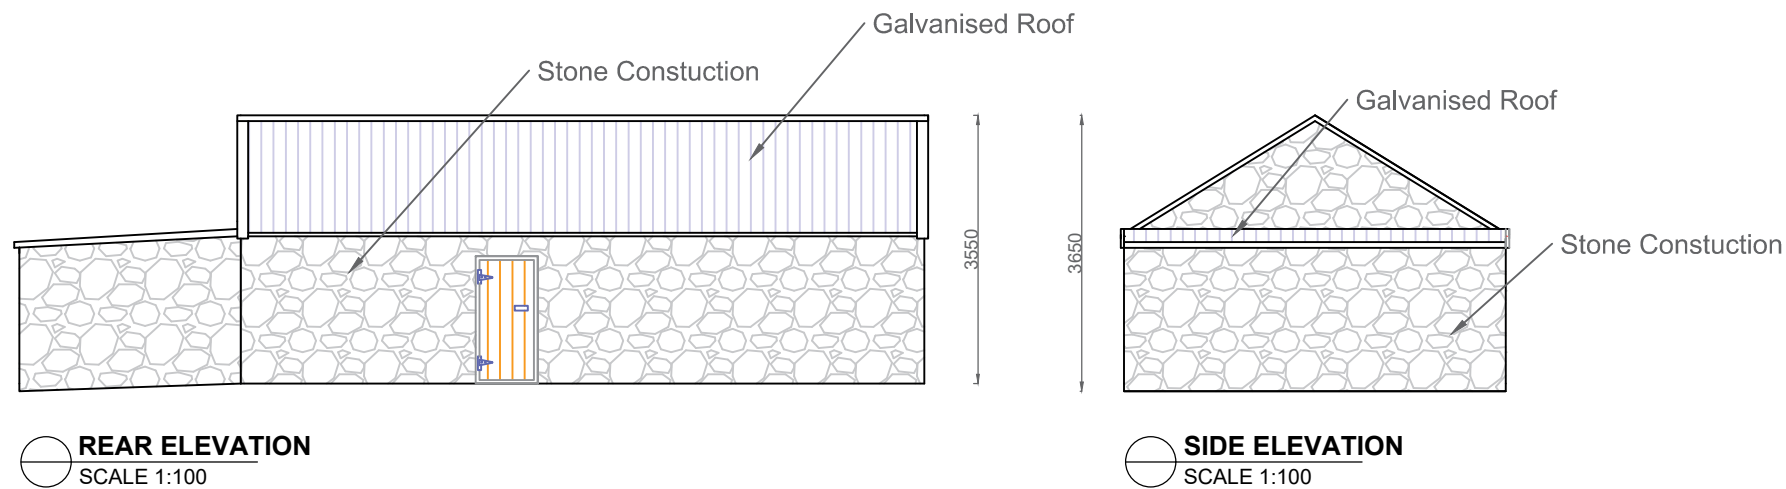


REAR ELEVATION
SCALE 1:100

SIDE ELEVATION
SCALE 1:100

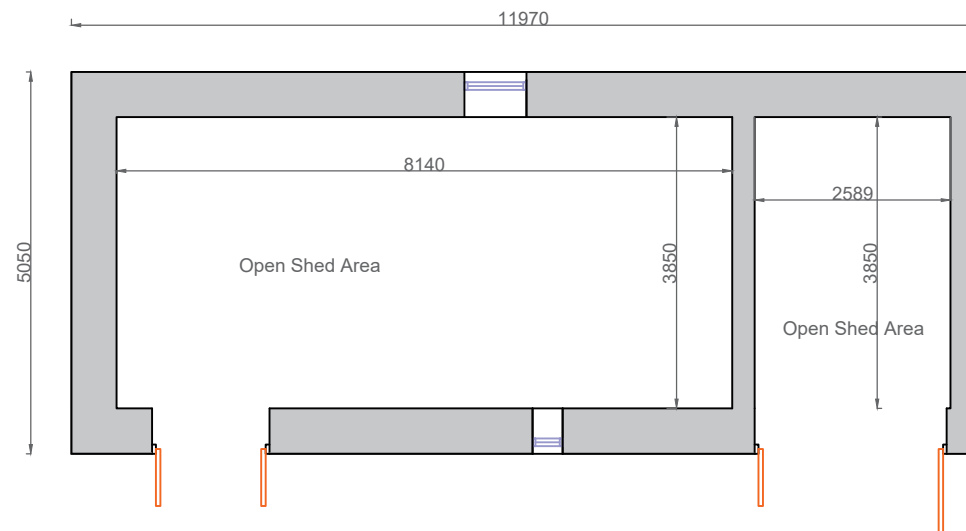

Floor Plans
AREA 45.4 Sqm
SCALE 1:100

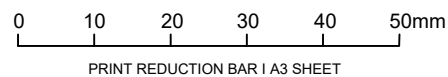

NOTES:
THIS DRAWING AND ANY DESIGN HEREON IS COPYRIGHT AND MUST NOT BE REPRODUCED WITHOUT WRITTEN CONSENT.
DO NOT SCALE FROM DRAWING. USE FIGURED DIMENSIONS ONLY.
ALL DIMENSIONS TO BE CHECKED ON SITE AND ANY DISCREPANCIES REPORTED IMMEDIATELY TO THE ENGINEER BEFORE WORK PROCEEDS. ALL DIMENSIONS IN MM UNLESS STATED.
DRAWINGS ARE FOR PLANNING PURPOSES ONLY AND ARE NOT INTENDED FOR CONSTRUCTION

OMC
Multidisciplinary Building Consultants
Dublin | Galway | Clifden
Telephone: +353 (0) 91 394 185
omcgroup.ie

REV.	AMENDMENT DESCRIPTION	DATE

PROJECT TYTLE: Retention Application at Ballinaboy, Clifden, Co. Galway	DRAWING TITLE: Existing Plans & Elevations as built (Shed)
---	--

CLIENT: Mr. George Melville	DRAWING NO: PP-01.01
DATE: October 2025	DRAWN BY: JB
PROJECT NO.: 1425	CHECKED BY:
SCALE @ A3: 1:100	REVISION: 0