



**FRONT ELEVATION**  
SCALE 1:100

Blue/Black Slates

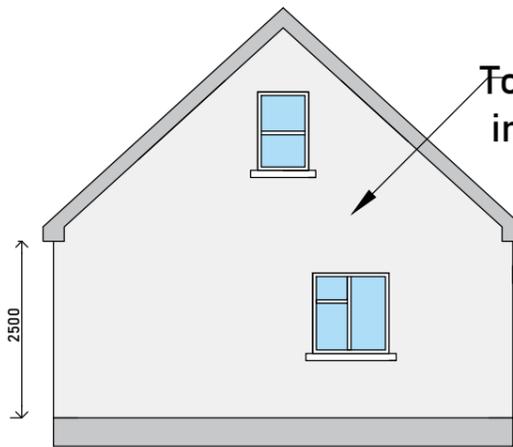


**SIDE ELEVATION**  
SCALE 1:100

To be finished  
in nap plaster

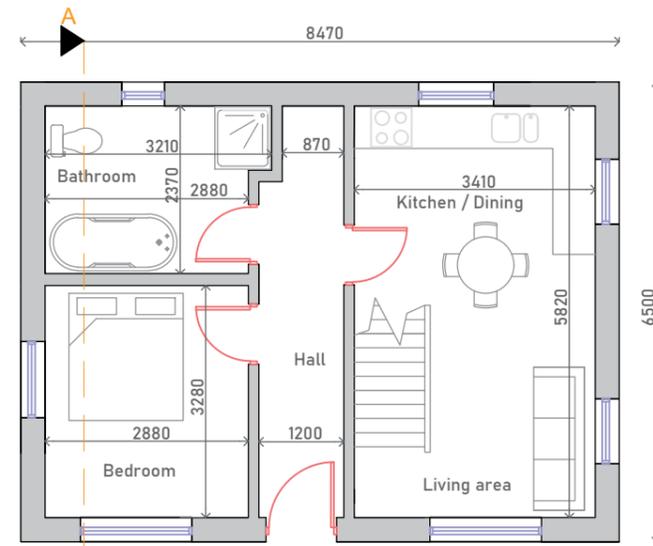


**GROUND FLOOR PLANS**  
SCALE 1:100  
Area 45.3Sqm

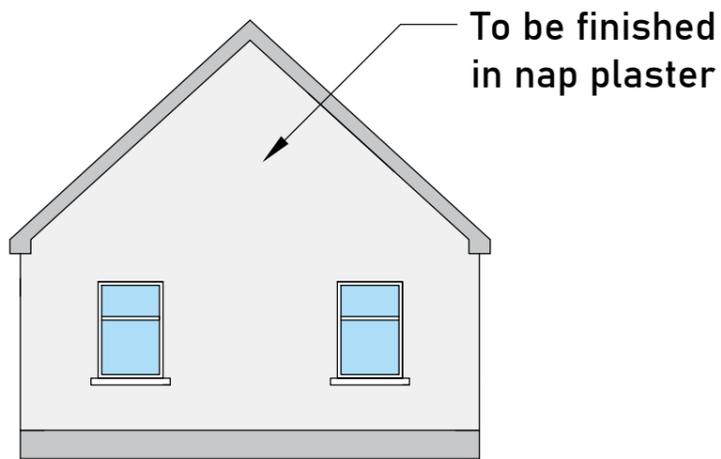


**SIDE ELEVATION**  
SCALE 1:100


To be finished  
in nap plaster

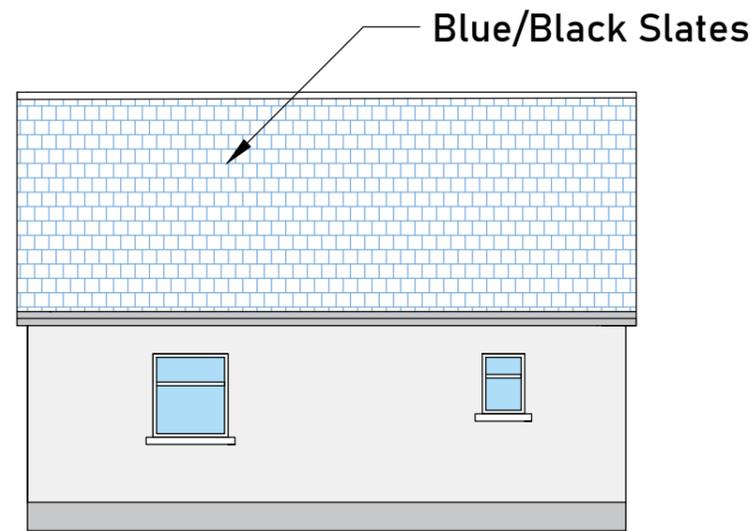


**REAR ELEVATION**  
SCALE 1:100

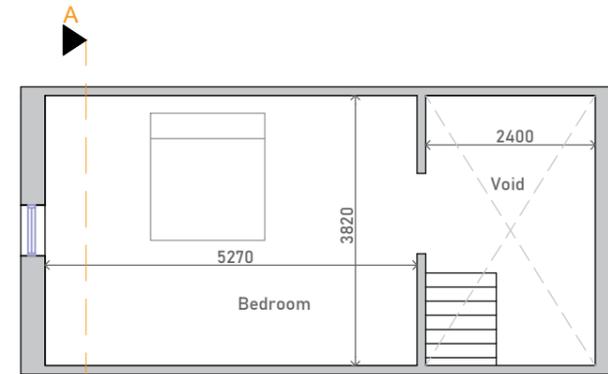

**FIRST FLOOR PLANS**  
SCALE 1:100  
Area 20.1Sqm

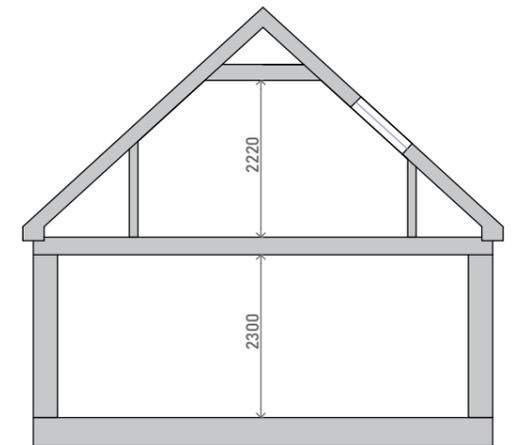

**TYPICAL SECTION A-A**  
See Plans

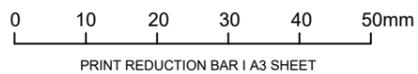

NOTES:  
THIS DRAWING AND ANY DESIGN HEREON IS COPYRIGHT AND MUST NOT BE REPRODUCED WITHOUT WRITTEN CONSENT.  
DO NOT SCALE FROM DRAWING. USE FIGURED DIMENSIONS ONLY.  
ALL DIMENSIONS TO BE CHECKED ON SITE AND ANY DISCREPANCIES REPORTED IMMEDIATELY TO THE ENGINEER BEFORE WORK PROCEEDS. ALL DIMENSIONS IN MM UNLESS STATED.  
DRAWINGS ARE FOR PLANNING PURPOSES ONLY AND ARE NOT INTENDED FOR CONSTRUCTION

**OMC**  
Multidisciplinary Building Consultants  
Dublin | Galway | Clifden  
Telephone: +353 (0) 91 394 185  
omcgroup.ie

REV.	AMENDMENT DESCRIPTION	DATE

PROJECT TITLE: <b>Retention Application at Derrynavglau, Recess, Co. Galway</b>
DRAWING TITLE: <b>Existing Elevations as built</b>

CLIENT: <b>Ann Conroy</b>	DATE: <b>August 2025</b>	DRAWN BY: <b>JB</b>
PROJECT NO.: <b>3501</b>	SCALE @ A3: <b>1:100</b>	CHECKED BY:

DRAWING NO: <b>PP-01</b>
REVISION: <b>0</b>