



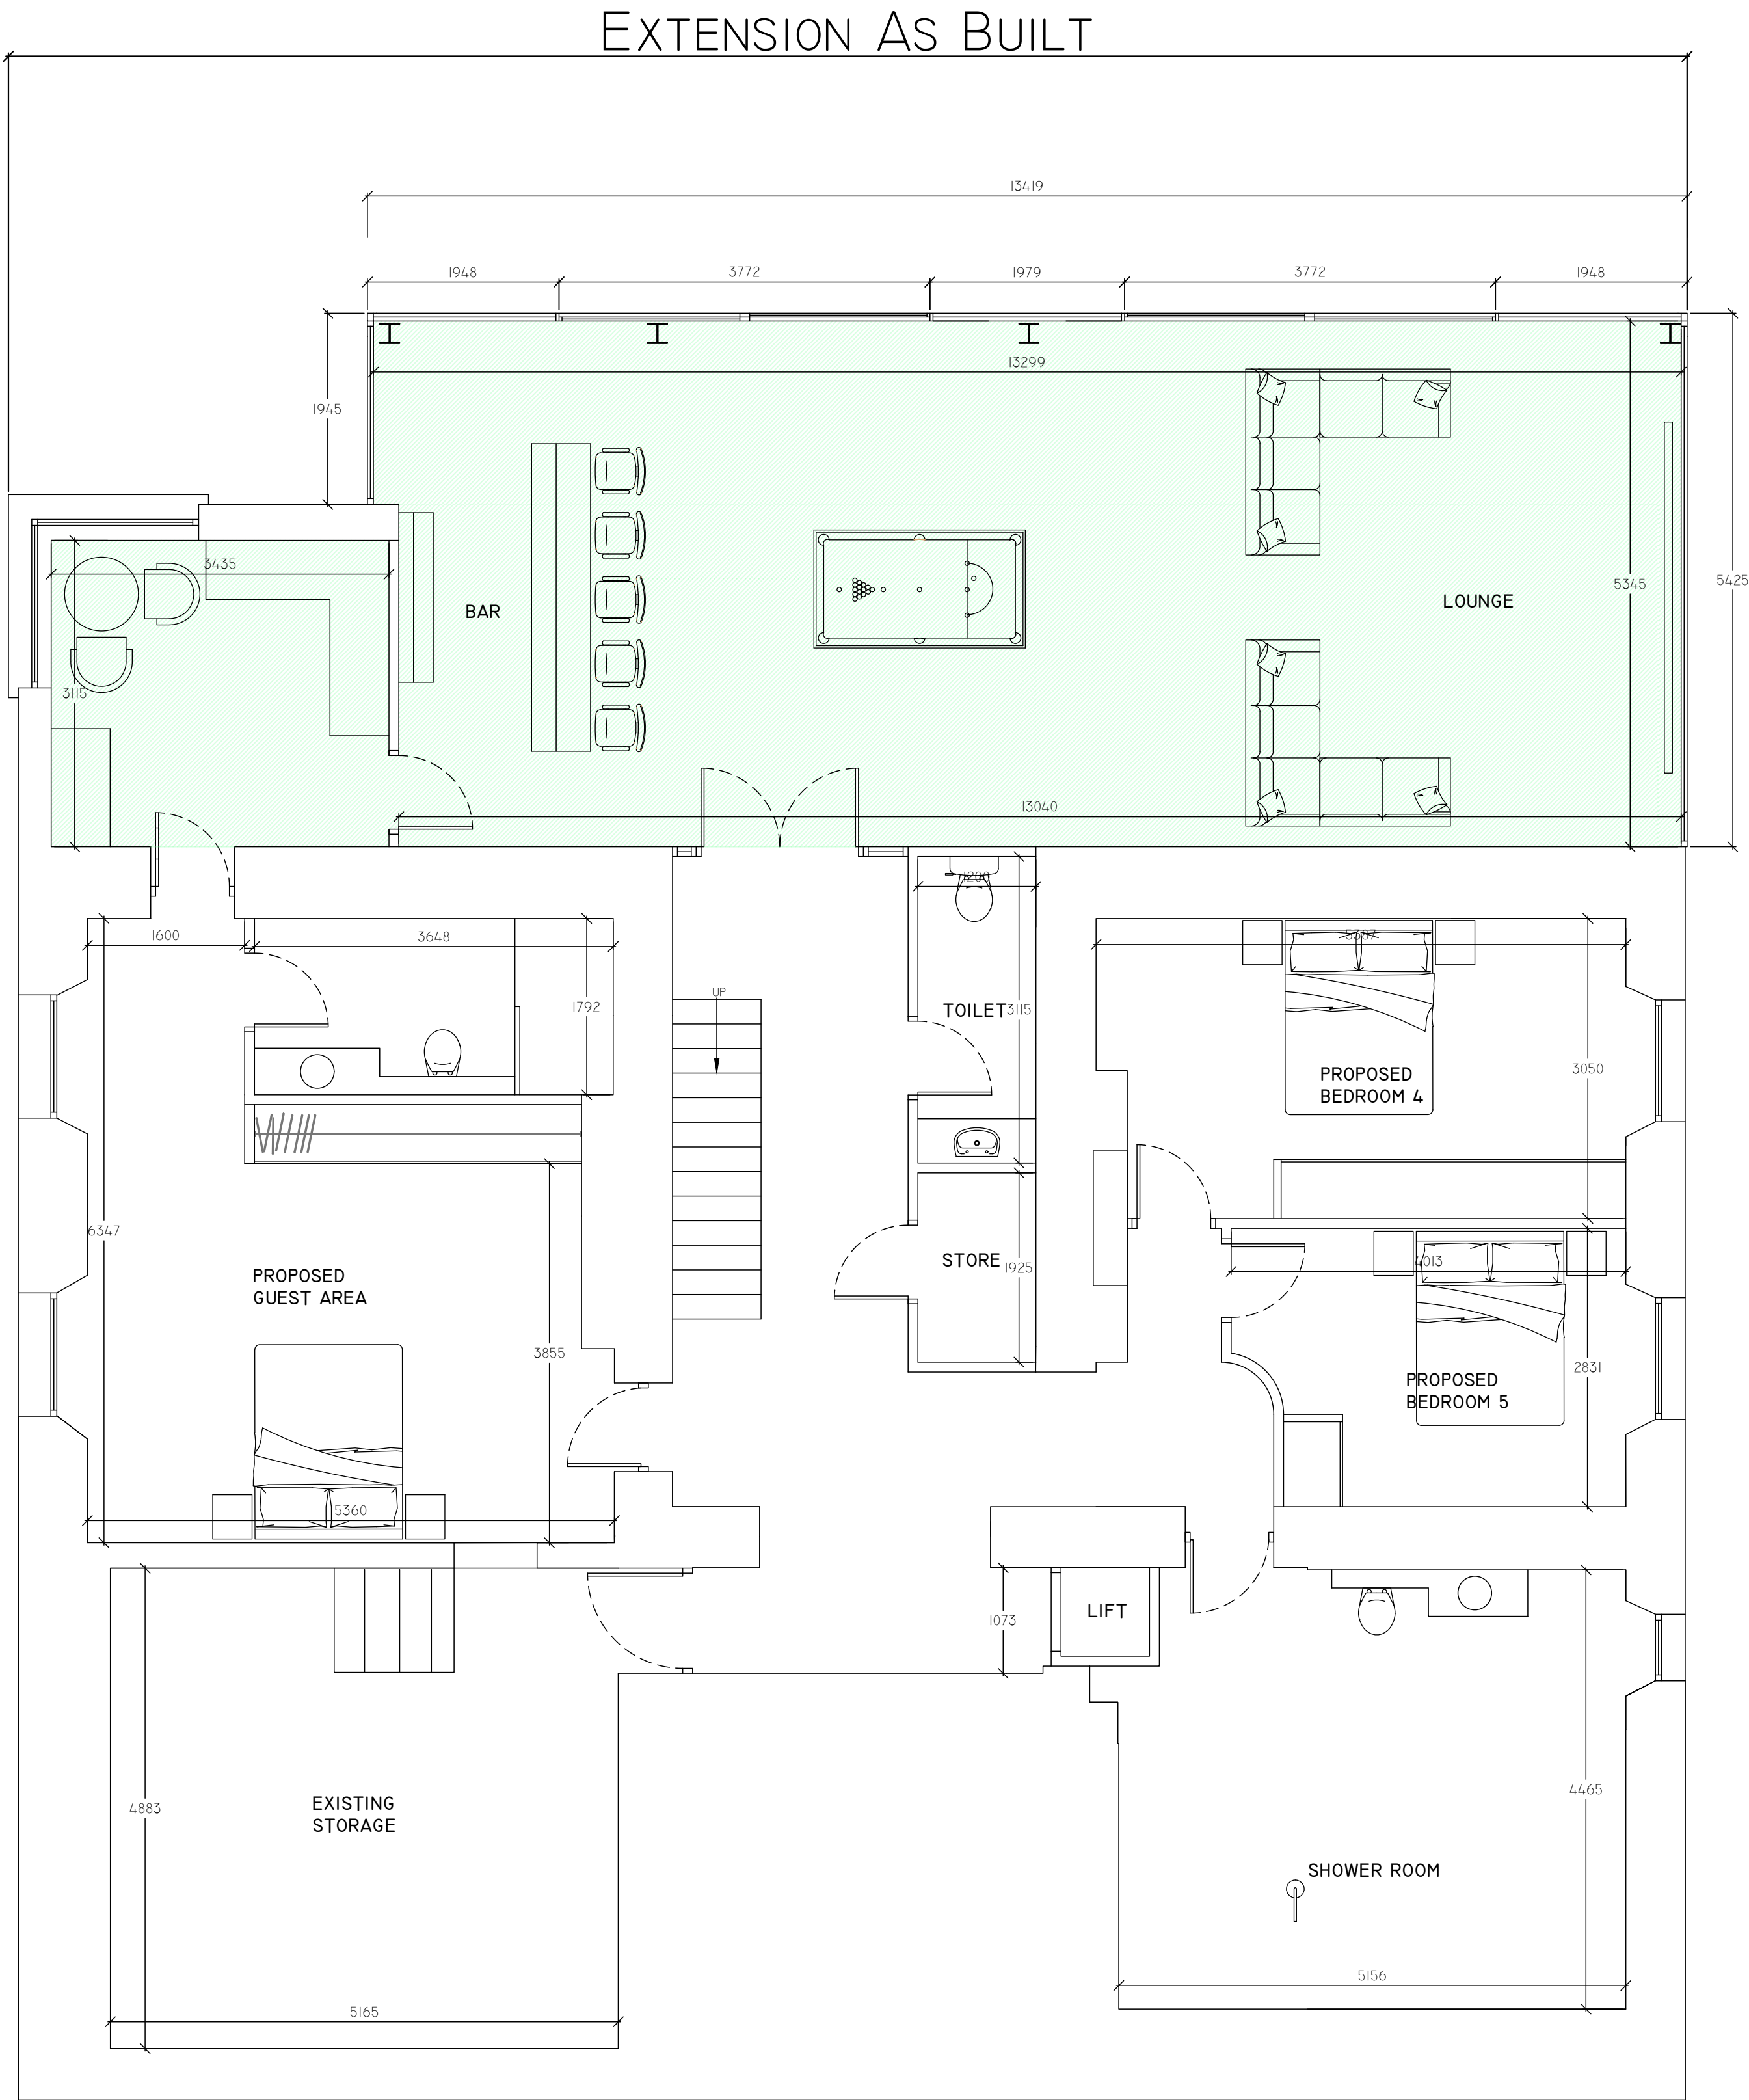

EXTENSION AS BUILT SHOWN THUS

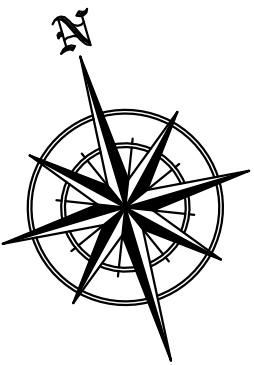

AS BUILT LOWER GROUND FLOOR PLAN
Scale 1 : 50

Rev.	Date	By	Description
Scale	1 : 50		Job Title
Date	DEC. 2025		PROPOSED WORKS AT TARA HALL, BALSADDEN ROAD, HOWTH, CO. DUBLIN
Drawn by	D.C.		Drawing Title
Org. No.	24-1471-07	Rev.	Client
			MR. JOHN ROE

© DaCaD DESIGNS
DESIGN, PLANNING &
FIRE SAFETY CONSULTANTS
55 LUDFORD DRIVE, BALLINTEER, DUBLIN 16.
TEL.:086 8147081
Email-dacaddesigns@gmail.com