



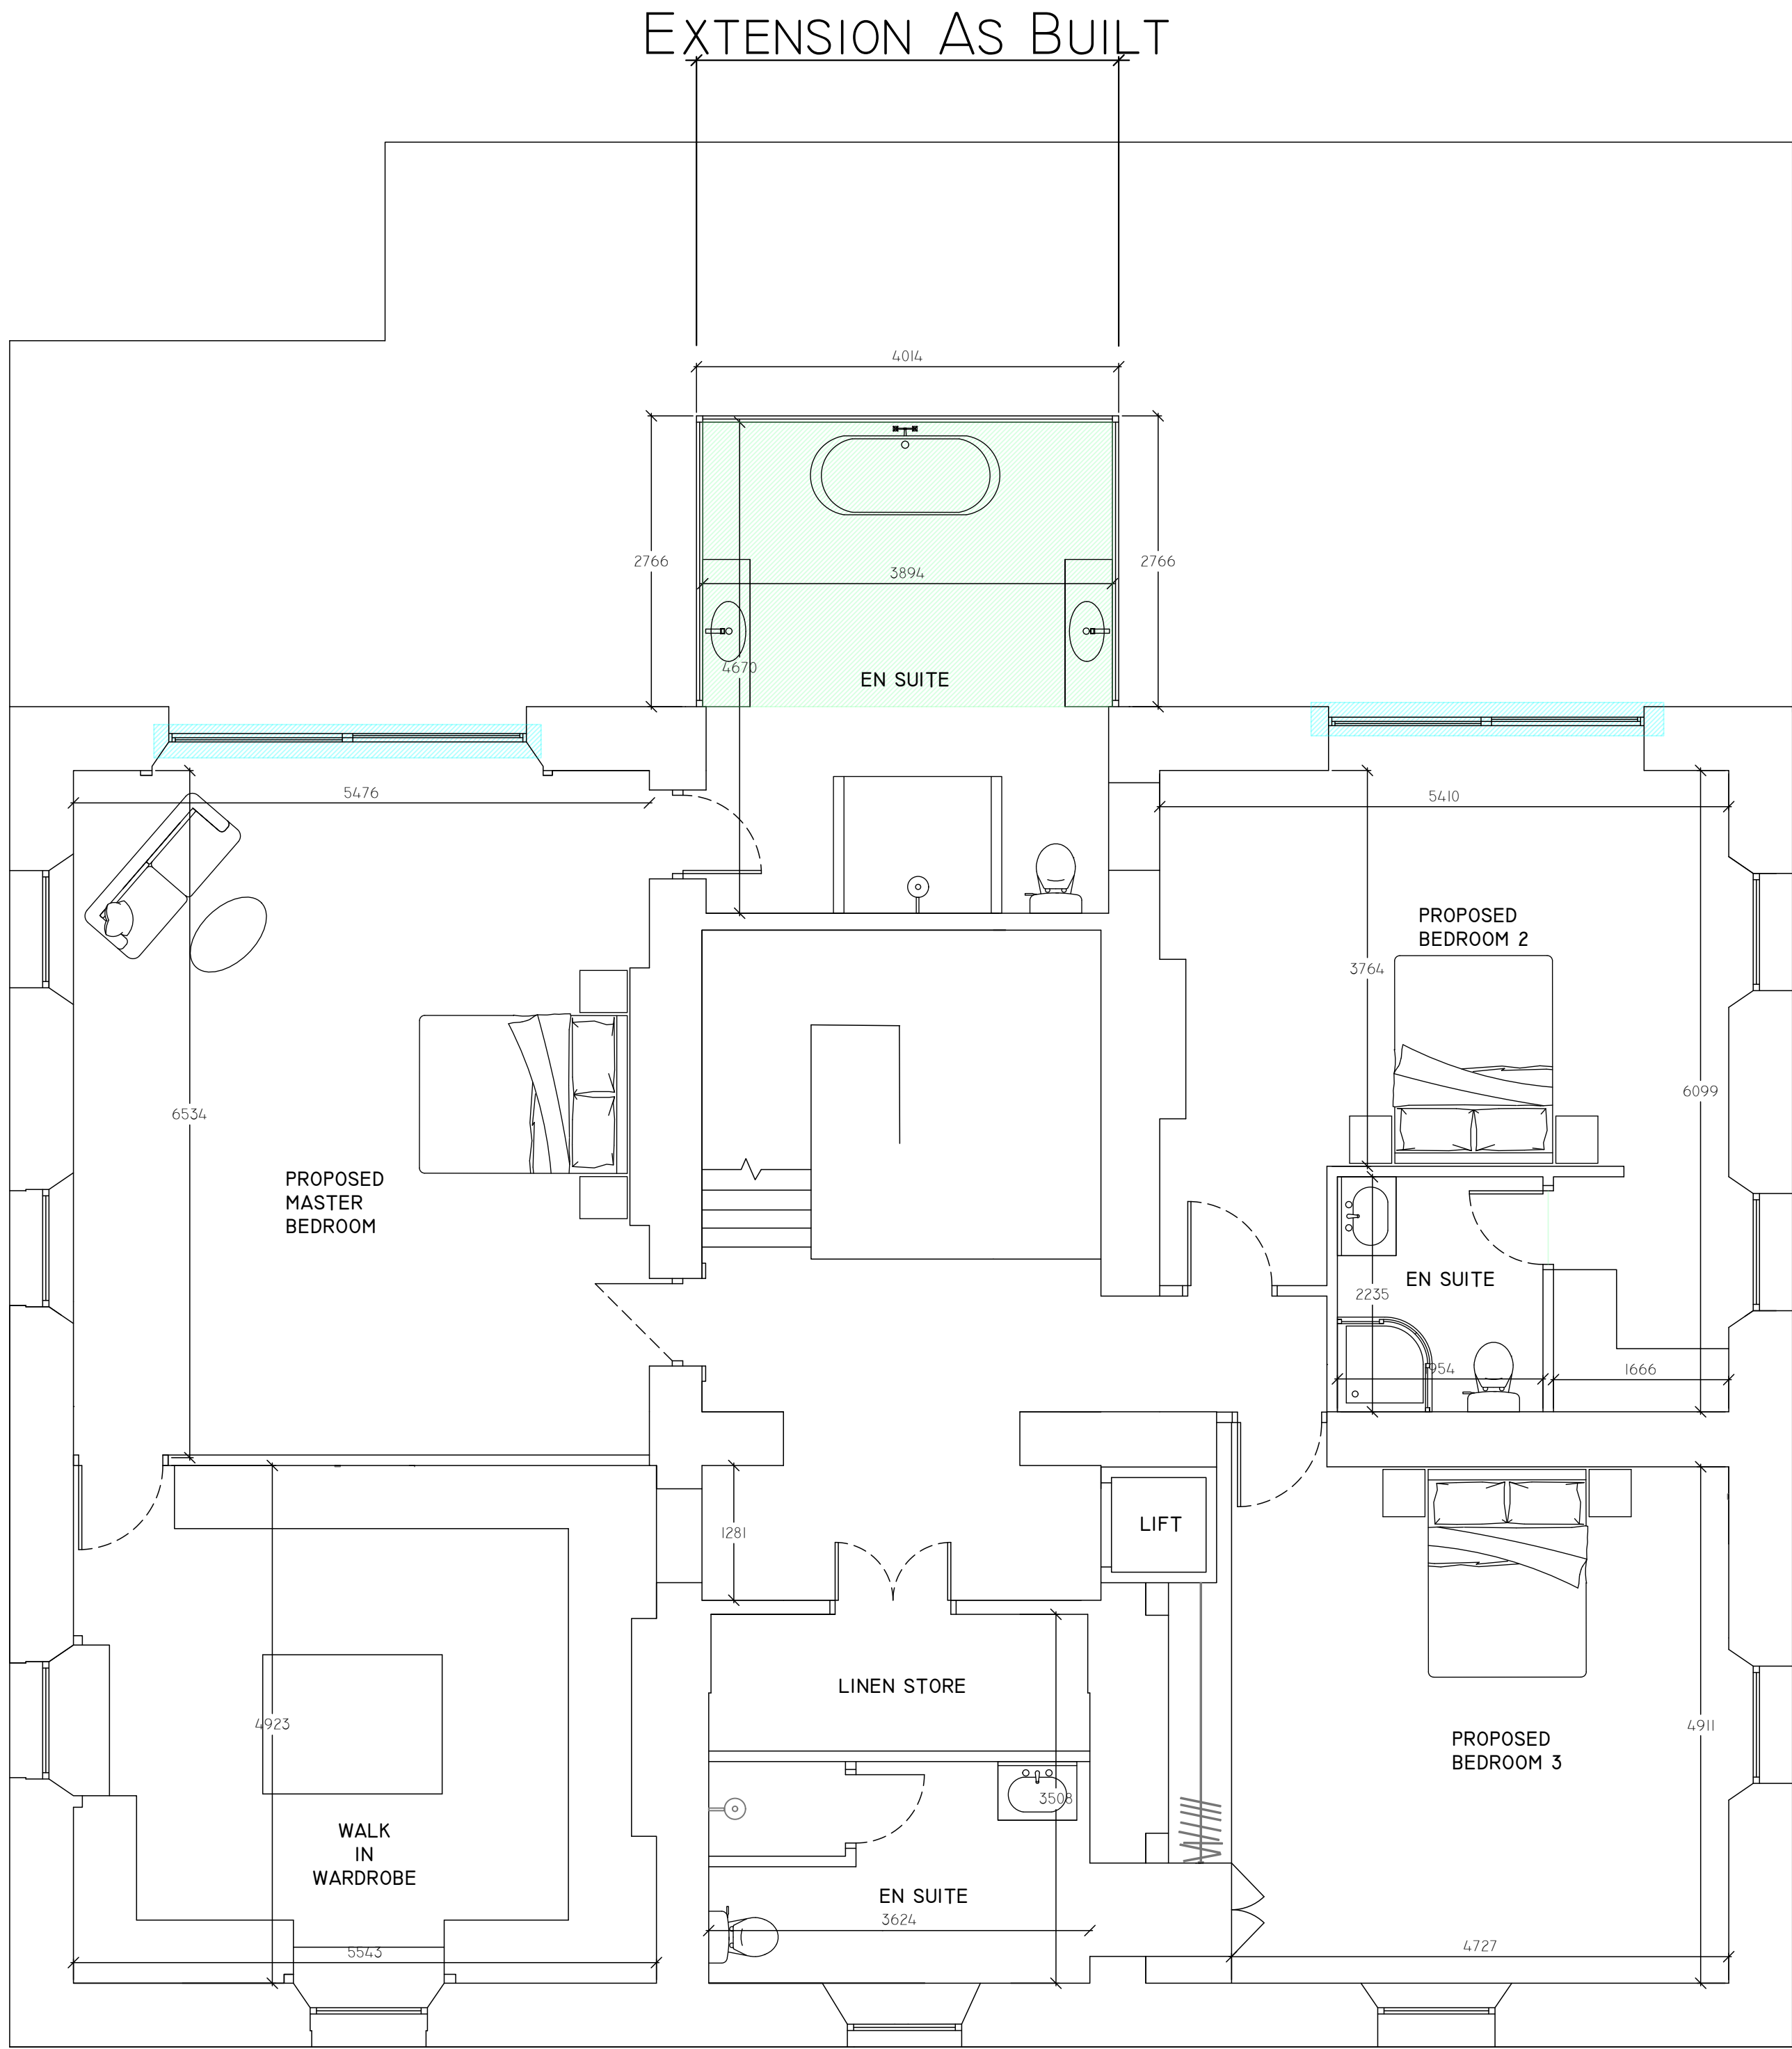

- EXTENSION AS BUILT SHOWN THUS
- NEWLY INSTALLED OPES SHOWN THUS

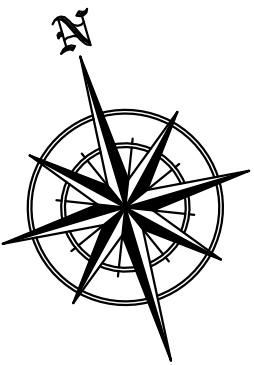

AS BUILT FIRST FLOOR PLAN
Scale 1 : 50

Rev.	Date	By	Description
Scale	1 : 50		Job Title PROPOSED WORKS AT TARA HALL, BALSADDEN ROAD, HOWTH, CO. DUBLIN
Date	DEC. 2025		Drawing Title AS BUILT FIRST FLOOR PLAN
Drawn by	D.C.		Client MR. JOHN ROE
Org. No. 24-1471-09	Rev.		

© DaCaD DESIGNS
DESIGN, PLANNING &
FIRE SAFETY CONSULTANTS
55 LUDFORD DRIVE, BALLINTEER, DUBLIN 16.
TEL:086 8147081
Email-dacaddesigns@gmail.com