


# OS LOCATION MAP

Scale 1:50000

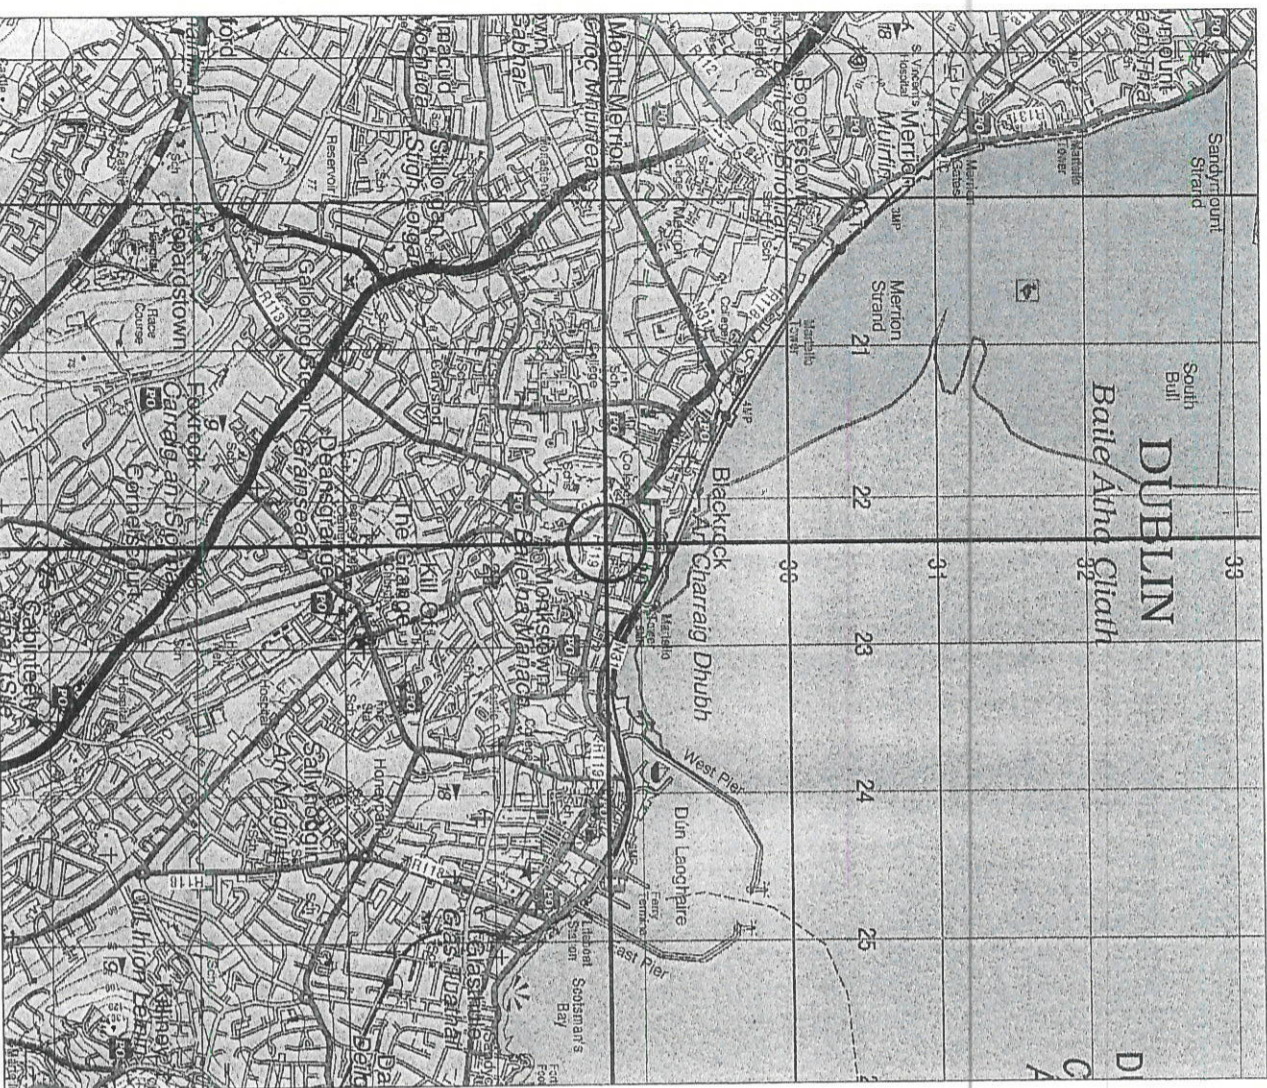

Reproduced from the OS Discovery Map Series 1:50000 under licence No. EN 0023617

Drawing No.	Drawing Title
CIG-DLR / 301	O.S. Location Map & Photos
CIG-DLR / 302	North East Elevation
CIG-DLR / 303	Plan View Elevation
CIG-DLR / 304	Pole Details
CIG-DLR / 305	Cabinet Details

## SITE PHOTOGRAPHS

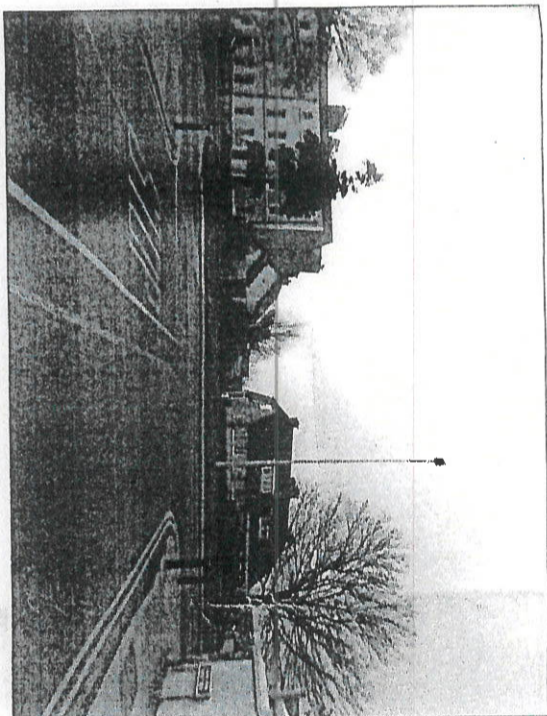


FIG 1. EXISTING ELEVATION

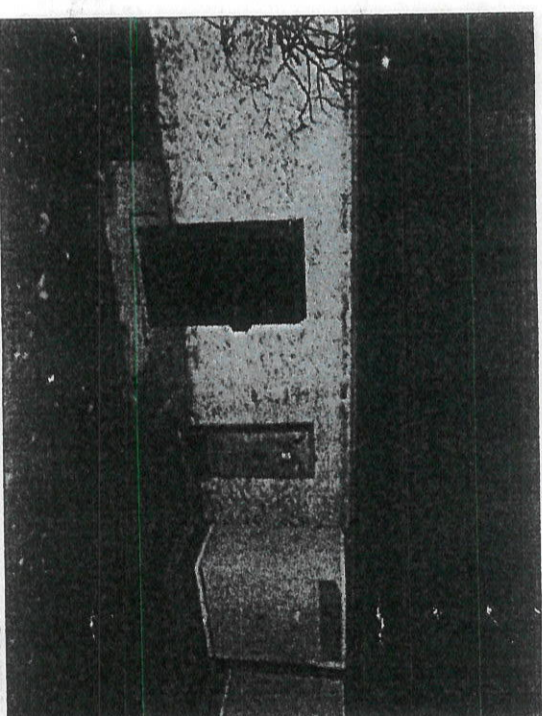


FIG 2. EXISTING SITE LOCATION

- GENERAL NOTES**
1. Do not scale.
  2. All dimensions to be in mm unless specified otherwise.
  3. This drawing need in conjunction with the relevant scope of works and all relevant engineers and specialist drawings.
  4. All works to be in accordance with the relevant and current health and safety legislation.
  5. Specification of the works to be to the appropriate Irish standard or the equivalent British standard.
  6. All works to be carried out in strict accordance with project specifications.

**AN BORD PLEANANN**  
 TIME \_\_\_\_\_ BY \_\_\_\_\_  
 29 AUG 2018  
 LTR DATER \_\_\_\_\_ FROM \_\_\_\_\_  
 PL \_\_\_\_\_

No.	Revision	Date	By	Chk
-	REDUCED AS BUILT ISSUE	12/02/17	TD	ECR
1	Revision	15/12/17	Site App.	pp
2	Revision	15/12/17	Site App.	pp



www.4site.ie

Site Name  
 MONKSTOWN,  
 MONKSTOWN DR.,  
 MONKSTOWN ROAD,  
 Co. DUBLIN

Title  
 O.S. LOCATION MAP  
 AND PHOTOGRAPHS

Issue  
 AS BUILT

Designed	Drawn	Date	Scale
pp	TD	15/12/17	AS SHOWN
Dwg. No.	Rev.		
CIG-DLR-301	-		


**SITE COORDINATES**

ITM. COORDINATE EAST	722 225
ITM. COORDINATE NORTH	728 813
IG. COORDINATE EAST	322 301
IG. COORDINATE NORTH	228 785
ALTITUDE ABOVE SEA LEVEL	
WIND ZONE	24m/5

AN BOARD PLYMOUTH  
11 APR 1988

- GENERAL NOTES**
1. Do not scale.
  2. All dimensions to be in mm unless specified otherwise.
  3. This drawing read in conjunction with the relevant scope of works and all relevant engineers and specialist drawings.
  4. All works to be in accordance with the relevant and current health and safety legislation.
  5. Specification of the works to be to the appropriate Irish standard or the equivalent British standard.
  6. All works to be carried out in strict accordance with project specifications.


**AN BORD PLEANÁLA**  
 TIME \_\_\_\_\_ BY \_\_\_\_\_  
 29 AUG 2018  
 LTR DATER \_\_\_\_\_ FROM \_\_\_\_\_  
 PL \_\_\_\_\_

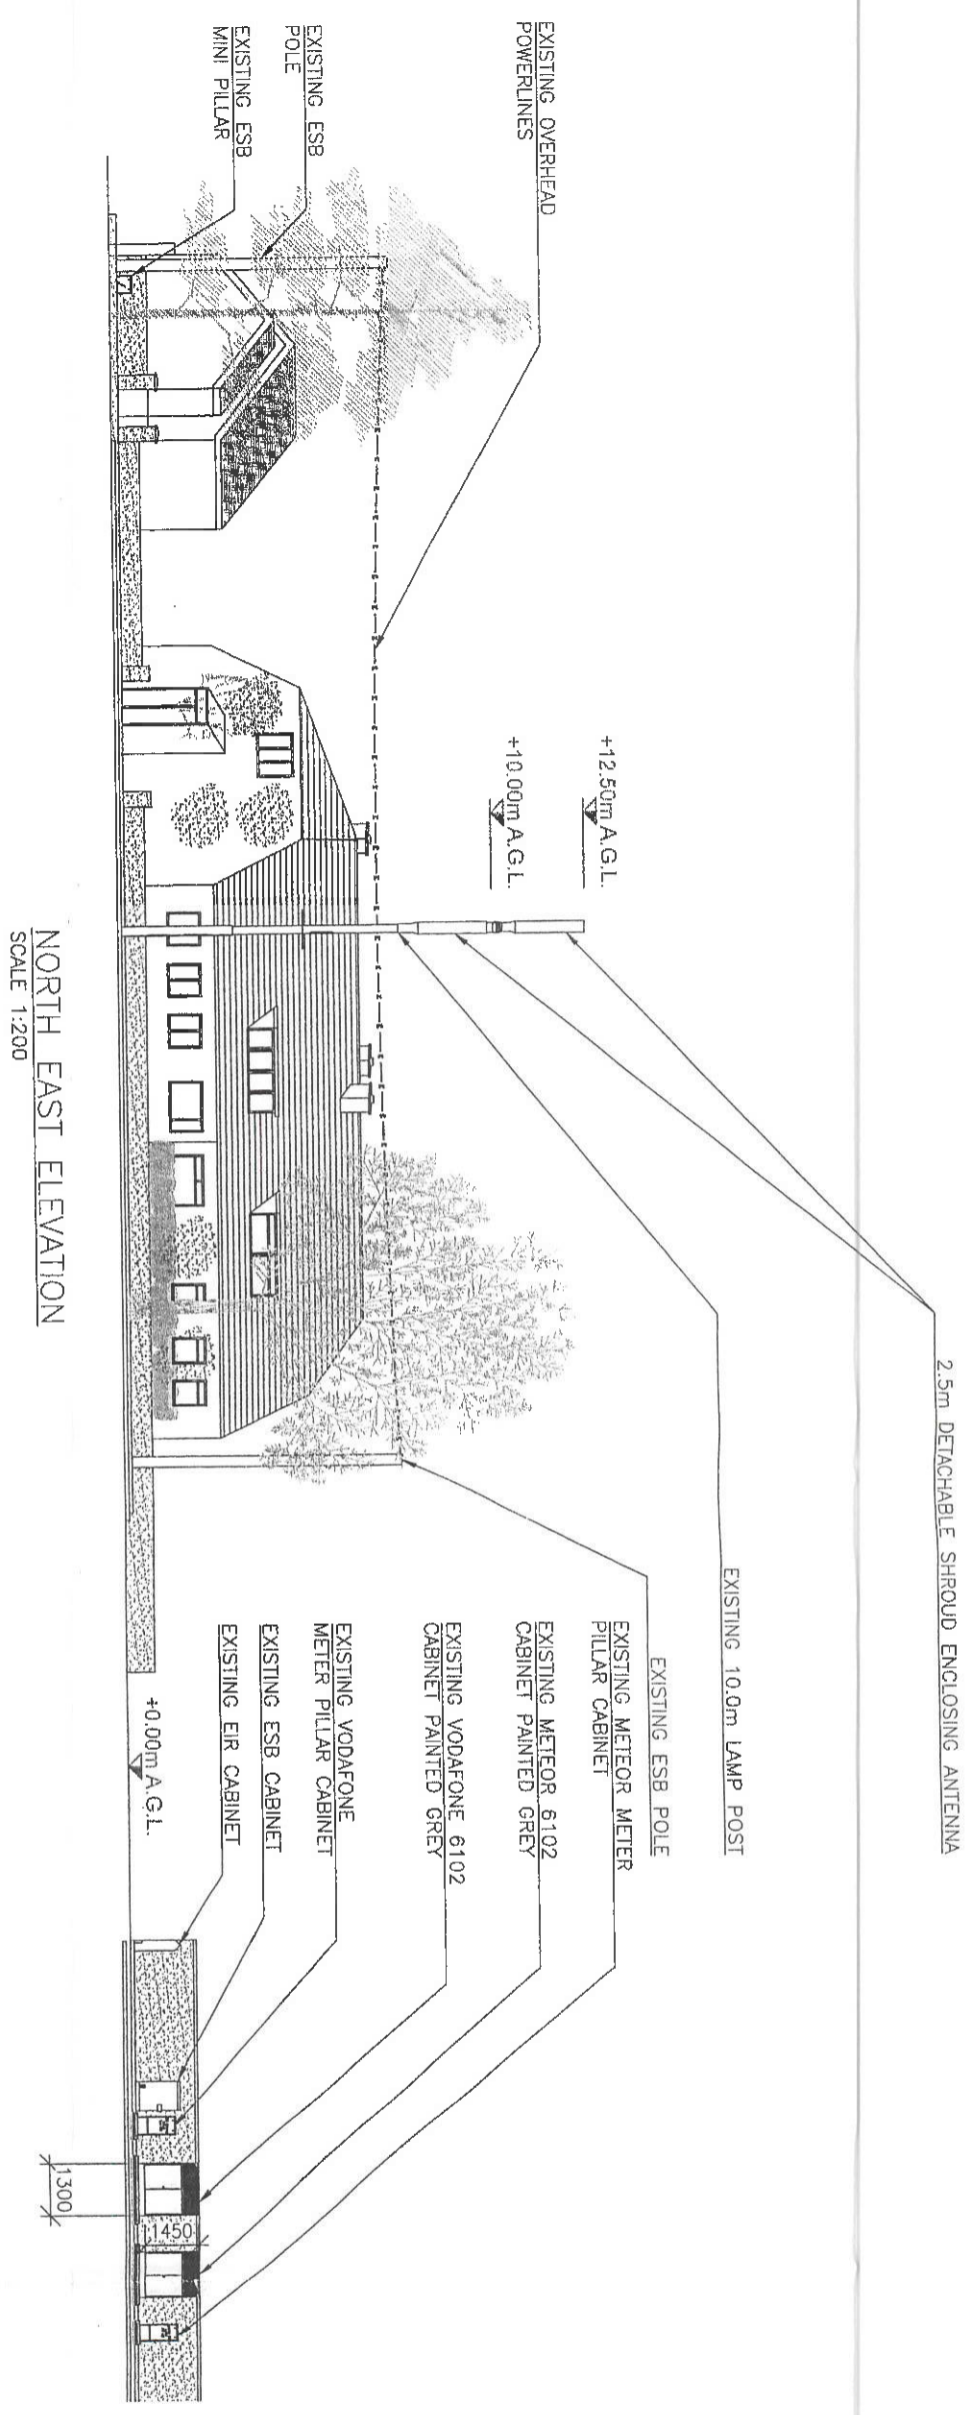

NORTH-EAST ELEVATION  
SCALE 1:200

No.	Revision	Date	By	Chd
-	REDACTED AS BUILT ISSUE	12/02/17	TD	ESR
1	ESR	15/12/17	ESR	ESR

  
**SIGNAL**  
 Clear signal. Everywhere


  
 www.4siteworks.com

Site Code: CIG\_DLR  
 Structure Height: 10m  
 Structure Type: STREET WORKS  
 Base Width: -  
 Site Name: MONKSTOWN, MONKSTOWN DRL, MONKSTOWN ROAD, CO. DUBLIN  
 Title: NORTH-EAST ELEVATION  
 Issue: AS BUILT  
 Designed: PJ  
 Drawn: TD  
 Date: 15/12/17  
 Scale: AS SHOWN  
 Dwg. No.: CIG\_DLR - 302

AM BOLD PTE MANILA  
11 AND 2011

- GENERAL NOTES**
1. Do not scale.
  2. All dimensions to be in mm unless specified otherwise.
  3. This drawing read in conjunction with the relevant scope of works and all relevant engineers and specialist drawings.
  4. All works to be in accordance with the relevant and current health and safety legislation.
  5. Specification of the works to be to the appropriate Irish standard or the equivalent British standard.
  6. All works to be carried out in strict accordance with project specifications.

20

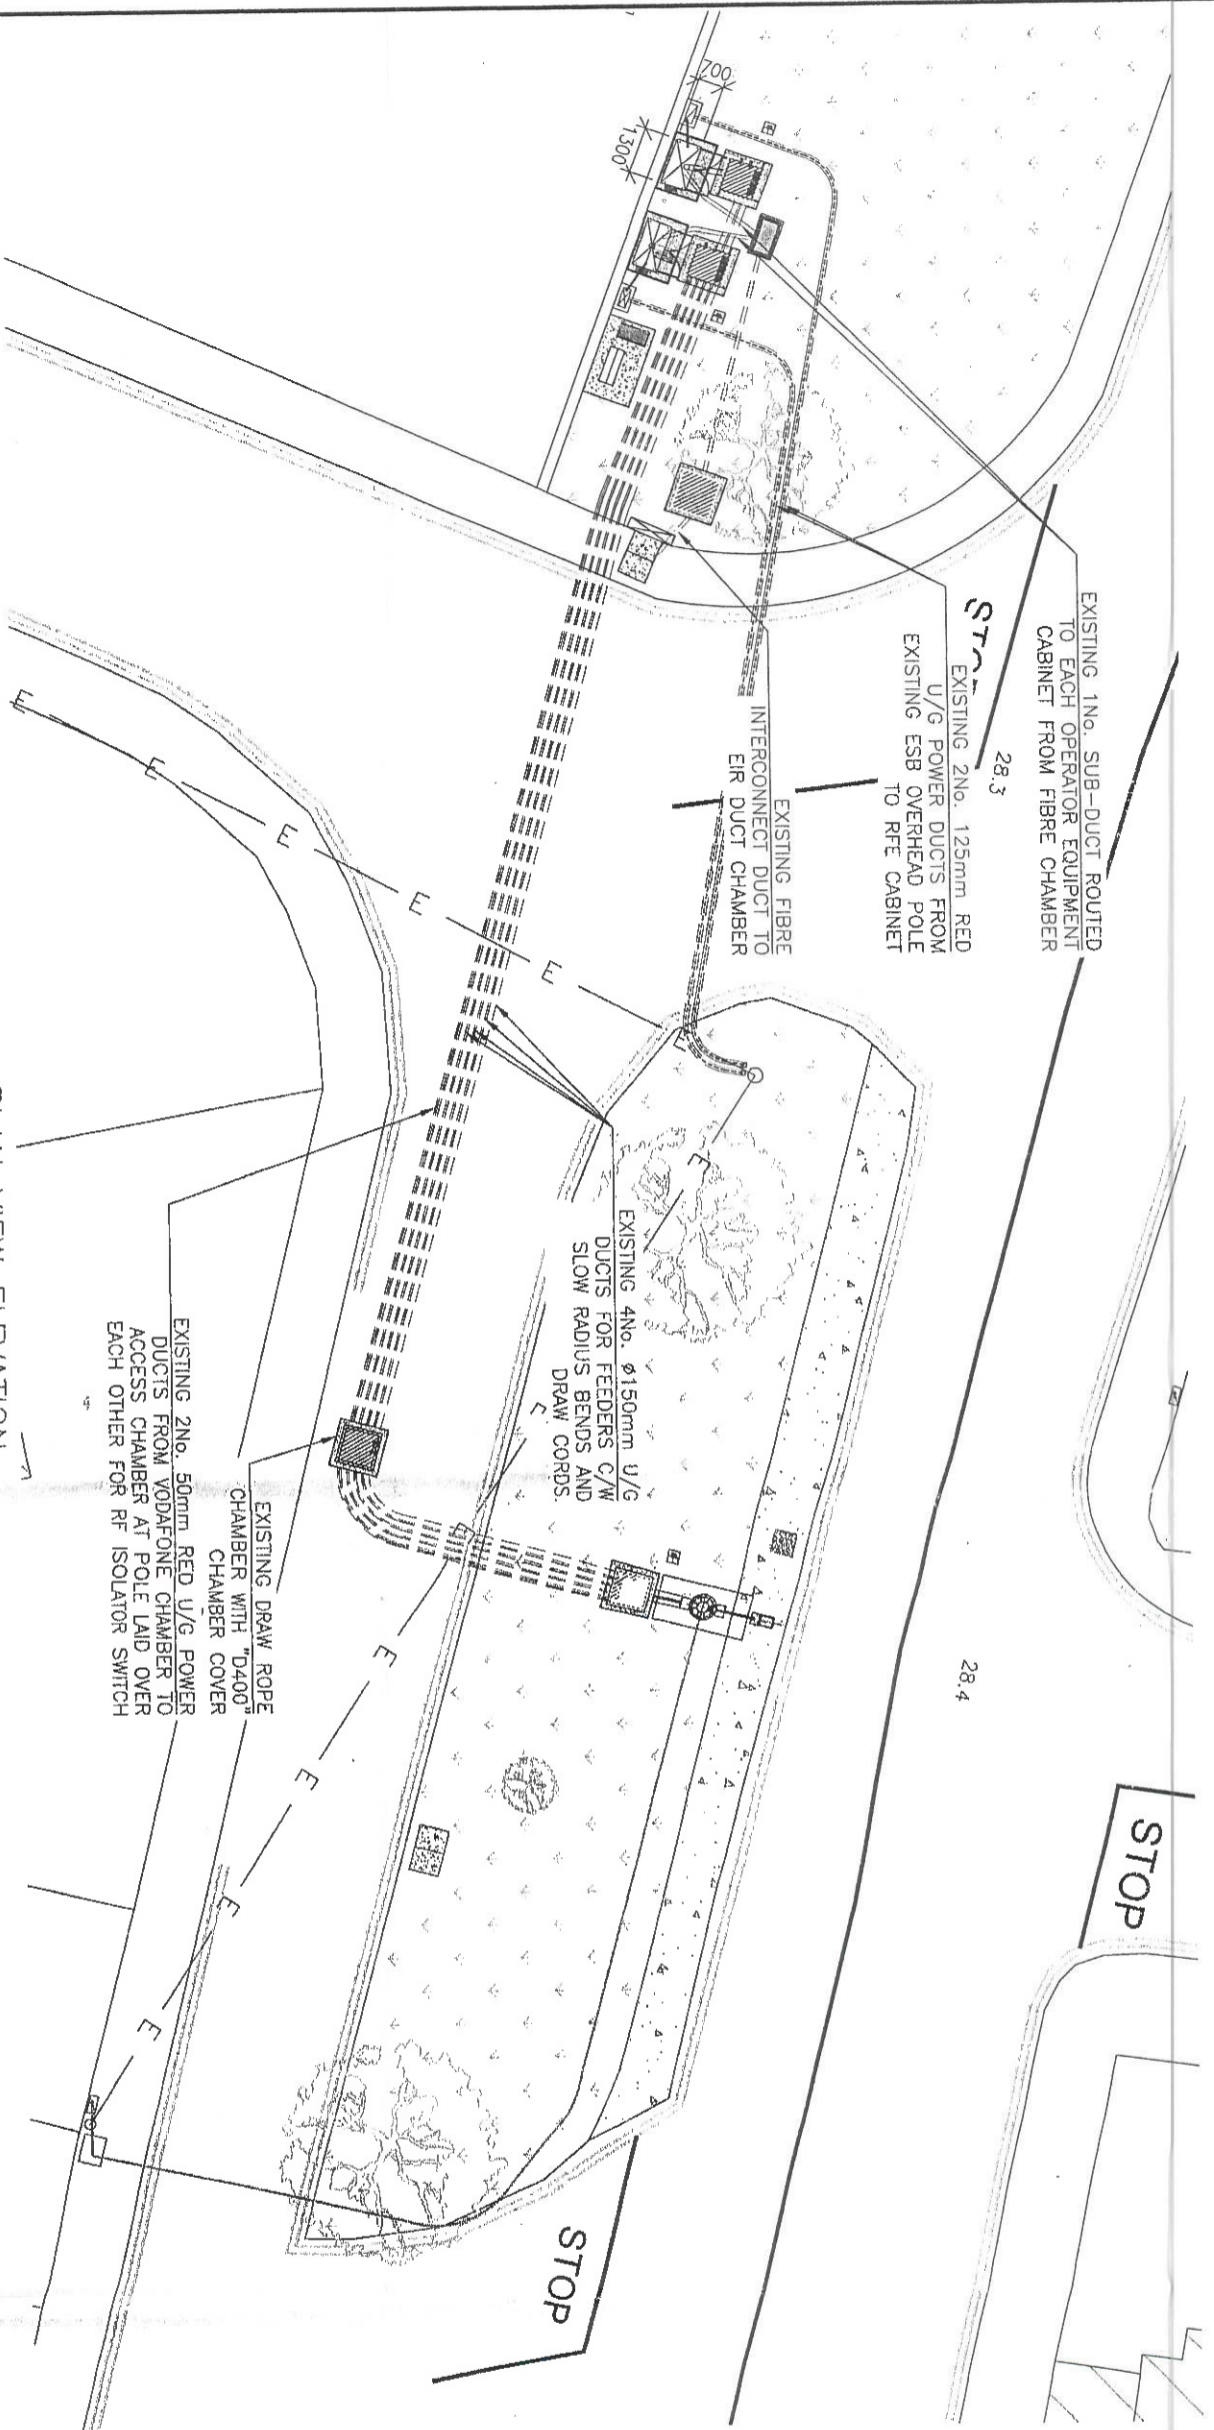

**AN BORD PLEANAL.**  
 TIME BY FROM  
 29 AUG 2018  
 LTR DATER FROM

No.	Revision	Date	By	Ckd
-	REDACTED AS BUILT ISSUE	12/02/17	TD	EBR
451e Cnk.	EBR	15/12/17	451e Apr.	PD
		15/12/17		




Site Code	CIG-DLR
Structure Height	10m
Structure Type	STREET WORKS
Base Width	-
Site Name	MONKSTOWN, MONKSTOWN, DRL, MONKSTOWN ROAD, Co. DUBLIN
Title	PLAN VIEW ELEVATION
Issue	AS BUILT
Designed	PD
Drawn	TD
Date	15/12/17
Scale	AS SHOWN
Draw. No.	CIG-DLR - 303
Rev.	-

MA GROS 19/10/16  
13 YUN  
JUN 1 1916  
JUN 1 1916


- GENERAL NOTES**
1. Do not scale.
  2. All dimensions to be in mm unless specified otherwise.
  3. This drawing used in conjunction with the relevant scope of works and all relevant engineers and specialist drawings.
  4. All works to be in accordance with the relevant and current health and safety legislation.
  5. Specification of the works to be to the appropriate Irish standard or the equivalent British standard.
  6. All works to be carried out in strict accordance with project specifications.

**AN BORD PLEANÁLA**  
 TIME \_\_\_\_\_ BY \_\_\_\_\_  
 29 AUG 2018  
 LTR DATER \_\_\_\_\_ FROM \_\_\_\_\_  
 PL \_\_\_\_\_

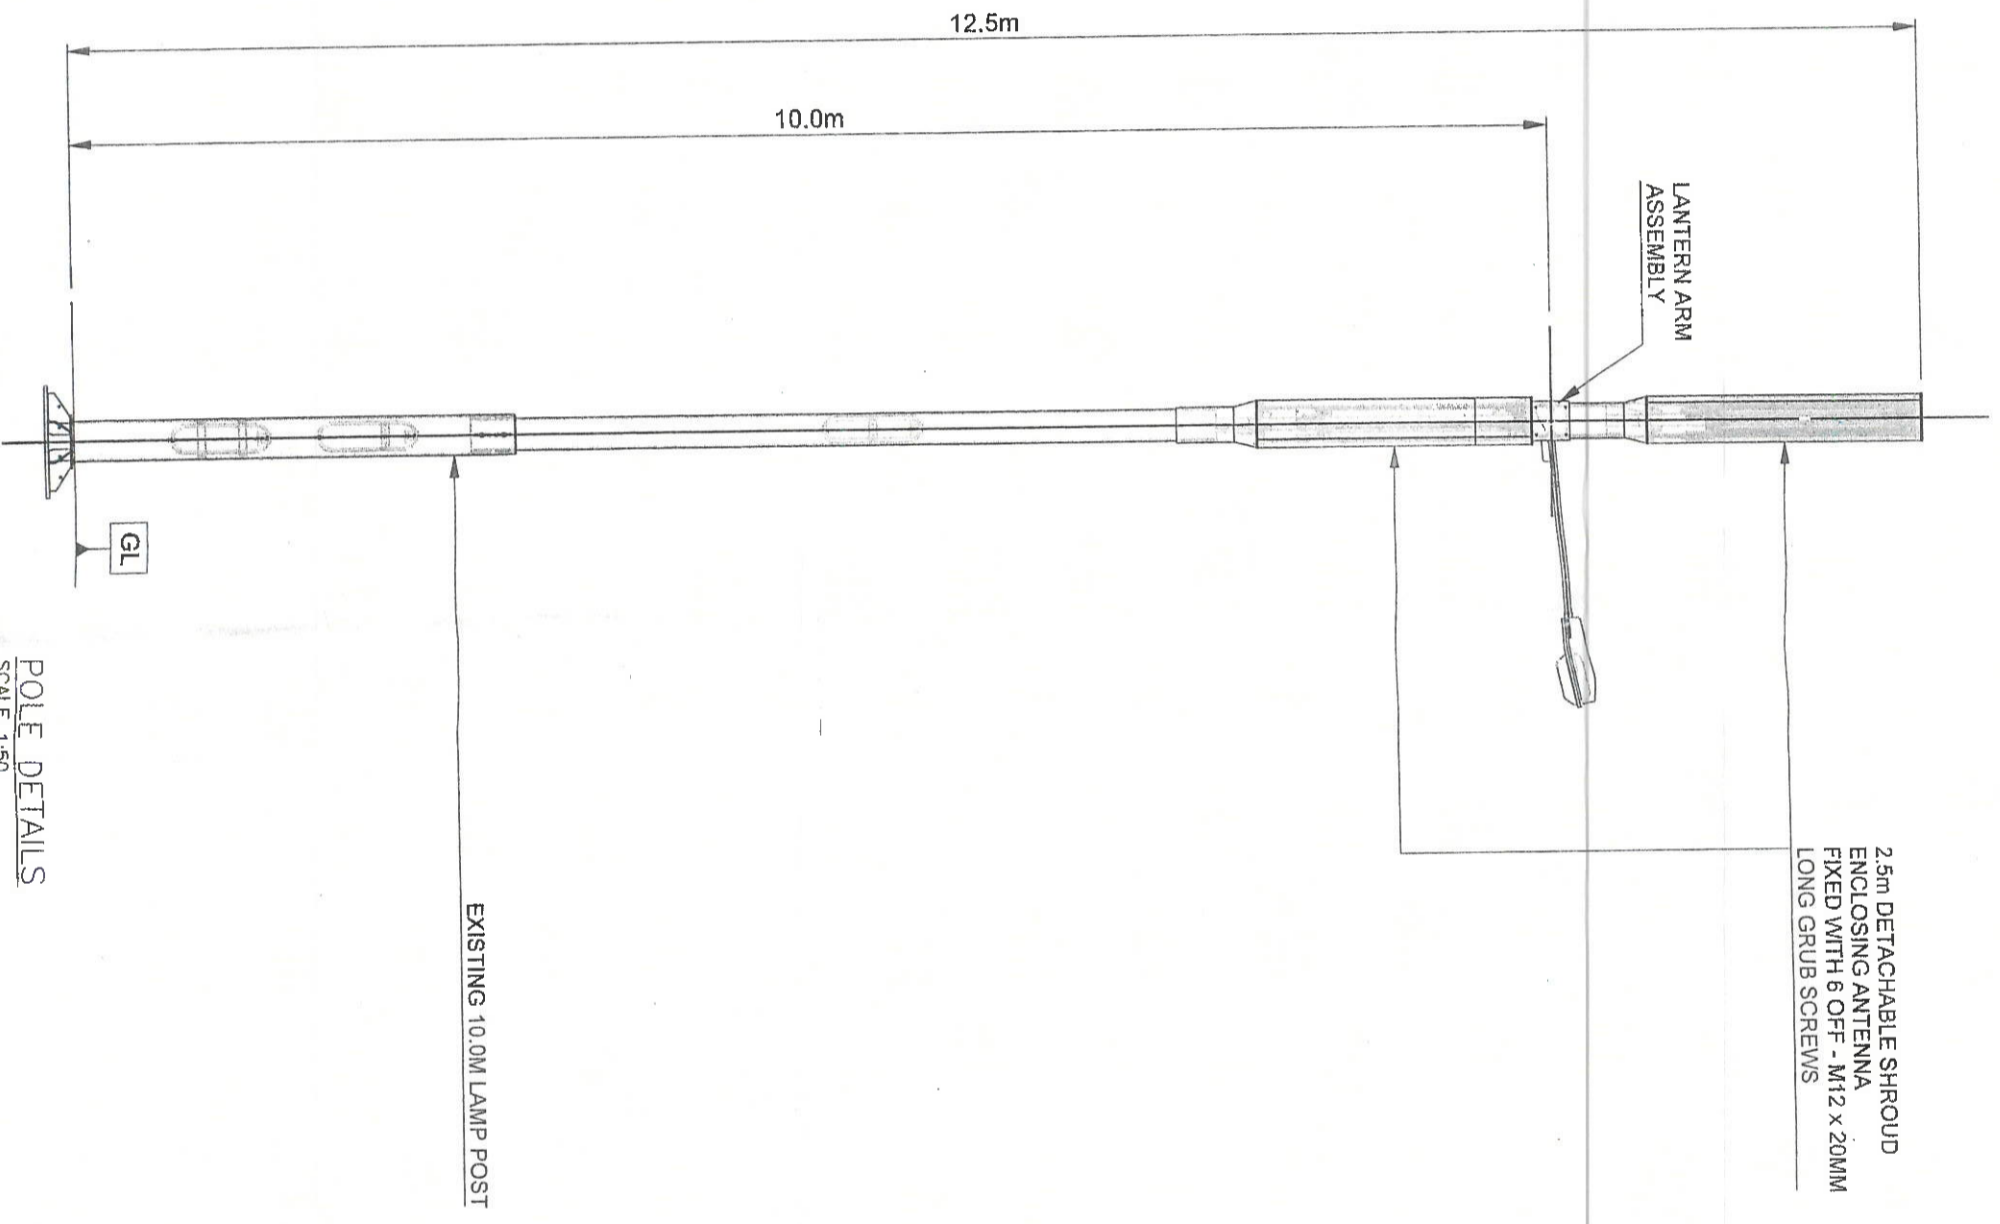

No.	Revision	Date	By	Ctd
-	REDACTED AS BUILT ISSUE	12/02/17	TD	EGR
4516	CHK	15/12/17	Site Appr.	15/12/17

  
**SIGNAL**  
 Clear signal. Everywhere

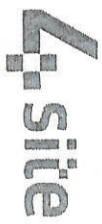  
 www.4site.ie  
 www.4site.ie/works/0271

Site Code: CIG\_DLR  
 Structure Height: 10m  
 Structure Type: STREET WORKS  
 Base Width: \_\_\_\_\_

Site Name:  
 MONKSTOWN,  
 MONKSTOWN DRL,  
 MONKSTOWN ROAD,  
 Co. DUBLIN

Title: POLE DETAILS  
 Issue: AS BUILT  
 Designed: PD  
 Drawn: TD  
 Date: 15/12/17  
 Scale: AS SHOWN  
 Dwg. No.: CIG\_DLR - 304

THIS DRAWING IS THE PROPERTY OF SIGNAL. AND MUST NOT BE COPIED, TRACED OR REPRODUCED WITHOUT THEIR PERMISSION

POLE DETAILS  
 SCALE 1:50


PC  
FEB 19 2018  
11 11 AM '18  
AIR BOARD PL/ENAN/CA




**GENERAL NOTES**

1. Do not scale.
2. All dimensions to be in mm unless specified otherwise.
3. This drawing read in conjunction with the relevant scope of works and all relevant engineers and specialist drawings.
4. All works to be in accordance with the relevant and current health and safety legislation.
5. Specification of the works to be to the appropriate Irish standard or the equivalent British standard.
6. All works to be carried out in strict accordance with project specifications.


20

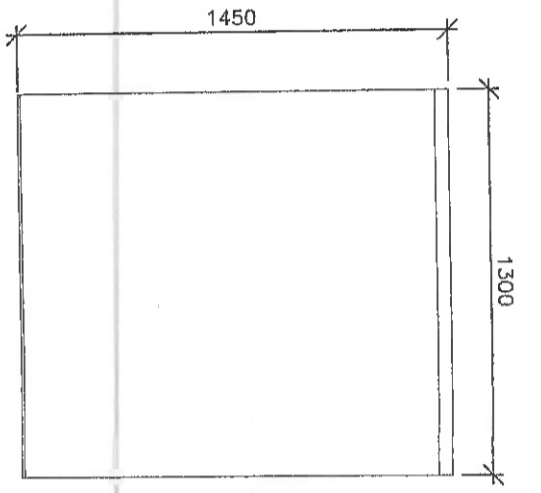


REAR ELEVATION

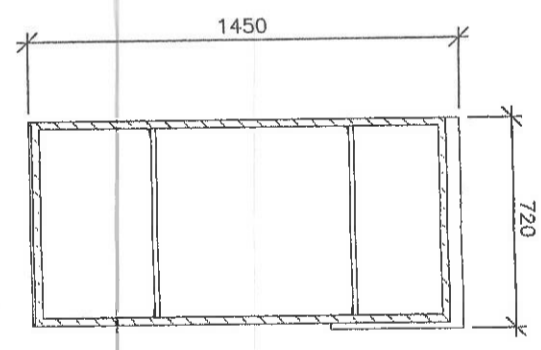


SECTION THRU

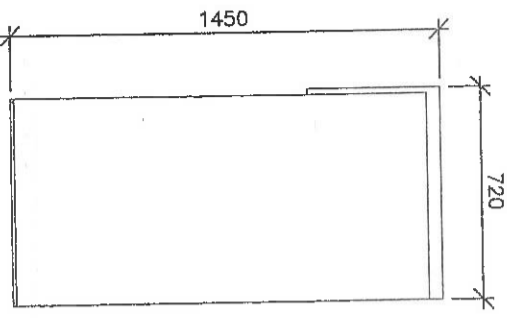


SIDE VIEW 1

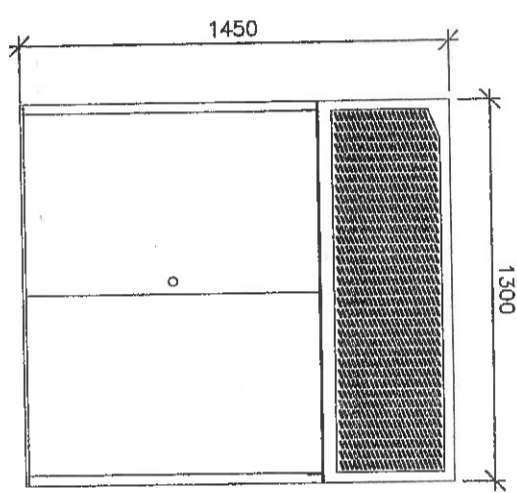

FRONT ELEVATION

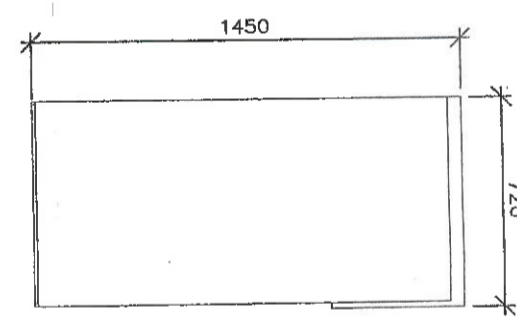

SIDE VIEW 2

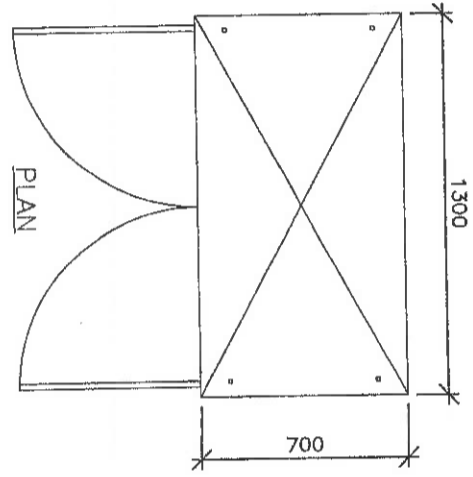

PLAN

**CABINET DETAILS**  
SCALE 1:25

**AN BORD PLEAIN**  
 TIME BY  
**29 AUG 2018**  
 LTR DATER FROM

No.	Revision	Date	By	Old
-	REDACTED AS BUILT ISSUE	12/02/17	TD	EGR
1	AS BUILT	15/12/17	PO	Date
2	15/12/17	15/12/17	PO	15/12/17



www.4siteworks.com

Site Code	CIG_DLR
Structure Height	10m
Structure Type	STREET WORKS
Base Width	-

Site Name  
 MONKSTOWN,  
 MONKSTOWN DRL,  
 MONKSTOWN ROAD,  
 Co. DUBLIN

Title	CABINET DETAILS
Issue	AS BUILT
Designed	PO
Drawn	TD
Date	15/12/17
Scale	AS SHOWN
Rev.	-
Dep. No.	CIG_DLR - 305

10/10/2010

AM BOARD PTE 10/10/2010

10/10/2010