


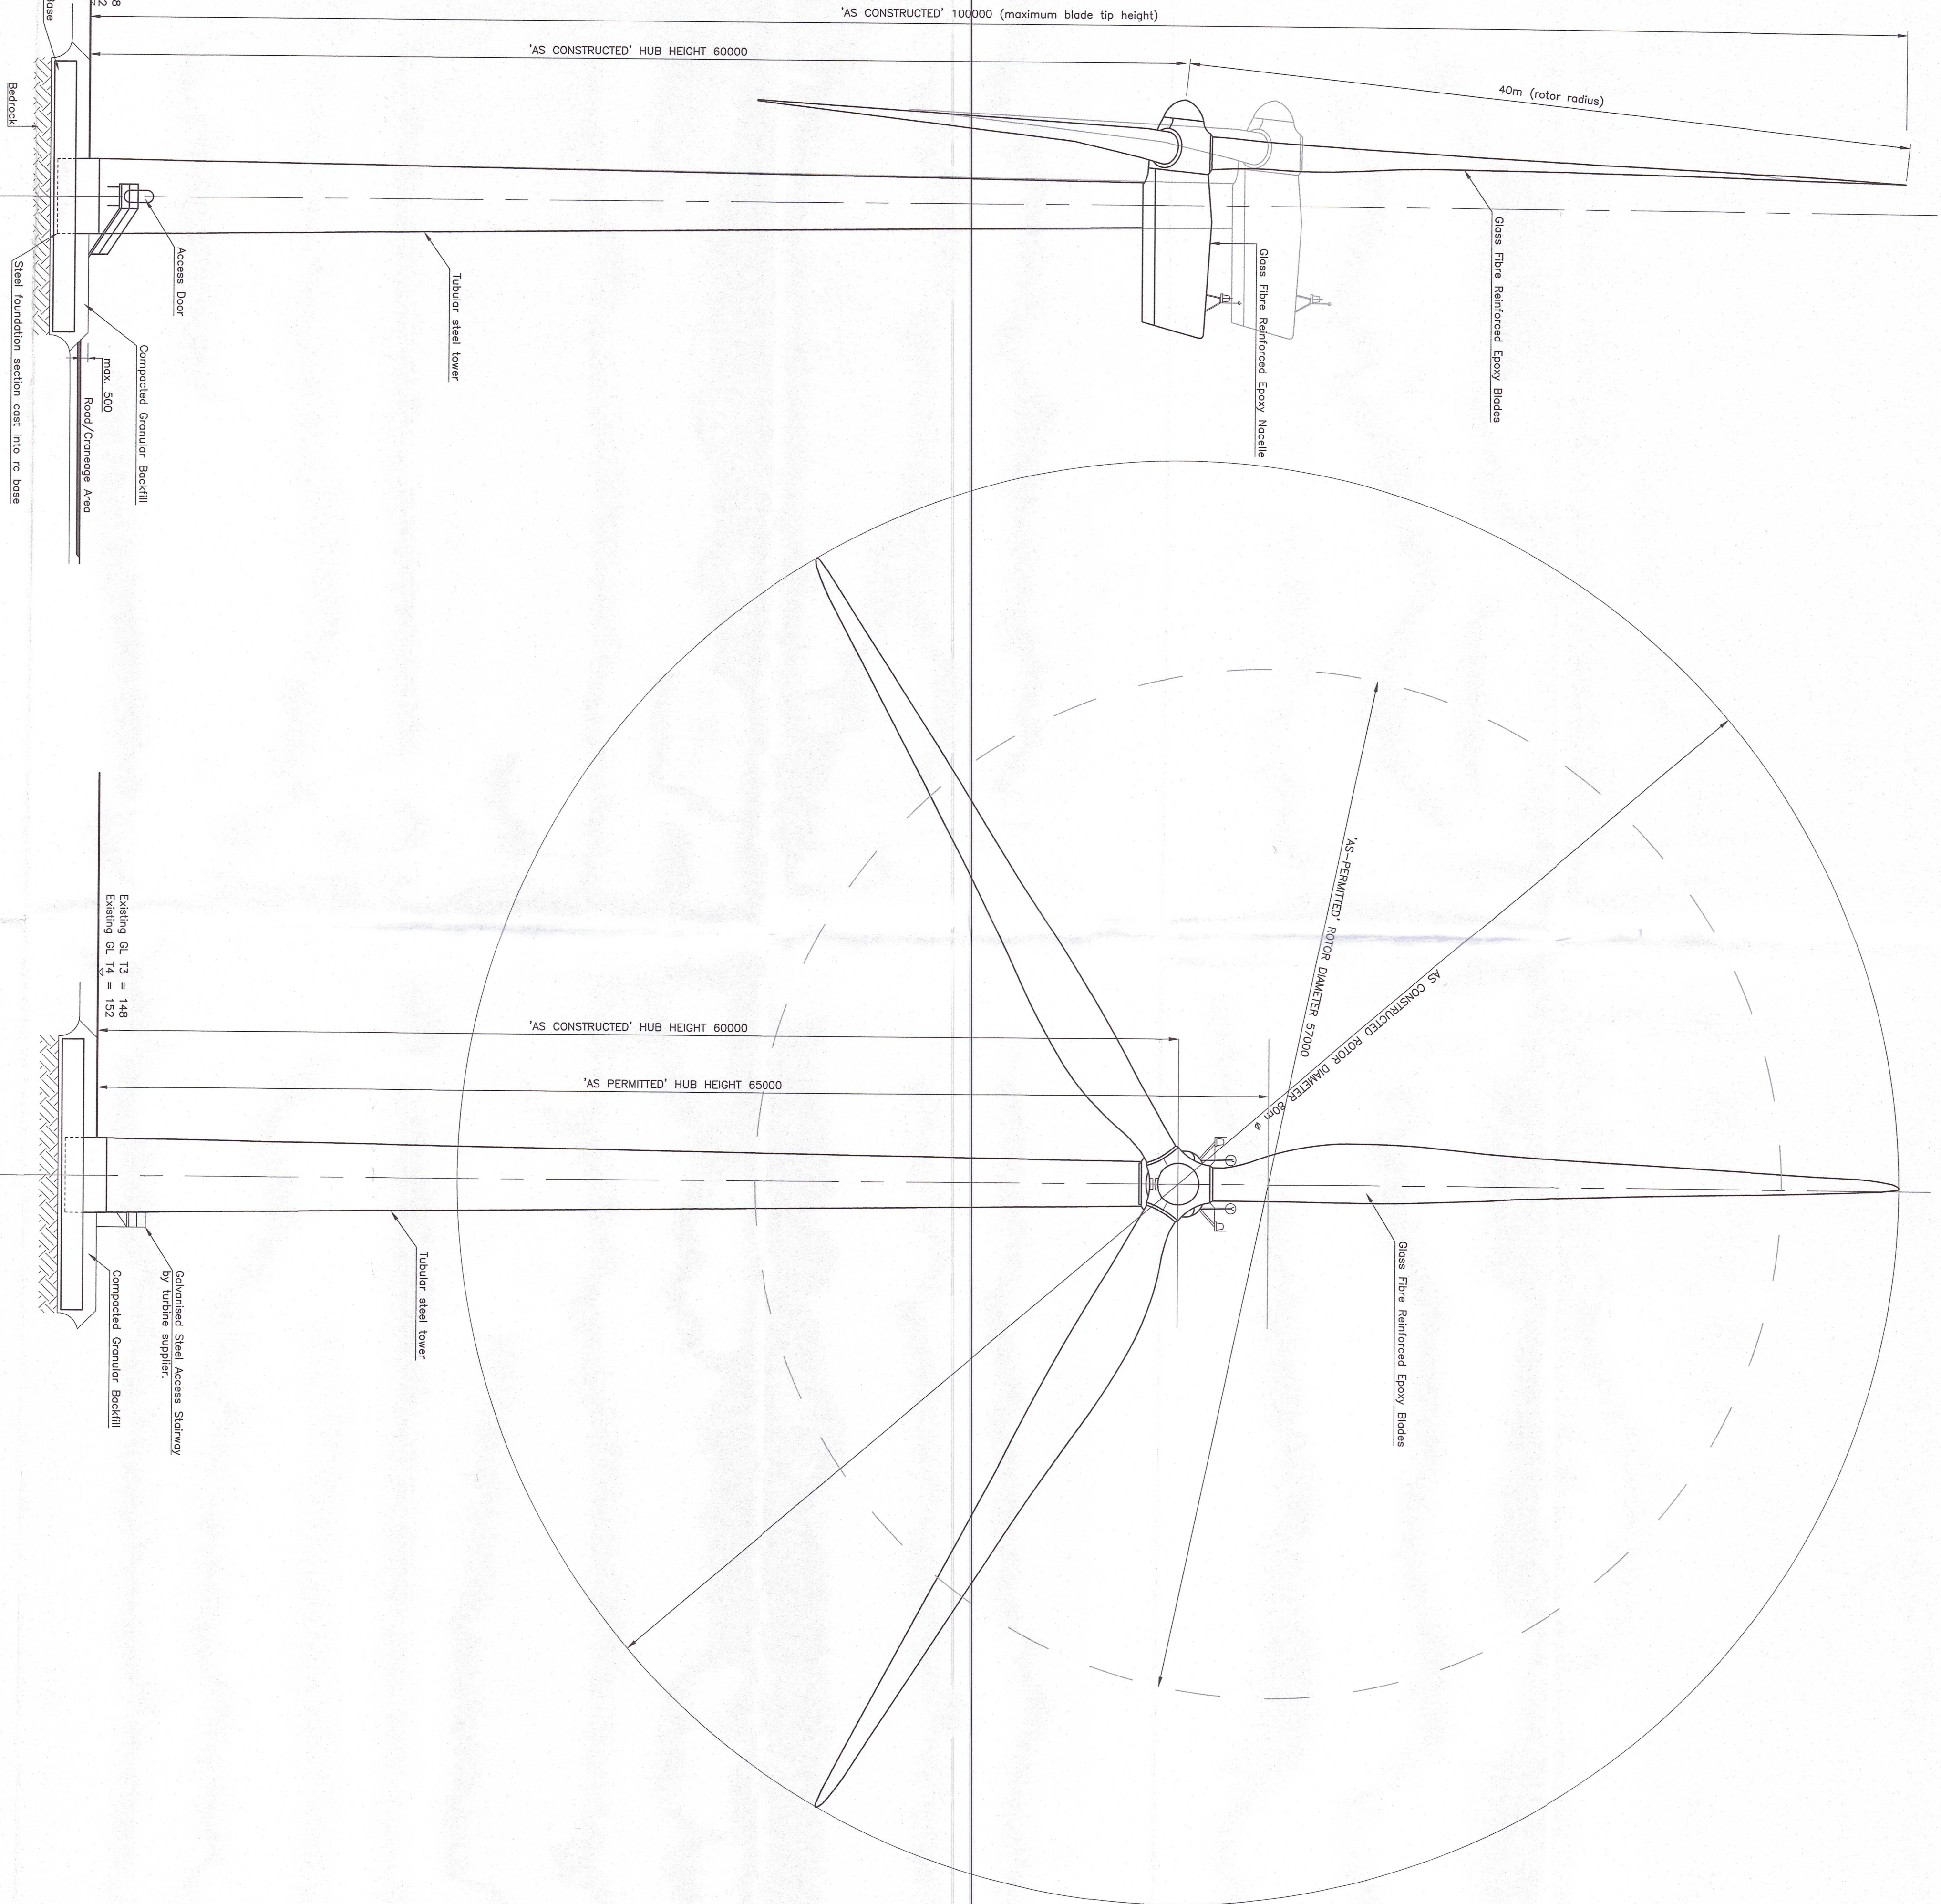

Notes :

1. All dimensions are in millimetres – figured dimensions to be taken in preference to scaled dimensions.
2. All levels are in metres and relate to Ordnance Datum Mean Head.

REG. NO. **PLANNING (WEST) DEPT**
29 SEP 2023
CORK COUNTY COUNCIL
MORTON HOUSE, BRIBBEREE, CO. CORK P18 4WZ

1	5.6.22	'As-Built' - Permitted Development Issue	DM	KH	KH
0	02.10.15	Original	DM	CH	KH
Issues	Date	Revisions	Drawn	Checked/Approved	

MRG
consulting engineers

1202 Gateway Business Park, Mallow Rd, Cork
Telephone : (031) 868030
Tel/Fax : (031) 868030
Email : enquiries@mrge.ie
Site : Bay View, Mallow, Co. Kerry

MRG Consulting Engineers
CIVIL STRUCTURAL ENVIRONMENTAL

Project		KILVINANE WINDFARM – CO. CORK	
Drawing		As-Constructed Permitted Development Wind Turbine Elevation (T3 & T4) 2MW Wind Turbine	
Drawn	D.McCarthy	Project No.	122004
Date	02.10.2015	Drawing No.	122004-321
Scale	As Shown		