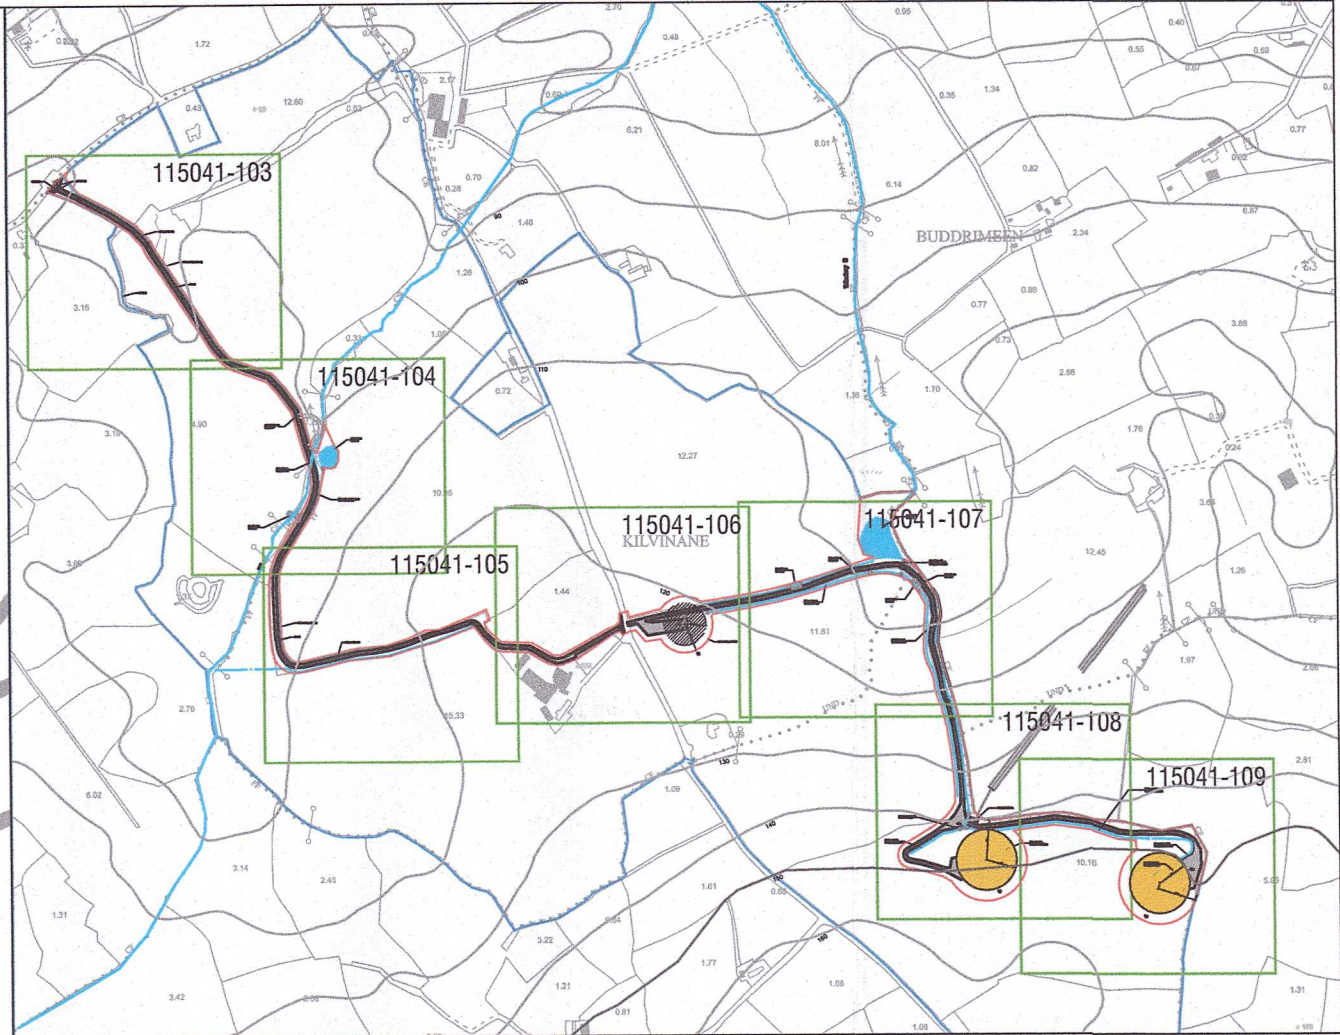
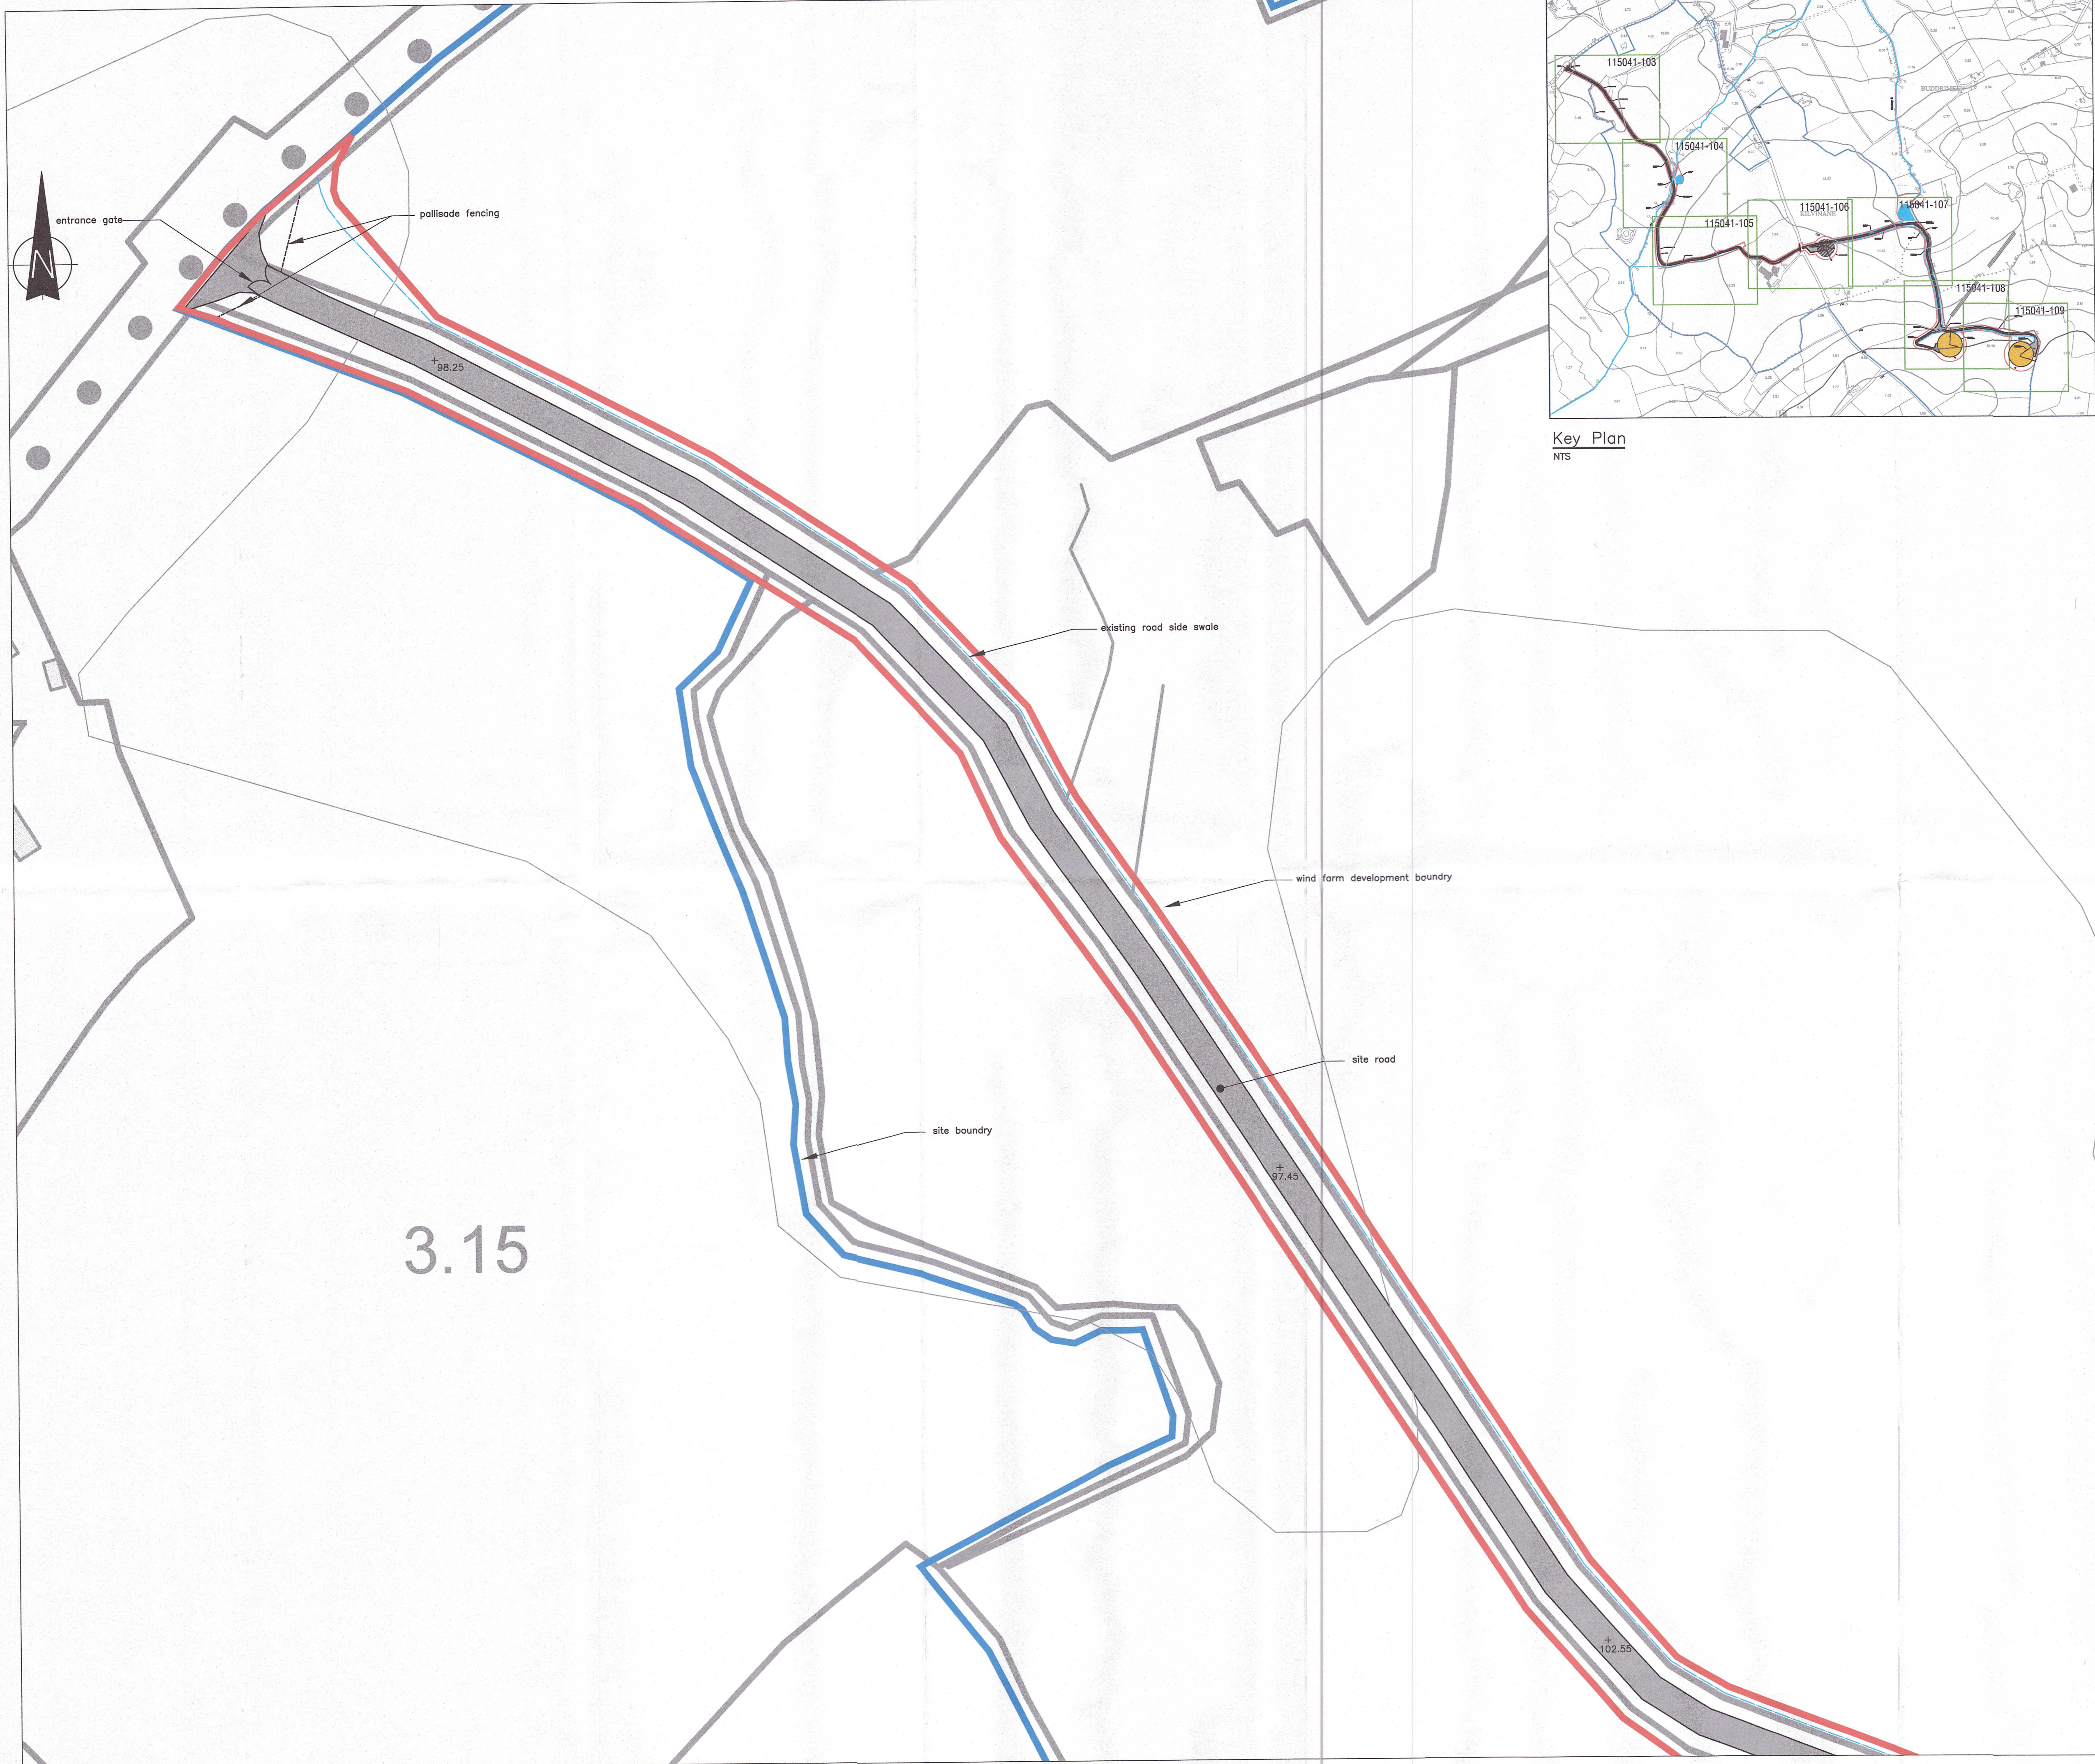




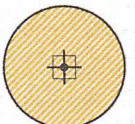
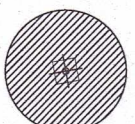
Key Plan
NTS

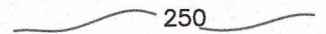
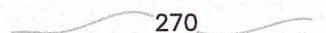
Notes :

1. All dimensions are in millimetres – figured dimensions to be taken in preference to scaled dimensions.
2. All levels are in metres, and relate to Ordnance Datum Malin Head.

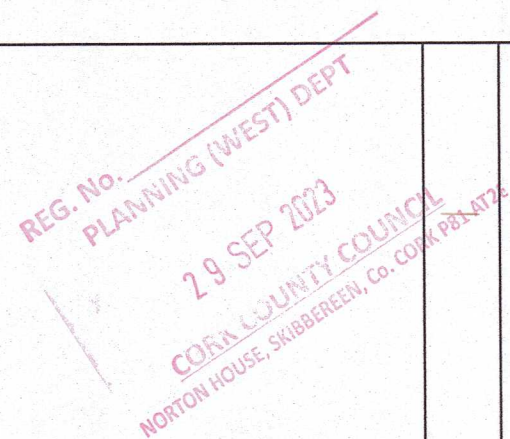
Legend :-

Site Boundary shown thus: 
(Overall Site Area = 96.5ha)
Development Boundary shown thus: 
(Development Area = 6.88ha)
Existing Access tracks/ Hardstanding areas shown thus: 

Existing 2MW Wind Turbine with 60m Hub Height and 80m Rotor Diameter shown thus: 
Existing 850kW Wind Turbine with 55m Hub Height and 58m Rotor Diameter shown thus: 

50m Contour shown thus:  250
10m Contour shown thus:  270
Existing trackside swales shown thus: 
Streams shown thus: 

Ordnance Survey Ireland Licence No. EN 0034811
Ordnance Survey Ireland Government of Ireland

REG. No. 
PLANNING (WEST) DEPT
29 SEP 2013
CORK COUNTY COUNCIL
NORTON HOUSE, SHANBERRY, Co. CORK (P6A-174)

1	5.8.22	'As-Built'—Permitted Development Issue	DM	KH	KH
0	02.10.15	Original	DM	KH	KH
Issue	Date	Revisions	Drawn	Checked	Approved



consulting engineers

1202 Gateway Business Park, Mallow Rd, Cork
Telephone : (021) 4302250
Telefax : (021) 4306723
E-Mail : cork@mrgr.ie
also : Day Place, Tralee, Co. Kerry

MRG Consulting Engineers

CIVIL STRUCTURAL ENVIRONMENTAL

Project		
KILVINANE WINDFARM — CO. CORK		
Drawing		
As—Constructed Permitted Development Site Layout Plan (1:500) Sheet 1 of 7		
Drawn	D.Moriarty	Project No.
Date	02.10.2015	122004
Scale	1:500 @ A1	Drawing No. 122004—303