
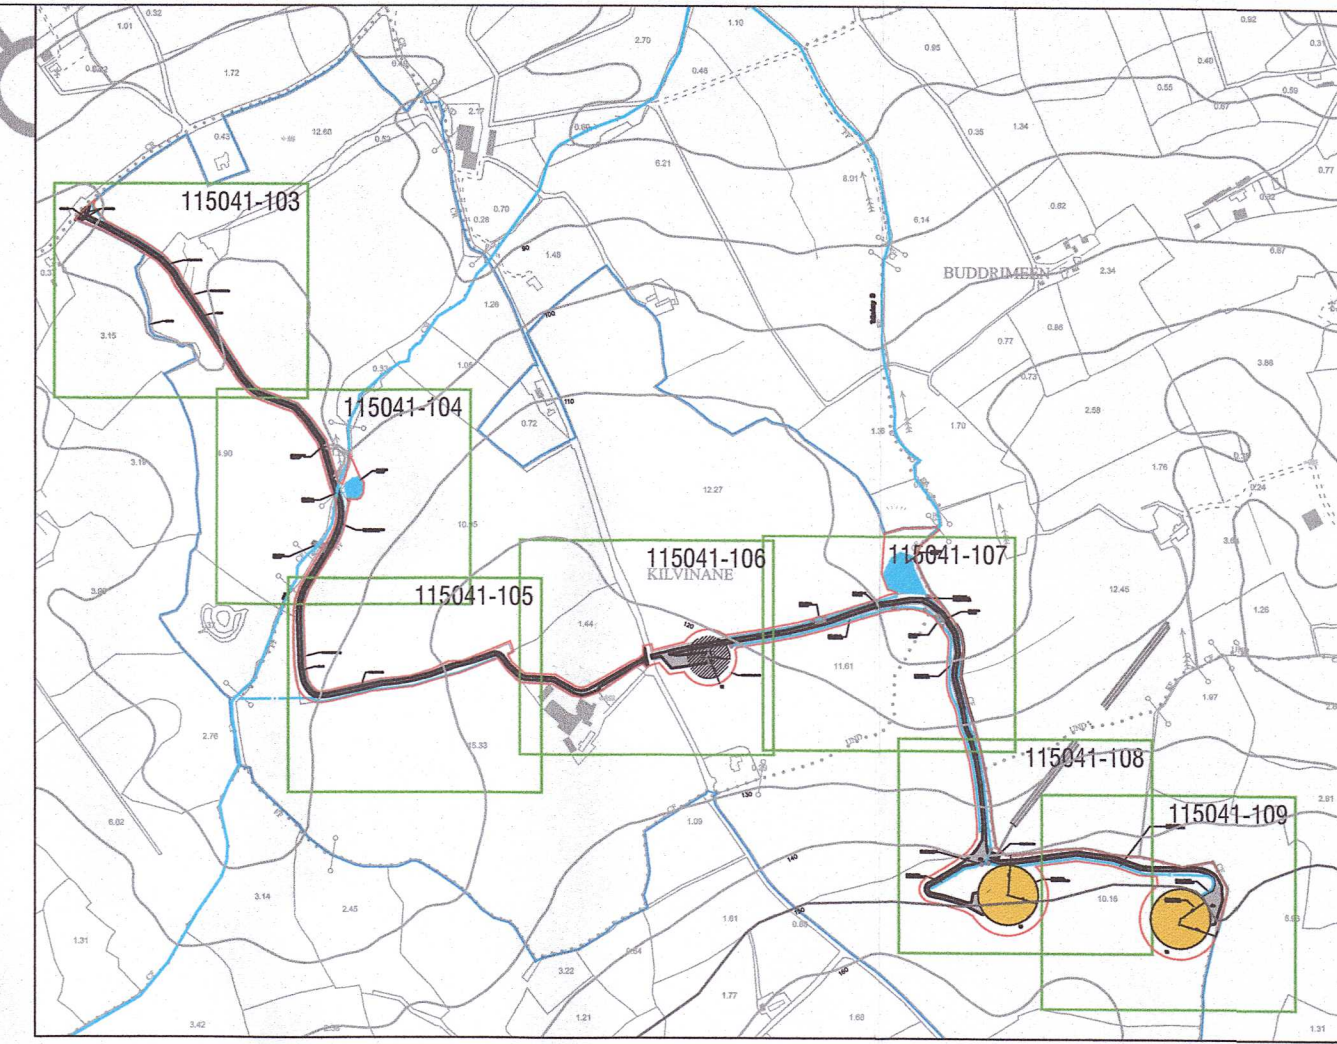


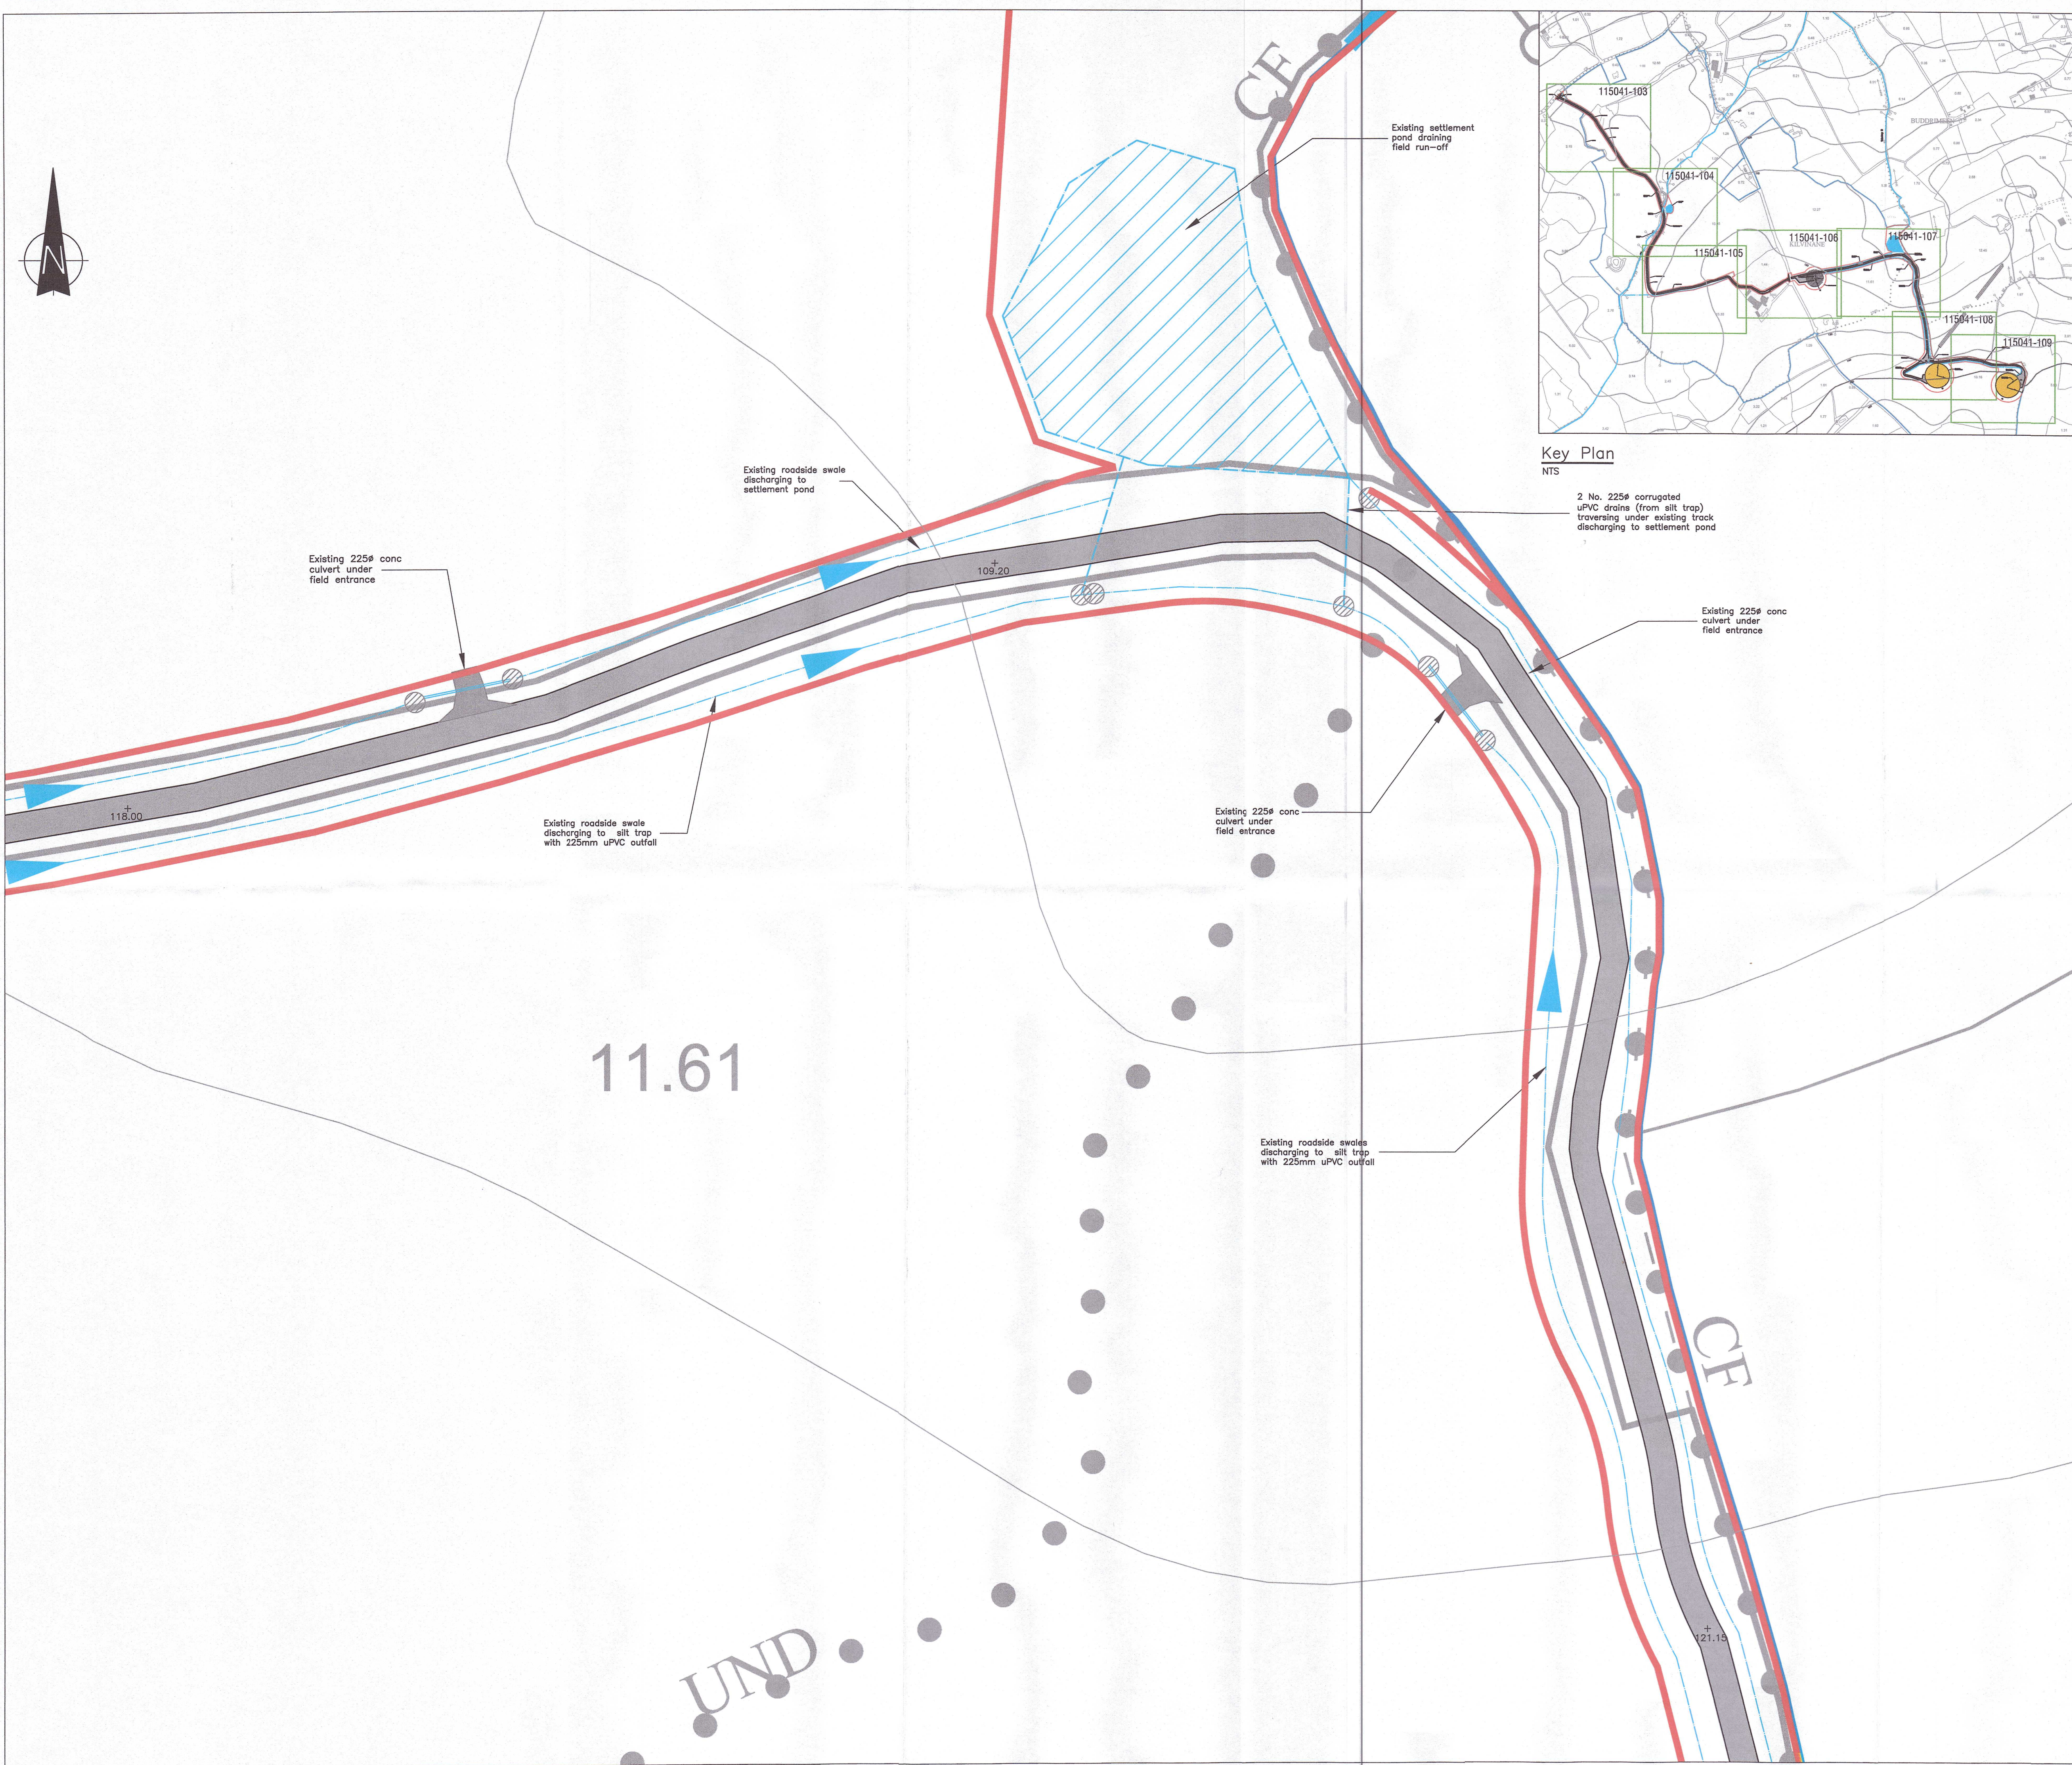

Key Plan
NTS

Notes :

- All dimensions are in millimetres – figured dimensions to be taken in preference to scaled dimensions.
- All levels are in metres, and relate to Ordnance Datum Malin Head.

Legend :-

Site Boundary shown thus:

Development Boundary shown thus:

Existing Access tracks/ Hardstanding areas shown thus:

Existing 2MW Wind Turbine with 60m Hub Height and 80m Rotor Diameter shown thus:

Existing 850kW Wind Turbine with 55m Hub Height and 58m Rotor Diameter shown thus:

50m Contour shown thus: 250

10m Contour shown thus: 270

Existing trackside swales shown thus:

Streams shown thus:

Ordnance Survey Ireland Licence No. EN 0034811
Ordnance Survey Ireland Government of Ireland

				</	

MRG
consulting engineers

1202 Gateway Business Park, Mallow Rd, Cork

Telephone : (021) 430250
 Telefax : (021) 430273
 E-Mail : cork@mrgr.ie

also : Day Place, Tralee, Co. Kerry

MRG Consulting Engineers
CIVIL STRUCTURAL ENVIRONMENTAL

Project		
KILVINANE WINDFARM — CO. CORK		
Drawing		
As-Constructed Permitted Development Site Layout Plan (1:500) Sheet 5 of 7		
Drawn	D.Moriarty	Project No.
Date	02.10.2015	122004
Scale	1:500 @ A1	Drawing No. 122004-307