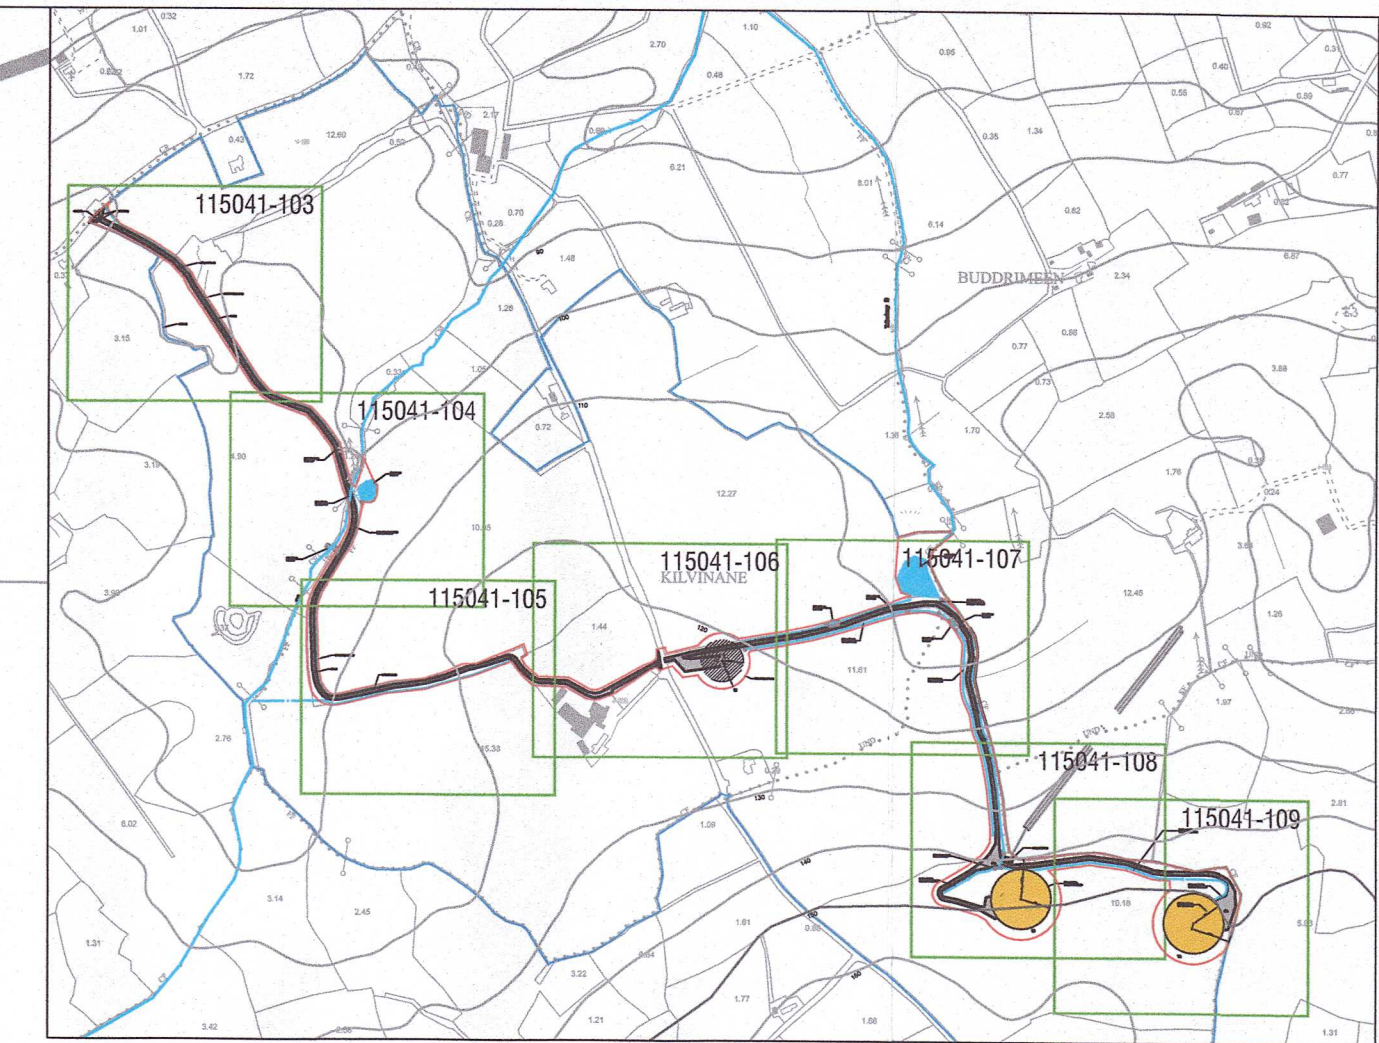
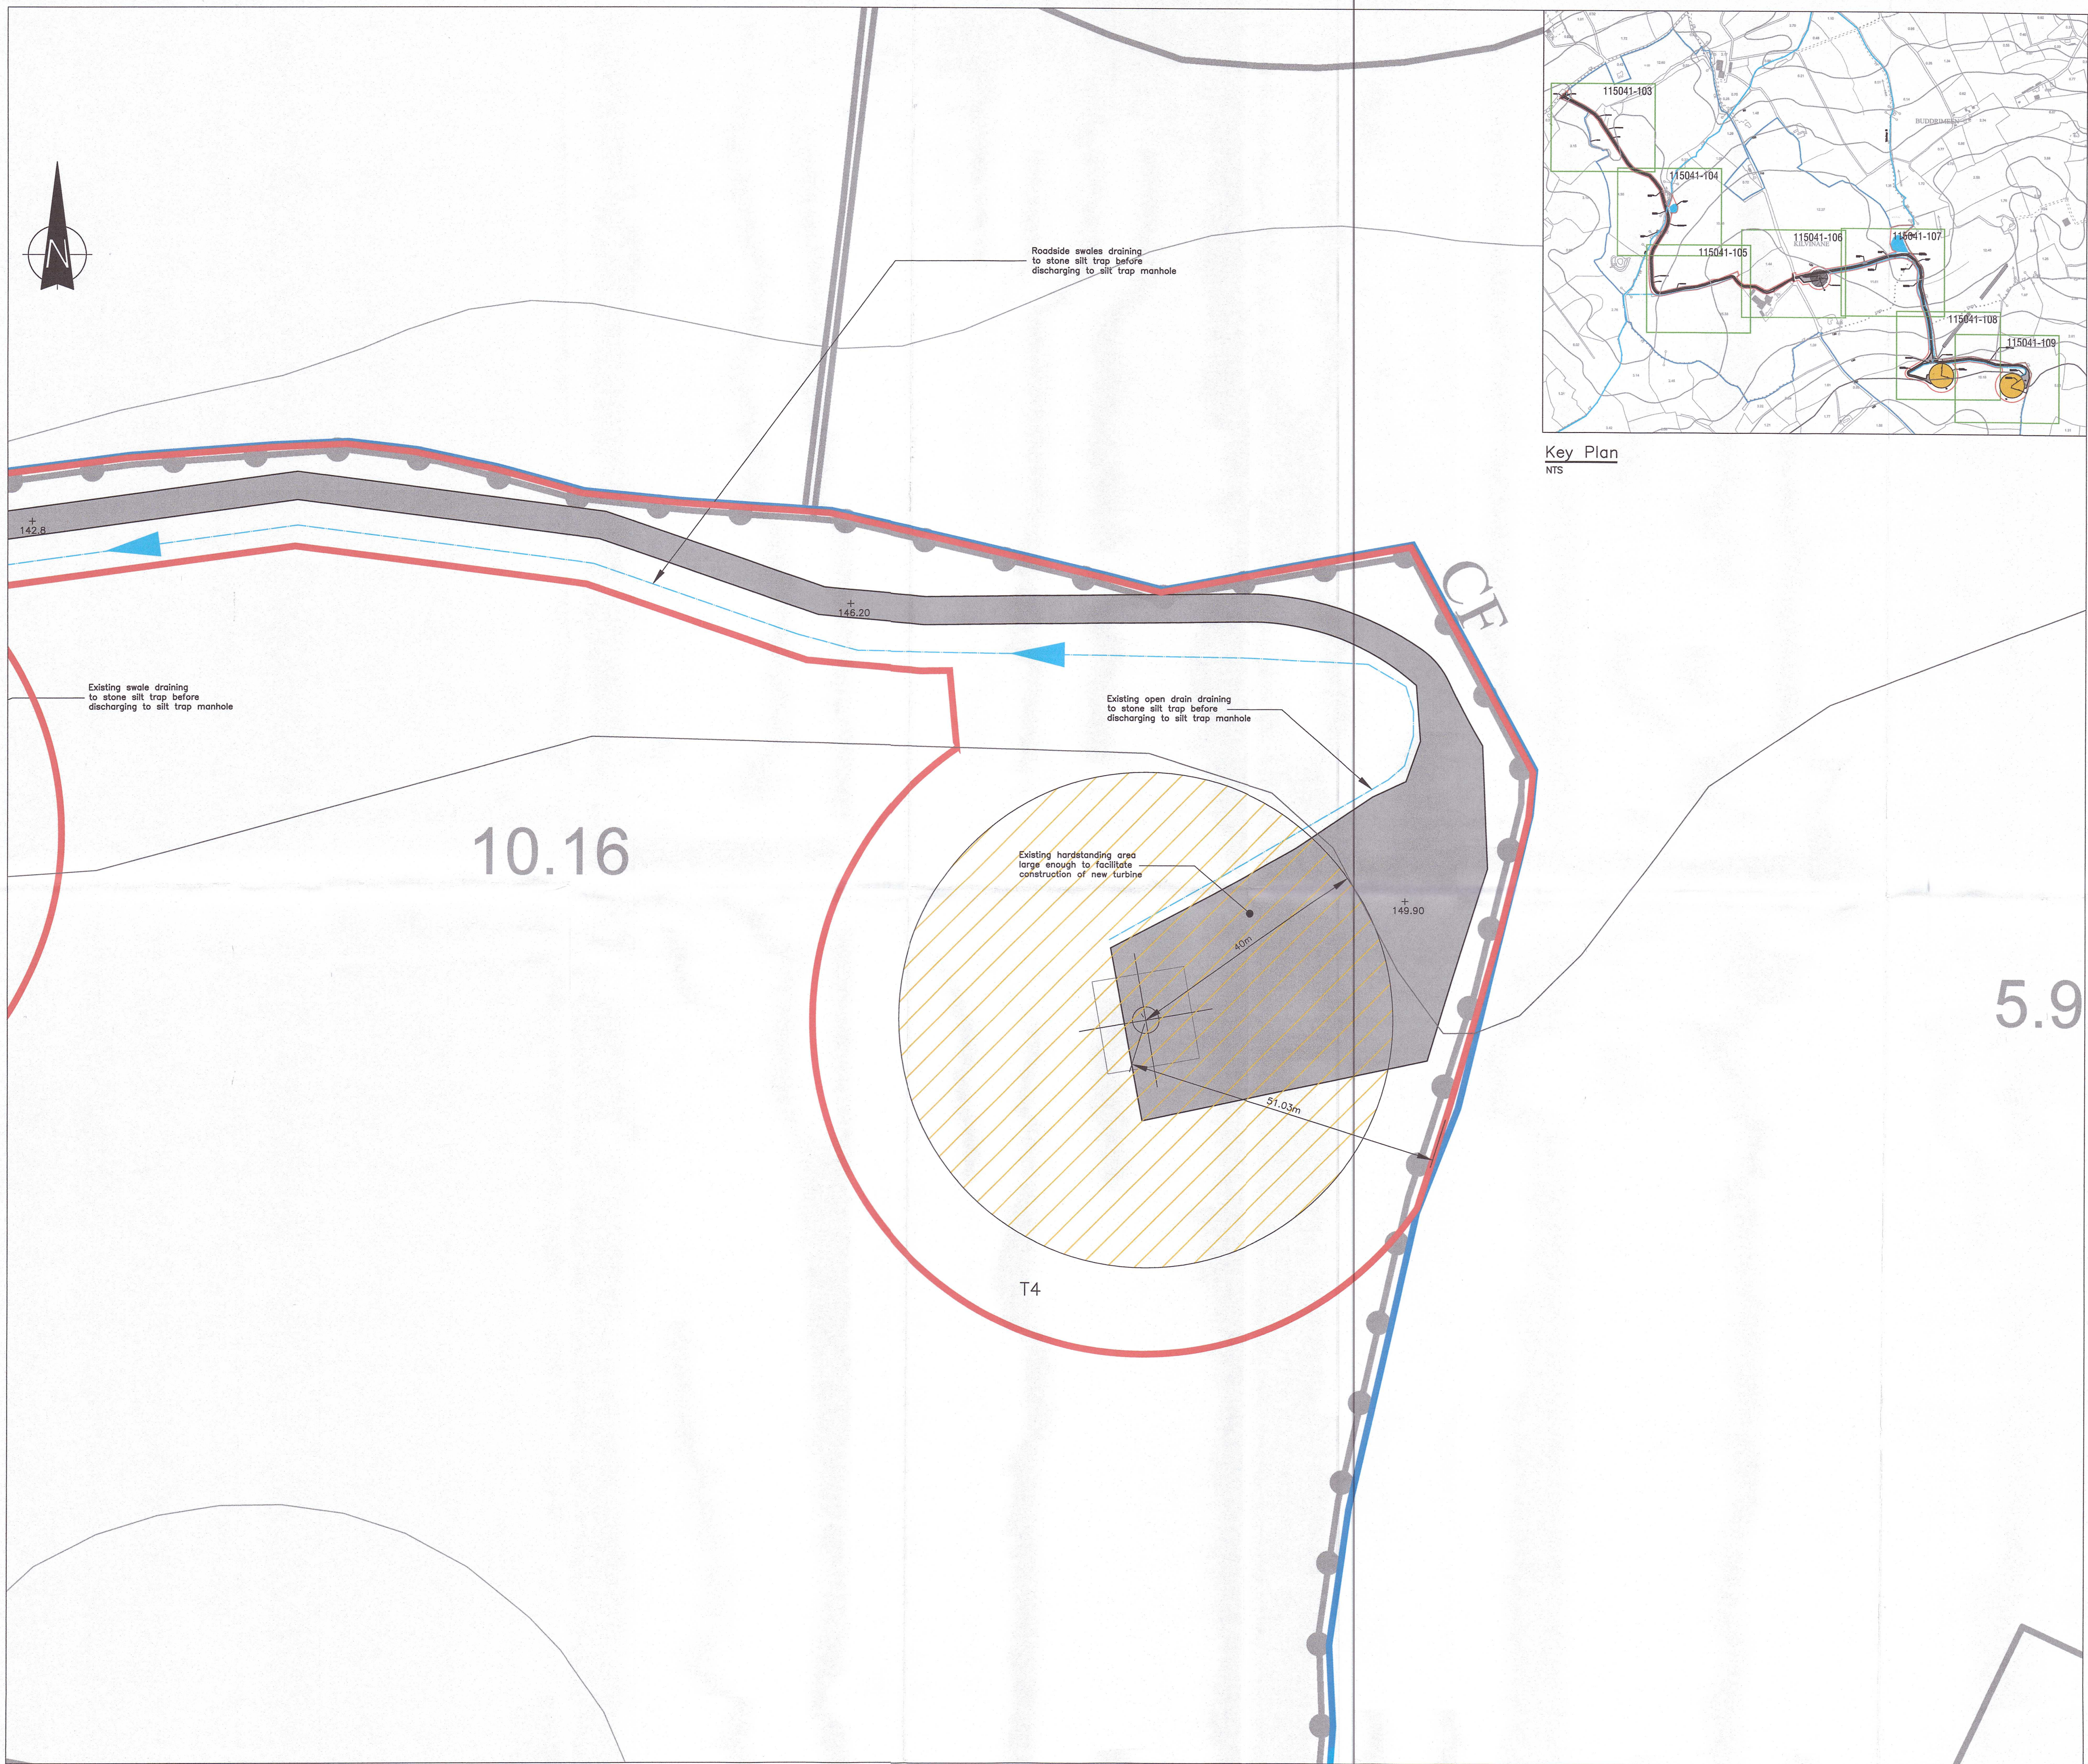
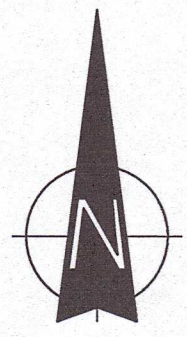


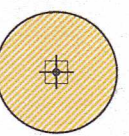
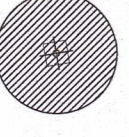
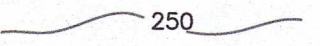
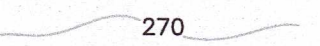


Key Plan
NTS

Notes :

1. All dimensions are in millimetres – figured dimensions to be taken in preference to scaled dimensions.
2. All levels are in metres, and relate to Ordnance Datum Malin Head.

Legend :-

- Site Boundary shown thus: 
- Development Boundary shown thus: 
- Existing Access tracks/ Hardstanding areas shown thus: 
- Existing 2MW Wind Turbine with 60m Hub Height and 80m Rotor Diameter shown thus: 
- Existing 850kW Wind Turbine with 55m Hub Height and 58m Rotor Diameter shown thus: 
- 50m Contour shown thus:  250
- 10m Contour shown thus:  270
- Existing trackside swales shown thus: 
- Streams shown thus: 

Ordnance Survey Ireland Licence No. EN 0034811
Ordnance Survey Ireland Government of Ireland

REG. No. PLANNING (WEST) DEPT 29 SEP 2023 CORK COUNTY COUNCIL NORTON HILL, CORK, CO. CORK			
1	5.8.22	'As-Built'—Permitted Development Issue	DM KH KH
0	02.10.15	Original	DM KH KH
Issue	Date	Revisions	Drawn Checked Approved

**MRG**
consulting engineers

1202 Gateway Business Park, Mallow Rd, Cork
Telephone : (021) 4380250
Telefax : (021) 4386720
E-Mail : cork@mrng.ie
also : Day Place, Tralee, Co. Kerry

MRG Consulting Engineers

CIVIL STRUCTURAL ENVIRONMENTAL

Project KILVINANE WINDFARM – CO. CORK		
Drawing As—Constructed Permitted Development Site Layout Plan (1:500) Sheet 7 of 7		
Drawn D.Moriarty	Project No. 122004	Drawing No. 122004—309
Date 02.10.2015		
Scale 1:500 @ A1		