


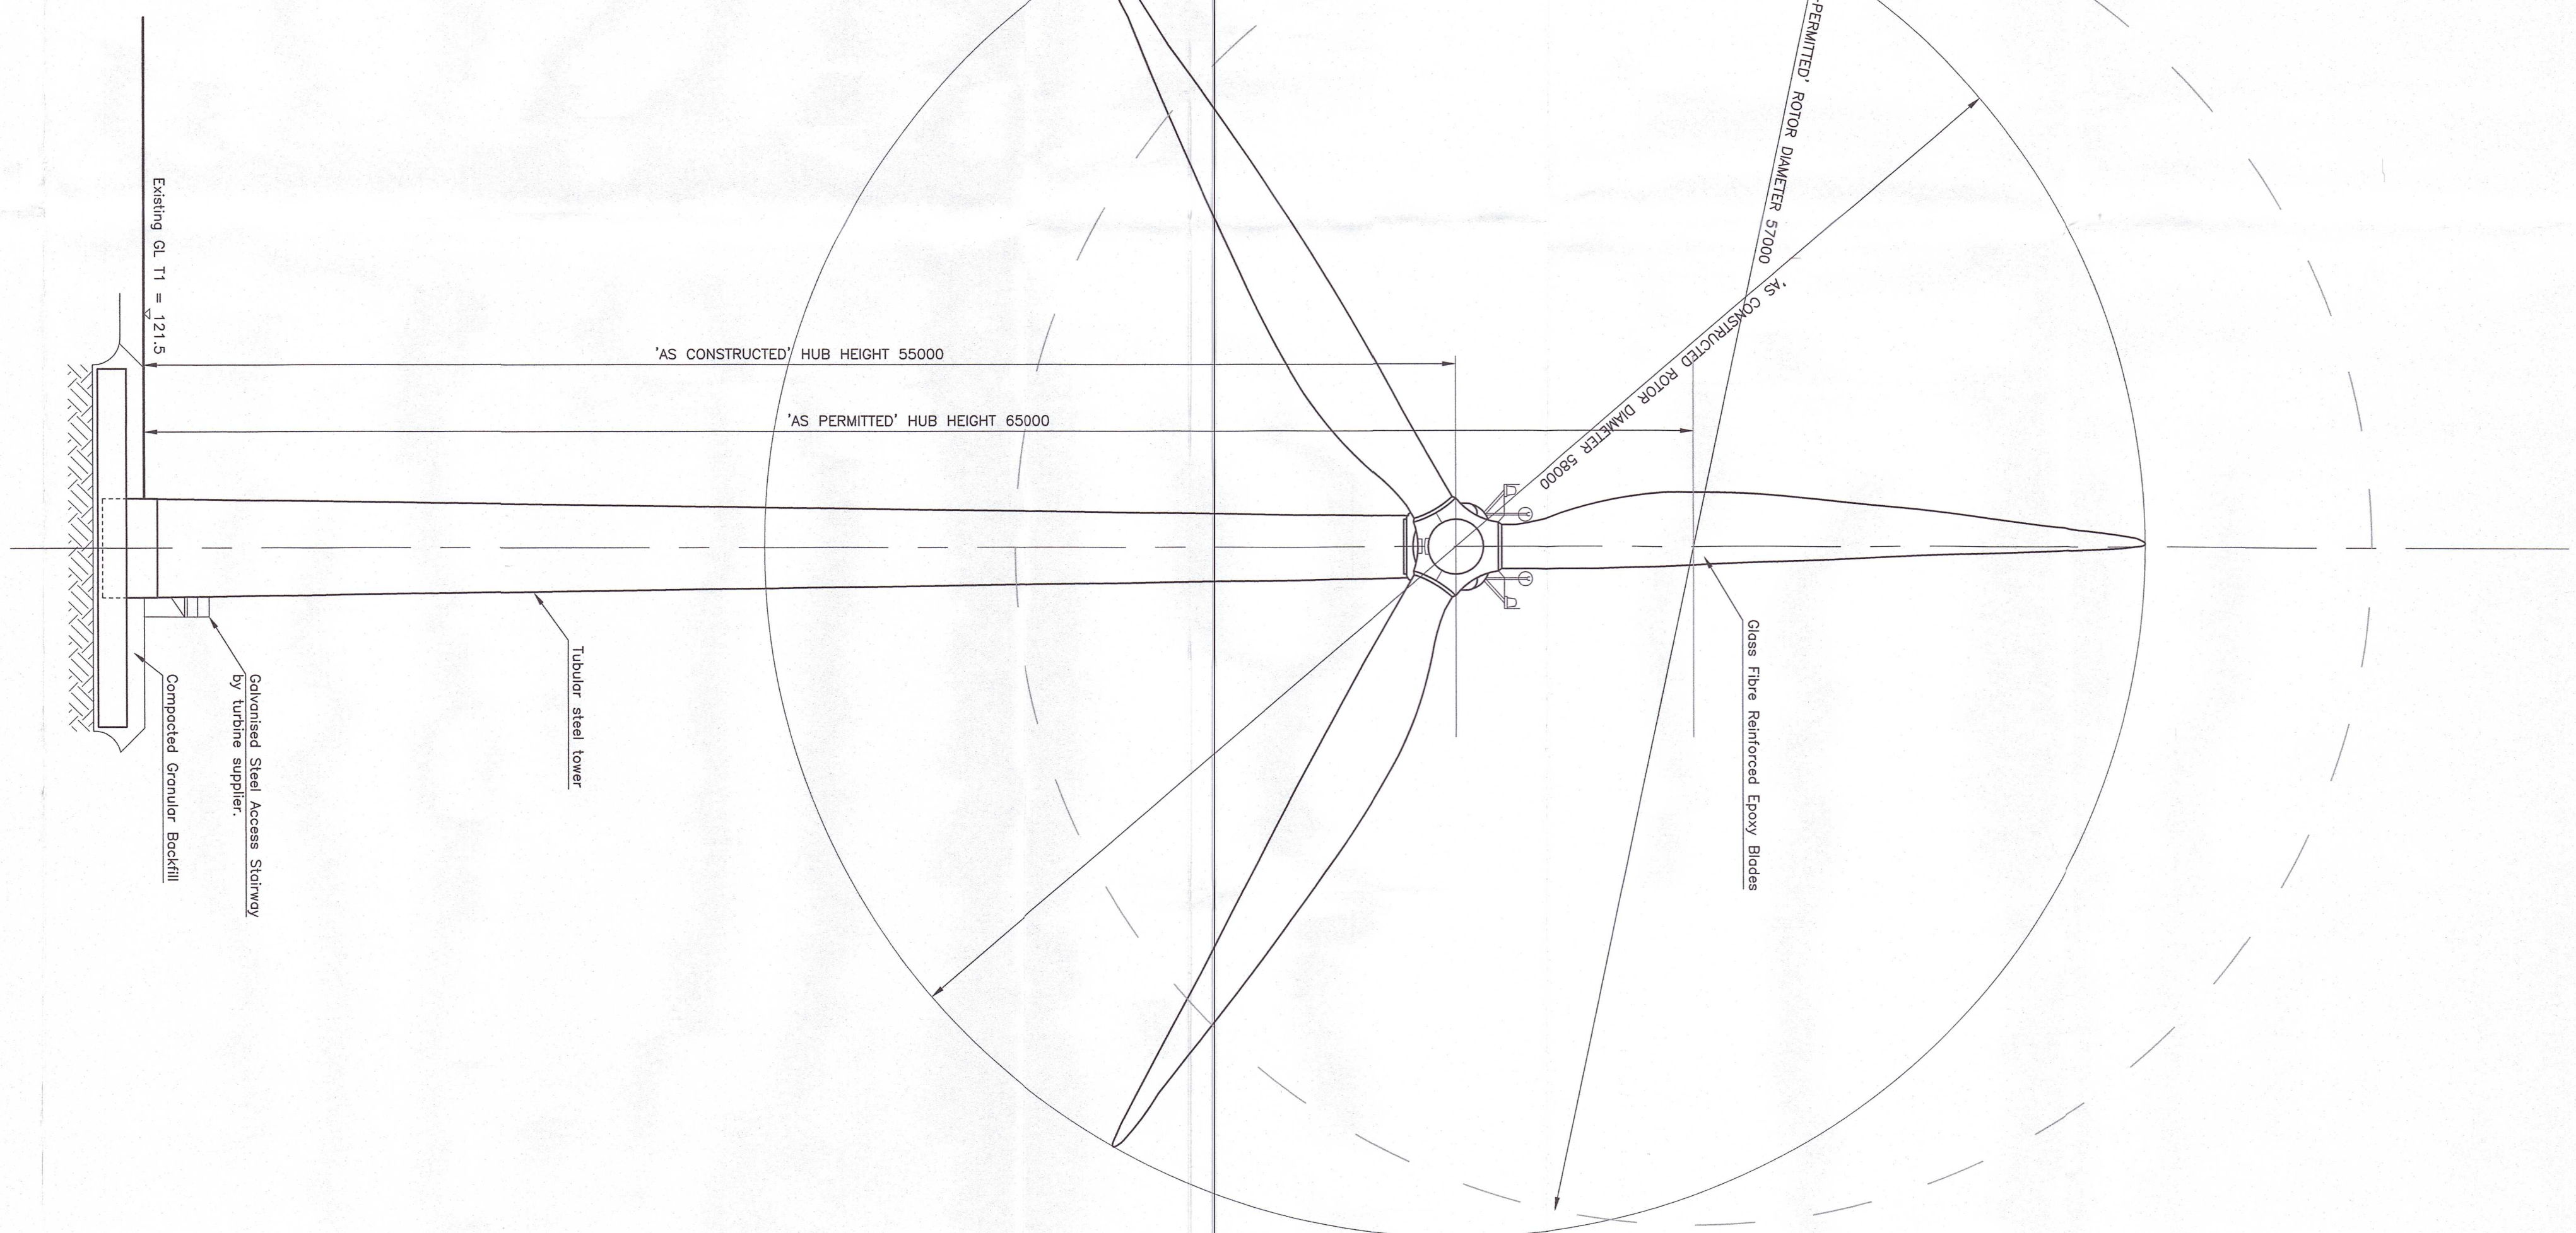

Front Sectional Elevation
Scale 1 : 200

Scale 1 : 200

- MRG**
consulting engineers
- 1202 Gateway Business Park, Mallow Rd, Cork
- Telephone : (021) 408260
Telex : (021) 50873
E-Mail : cork@mrge.ie
also : Boy Pluck, Tulla Co. Kerry
- CIVIL STRUCTURAL ENVIRONMENTAL**
- MRG Consulting Engineers



MRG
consulting engineers

1202 Gateway Business Park, Mallow Rd, Cork

Telephone : (003) 400000
 Fax : (003) 400001
 E-Mail : info@mrge.ie
 Web : www.mrge.ie

also : Day Peck, Tulsa, Co. Kerry

CIVIL STRUCTURAL ENVIRONMENTAL

MRG Consulting Engineers

KILVINANE WINDFARM — CO. CORK

Drawing

As-Constructed Permitted Development

Wind Turbine Elevation (T1)

850kw Wind Turbine

Project

Droom	D. Memory	Project No.	Drawing No.
Date	02.10.2015	122004	122004-322
Scale	As Shown		