




Existing Side Elevation
Scale 1:50

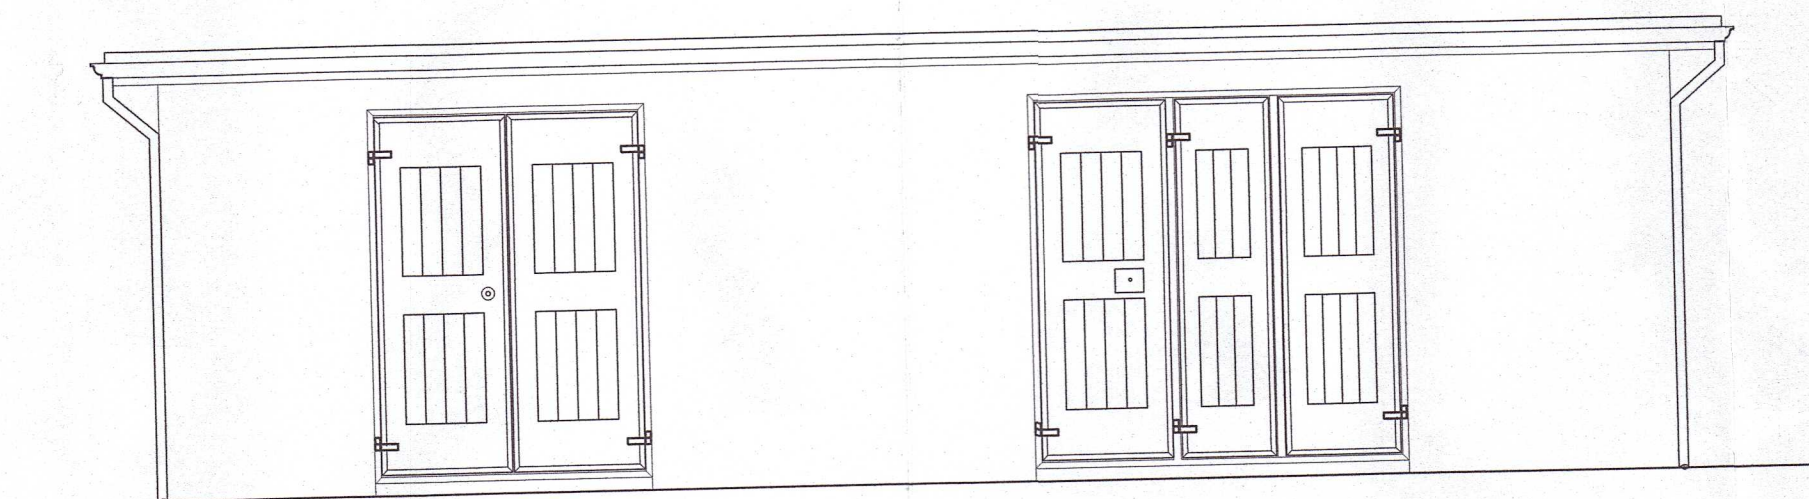


Existing Front Elevation
Scale 1:50

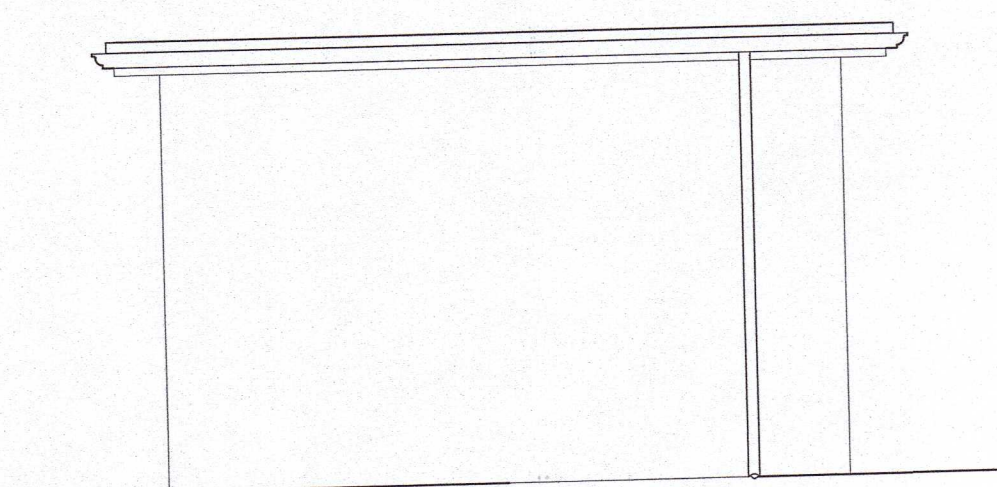


Existing Side Elevation
Scale 1:50

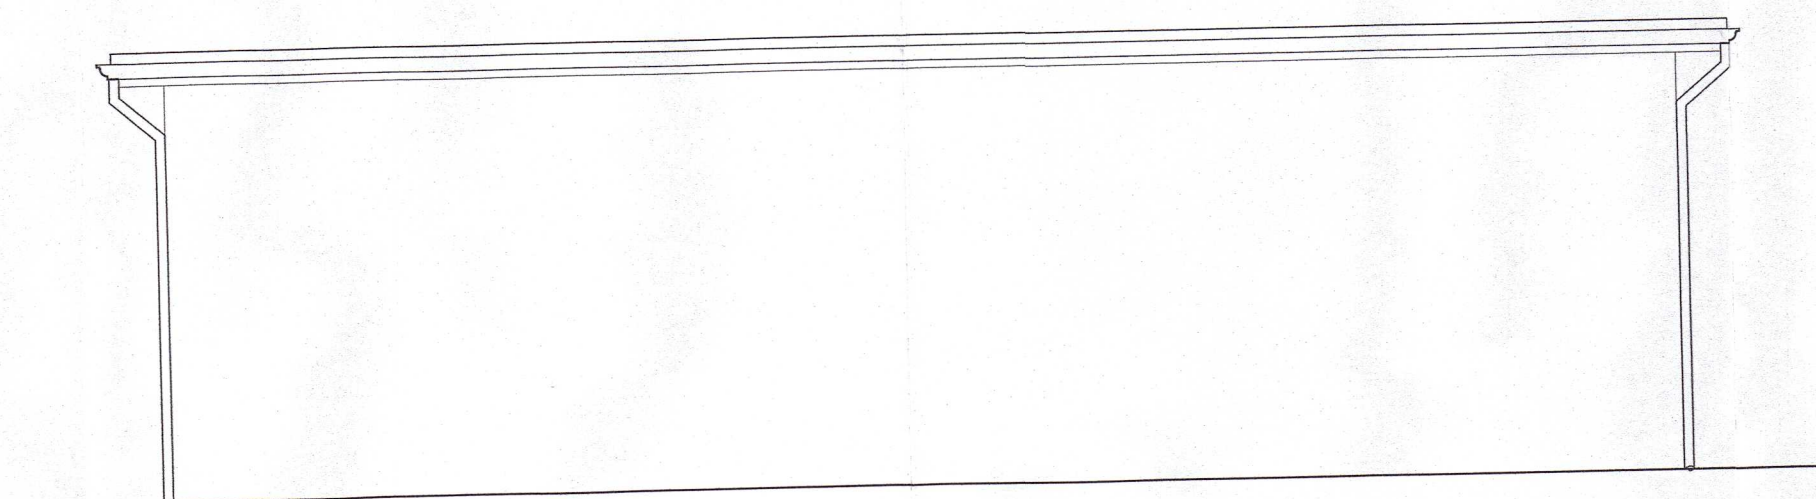

Existing Rear Elevation
Scale 1:50

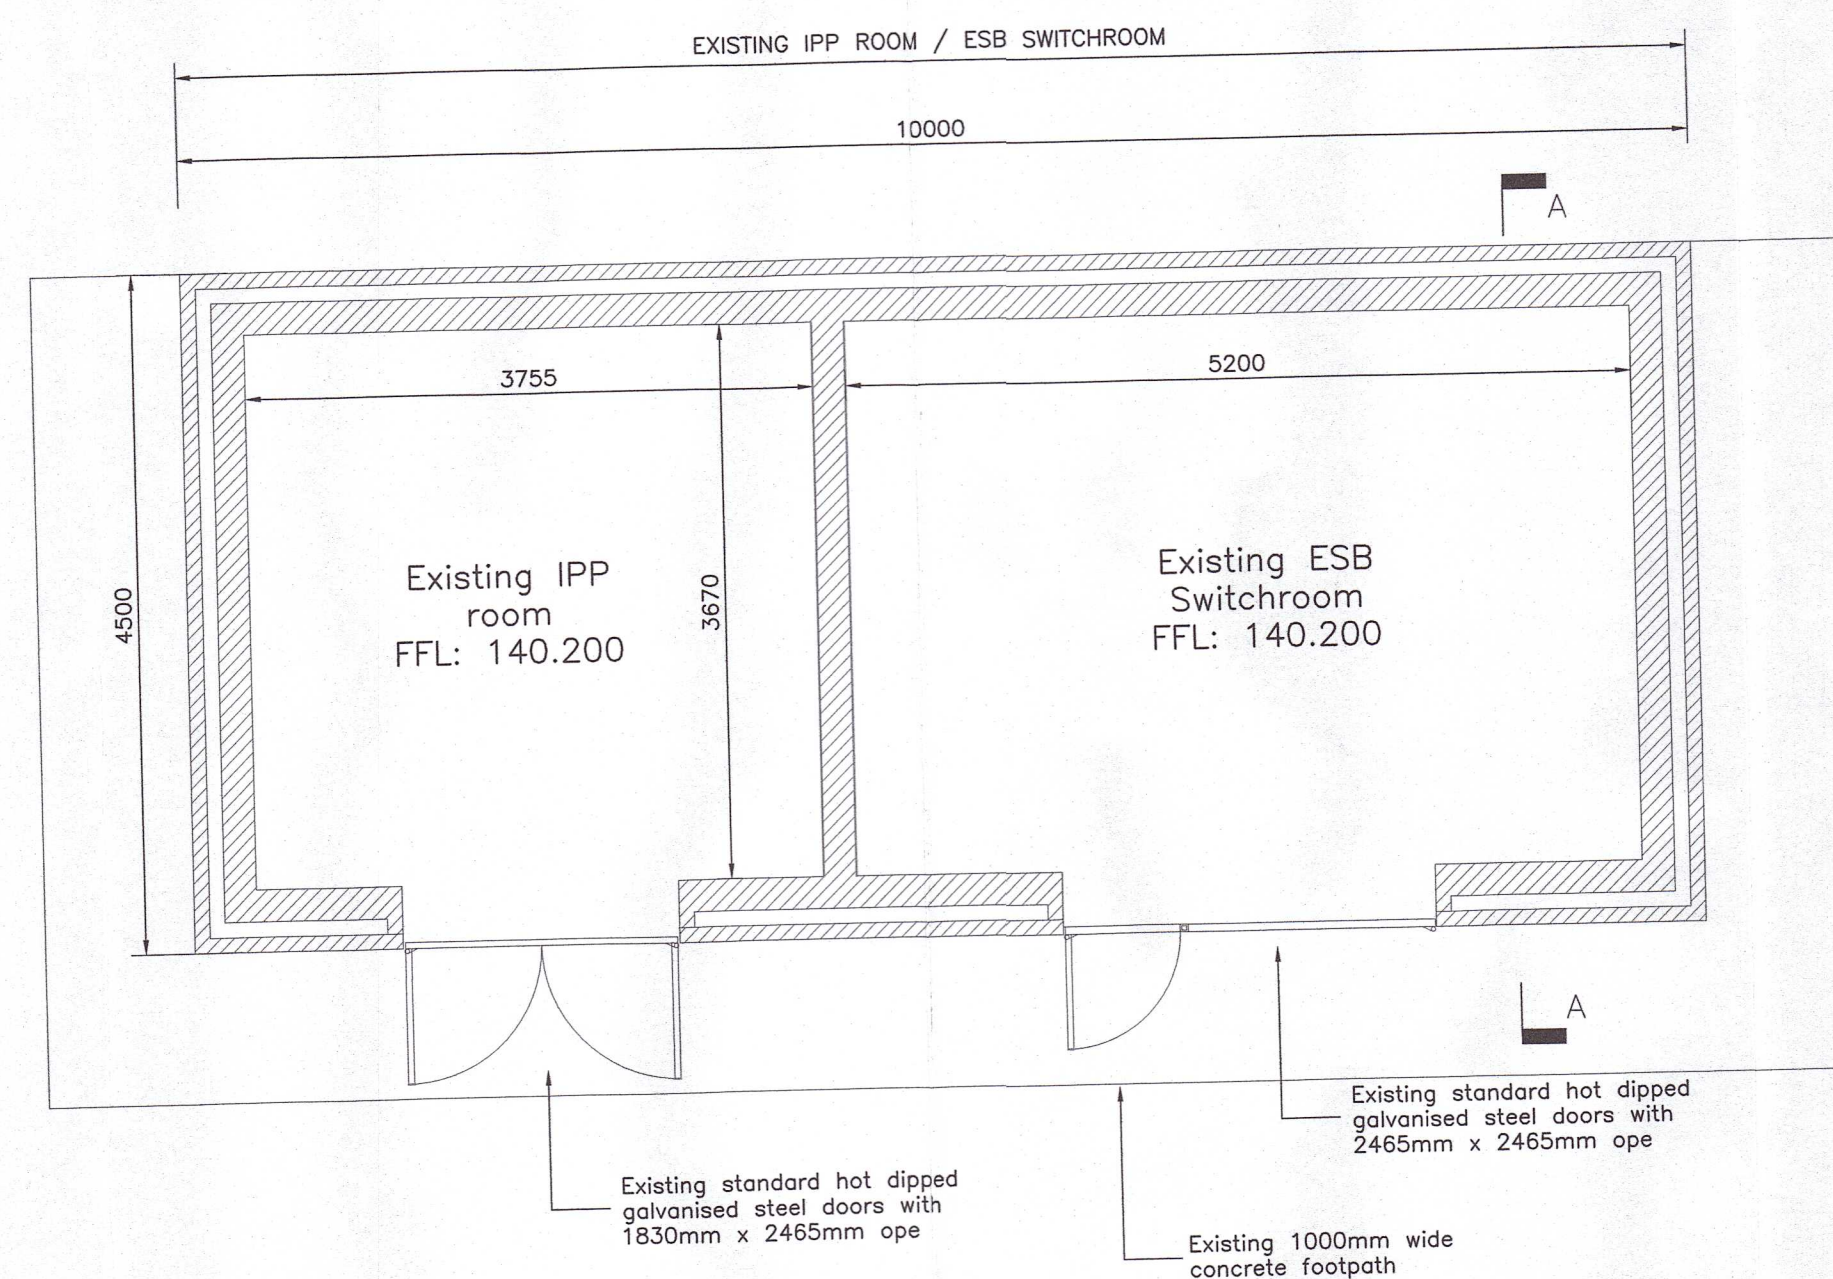

Existing Ground Floor Plan
Scale 1:50

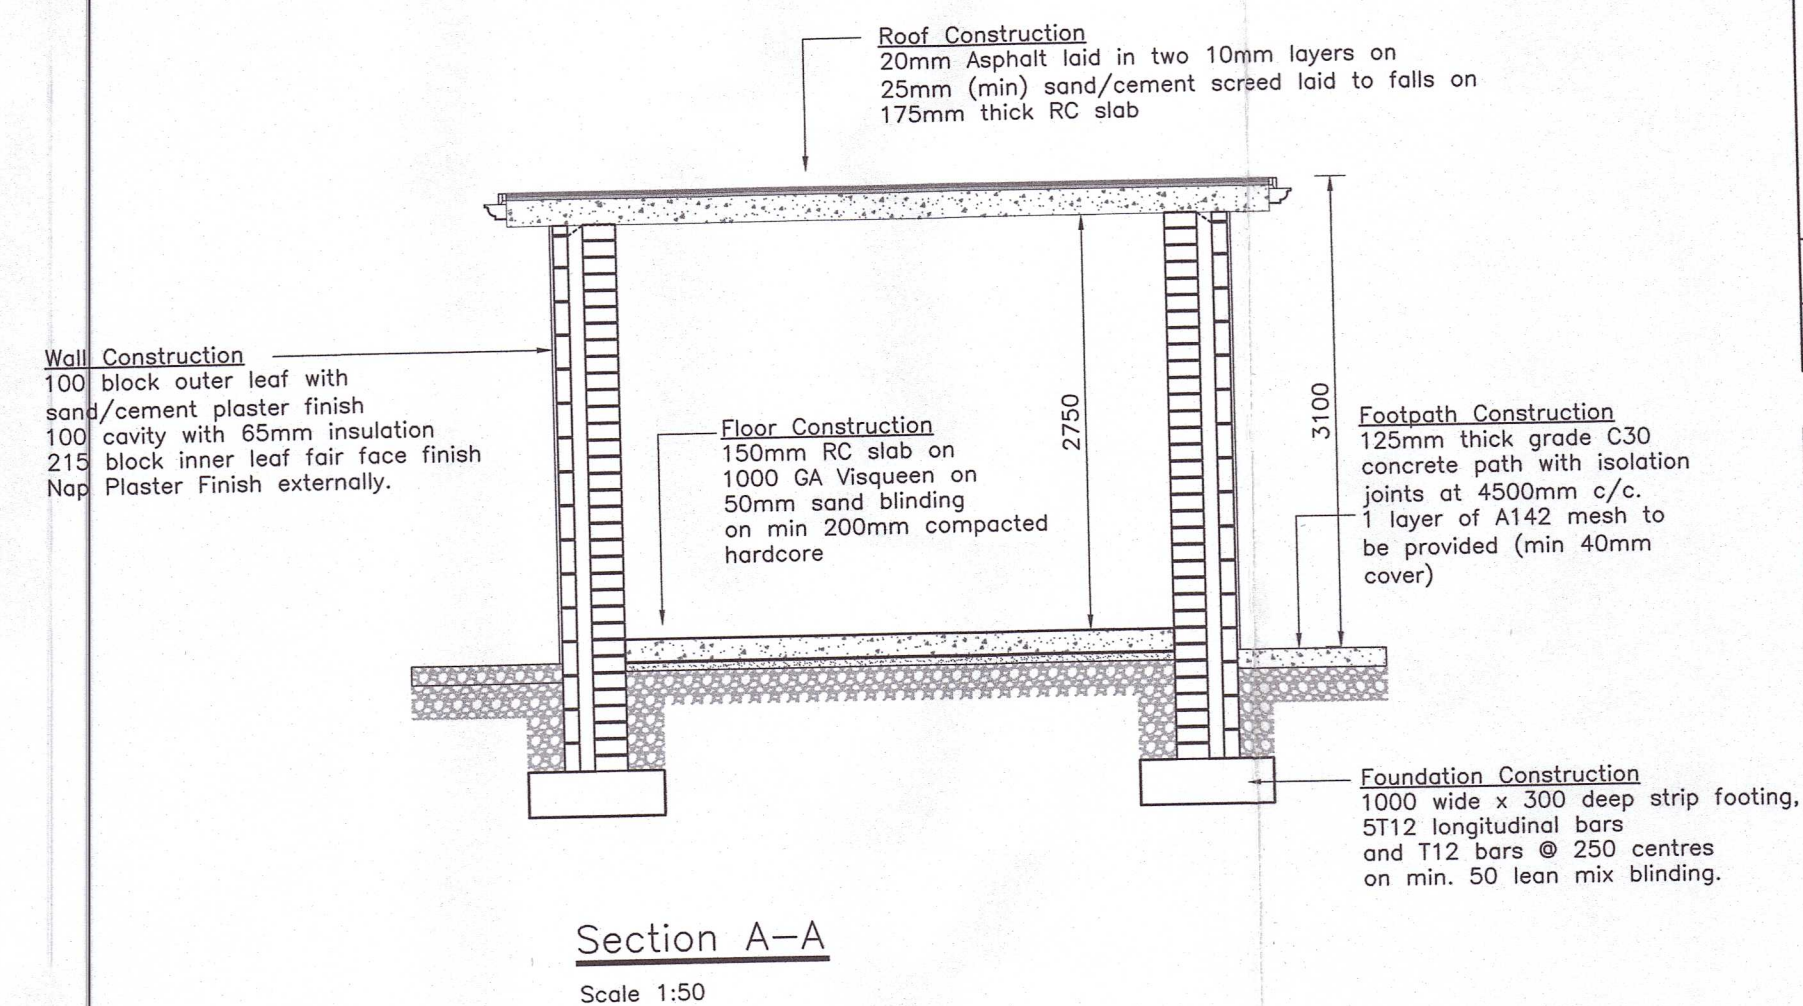

Section A-A
Scale 1:50

Notes :

1. All dimensions are in millimetres – figured dimensions to be taken in preference to scaled dimensions.
2. All levels are in metres, and relate to Ordinance Datum Malin Head.

1	5.8.22	'As-Built'—Permitted Development Issue	DM	KH	KH
O	02.10.15	Original	DM	KH	KH
Issue	Date	Revisions	Drawn	Checked	Approved

MRG consulting engineers
1202 Gateway Business Park, Mallow Road, Cork
Telephone : (068) 7123130
Telefax : (068) 7123344
E-Mail : info@mrge.ie
also : 4 Day Place, Tralee, Co. Kerry

Consulting Engineers Civil Structural Environmental

Project KILVINANE WINDFARM — CO. CORK		
Drawing As—Constructed Permitted Development Substation Control Building		
Drawn D.Moriarty	Project No. 122004	Drawing No. 122004—323
Date 02.10.2015		
Scale As Shown @ A1		