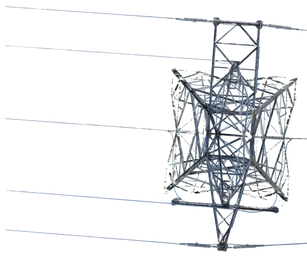

DERRYBRIEN 110 kV LINE END MAST
TOWER EM41 - SEE NOTE

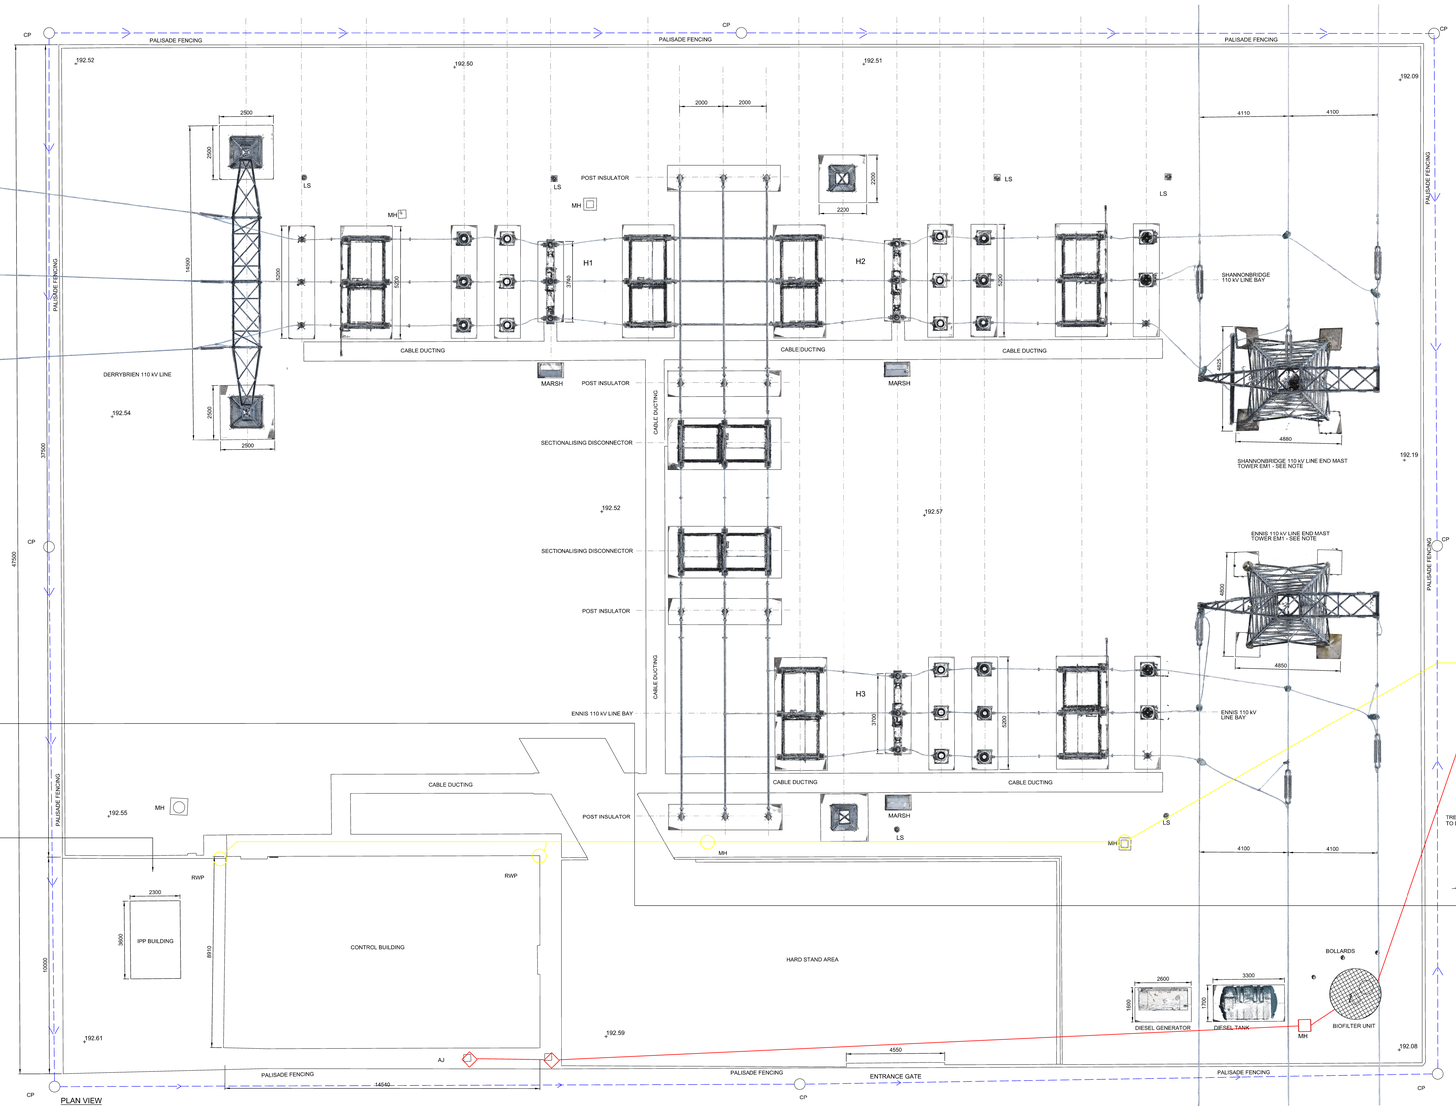

PLAN VIEW

IPP CONTROL BUILDING
VIEWED FROM 110kV COMPOUND

LEGEND

MARSH	MARSHALLING BOX
LS	LAMP STANDARD
192.52	SPOT LEVELS
SURFACE WATER	
FOUL WATER	
SW MANHOLE	MH
FW MANHOLE	MH
SURFACE WATER AJ	AJ
FOUL WATER AJ	AJ
LAND DRAIN	
CATCH PIT	CP
RAINWATER DOWNPIPE	RWP
BIOCYCLE TREATMENT SYSTEM	
WATER SUPPLY WELL	WW

KEY
SUBSTITUTE CONSENT APPLICATION BOUNDARY

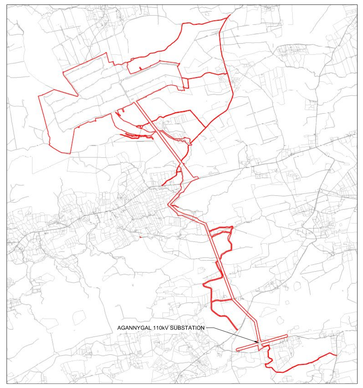

NOTES

DRAWING CREATED FROM SURVEY DATA CAPTURED BY TERRESTRIAL LIDAR (LASER SCANNING) MAY 2019

FOR PALISADE FENCE DETAILS SEE DRG. No. QS-000280-01-D460-022-005-00C

FOR CONTROL BUILDING DETAILS SEE DRG. No. QS-000280-01-D460-022-004-00C

FOR TOWER EM1 DETAILS SEE DRG. No. QS-000280-01-D460-023-007-00C

FOR TOWER EM41 DETAILS SEE DRG. No. QS-000280-01-D460-023-004-00C

ALL DIMENSIONS IN MILLIMETRES

SPOT LEVELS IN ITM TO OSI MALIN HEAD DATUM

DO NOT SCALE FROM DRAWING

REV.	DATE	REVISION DESCRIPTION	DRN	PROD	VER.I	VER.II	APP
0	00.00.00	ISSUED FOR ---	--	--	--	--	--

PURPOSE OF ISSUE - PRELIMINARY UNLESS INDICATED

TENDER ☐ CLIENT APPROVAL ☐ CONSTRUCTION ☐ AS-BUILT ☐ REVISED ☐

Client: GORT WINDFARMS

Project: DERRYBRIEN WIND FARM PROJECT

Contract:

Drawing Title: AGANNYGAL 110kV SUBSTATION SITE LAYOUT PLAN

Production Unit: Civil & Environmental Engineering

ESB INTERNATIONAL
One Dublin Airport Central,
Dublin Airport, Cloghran, Co. Dublin
Tel: 353 1 703 8000 Email: marketing@esbi.ie
Web: www.esbinternational.ie
ESBI International is a trading name of
ESBI Engineering & Facility Management Ltd
Registered Office: as above Registered in Ireland No. 155249

DRAWN	PRODUCED	VERIFIED 1	VERIFIED 2	APPROVED	APPD DATE
P.CARROLL	P.CARROLL	C.DOLAN	J.McLOUGHLIN	H.O'KEEFFE	17/07/2020

CLIENT REF	No. of Shts	SIZE	SCALE
TC NUMBER	1	A0	1:100

DRAWING NUMBER / SHEET / REV
QS-000280-01-D460-022-002-000

COPYRIGHT © ESBI ENGINEERING & FACILITY MANAGEMENT LIMITED.
All rights reserved. No part of this work may be modified or reproduced or copied in any form or by any means - graphic, electronic or mechanical, including photocopying, recording, taping or information-and-retrieval system, or used for any purpose other than its designated purpose, without the written permission of ESBI Engineering & Facility Management Ltd.

BF-D460-D13-001-001

c:\temp\qs-000280-01-d460-022-002-000.dgn